

MAINE TURNPIKE




THE GOLD STAR
MEMORIAL HIGHWAY

MAINE TURNPIKE AUTHORITY

GERARD P. CONLEY, CHAIRMAN
LUCIEN B. GOSSELIN, VICE CHAIRMAN
EARL L. ADAMS, MEMBER
HARLAND C. GOODWIN, MEMBER
RICHARD E. VALENTINO, MEMBER
DOUGLAS A. VOLK, MEMBER
GREGORY G. NADEAU, MEMBER EX-OFFICIO

PAUL E. VIOLETTE, EXECUTIVE DIRECTOR

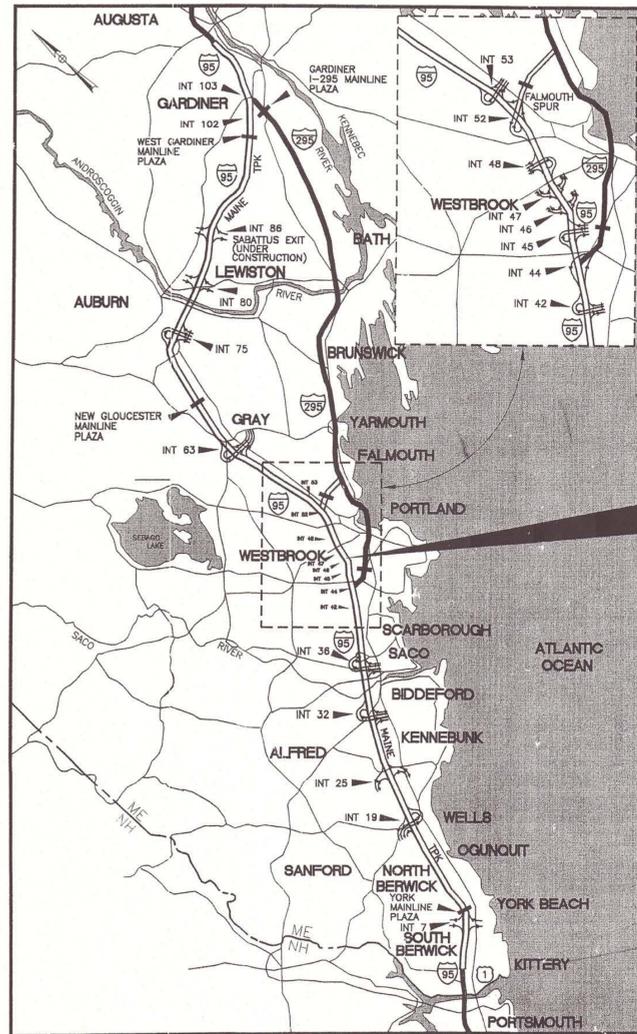

LOCATION MAP

CONTRACT 2007.07 MAINE TURNPIKE AUTHORITY ADMINISTRATION BUILDING SET 1 OF 2

CONTRACT 2007.07

STATE OF MAINE
DEPARTMENT OF TRANSPORTATION

COMMISSIONER _____ DATE _____

BUREAU DIRECTOR AND CHIEF ENGINEER _____ DATE _____

GENERAL CONTRACTOR


BUSINESS NAME _____
OFFICER _____ TITLE _____
DATE _____

APPROVED:

MAINE TURNPIKE AUTHORITY

CHAIRMAN

EXECUTIVE DIRECTOR
DATE _____

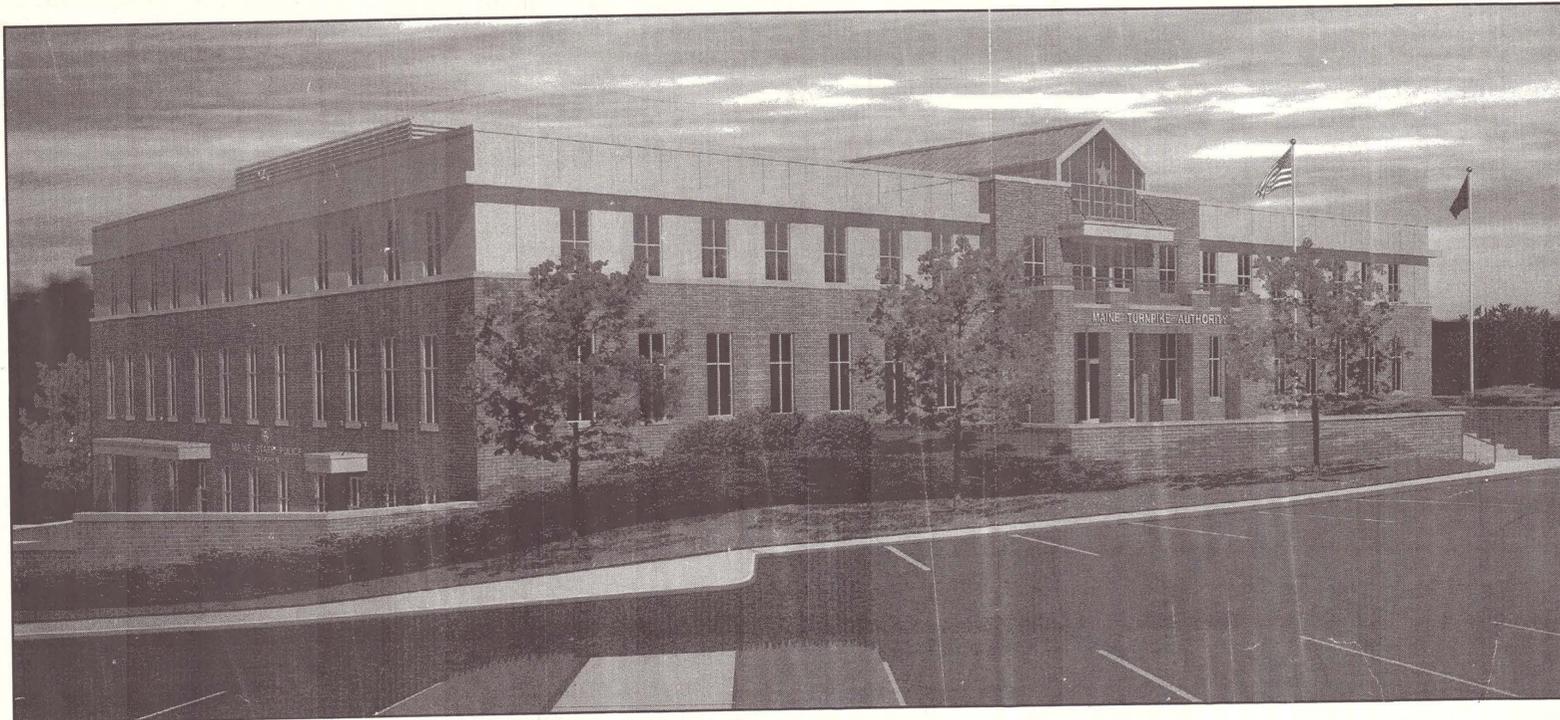

MAINE TURNPIKE AUTHORITY ADMINISTRATION BUILDING PORTLAND, MAINE


AS BUILT
Owner Copy

GENERAL NOTES:

- FIELD VERIFY ALL DIMENSIONS AND LAYOUT PRIOR TO PROCEEDING WITH WORK. NOTIFY ARCHITECT IN WRITING OF ANY DISCREPANCIES OR INCONSISTENCIES. FAILURE TO REPORT ANY DISCREPANCIES WITHIN THESE CONSTRUCTION DOCUMENTS TO THE ARCHITECT WILL NOT BE GROUNDS FOR ADDITIONAL COST OR CHANGE ORDERS.
- CONTRACTOR SHALL BE RESPONSIBLE FOR PROVIDING ALL MATERIALS (UNLESS NOTED OTHERWISE), AND WORKMANSHIP IN ACCORDANCE WITH FEDERAL, STATE, CITY AND LOCAL BUILDING CODES AND THEIR REQUIREMENTS.
- CONTRACTOR AND ALL TRADES SHALL NOTE REQUIREMENTS OF "GENERAL NOTES" ON ALL SHEETS.
- EACH TRADE TO PROVIDE SMOKE OR FIRE SEALANT AT PENETRATIONS AS REQUIRED FOR WALL TYPE. ALL SEALANT, FIRE STOPPING, AND SMOKE STOPPING ASSEMBLIES SHALL BE U.L. RATED.
- DIMENSIONS ARE FACE OF CONCRETE, FACE OF MASONRY, AND CENTERLINE OF STUD PARTITIONS, UNLESS INDICATED OTHERWISE.
- REFER TO ALL CONSTRUCTION DOCUMENTS FOR REQUIREMENTS WHICH MAY AFFECT THE WORK IN ANOTHER DISCIPLINE AND COORDINATE WORK.
- SEE G1003 FOR TYPICAL MOUNTING HEIGHTS OF PLUMBING FIXTURES, BATHROOM ACCESSORIES AND MISC. ITEMS.
- REFER TO DETAILS FOR ADDITIONAL DIMENSIONAL INFORMATION.
- DOOR JAMBS SHALL BE LOCATED 6" FROM CORNER IN STUD PARTITIONS AND 8" FROM CORNER IN MASONRY PARTITIONS, UNLESS INDICATED OTHERWISE.
- PROVIDE BLOCKING IN WALLS AS NECESSARY WHERE CASEWORK, SHELVES, HANDRAILS, AND MISC. EQUIPMENT ARE LOCATED.
- DO NOT SCALE DRAWINGS.
- "PROVIDE" MEANS "FURNISH AND INSTALL".
- ELEVATIONS INDICATED ON THE GENERAL, ARCHITECTURAL, STRUCTURAL, MECHANICAL, ELECTRICAL, FIRE PROTECTION AND PLUMBING DRAWINGS ARE BASED ON AN ASSIGNED REFERENCE ELEVATION OF THE FIRST FLOOR = 100'-0". ACTUAL FIRST FLOOR ELEVATION BASED ON USGS DATUM INDICATED ON DRAWING CP201.



ARCHITECTURE ENGINEERING PLANNING
SMRT
144 Fore Street/P.O. Box 618
Portland, Maine 04104
tel. (207) 772-3846
fax. (207) 772-1070

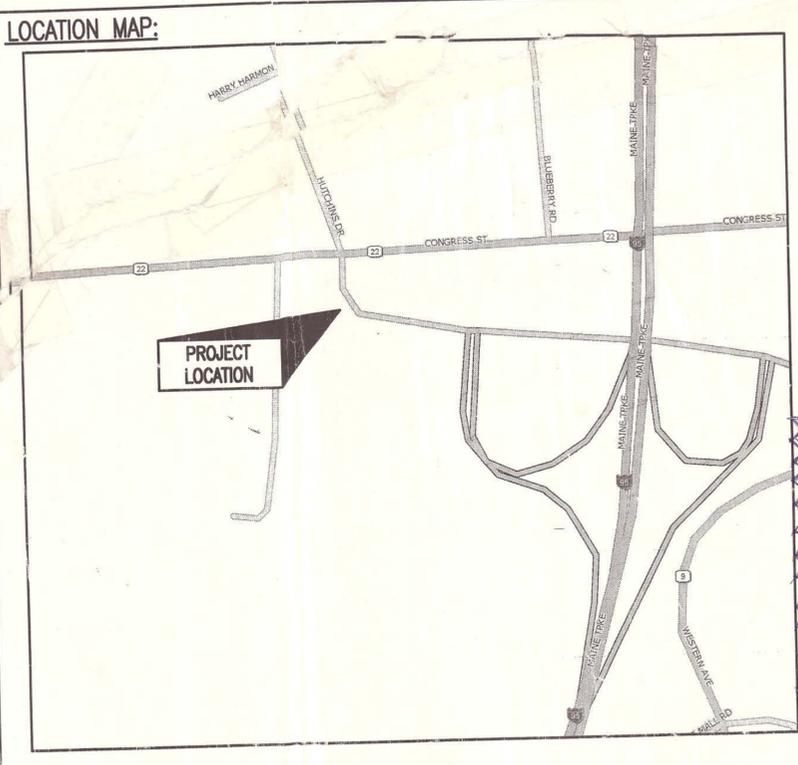

DRAWING LIST:

GENERAL	ARCHITECTURAL CONT.	ARCHITECTURAL CONT.	STRUCTURAL CONT.	PLUMBING
G000 COVER SHEET	AE111 FIRST FLOOR LAYOUT PLAN	AE531 BUILDING AND WALL SECTION DETAILS	S5.0 STEEL BRACING ELEVATIONS & DETAILS	PL101 FIRST FLOOR DWV PIPING PLAN
G001 TITLE SHEET	AE112 SECOND FLOOR LAYOUT PLAN	AE532 BUILDING AND WALL SECTION DETAILS	S5.1 COLUMN SCHEDULE	PL102 SECOND FLOOR DWV PIPING PLAN
G002 GENERAL INFORMATION	AE113 THIRD FLOOR LAYOUT PLAN	AE533 BUILDING AND WALL SECTION DETAILS	S5.2 STEEL FRAMING SECTIONS & DETAILS	PL103 THIRD FLOOR DWV PIPING PLAN
G003 GENERAL INFORMATION	AE121 FIRST FLOOR REFLECTED CEILING PLAN	AE534 BUILDING AND WALL SECTION DETAILS	S5.3 STEEL FRAMING SECTIONS & DETAILS	PL111 FIRST FLOOR SUPPLY PIPING PLAN
SITE	AE122 SECOND FLOOR REFLECTED CEILING PLAN	AE535 BUILDING AND WALL SECTION DETAILS	S5.4 STEEL FRAMING SECTIONS & DETAILS	PL112 SECOND FLOOR SUPPLY PIPING PLAN
C001 NOTES AND LEGEND	AE123 THIRD FLOOR REFLECTED CEILING PLAN	AE541 STAIR SECTIONS	S5.5 STEEL FRAMING SECTIONS & DETAILS	PL113 THIRD FLOOR SUPPLY PIPING PLAN
B1 PROPERTY AND RIGHT-OF-WAY PLAN	AE131 ROOF PLAN	AE542 STAIR DETAILS	S5.6 STEEL FRAMING SECTIONS & DETAILS	PL401 MECHANICAL & TOILET ROOM PART PLANS
CP101 EXISTING CONDITIONS PLAN	AE201 EXTERIOR ELEVATIONS	AE543 STAIR DETAILS	S5.7 STEEL FRAMING SECTIONS & DETAILS	PL501 DETAILS
CP201 LAYOUT PLAN	AE202 EXTERIOR ELEVATIONS	AE544 RAILING DETAILS	FP101 FIRST FLOOR FIRE PROTECTION PLAN	PL502 DETAILS
CP202 DETAIL LAYOUT PLAN	AE211 INTERIOR ELEVATIONS	AE601 FIRST FLOOR ROOM FINISH SCHEDULE	FP102 SECOND FLOOR FIRE PROTECTION PLAN	PL601 SCHEDULES
CG101 GRADING PLAN	AE212 INTERIOR ELEVATIONS	AE602 SECOND FLOOR ROOM FINISH SCHEDULE	FP103 THIRD FLOOR FIRE PROTECTION PLAN	PL651 RISER DIAGRAM
CG201 DETAIL GRADING PLAN	AE213 INTERIOR ELEVATIONS	AE603 THIRD FLOOR ROOM FINISH SCHEDULE	FP501 FIRE PROTECTION DETAILS	ELECTRICAL
CG202 DETAIL GRADING PLAN	AE214 INTERIOR ELEVATIONS	AE611 FIRST FLOOR DOOR SCHEDULE	M-001 LEGEND AND ABBREVIATIONS	E-001 LEGEND AND GENERAL NOTES
CG203 SITE GRADING DETAILS	AE215 INTERIOR ELEVATIONS	AE612 SECOND FLOOR DOOR SCHEDULE	MH101 FIRST FLOOR HVAC DUCTWORK PLAN	ES101 ELECTRICAL SITE PLAN
CG301 UNDERDRAIN SOIL FILTER AND DETENTION POND PLANS AND DETAILS	AE216 INTERIOR ELEVATIONS	AE613 THIRD FLOOR DOOR SCHEDULE	MH102 SECOND FLOOR HVAC DUCTWORK PLAN	ES301 DUCT BANK DETAILS
CG302 UNDERDRAIN SOIL FILTER AND DETENTION POND PLANS AND DETAILS	AE217 INTERIOR ELEVATIONS	AE621 DOOR AND WINDOW ELEVATIONS	MH103 THIRD FLOOR HVAC DUCTWORK PLAN	ES302 DUCT BANK DETAILS
CU101 UTILITY PLAN	AE218 INTERIOR ELEVATIONS	AE622 DOOR AND WINDOW DETAILS	MH104 ROOF HVAC DUCTWORK PLAN	ES401 ENLARGED ELECTRICAL SITE PLAN
CU201 SEWER PLAN AND PROFILE	AE219 INTERIOR ELEVATIONS	AE625 DOOR AND WINDOW DETAILS	MP101 FIRST FLOOR HVAC PIPING PLAN	EG101 GROUNDING & CONDUIT PLAN
CU202 SEWER DETAILS SHEET 1	AE220 INTERIOR ELEVATIONS	AE626 DOOR AND WINDOW DETAILS	MP102 SECOND FLOOR HVAC PIPING PLAN	EP101 FIRST FLOOR POWER PLAN
CU203 SEWER DETAILS SHEET 2	AE301 BUILDING SECTIONS	AE627 DOOR AND WINDOW DETAILS	MP103 THIRD FLOOR HVAC PIPING PLAN	EP102 SECOND FLOOR POWER PLAN
LP101 LANDSCAPE PLAN	AE311 WALL SECTIONS	AE628 DOOR AND WINDOW DETAILS	MP111 FIRST FLOOR RADIANT FLOOR PIPING PLAN	EP103 THIRD FLOOR POWER PLAN
LP201 DETAIL LANDSCAPE PLAN	AE312 WALL SECTIONS	AF101 FIRST FLOOR FINISH PLAN	MP111A FIRST FLOOR INSLAB RADIANT FLOOR PIPING PLAN	EP104 ROOF POWER PLAN
LP202 DETAIL LANDSCAPE PLAN	AE313 WALL SECTIONS	AF102 SECOND FLOOR FINISH PLAN	MP112 SECOND FLOOR RADIANT FLOOR PIPING PLAN	EP401 ENLARGED POWER PLANS
LP501 LANDSCAPE DETAILS/PLANT LIST	AE314 WALL SECTIONS	AF103 THIRD FLOOR FINISH PLAN	MP113 THIRD FLOOR RADIANT FLOOR PIPING PLAN	EP402 ENLARGED POWER PLANS
C-301 SITE WALL ELEVATIONS	AE315 WALL SECTIONS	STRUCTURAL	M-401 MECHANICAL ROOM PART PLAN	EP501 PANEL SCHEDULES
C-501 SITE DETAILS	AE316 WALL SECTIONS	S1.0 GENERAL STRUCTURAL NOTES	M-501 DETAILS	EP502 PANEL SCHEDULES
C-502 SITE DETAILS	AE401 ENLARGED PARTIAL PLANS	S1.1 MAINTENANCE BUILDING PLANS & ELEVATIONS	M-502 DETAILS	EP503 PANEL SCHEDULES
C-503 SITE DETAILS	AE402 MAINTENANCE BUILDING PLANS & ELEVATIONS	AE501 TYPICAL SECTIONS & DETAILS	M-503 DETAILS	EP601 ELECTRICAL ONE LINE DIAGRAM
C-504 SITE DETAILS	AE501 TYPICAL SECTIONS & DETAILS	AE511 PLAN SECTIONS & DETAILS	M-504 DETAILS	EL101 FIRST FLOOR LIGHTING PLAN
CS301 EROSION/SEDIMENT CONTROL PLAN	AE511 PLAN SECTIONS & DETAILS	AE512 PLAN SECTIONS & DETAILS	M-601 SCHEDULES	EL102 SECOND FLOOR LIGHTING PLAN
CS302 EROSION/SEDIMENT CONTROL NOTES	AE512 PLAN SECTIONS & DETAILS	AE513 PLAN SECTIONS & DETAILS	M-602 SCHEDULES	EL103 THIRD FLOOR LIGHTING PLAN
CS501 EROSION/SEDIMENT CONTROL DETAILS	AE513 PLAN SECTIONS & DETAILS	AE514 PLAN SECTIONS & DETAILS	M-603 SCHEDULES	EI 401 ENLARGED LIGHTING PLANS
CS502 EROSION/SEDIMENT CONTROL DETAILS	AE514 PLAN SECTIONS & DETAILS	AE515 PLAN SECTIONS & DETAILS	M-651 SCHEMATICS	EL601 LIGHTING FIXTURE SCHEDULE
ARCHITECTURAL	AE515 PLAN SECTIONS & DETAILS	AE521 INTERIOR ELEVATION SECTIONS & DETAILS	M-652 SCHEMATICS	EL602 LIGHTING DETAILS
AE001 CODE COMPLIANCE INFORMATION	AE521 INTERIOR ELEVATION SECTIONS & DETAILS	AE522 INTERIOR ELEVATION SECTIONS & DETAILS	M-653 SCHEMATICS	EL603 LIGHTING CONTROL SCHEDULES & RISERS
AE101 FIRST FLOOR PLAN	AE522 INTERIOR ELEVATION SECTIONS & DETAILS	AE523 INTERIOR ELEVATION SECTIONS & DETAILS	S3.0 FOUNDATION PLAN	EL651 LIGHTING DETAILS
AE102 SECOND FLOOR PLAN	AE523 INTERIOR ELEVATION SECTIONS & DETAILS	S3.1 FOUNDATION SECTIONS & DETAILS	S3.1 FOUNDATION SECTIONS & DETAILS	EL652 LIGHTING CONTROL SCHEDULES & RISERS
AE103 THIRD FLOOR PLAN	S3.2 FOUNDATION SECTIONS & DETAILS	S3.2 FOUNDATION SECTIONS & DETAILS	S3.2 FOUNDATION SECTIONS & DETAILS	EL653 LIGHTING DETAILS AND RISERS
	S3.3 FOUNDATION SECTIONS & DETAILS	S3.3 FOUNDATION SECTIONS & DETAILS	S3.3 FOUNDATION SECTIONS & DETAILS	EY101 FIRST FLOOR SYSTEMS PLAN
	S3.4 FOUNDATION PIERS & DETAILS	S3.4 FOUNDATION PIERS & DETAILS	S3.4 FOUNDATION PIERS & DETAILS	EY102 SECOND FLOOR SYSTEMS PLAN
	S3.5 FOUNDATION SECTIONS & DETAILS	S3.5 FOUNDATION SECTIONS & DETAILS	S3.5 FOUNDATION SECTIONS & DETAILS	EY103 THIRD FLOOR SYSTEMS PLAN
	S3.6 BRICKSHELF ELEVATION PLAN	S3.6 BRICKSHELF ELEVATION PLAN	S3.6 BRICKSHELF ELEVATION PLAN	EY501 FIRE ALARM RISER DIAGRAM
	S4.0 SECOND FLOOR FRAMING PLAN	S4.0 SECOND FLOOR FRAMING PLAN	S4.0 SECOND FLOOR FRAMING PLAN	EY502 SYSTEMS RISER DIAGRAMS
	S4.1 THIRD FLOOR FRAMING PLAN	S4.1 THIRD FLOOR FRAMING PLAN	S4.1 THIRD FLOOR FRAMING PLAN	
	S4.2 ROOF FRAMING PLAN	S4.2 ROOF FRAMING PLAN	S4.2 ROOF FRAMING PLAN	

PROJECT TITLE:
MAINE TURNPIKE AUTHORITY
ADMINISTRATION BUILDING
PORTLAND, MAINE

ISSUED FOR BIDDING/CONSTRUCTION
7-3-07

REV	DESCRIPTION	DATE
0	BIDDING/CONSTRUCTION	7-9-07

GRAPHIC SCALE:
0" = 1"

SCALE: AS NOTED
PROJECT MANAGER: SLB
DESIGNED BY: TCM/TCH
DATE OF RECORD: 7-3-07
CAD FILE: G101-001.rvt
PROJECT NO: 00016
DATE: 7-9-07

SHEET TITLE:
TITLE SHEET
SHEET No. G100

ABBREVIATIONS

AB	ANCHOR BOLT	L	ANGLE; LENGTH
AC, A/C	AIR CONDITIONING	LF	LEFT
ACCU	AIR CONDITIONING CONDENSER UNIT	LNO	SHEET LINOLEUM
ACPLAS	ACOUSTICAL PLASTER	LL	LIVE LOAD
ACT	ACOUSTIC CEILING TILE	LLH	LONG LEG HORIZONTAL
AFF	ABOVE FINISHED FLOOR	LLV	LONG LEG VERTICAL
AGG	AGGREGATE	LTP	LIGHTING PANEL; LIQUIPED PROPANE
ALT	ALTERNATE		
AP	ACCESS PANEL		
APROX	APPROXIMATE	MAX	MAXIMUM
ARCH	ARCHITECTURAL	MB	MARKER BOARD
BCK	BOTTOM CHORD EXTENSION	MDO	MEDIUM DENSITY OVERLAY
BD	BOARD	MECH	MECHANICAL
BIT	BITUMINOUS	MFR	MANUFACTURER
BLDG	BUILDING	MIN	MINIMUM
BLP	BORROWED LIGHT PANEL	MISC	MISCELLANEOUS
BO	BOTTOM OF	MO	MASONRY OPENING
BOF	BOTTOM OF FOOTING	MR	MOISTURE-RESISTANT
BOS	BOTTOM OF STEEL	MUA	MAKE-UP AIR
BOT	BOTTOM	N	NOSING
BRDG	BRIDGING	NCB	NEW CATCH BASIN
BRG	BEARING	NDMH	NEW DRAIN MANHOLE
BS	BOTH SIDES	NFM	NEW FORCE MAIN
BSE	BRICK SHELF ELEVATION	NIC	NOT IN CONTRACT
		NS	NEAR SIDE
C	CHANNEL	NSD	NEW STORM DRAIN LINE
CB	CATCH BASIN; CHALKBOARD	NSS	NEW SANITARY SEWER LINE
CEM	CEMENTITIOUS BACKER BOARD	NTS	NOT TO SCALE
CFM	CUBIC FEET PER MINUTE	NW	NEW WATER LINE
CIP	CAST IN PLACE		
CJ	CONTROL JOINT; CONSTRUCTION JOINT	OC	ON CENTER
CL	CENTER LINE	OF	OUTSIDE FACE
CLL	CONTRACT LIMIT LINE	OH	OVERHEAD
CLR	CLEAR	PA	PUBLIC ADDRESS
CMU	CONCRETE MASONRY UNIT	PAF	POWDER-ACTUATED FASTENER
COL	COLUMN	POU	POOL DEHUMIDIFICATION UNIT
CONC	CONCRETE	PL	PLATE; PROPERTY LINE
CONC	CONTINUOUS	PLAM	PLASTIC LAMINATE
CT	CERAMIC TILE	PLF	POUNDS PER LINEAR FOOT
CUH	CABINET UNIT HEATER	PP	POWER PANEL
		PSF	POUNDS PER SQUARE FOOT
D	DIAMETER	PSI	POUNDS PER SQUARE INCH
DBL	DOUBLE	PT	PRESSURE-TREATED
DF	DRINKING FOUNTAIN	PVC	POLYVINYL CHLORIDE
DL	DEAD LOAD	PVMT	PAVEMENT
DR	DISPLAY RAIL		
DTL	DETAIL	R	RISER; RADIUS
DW	DISHWASHER	RB	RESILIENT BASE
DWG	DRAWING	RD	ROOF DRAIN
		REIN	REINFORCED
EA	EACH	REQ'D	REQUIRED
EF	EXHAUST FAN; EACH FACE	RT	RIGHT
EJ	EXPANSION JOINT	RO	ROUGH OPENING
ELEV	ELEVATION	ROW	RIGHT OF WAY
ELEC	ELECTRICAL	RUB	RUB-RAIL
EOP	EDGE OF PAVEMENT	RTU	ROOFTOP UNIT (HVAC)
EPDM	ETHYLENE PROPYLENE DIENE MONOMER	SACT	SUSPENDED ACOUSTIC CEILING TILE
EQ	EQUAL	SC	SOLID CORE
EW	EACH WAY	SF	SQUARE FOOT; SUPPLY FAN
EWV	ELECTRIC WATER COOLER	SHT	SHEET
EXIST	EXISTING	SIM	SIMILAR
EXP	EXPANSION	SK	SHEAR KEY
EXT	EXTERIOR	SN	SANITARY NAPKIN (DISPENSER)
F.R.P.	FABRICATED FIBERGLASS REINFORCED PLASTIC	SP	SPECIAL
FB	FLAT BAR	SS	STAINLESS STEEL
FBO	FURNISHED BY OTHERS	STA	STATION
FDO	FLOOR CLEAN-OUT	STL	STEEL
FD	FLOOR DRAIN	STRUC	STRUCTURAL
FE	FIRE EXTINGUISHER	T	TREAD
FF	FINISHED FLOOR; FAR FACE	TB	TACKBOARD
FFE	FINISHED FLOOR ELEVATION	T&B	TOP AND BOTTOM
FD	FRAMED OPENING	TBM	TEMPORARY BENCHMARK
FRP	FIBERGLASS REINFORCED PLASTIC	TCE	TOP CHORD EXTENSION
FS	FAR SIDE	TJ	TIE JOINT
FTG	FOOTING	TO	TOP OF
		TOC	TOP OF CONCRETE
GA	GAUGE	TOM	TOP OF MASONRY
GALV	GALVANIZED	TOP	TOP OF PIER
GB	GRAB BAR	TOS	TOP OF STEEL; TOP OF SLAB
GC	GENERAL CONTRACTOR	TOW	TOP OF WALL
GOT	GYPSTUM DROP-IN TILE		
GV	GRAVITY VENT	TP	TOILET PAPER (DISPENSER); TEST PIT
GWB	GYPSTUM WALL BOARD	TS	TUBE STEEL
		TYP	TYPICAL
H	HORIZONTAL	UH	UNIT HEATER
HC	HANDICAPPED; HOLLOW CORE	UNO	UNLESS NOTED OTHERWISE
HORIZ	HORIZONTAL		
HM	HOLLOW METAL	V	VENT PIPE; VERTICAL
HRU	HEAT RECOVERY UNIT	VB	VAPOR BARRIER
H&V	HEATING AND VENTILATING	VCT	VINYL COMPOSITION TILE
HVAC	HEATING, VENTILATING AND AIR CONDITIONING	VERT	VERTICAL
		VP	VISION PANEL
I	INCLUDED ANGLE	VTR	VENT THROUGH THE ROOF
ID	INSIDE DIAMETER	W/	WITH
IF	INSIDE FACE	WC	WATER CLOSER
IMP	ISOLATION JOINT	WF	WIDE FLANGE
INS	IMPACT RESISTANT	WH	WATER HEATER
INV	INSULATED	WO	WITHOUT
		W/O	WORKING POINT
JS	JOIST SUBSTITUTE	WP	WEB STIFFENER
K	KIPS	WS	WELDED WIRE FABRIC
		WVF	WELDED WIRE FABRIC

See REF 179 For Interior Wall Types (Typex Dens Aemore Plus Type X)

PARTITION LEGEND

S1	PARTITION: 3-5/8" METAL STUDS @ 16" O.C. TO DECK. (1) LAYER 5/8" GWB TO DECK EACH SIDE, BATT INSULATION.	
S2	PARTITION: 3-5/8" METAL STUDS @ 16" O.C. TO 6" ABOVE CEILING. (1) LAYER 5/8" GWB TO 6" ABOVE CEILING EACH SIDE, BATT INSULATION.	
S3	PARTITION: 3-5/8" METAL STUDS @ 16" O.C. TO 6" ABOVE CEILING. (1) LAYER 5/8" GWB TO 6" ABOVE CEILING EACH SIDE.	
S4	SMOKE PARTITION: SIMILAR TO S1 EXCEPT SEAL PERIMETER AND ALL PENETRATIONS W/ FIRESTOPPING SEALANT.	
S5	1 HOUR FIRE RATED PARTITION: UL DESIGN U419 20 GAGE 3-5/8"x1-1/4" FLOOR AND CEILING RUNNERS FASTENED @ 24" O.C. MAX. WITH 3-5/8"x1-1/4" 20 GAGE STUDS WITH 3/8" RETURNS SPACED 16" O.C. FASTEN (1) LAYER 5/8"x4" TYPE 'X' GWB TO BOTH SIDES OF STUDS & TRACKS WITH 1" TYPE S SELF TAPPING SCREWS AT 8" O.C. ALONG EDGES & 12" O.C. INFIELD. APPLY 2" PAPER JOINTS AND FINISH W/2 COATS OF JOINT COMPOUND. SEAL PERIMETER AND ALL PENETRATIONS W/ FIRESTOPPING SEALANT. BLANKET INSULATION IN STUD CAVITIES.	
S6	PARTITION: SIMILAR TO S1 EXCEPT (2) LAYERS 5/8" GWB TO DECK EACH SIDE.	
S7	SMOKE PARTITION: SIMILAR TO S4 EXCEPT (2) LAYERS 5/8" GWB TO DECK EACH SIDE.	
S8	1 HOUR FIRE RATED PARTITION: UL DESIGN U419: SIMILAR TO S5 EXCEPT (2) LAYERS 5/8" GWB TO DECK EACH SIDE.	
S9	PARTITION: 6" METAL STUDS @ 16" O.C. TO DECK. (1) LAYER 5/8" GWB TO DECK EACH SIDE, BATT INSULATION.	
S10	SMOKE PARTITION: SIMILAR TO S9 EXCEPT SEAL PERIMETER AND ALL PENETRATIONS W/ FIRESTOPPING SEALANT.	
S11	1 HOUR FIRE RATED PARTITION: UL DESIGN U419 20 GAGE 6"x1-1/4" FLOOR AND CEILING RUNNERS FASTENED @ 24" O.C. MAX. WITH 6"x1-1/4" 20 GAGE STUDS WITH 3/8" RETURNS SPACED 16" O.C. FASTEN (1) LAYER 5/8"x4" TYPE 'X' GWB TO BOTH SIDES OF STUDS & TRACKS WITH 1" TYPE S SELF TAPPING SCREWS AT 8" O.C. ALONG EDGES & 12" O.C. INFIELD. APPLY 2" PAPER JOINTS AND FINISH W/2 COATS OF JOINT COMPOUND. SEAL PERIMETER AND ALL PENETRATIONS W/ FIRESTOPPING SEALANT. BLANKET INSULATION IN STUD CAVITIES.	
S12	1 HOUR RATED SHAFT WALL: UL DESIGN U415-SYSTEM A 4" 22 GAGE 'J' SHAPED FLOOR AND CEILING RUNNERS ATTACHED TO STRUCTURAL SUPPORTS 2" (MAX) FROM EDGE AND 24" (MAX) O.C. 22 GAGE 4" 'C-H' SHAPED STUDS SPACED 24" O.C. (MAX). 1" GWB LINER PANELS INSERTED INTO 'H' SECTION OF 'C-H' STUDS, ATTACH TO LONG LEG OF 'J' SHAPE WITH 1-5/8" TYPE S SELF DRILLING, SELF TAPPING SCREWS 12" O.C. (MAX). FASTEN (1) LAYER 5/8" TYPE X GWB TO OUTER FACE OF 'C' PORTION OF 'C-H' STUDS WITH 1" TYPE S SELF TAPPING SCREWS AT 8" O.C. ALONG EDGES & 12" O.C. INFIELD. INSTALL BOARD WITH VERTICAL JOINTS STAGGERED. APPLY 2" PAPER JOINTS AND FINISH W/2 COATS OF JOINT COMPOUND. SEAL TIGHT TO STRUCTURE AND DECK. PROVIDE FULL THICKNESS BATT INSULATION IN PARTITION.	
S13	1 HOUR RATED SHAFT WALL: UL DESIGN U415-SYSTEM A SIMILAR TO S12 EXCEPT ADD (1) FINISH LAYER OF 5/8" GWB TAGGED SIDE, SEAL PERIMETER AND ALL PENETRATIONS W/ FIRESTOPPING SEALANT.	
C1	CHASE WALL: 5/8" GWB TO DECK, 3-5/8" METAL STUDS TO DECK, 2 PIECES 24" HIGH GYPSTUM PANEL BRACING, A SECOND ROW OF 3-5/8" METAL STUDS TO DECK, 5/8" GWB TO DECK. REFER TO ROOM FINISH SCHEDULE FOR APPLIED FINISHES SUCH AS TILE. PROVIDE SPECIFIED WALL FINISH SUBSTRATE IN PLACE OF GYPSTUM BOARD WHERE TILE IS SCHEDULED.	
C2	SMOKE CHASE WALL: SIMILAR TO C1 EXCEPT SEAL PERIMETER AND ALL PENETRATIONS W/ FIRESTOPPING SEALANT.	
C3	1 HOUR FIRE RATED CHASE WALL: UL DESIGN 420 5/8" TYPE 'X' GWB TO DECK, 3-5/8" METAL STUDS TO DECK, 2 PIECES 24" HIGH GYPSTUM PANEL BRACING, A SECOND ROW OF 3-5/8" METAL STUDS TO DECK, 5/8" TYPE 'X' GWB TO DECK. SEAL PERIMETER AND ALL PENETRATIONS W/ FIRESTOPPING SEALANT. REFER TO PLANS FOR WALL THICKNESS. CONSTRUCT WALL TO COMPLY WITH NO LESS THAN THE REQUIREMENTS OF UL DESIGN #U420. REFER TO FINISH SCHEDULE FOR APPLIED FINISHES SUCH AS TILE. PROVIDE SPECIFIED WALL FINISH SUBSTRATE IN PLACE OF GYPSTUM BOARD WHERE TILE IS SCHEDULED.	
F1	FURRING: 1 5/8" METAL STUDS @ 16" O.C. TO 6" ABOVE CEILING. (1) LAYER 5/8" GWB TO 6" ABOVE CEILING TAGGED SIDE. EXPOSED STUDS OPPOSITE SIDE, BATT INSULATION.	
F2	FURRING: 3-5/8" METAL STUDS @ 16" O.C. TO 6" ABOVE CEILING. (1) LAYER 5/8" GWB TO 6" ABOVE CEILING TAGGED SIDE. EXPOSED STUDS OPPOSITE SIDE, BATT INSULATION.	
F3	2" Z" FURRING CHANNELS @ 24" O.C. TO DECK. 2" RIGID INSULATION BETWEEN CHANNELS TO DECK. (1) LAYER 5/8" GWB TO DECK, TAGGED SIDE.	

A5 PARTITION, EXTERIOR WALL, & ROOF ASSEMBLY LEGEND

N.T.S.

M1	MASONRY WALL: 1 5/8" METAL STUDS @ 16" O.C. TO 6" ABOVE CEILING. (1) LAYER 5/8" GWB TO 6" ABOVE CEILING. 8"x8"x16" CMU TO DECK LAID IN FULL 3/8" MORTAR BED WITH VERTICAL JOINTS STAGGERED. REFER TO STRUCTURAL FOR REQUIRED REINFORCING. 1 5/8" METAL STUDS @ 16" O.C. TO 6" ABOVE CEILING. (1) LAYER 5/8" GWB TO 6" ABOVE CEILING.	
M2	1 HOUR FIRE RATED MASONRY WALL (SEE PARTITION NOTE 6) 8"x8"x16" CMU TO DECK LAID IN FULL 3/8" MORTAR BED WITH VERTICAL JOINTS STAGGERED. SEAL TIGHT TO BOTTOM OF DECK. REFER TO STRUCTURAL FOR REQUIRED REINFORCING. BULLNOSE BLOCK AT ALL MASONRY OPENING EXPOSED CORNERS, TOPS AND SIDES.	
M3	1 HOUR FIRE RATED MASONRY WALL (SEE PARTITION NOTE 6) SAME AS M2 EXCEPT 1 5/8" METAL STUDS @ 16" O.C. TO 6" ABOVE CEILING. (1) LAYER 5/8" GWB TO 6" ABOVE CEILING TAGGED SIDE ONLY.	

EXTERIOR WALL LEGEND

W1	FACE BRICK, SEE ELEVATIONS MASONRY ANCHOR, TYP. AIR SPACE 2" FOAM-PLASTIC BOARD INSULATION AIR/WATER BARRIER 5/8" GLASS-MAT GYPSTUM WALL SHEATHING 6" METAL STUDS 6" GLASS FIBER BLANKET INSULATION VAPOR RETARDER MEMBRANE 5/8" INTERIOR GYPSTUM WALL BOARD	
W2	METAL-COMPOSITE WALL PANEL, SEE ELEVATIONS 2" Z" FURRING 2" FOAM-PLASTIC BOARD INSULATION AIR/WATER BARRIER 5/8" GLASS-MAT GYPSTUM SHEATHING 6" METAL STUDS 6" GLASS FIBER BLANKET INSULATION VAPOR RETARDER MEMBRANE 5/8" INTERIOR GYPSTUM WALL BOARD	

ROOF ASSEMBLY LEGEND

R1	SINGLE PLY THERMOPLASTIC MEMBRANE 1/4" GLASS-MAT GYPSTUM COVER BOARD 1/4" FOOT TAPERED RIGID INSULATION 5" RIGID INSULATION 5/8" GLASS-MAT TYPE X GYPSTUM FIRE BARRIER BOARD 1-1/2" STEEL DECK, RE: STRUCTURAL STEEL ROOF FRAMING, RE: STRUCTURAL	
R2	SHEET METAL ROOFING SELF-ADHERING SHEET UNDERLAYMENT 5/8" FIRE RATED EXTERIOR GRADE PLYWOOD 2x FIRE RATED EXTERIOR GRADE SLEEPERS @ 16" O.C., PLYWOOD (Fire Rated) VENT SPACE BETWEEN 1/4" GLASS-MAT GYPSTUM COVER BOARD 5" RIGID INSULATION 5/8" GLASS-MAT TYPE X GYPSTUM FIRE BARRIER BOARD 1-1/2" STEEL DECK, RE: STRUCTURAL STEEL ROOF FRAMING, RE: STRUCTURAL	
R3	ROOF PAVERS PAVER SUPPORTS (P.T. BLOCKING BELOW TPO MEMBRANE) SINGLE PLY THERMOPLASTIC MEMBRANE 1/4" GLASS-MAT GYPSTUM COVER BOARD 1/4" FOOT TAPERED RIGID INSULATION 2" RIGID INSULATION 5" CONCRETE SLAB, RE: STRUCTURAL	
R4	SINGLE PLY THERMOPLASTIC MEMBRANE 1/4" GLASS-MAT GYPSTUM COVER BOARD 1/4" FOOT TAPERED RIGID INSULATION STEEL ROOF FRAMING, RE: STRUCTURAL	

GENERAL NOTES:

- SEE G101 FOR PROJECT GENERAL NOTES.
- PARTITION TYPE DRAWINGS ARE GRAPHIC REPRESENTATION ONLY, THEY ARE NOT TO SCALE TYPICAL.
- MORTAR USED IN THE RATED ASSEMBLIES SHALL HAVE SAND TO CEMENT RATIO BETWEEN 2.25 & 3.5, AND HYDRATED LIME TO CEMENT RATIO LESS THAN 0.5.
- ALL BATT INSULATION IS TO BE FULL THICKNESS AND FULL HEIGHT UNLESS NOTED OTHERWISE.
- REFER TO FINISH SCHEDULE FOR EXTENT OF FINISHES APPLIED TO WALLS.
- BRACE WALLS WHICH DO NOT EXTEND FULL HEIGHT TO STRUCTURE FOR ALL WALL LENGTHS GREATER THAN 8' BETWEEN CORNERS. BRACE WITH 45° STUD TO STRUCTURE AT 8'-0" ON CENTER MAX.
- FIRE ENDURANCES FOR CMU ASSEMBLIES HAVE BEEN DESIGNED PER CALCULATIONS IDENTIFIED IN "ANALYTICAL METHODS OF DETERMINING FIRE ENDURANCE OF CONCRETE AND MASONRY - MODEL CODE APPROVED PROCEDURES" AS PUBLISHED BY THE CONCRETE AND MASONRY INDUSTRY FIRE SAFETY COMMITTEE. BY CALCULATION, ALL ASSEMBLIES MEET OR EXCEED THE REQUIREMENT. SOLID GROUT WALLS AS REQUIRED TO PROVIDE AN EQUIVALENT THICKNESS OF NOT LESS THAN 2.8" THICKNESS FOR 1 HOUR PROTECTION.

PARTITION KEY:

- Interior Stud Partition
- Chase Wall System
- Furred Wall System
- Interior Masonry Partition
- Exterior Wall System
- Roof System

SYMBOL LEGEND


- Building Section
- Section
- Detail
- Exterior Elevation
- Interior Elevation
- Level Line
- Circle Note
- Window Tag
- Partition Tag
- Door Tag
- Room Name
- Room Number
- Column Bubble and Center Line

GRID NO.	TITLE
SCALE	REFERENCE SHEET

- 1 HOUR FIRE RATED WALL
- 1 HOUR SMOKE BARRIER
- LATERAL BRACING, RE: STRUCTURAL



ARCHITECTURE ENGINEERING PLANNING
SMRT
144 Fore Street/P.O. Box 618
Portland, Maine 04104
tel. (207) 772-3646
fax. (207) 772-1070

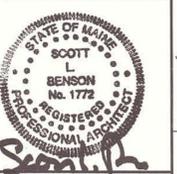


AS BUILT
Owner Copy

PROJECT TITLE: MAINE TURNPIKE AUTHORITY ADMINISTRATION BUILDING PORTLAND, MAINE
CURRENT ISSUE STATUS: ISSUED FOR BIDDING/CONSTRUCTION 7-9-07

REV	DESCRIPTION	DATE
0	BIDDING/CONSTRUCTION	7-9-07


GRAPHIC SCALE: 0" = 1"
SCALE: AS NOTED
PROJECT MANAGER: SLB
JC/DRAWN BY: TCM/TCM
A/E OF RECORD: SLB
CAD FILE: G102-06016
PROJECT NO: 06016
DATE: 7-9-07
SHEET TITLE: GENERAL INFORMATION
SHEET No: G1002

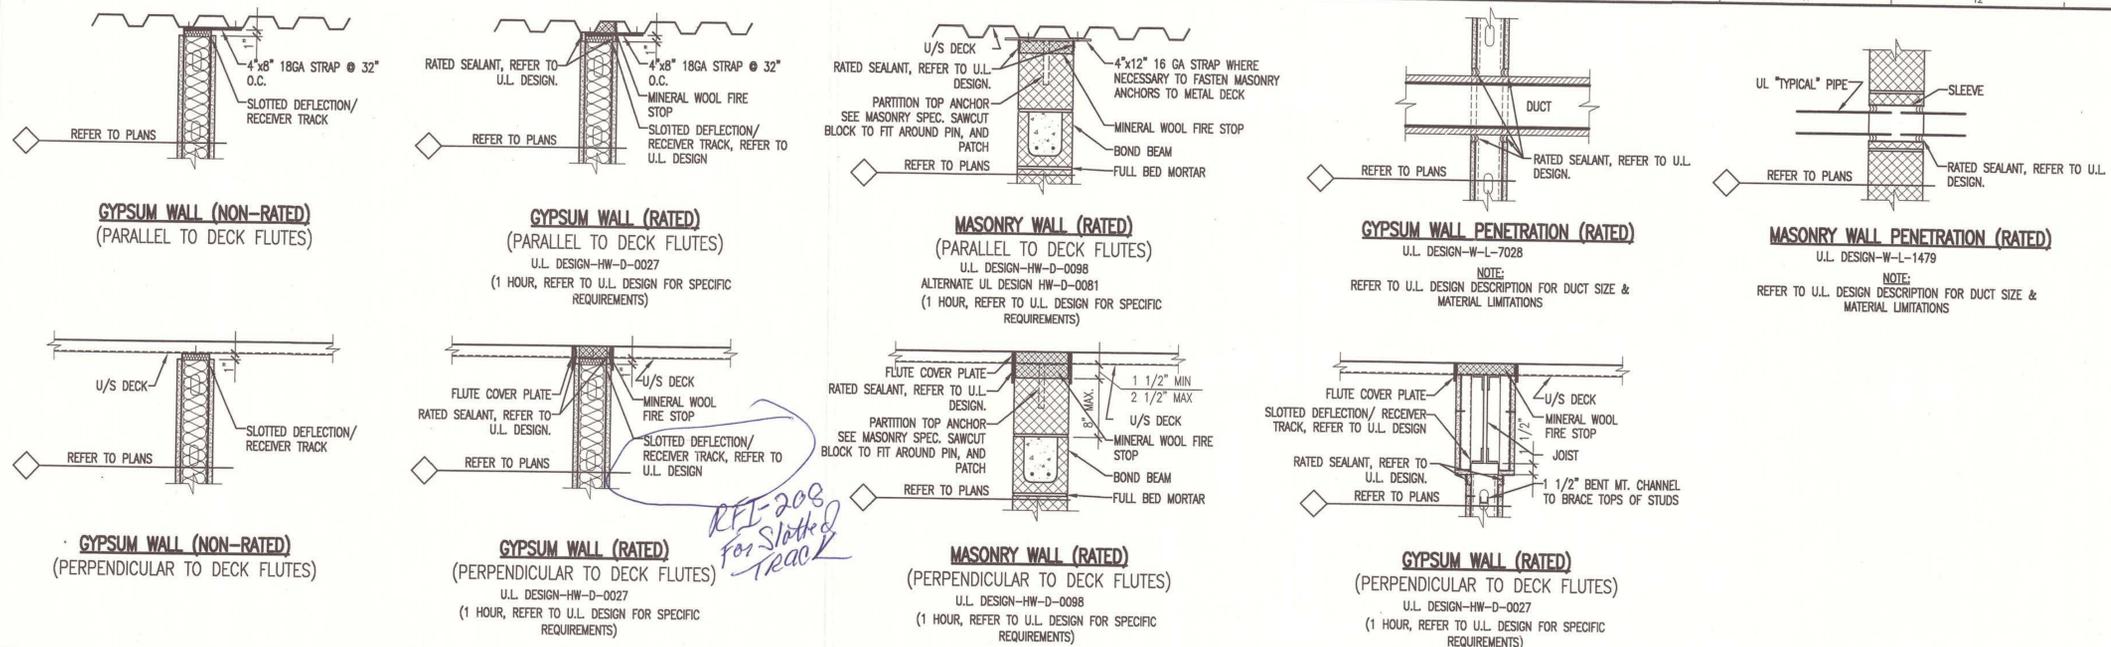

GENERAL NOTES:
 1. SEE G1001 FOR PROJECT GENERAL NOTES.




ARCHITECTURE ENGINEERING PLANNING
 SCOTT
 144 Fore Street P.O. Box 618
 Portland, Maine 04104
 tel. (207) 772-3846
 fax. (207) 772-1070

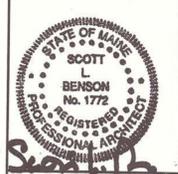

H5 TYPICAL TOP OF WALL AND THROUGH WALL PENETRATION DETAILS

1" = 1'-0"

Owner Toilet Accessories RFI-215

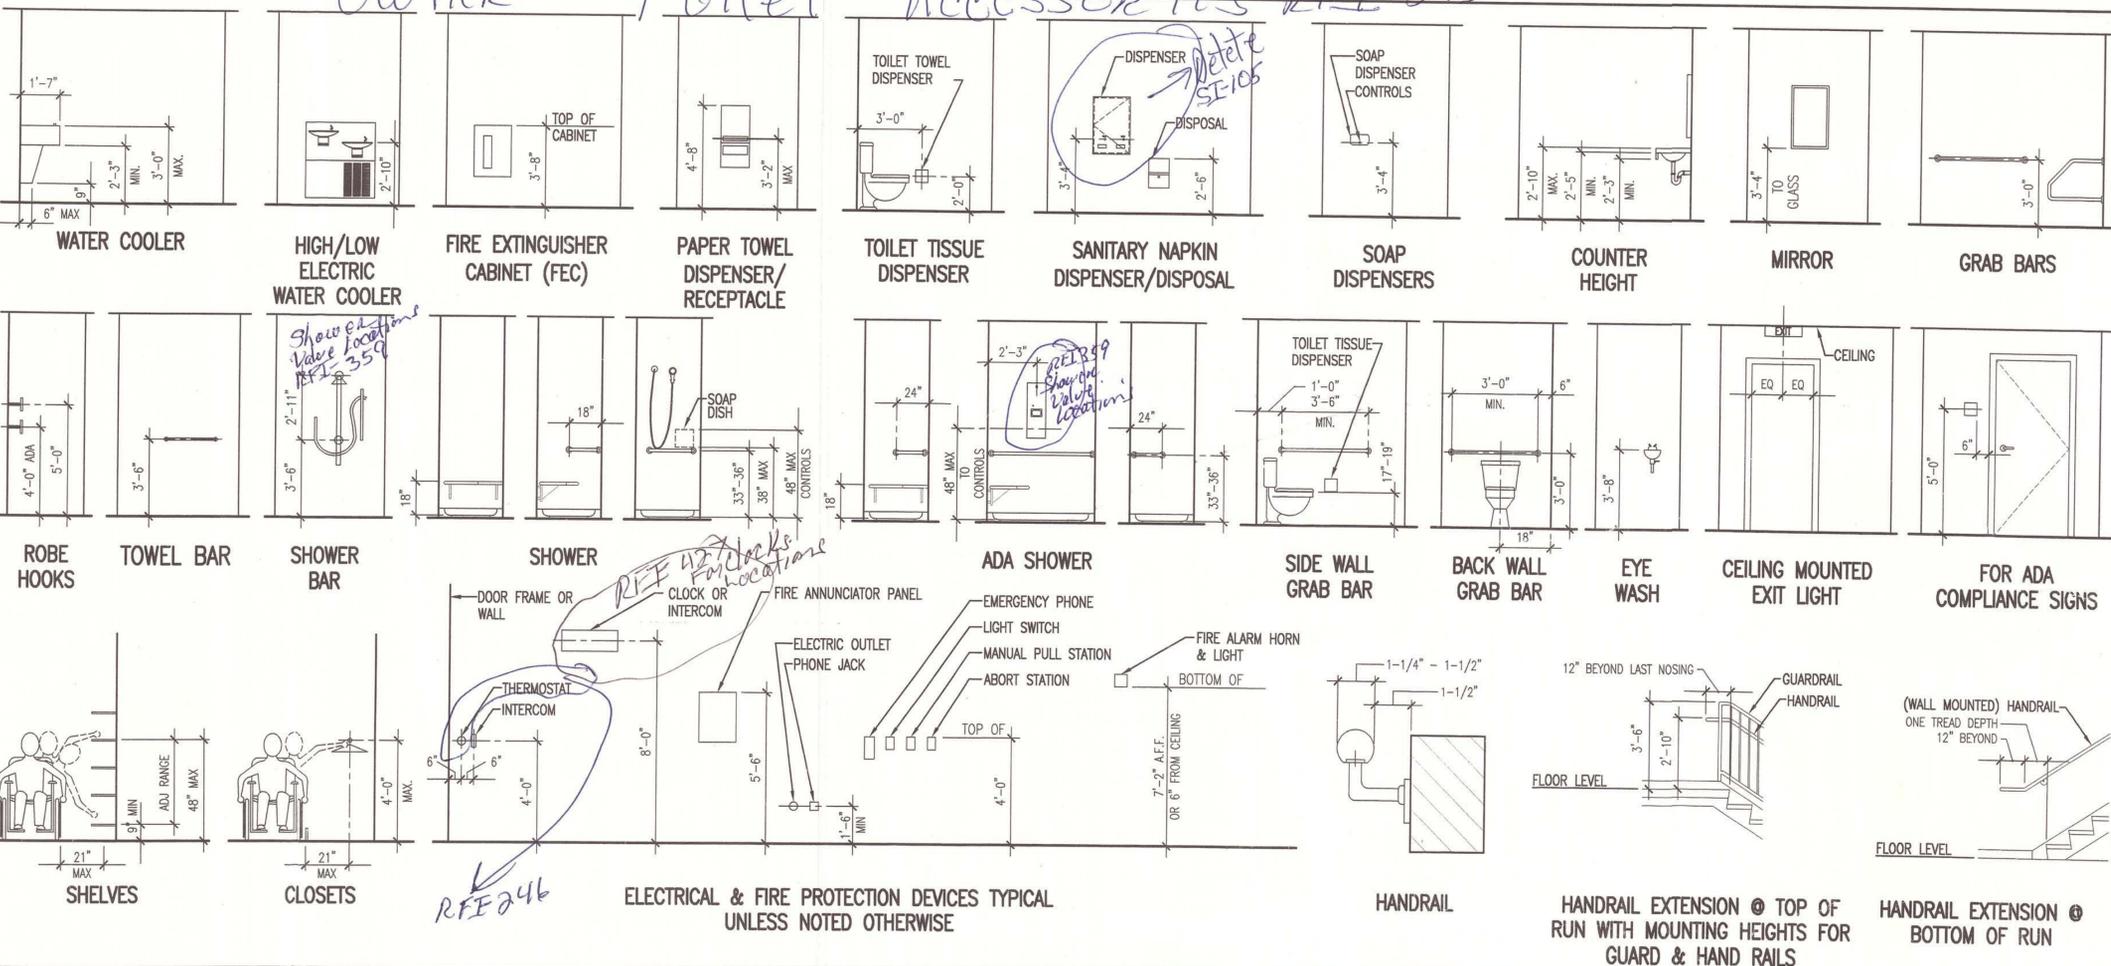

Owner toilet accessories see RFI-215

A1 TYPICAL MOUNTING HEIGHTS

N.T.S.


AS BUILT
 Owner Copy

PROJECT TITLE: MAINE TURNPIKE AUTHORITY ADMINISTRATION BUILDING PORTLAND, MAINE
 CURRENT ISSUE STATUS: ISSUED FOR BIDDING/CONSTRUCTION 7-9-07

REV	DESCRIPTION	DATE
0	BIDDING/CONSTRUCTION	7-9-07

GRAPHIC SCALE: 0" 1"
 SCALE: AS NOTED
 PROJECT MANAGER: SLB
 JC/DRAWN BY: TCM/TCM
 A/E OF RECORD: SLB
 CAD FILE: G1003-06016
 PROJECT NO: 06016
 DATE: 7-9-07

SHEET TITLE: GENERAL INFORMATION
 SHEET No: G1003

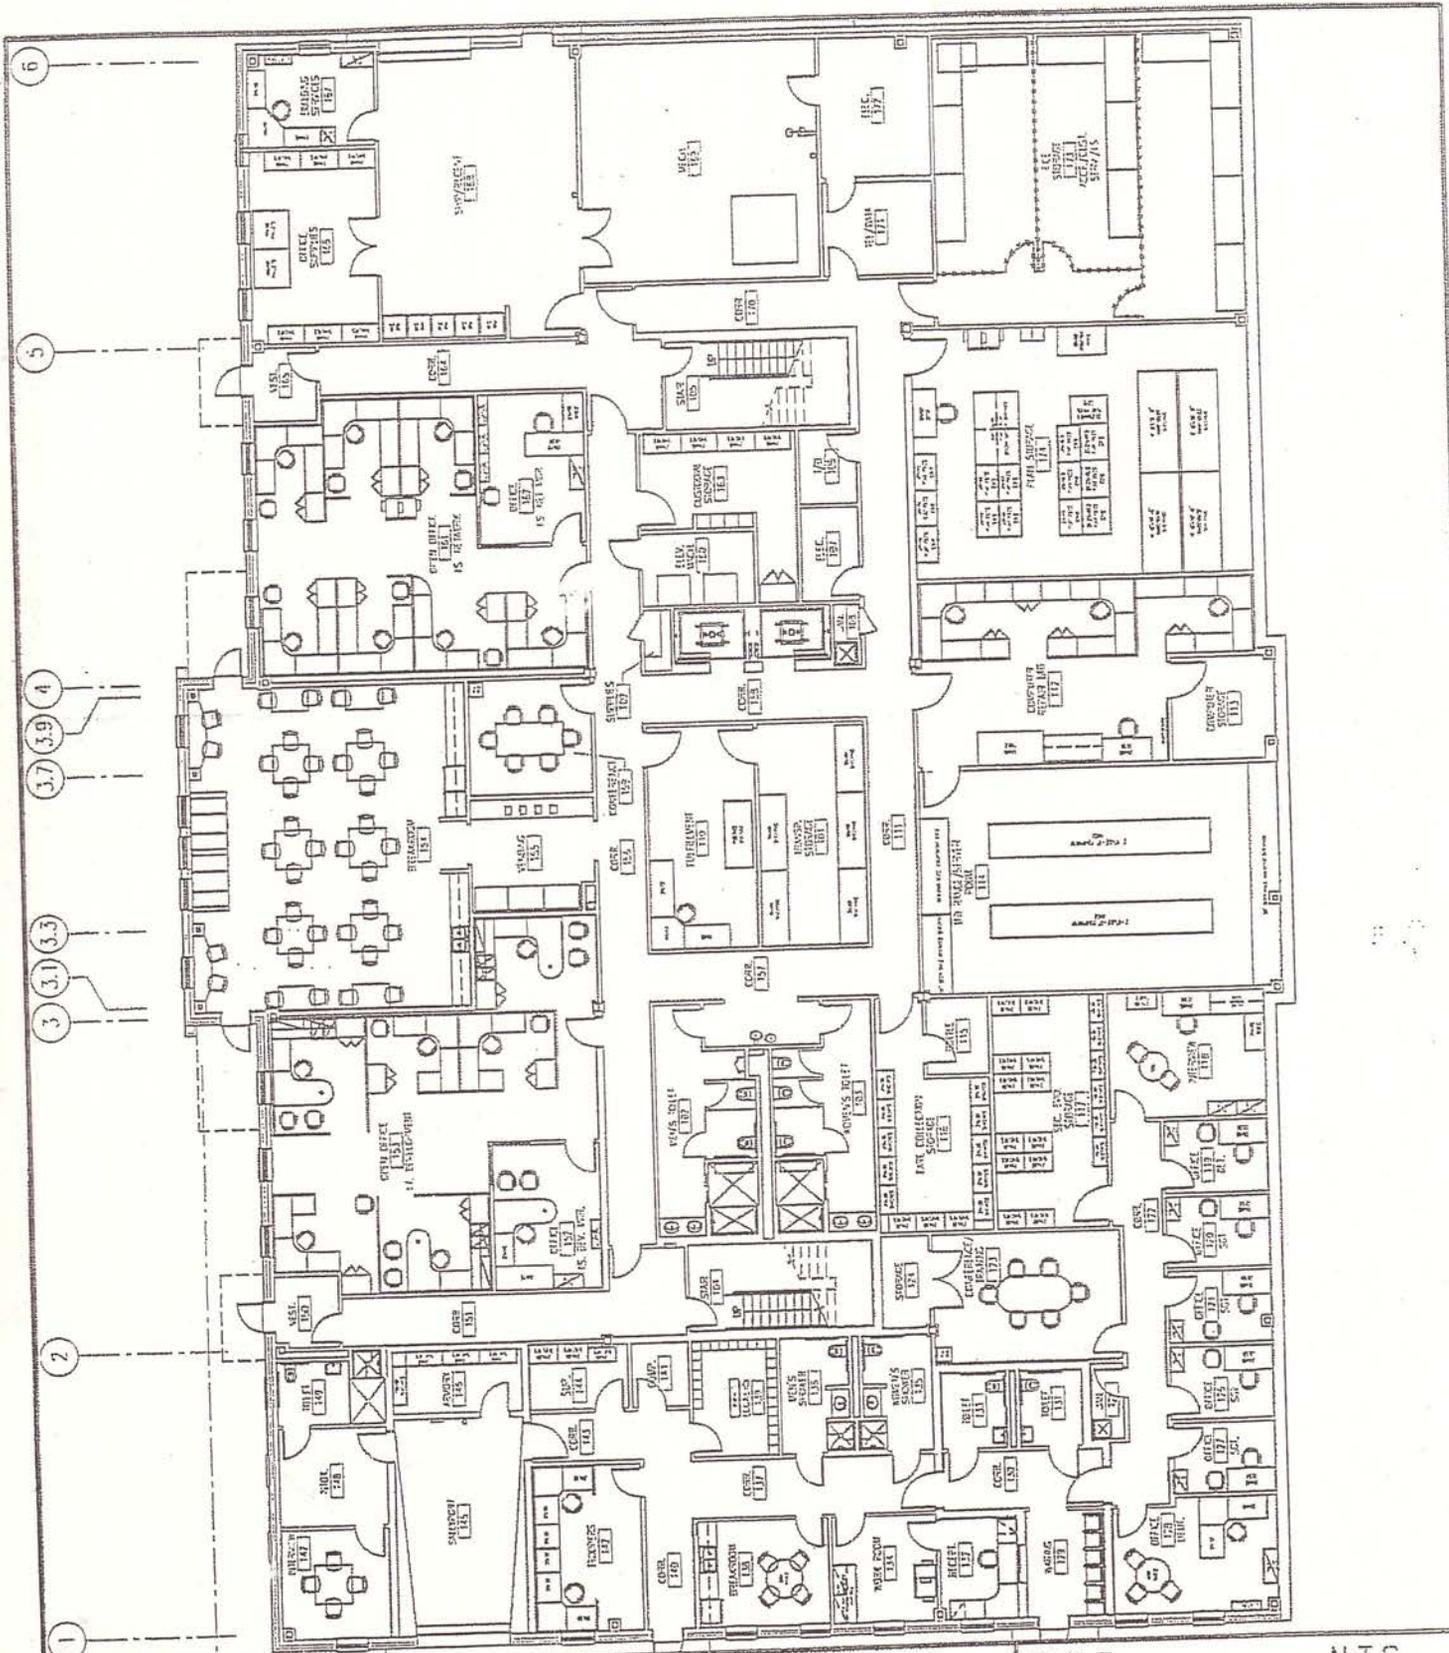

ARCHITECTURE ENGINEERING PLANNING
 SMRT
 144 Fore Street/P.O.Box 611 PORTLAND, MAINE 04104
 tel. (207) 772-3846 / fax. (207) 772-1070

MAINE TURNPIKE AUTHORITY
 ADMINISTRATION BUILDING
 FIRST FLOOR FURNITURE PLAN

SCALE:	N.T.S.
CAD FILE:	IF101-06016
PROJECT No.	06016
REF. SHEET:	IF101
PM:	SLB
/E:	SLB
DATE: 8-10-07	
ADDENDUM No.	ADD-4
SKETCH No.	A-11
© COPYRIGHT 2007 SMRT INC.	

DEMO NOTES:

1. ALL PRE-EXISTING STRUCTURES WITHIN THE PROPOSED BUILDING FOOTPRINT, UNDER AREAS PROPOSED FOR PAVING, AND ALONG PROPOSED UTILITY ROUTES ARE TO BE COMPLETELY REMOVED AND REPLACED WITH COMPACTED STRUCTURAL FILL.
2. STRUCTURES IN THE DEVELOPED AREA TO BE LANDSCAPED ARE TO BE REMOVED TO A DEPTH OF 24" MIN (OR AS DIRECTED) BELOW PROPOSED FINISHED GRADE AND BACKFILLED WITH APPROVED FILL.
6. ALL CONFLICTING ITEMS WITHIN THE DEVELOPMENT AREA NOT OTHERWISE NOTED SHALL BE REMOVED.

LAYOUT NOTES:

1. DO NOT SCALE THE DRAWINGS. ALL DIMENSIONS SHALL BE VERIFIED IN THE FIELD BY THE CONTRACTOR PRIOR TO CONSTRUCTION. ANY OMISSIONS IN DIMENSIONING SHALL BE REPORTED IMMEDIATELY TO THE ARCHITECT FOR DECISION. ANY DISCREPANCIES BETWEEN DRAWINGS, DETAILS, NOTES, AND SPECIFICATIONS SHALL IMMEDIATELY BE REPORTED TO THE ARCHITECT FOR FURTHER DIRECTION AND RESOLUTION BEFORE ANY ADDITIONAL WORK PROCEEDS.
2. ALL ANGLES ARE 90 DEGREES UNLESS OTHERWISE NOTED.
3. ALL PAVING, CURBS, AND STRUCTURES SHALL BE STAKED OUT BY THE CONTRACTOR AND REVIEWED BY THE ARCHITECT PRIOR TO CONSTRUCTION.
4. ALL DIMENSIONS FROM BUILDING ARE TO FACE OF BUILDING FOUNDATION. ALL DIMENSIONS FROM CURBS ARE TO FACE OF CURB.
5. PROVIDE A SMOOTH TRANSITION WHERE NEW WORK MEETS EXISTING WORK.
6. CONTRACTOR SHALL NOTIFY DIG-SAFE (1-888-344-7233) AND LOCAL UTILITY COMPANIES TO VERIFY LOCATION OF ALL EXISTING UTILITIES PRIOR TO EXCAVATION.
7. CONTRACTOR SHALL SECURE ALL NECESSARY PERMITS FOR WORK SHOWN ON THESE PLANS.
8. ALL WORK SHALL COMPLY WITH ALL LOCAL, STATE, AND FEDERAL SAFETY REGULATIONS AND MEET OR EXCEED CITY OF PORTLAND STANDARDS.
9. PROVIDE TAPERED END SECTIONS (2' MIN.) AT ALL CURB ENDS.
10. EXISTING CONDITIONS AND TOPOGRAPHIC DATA ARE BASED UPON PRELIMINARY TOPOGRAPHIC SURVEY BY HNTB, WESTBROOK, MAINE.

GRADING NOTES:

1. SOIL DISTURBANCE IS TO BE KEPT TO A MINIMUM AND ALL DISTURBED AREAS SHALL BE STABILIZED (WITH PERMANENT OR TEMPORARY MEASURES) AS QUICKLY AS POSSIBLE.
2. ALL DISTURBED AREAS NOT OTHERWISE TREATED SHALL BE LOAMED AND SEEDED (6" DEPTH).
3. ALL EROSION AND SEDIMENTATION CONTROL MEASURES SHALL BE MAINTAINED ON A REGULAR BASIS AND AS REQUIRED AFTER STORM EVENTS. SEE SPECIFICATIONS FOR DETAILS.
4. GULLIES OR OTHERWISE ERODED AREAS IN SEEDED AREAS SHALL BE RESTORED AS SOON AS POSSIBLE FOLLOWING OBSERVATION, USING EROSION CONTROL MESH TO STABILIZE AS REQUIRED.

UTILITY NOTES:

1. PROVIDE AND INSTALL MATERIALS NECESSARY TO COMPLETE UTILITY FEATURES AND DESIGN UNLESS OTHERWISE INDICATED.
2. ALL WORK SHALL MEET OR EXCEED STANDARDS OF THE CITY OF PORTLAND.
3. COORDINATE EXACT UTILITY SERVICE ENTRANCE/ EXIT LOCATION WITH MECHANICAL DRAWINGS.
4. UTILITY LOCATIONS SHOWN ARE APPROXIMATE AND SHALL BE VERIFIED BY CONTRACTOR PRIOR TO CONSTRUCTION.
5. CONTRACTOR SHALL NOTIFY DIG-SAFE (1-888-344-7233) AND LOCAL UTILITY COMPANIES TO VERIFY LOCATION OF ALL EXISTING UTILITIES PRIOR TO EXCAVATION.
6. ALL EXISTING UTILITY LOCATIONS SHOWN ARE APPROXIMATE AND HAVE BEEN DETERMINED BY SURFACE EVIDENCE AND/OR PREVIOUSLY GENERATED PLANS. NO GUARANTEE IS MADE THAT ALL UTILITIES ARE SHOWN OR WILL BE FOUND IN LOCATIONS INDICATED. THIS INFORMATION IS PROVIDED FOR REFERENCE AND THE CONTRACTOR SHALL VERIFY LOCATION OF ALL UTILITIES AND POINTS OF CONNECTION IN THE FIELD. CONTRACTOR SHALL BE RESPONSIBLE FOR REPAIR AND RESTORATION OF ALL UTILITIES DISTURBED DURING CONSTRUCTION.

LANDSCAPING NOTES:

1. THE LANDSCAPE CONTRACTOR SHALL SUPPLY AND INSTALL ALL PLANTS IN SUFFICIENT QUANTITIES TO COMPLETE THE WORK AS SHOWN ON THE DRAWINGS. DISCREPANCIES BETWEEN QUANTITIES SHOWN ON THE DRAWINGS AND THE PLANT LIST SHALL BE REPORTED IMMEDIATELY TO THE ARCHITECT AND SHALL NOT ENTITLE THE CONTRACTOR TO ADDITIONAL REMUNERATION.
2. THE LANDSCAPE CONTRACTOR IS ADVISED THAT BELOW GROUND UTILITIES EXIST ON SITE. THE LOCATIONS OF WHICH SHALL BE VERIFIED BY THE CONTRACTOR PRIOR TO COMMENCEMENT OF OPERATIONS. SHOULD THE LOCATION OF ANY PROPOSED PLANTING CONFLICT WITH ANY UTILITY, THE ARCHITECT SHALL BE NOTIFIED IMMEDIATELY FOR DECISION.
3. ANY AND ALL PAVING, CURBING, UTILITIES, LAWNS, ETC., DAMAGED AS A RESULT OF THE LANDSCAPE CONTRACTOR'S OPERATIONS SHALL BE REPLACED OR REPAIRED BY THE CONTRACTOR AT NO ADDITIONAL COST TO THE OWNER.
4. ALL PLANTING BEDS INCLUDING TREE AND SHRUB PITS AS INDICATED SHALL RECEIVE 3" APPROVED CLEAN, UNIFORMLY GROUND OR SHREDDED PINE OR HEMLOCK BARK MULCH.
5. LOCATIONS OF PROPOSED PLANTINGS AND BED LINES SHALL BE REVIEWED BY THE ARCHITECT PRIOR TO INSTALLATION.
6. THE LANDSCAPE CONTRACTOR SHALL RELOCATE ANY PLANT ACCORDING TO THE DIRECTION OF THE ARCHITECT.
7. ALL PLANT MATERIALS CALLED FOR AND INSTALLED SHALL MEET OR EXCEED SPECIFICATIONS OF THE "AMERICAN STANDARDS FOR NURSERY STOCK" (LATEST EDITION) AS SET FORTH BY THE AMERICAN ASSOCIATION OF NURSERYMEN.
8. ALL PLANTING BEDS SHALL BE DEFINED BY A NEAT, SHOVEL-CUT BED LINE. BED LINES SHALL BE TRUE TO FORM AS SHOWN ON THE DRAWINGS, CONSISTING OF SMOOTH CURVES AND SHARP LINES AND CORNERS.
9. IF, BECAUSE OF CULTURE REQUIREMENTS, AVAILABILITY, OR OTHER CIRCUMSTANCES, THE LANDSCAPE CONTRACTOR BELIEVES A PARTICULAR PLANT CALLED FOR IS INAPPROPRIATE, THE LANDSCAPE CONTRACTOR SHALL REPORT THE SITUATION IMMEDIATELY TO THE ARCHITECT FOR DECISION.
10. ALL DISTURBED AREAS NOT OTHERWISE COVERED SHALL RECEIVE 6" LOAM AND SEED.

SITE ABBREVIATION:

- | | |
|--------------------------------|----------------------------|
| AGG = AGGREGATE | OC = ON CENTER |
| ALT = ALTERNATE | PL = PROPERTY LINE |
| ARCH = ARCHITECTURAL | PVMT = PAVEMENT |
| APROX = APPROXIMATE | R = RADIUS |
| BC = BOTTOM OF CURB ELEVATION | ROW = RIGHT-OF-WAY |
| BIT = BITUMINOUS | RT = RIGHT |
| BS = TOP OF STEP ELEVATION | S = SLOPE |
| CIP = CAST-IN-PLACE | SHT = SHEET |
| CL = CENTER LINE | STA = STATION |
| CLR = CLEAR | STRUCT = STRUCTURAL |
| CLL = CONTRACT LIMITS LINE | TP = TEST PIT |
| CONT = CONTINUOUS | TC = TOP OF CURB ELEVATION |
| D = DIAMETER | TS = TOP OF STEP ELEVATION |
| ELEC = ELECTRICAL | W/ = WITH |
| EOP = EDGE OF PAVEMENT | W/O = WITHOUT |
| EXT = EXTERIOR | |
| FFE = FINISHED FLOOR ELEVATION | |
| GA = GAUGE | |
| GV = GATE VALVE | |
| HC = HANDICAP | |
| HP = HIGH POINT ELEVATION | |
| I = INCLUDED ANGLE | |
| ID = INSIDE DIAMETER | |
| L = LENGTH | |
| LF = LEFT | |
| MECH = MECHANICAL | |
| MFR = MANUFACTURER | |
| MISC = MISCELLANEOUS | |
| NCB = NEW CATCH BASIN | |
| NDMH = NEW DRAIN MANHOLE | |
| NFM = NEW FORCE MAIN | |
| NOE = NEW OVERHEAD ELECTRIC | |
| NOT = NEW UNDERGROUND TELECOM | |
| NSD = NEW STORM DRAIN LINE | |
| NSS = NEW SANITARY SEWER LINE | |
| NTS = NOT TO SCALE | |
| NUD = NEW UNDERDRAIN | |
| NUE = NEW UNDERGROUND ELECTRIC | |
| NUT = NEW UNDERGROUND TELECOM | |
| NW = NEW WATER LINE | |

SITE DATA

ZONE: IM, MODERATE IMPACT INDUSTRIAL ZONE FAA RPZ, RUNWAY PROTECTION ZONE		
USE: OFFICE BUILDING, PERMITTED USE		
PARCEL SIZE: 6.78 AC. PARCEL ID#: 233-A004-001 233-A008-001		
SPACE STANDARDS	REQUIRED	PROPOSED
MINIMUM LOT SIZE	NONE	6.78 AC.
MINIMUM STREET FRONTAGE	60 FEET	204.06'
MAXIMUM BUILDING HEIGHT	75 FEET	48'
MINIMUM FRONT YARD	48'	353'
MINIMUM REAR & SIDE YARDS	25'	141'+
PAVEMENT SETBACK	10'	25'+
BUILDING AREA	---	54,817 SF
PARKING SPACES	138	192
IMPERVIOUS SURFACE	75% MAX	47%

CIVIL LEGEND:

PROPOSED ITEM	SYMBOL:
EDGE OF BUILDING W/DOOR	
CHAINLINK FENCE	X
BITUMINOUS DRIVE	
GRAVEL DRIVE	
BITUMINOUS WALK	
GRANITE CURB (VERTICAL)	
CONCRETE (C.I.P.)	
GRANITE CURB (SLOPED)	
WETLAND BOUNDARY	
RIP RAP INLET/OUTLET	
BOLLARD LIGHT	
LIGHT POLES	
FIRE HYDRANT	
CONC. BOLLARD	
STORM DRAIN PIPE (W/ SIZE)	6" NSD
UNDER DRAIN (W/ SIZE)	4" NUD
WATER PIPE (W/ SIZE)	4" NW
UNDERGROUND ELEC. & COMM.	NUE/C
FORCE MAIN PIPE (W/ SIZE)	4" NFM
OVERHEAD ELECTRIC	NOE
OVERHEAD COMMUNICATIONS	NOC
UNDERGROUND ELECTRIC	NUE
UNDERGROUND COMMUNICATIONS	NUC
SEWER PIPE (W/ SIZE)	4" NSS
CATCH BASIN	NCB
DRAIN INLET	NDI
SANITARY MANHOLE	NSMH
DRAIN MANHOLE	NDMH
ORNAMENTAL FENCE	
CHAINLINK SECURITY FENCE	
UTILITY POLE	Ø NUP
WATER GATE	GV
PROPERTY LINE	
EASEMENT, RIGHT-OF-WAY, SETBACK	
BOTTOM OF STEP ELEV.	+BS
TOP OF STEP ELEV.	+TS
TOP OF CURB ELEV.	+TC-OR-144.5/
BOTTOM OF CURB ELEV.	+BC-OR-/144.0
HIGH POINT ELEV.	+HP
LOW POINT ELEV.	+LP
SEDIMENT BARRIER BERM	SB
SILT FENCE	SF
SLOPE IS 1.3%	S=.013
CONTOURS	
PLUNGE POOL	
DIRECTION OF FLOW	
STONE CHECK DAM	
EROSION CONTROL MESH	
TEST PIT W/ REFERENCE	TS TP B-3
TRAFFIC CONTROL SIGN	
STRIPING ON PAVEMENT	
DRIP STRIP	
TRANSFORMER & CONCRETE PAD	T
LIMIT OF WORK	

NOTE:
THIS LEGEND IS FOR REFERENCE ONLY AND APPLIES ONLY TO THE CIVIL DRAWINGS. NOT ALL ITEMS SHOWN HEREIN MAY APPEAR ON THE DRAWINGS, OR BE INCORPORATED IN THE DESIGN.

AS BUILT
Cover Copy



ARCHITECTURE ENGINEERING PLANNING
SMRT
144 Fore Street/P.O. Box 618
Portland, Maine 04104
tel. (207) 772-3846
fax. (207) 772-1070





PROJECT TITLE:
MAINE TURNPIKE AUTHORITY
ADMINISTRATION BUILDING
PORTLAND, MAINE
ISSUED FOR BIDDING/CONSTRUCTION
7-9-07

REV	DESCRIPTION	DATE
0	BIDDING/CONSTRUCTION	7-9-07

GRAPHIC SCALE:
0" 1"
SCALE: SHOWN
PROJECT MANAGER: SLB
JC/DRAWN BY: TCM/PAF
A/E OF RECORD: MGJ
CAD FILE: 06016-0001
PROJECT NO: 06016
DATE: 7-9-07
SHEET TITLE:

NOTES AND LEGEND
SHEET No. C001

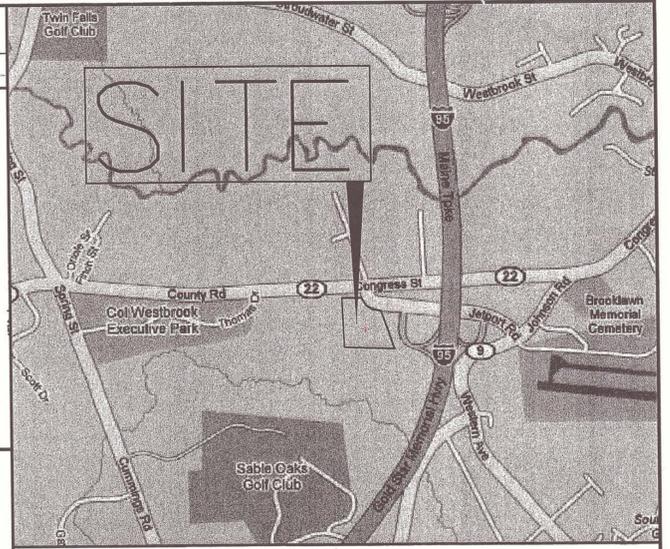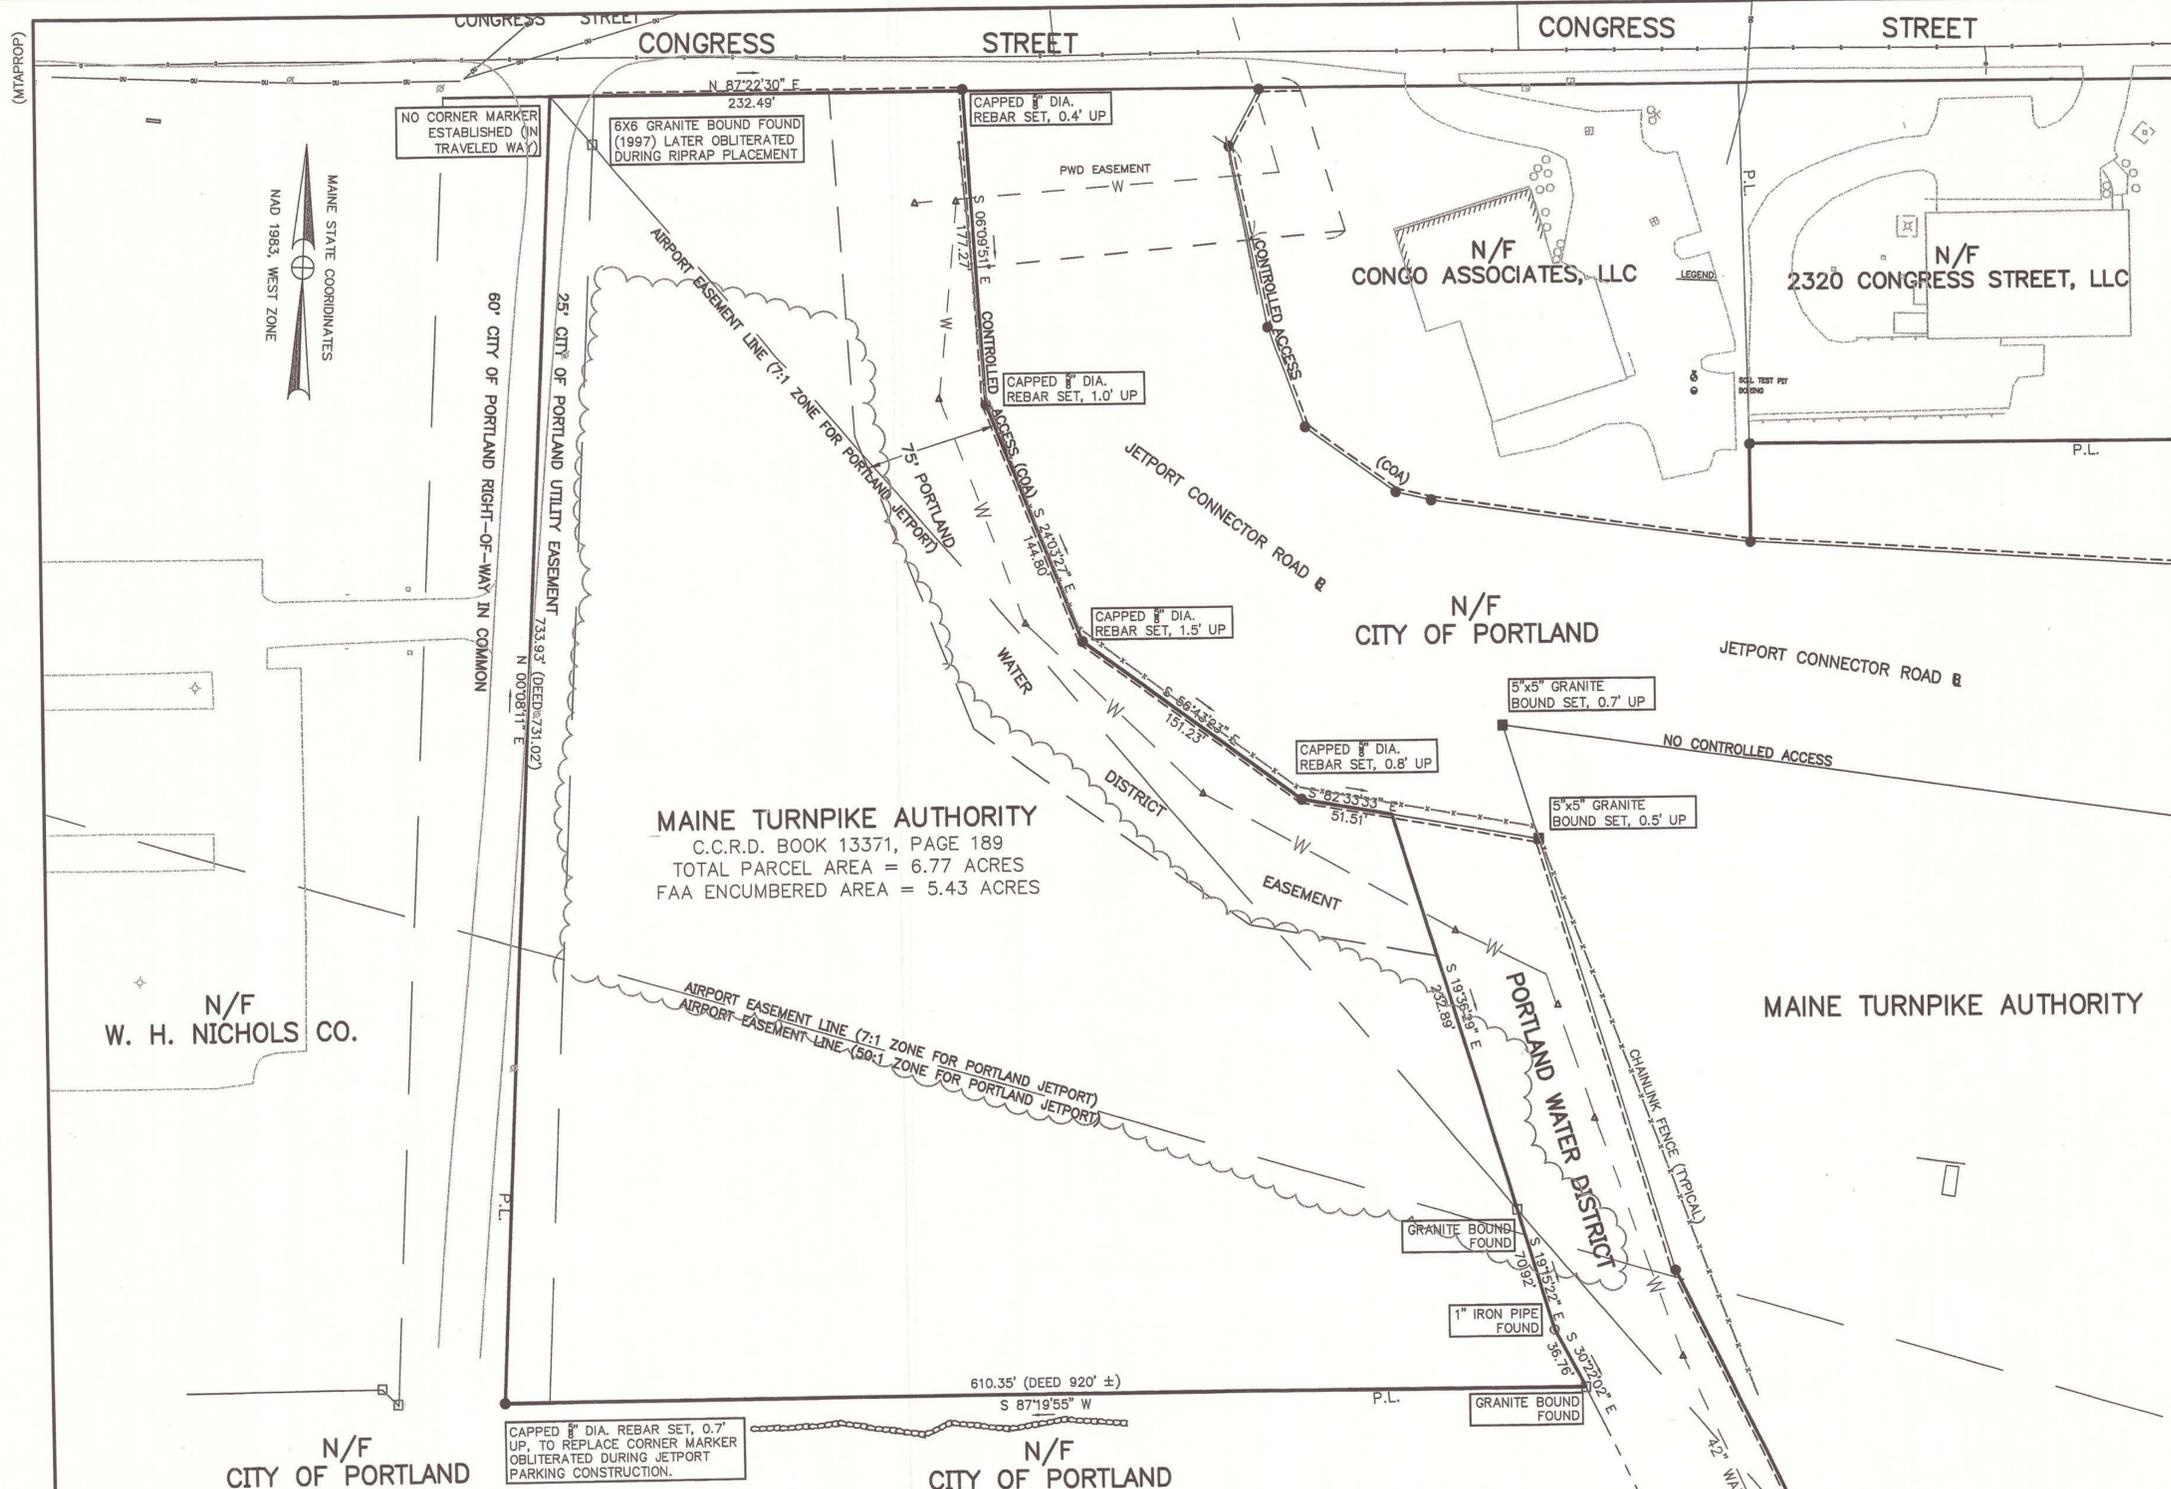

- NOTES:**
- SEE ALSO THE PROPERTY AND RIGHT-OF-WAY REFERENCES BELOW.
- DEED FROM W. H. NICHOLS COMPANY TO PORTLAND WATER DISTRICT DATED APRIL 4, 1967 AND RECORDED IN THE C.C.R.D BOOK 2990, PAGE 627.
 - DEED FROM HARRY A. HARMON AND GEORGE M. HUTCHINS TO PORTLAND WATER DISTRICT DATED 1979 AND RECORDED IN THE C.C.R.D BOOK 4514, PAGE 130.
 - DEED FROM PORTLAND WATER DISTRICT TO THE CITY OF PORTLAND DATED JULY 17, 2002 AND RECORDED IN THE C.C.R.D BOOK 17855, PAGE 214.
- PLAN REFERENCE:**
- PLAN OF FAR PART 77 ANALYSIS OF PRECISION APPROACH TO RUNWAY 11 FOR PORTLAND INTERNATIONAL JETPORT BY DUFRESNE-HENRY DATED JUNE 2004.
 - PLAN OF STANDARD BOUNDARY SURVEY FOR THE CITY OF PORTLAND (PORTLAND INTERNATIONAL JETPORT) BY DUFRESNE-HENRY DATED OCTOBER 30, 1997.
 - PLAN OF JETPORT INTERCHANGE PROJECT, PROPERTY AND RIGHT-OF-WAY PLAN FOR THE MAINE TURNPIKE AUTHORITY BY HNTB CORPORATION SHEETS 1 & 4 OF 11, SUPPLEMENTAL SHEETS DATED FEBRUARY 1997.
 - PLAN OF PROPOSED UTILITY AND ACCESS EASEMENT DATED JULY 12, 1979.

AS BUILT
Owner Copy

LEGEND

— NEW R/W	— EXISTING RIGHT OF WAY	○ I.P.F. (IRON PIPE or PIN) FOUND
— UT — UT — UNDERGROUND WIRE OR CABLE	— W — W — WATER LINE or MAIN	□ S.B.F. (STONE/CONCRETE BOUND) FOUND
— CONSTRUCTION LIMIT LINE — LIMIT OF HIGHWAY EASEMENT	— S — S — SEWER LINE	● I.P. (IRON PIPE or PIN) TO BE SET
— GRADING LIMITS — GRADING RIGHTS (TOE OF SLOPE)	— P.L. — PROPERTY LINE	■ S.B. (STONE/CONCRETE BOUND) TO BE SET

CONTROLLED ACCESS LIMIT (COA)

CONTROLLED ACCESS LIMIT LINE ALONG R/W LINE

CONTROLLED ACCESS LIMIT LINE NOT ON R/W LINE

NOTE:
NO ACCESS WILL BE PERMITTED TO OR FROM THE MAINE TURNPIKE AND ADJOINING PROPERTIES WITHIN BOUNDARIES DEFINED BY CONTROLLED ACCESS LIMIT LINES.

RECORDING

CUMBERLAND,ss Registry of Deeds

Received _____

At _____ h _____ m _____ M

Filed _____

Attest _____

Registrar

PROPERTY AND RIGHT-OF-WAY REFERENCES

GRANTOR	INSTRUMENT	DATE	BOOK	PAGE
S. B. HOLDINGS	QUITCLAIM DEED	10/10/97	13371	189
PORTLAND WATER DISTRICT	QUITCLAIM DEED	1/19/99	14481	191
PORTLAND WATER DISTRICT	EASEMENT	12/3/98	14359	320
C & A PROPERTIES	QUITCLAIM DEED	9/21/99	15057	16
MAINE TURNPIKE AUTHORITY	QUITCLAIM DEED	9/21/99	15057	10
GEORGE M. HUTCHINS	NOTICE OF L&T	3/31/97	13008	18

REVISIONS

NO.	DESCRIPTION	BY	DATE
1	UPDATED REFERENCES, NOTES, ETC.	PPD	1/10/07

MITA CONTRACT NO.: 2007.XX

DATE: FEBRUARY 1997

SCALE: 1" = 50'

SHEET NO.: 1 OF 1 DRAWING NO.: SUPPLEMENTAL 105

MAINE TURNPIKE AUTHORITY
MAINE TURNPIKE
PROPERTY AND RIGHT-OF-WAY PLAN
SECTION 1 - KITTERY TO PORTLAND

ADMINISTRATION BUILDING
2360 CONGRESS STREET, CITY OF PORTLAND,
CUMBERLAND COUNTY, MAINE

RECOMMENDED BY: **HNTB**
ARCHITECTS ENGINEERS PLANNERS

ROLAND A. LAVALLEE PROJECT MANAGER
APPROVED BY: MAINE TURNPIKE AUTHORITY

PAUL E. VIOLETTE EXECUTIVE DIRECTOR

E-Z-Plan


Designed: DOH 12/96
Drawn: PPD 2/97
Checked: PPD 3/97

In Charge Of: RAL

STATE OF MAINE
PAUL P. DANFORTH
REGISTRAR

Date: 1/18/2007

Filename: ...CAD\002_ExistCond.dgn

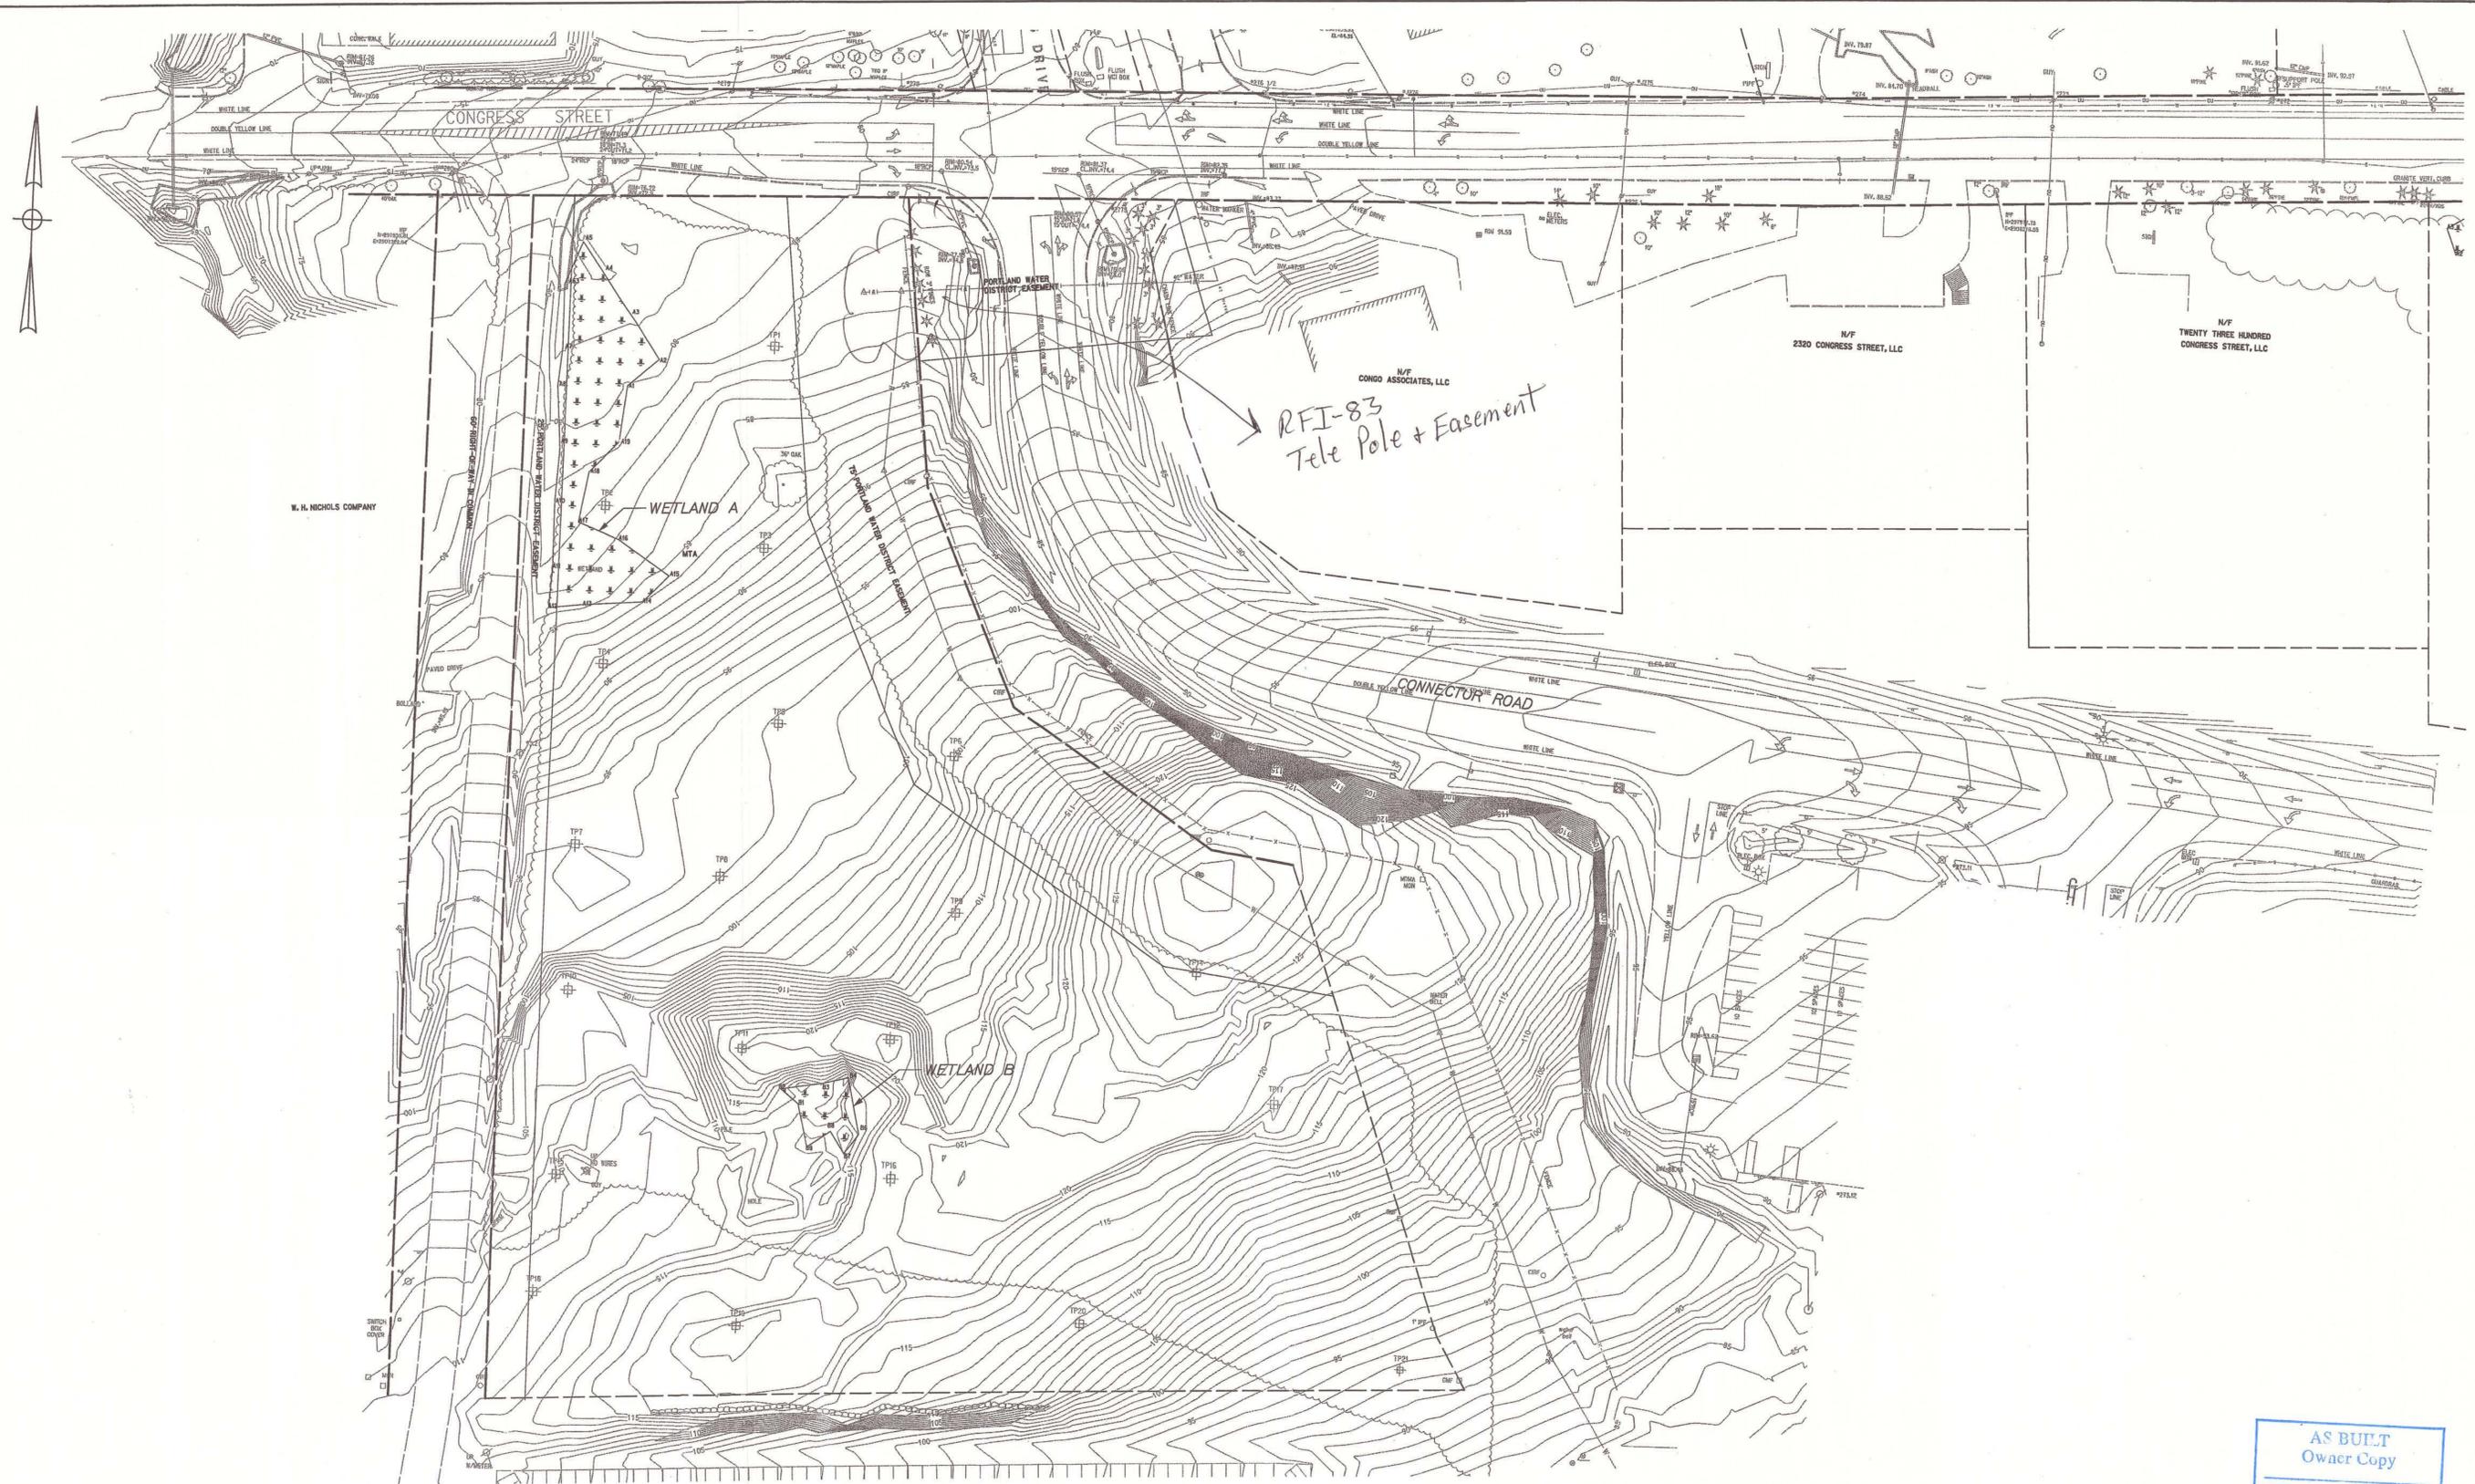

Scale: 50 0 50 100
SCALE

No.	Revision	By	Date

Designed by:

HNTB

	By	Date	Checked	By	Date
Designed	WRF	01/07		GAB	01/07
Drawn	MPC	01/07	In Charge of	RAL	01/07

PE Stamp:

ROLAND A. LAVALLEE
No. 6452
LICENSED PROFESSIONAL ENGINEER

Roland A. Lavallee

HNTB

2 Thomas Drive
Westbrook, ME 04092
TEL (207) 774-5155
FAX (207) 772-7410

MAINE
TURNPIKE



**THE GOLD STAR
MEMORIAL HIGHWAY**

TURNPIKE HEADQUARTERS

EXISTING
CONDITIONS PLAN


CONTRACT: 2007.07

AS BUILT
Owner Copy

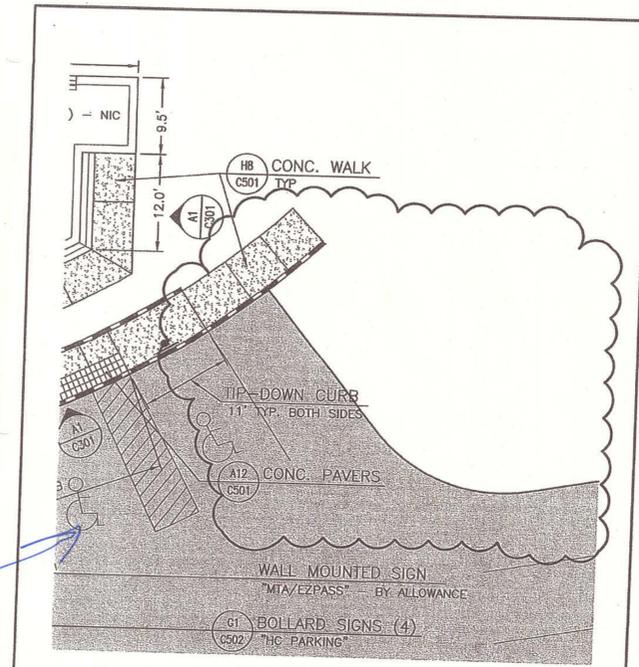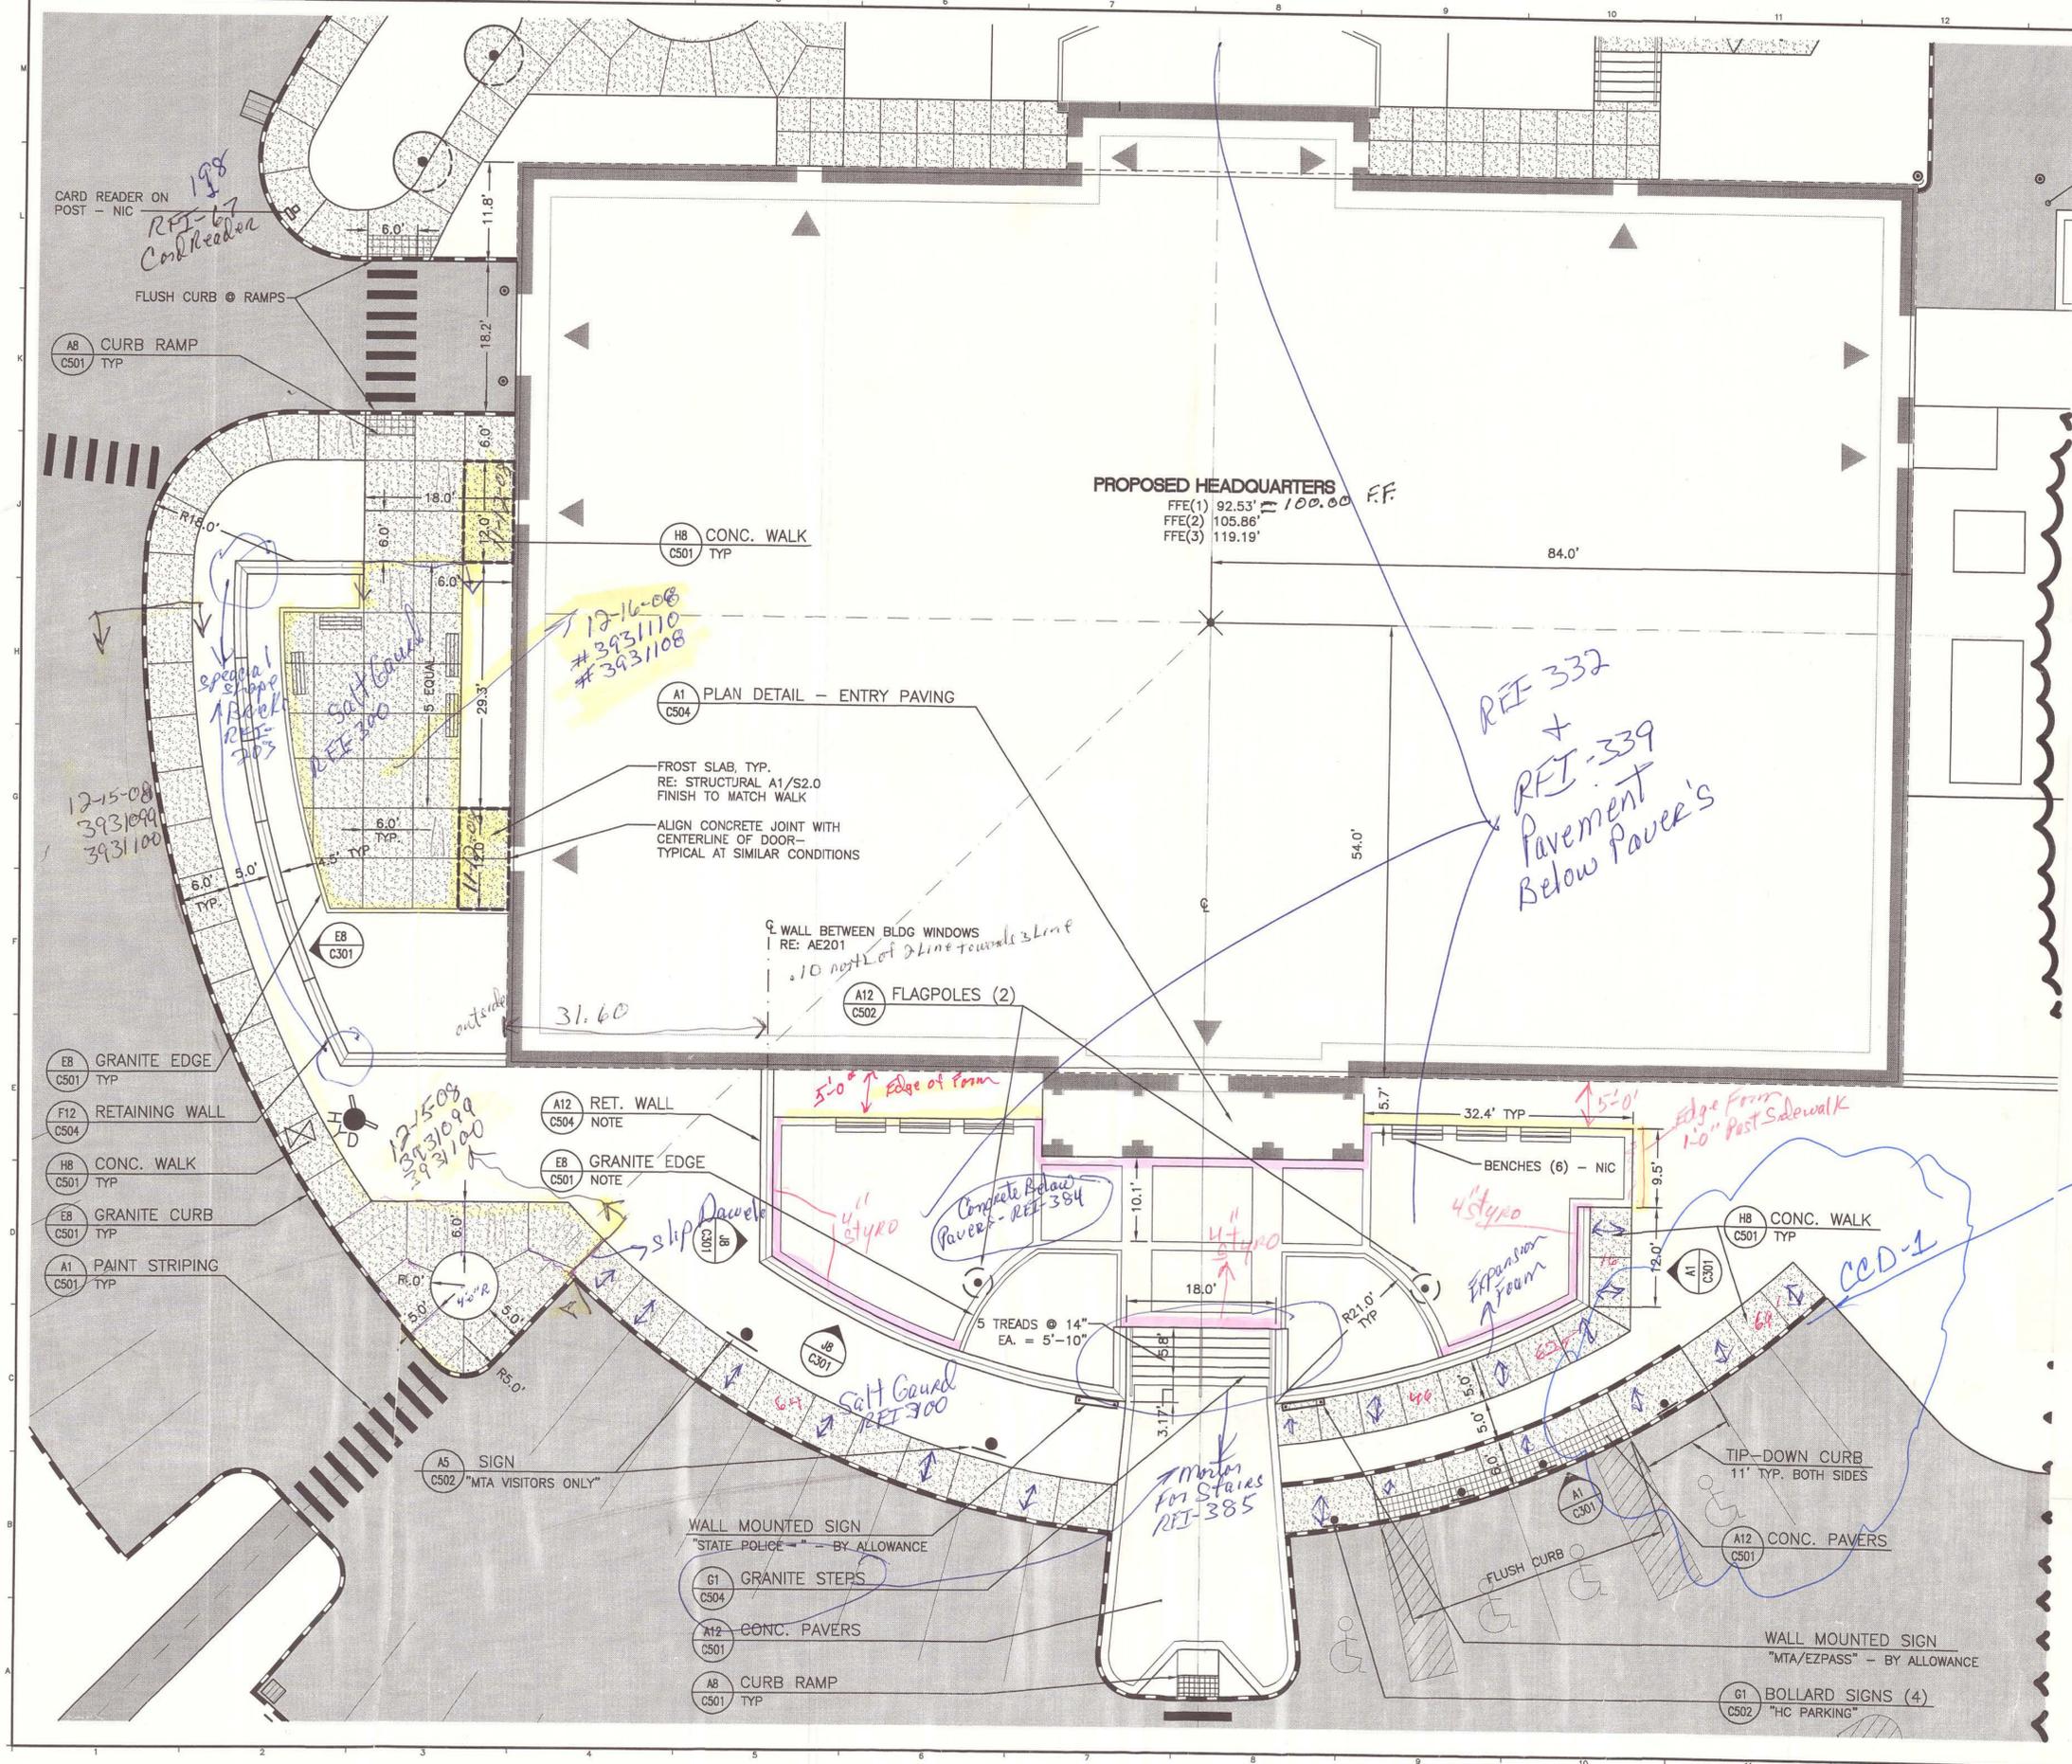


SM RT	ARCHITECTURE ENGINEERING PLANNING	SCALE: 1" = 10'
	SMRT 144 Fore Street / P.O. Box 618 PORTLAND, MAINE 04104 Tel. (207) 772-3846 / Fax. (207) 772-1070	CAD FILE: CP201-06016
PROJECT:	MAINE TURNPIKE AUTHORITY ADMINISTRATION BUILDING	PROJECT No. 06016
SUBJECT:	PARKING LOT RECONFIGURATION	REF. SHEET: CP201
		PM: SLB
		A/E: MGJ
		DATE: 11-30-07
		C-2

AS BUILT
 Owner Copy

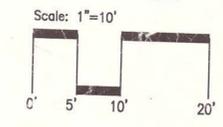

SCALE: SHOWN
PROJECT MANAGER: SLB
JC/DRAWN BY: TCM/PAF
A/E OF RECORD: MGJ
CAD FILE: 06016-CP201
PROJECT No. 06016
DATE: 7-9-07
SHEET TITLE: DETAIL LAYOUT PLAN
SHEET No. CP201

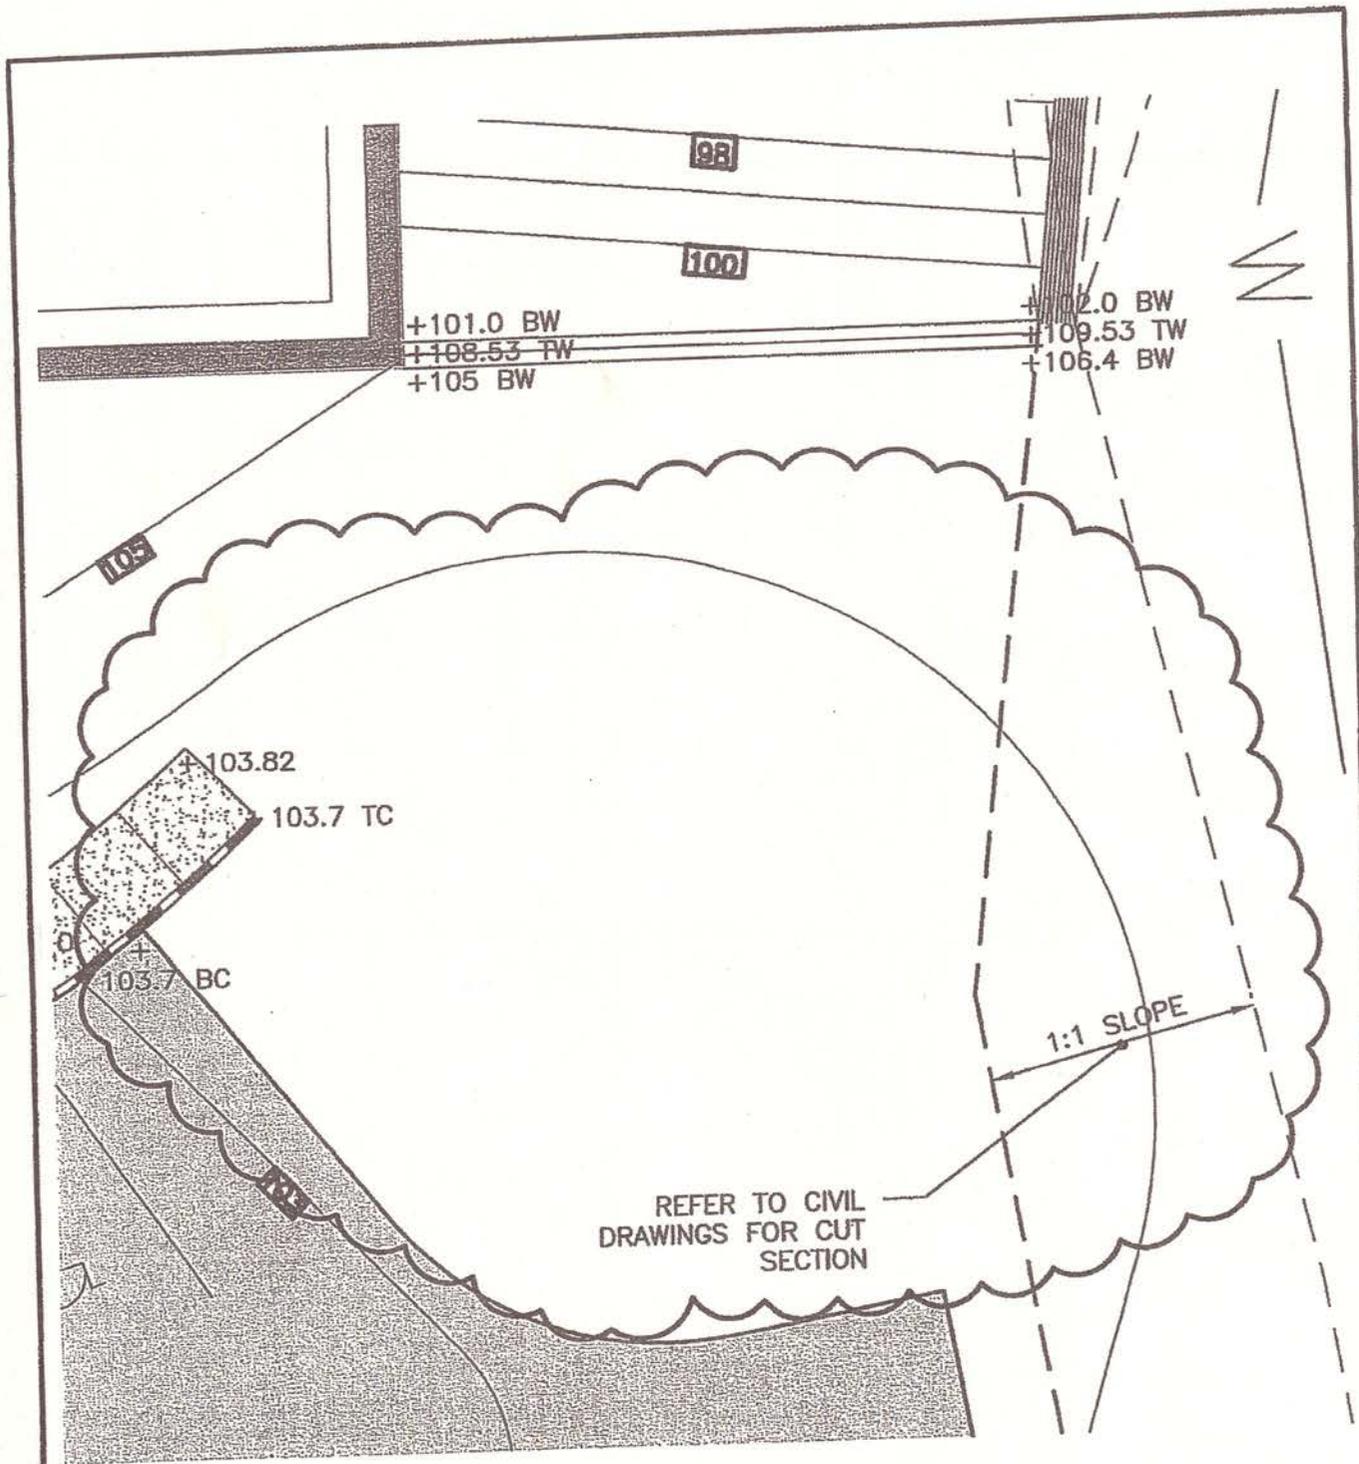

**SM
RT**

ARCHITECTURE ENGINEERING PLANNING

SMRT

144 Fore Street/P.O.Box 618 PORTLAND, MAINE 04104
tel. (207) 772-3846 / fax. (207) 772-1070

PROJECT:

**MAINE TURNPIKE AUTHORITY
ADMINISTRATION BUILDING**

SUBJECT:

**PARKING LOT @ LEDGE
RECONFIGURATION**

SCALE: 1" = 10'

CAD FILE: CG201-06016

PROJECT No. 06016

REF. SHEET: CG201/CG202

PM: SLB


SUPPLEMENTAL INSTRUCTION
CCD-1

A/E: MGJ

SKETCH No. **C-3**

DATE: 11-30-07

© COPYRIGHT 2007 SMRT INC.

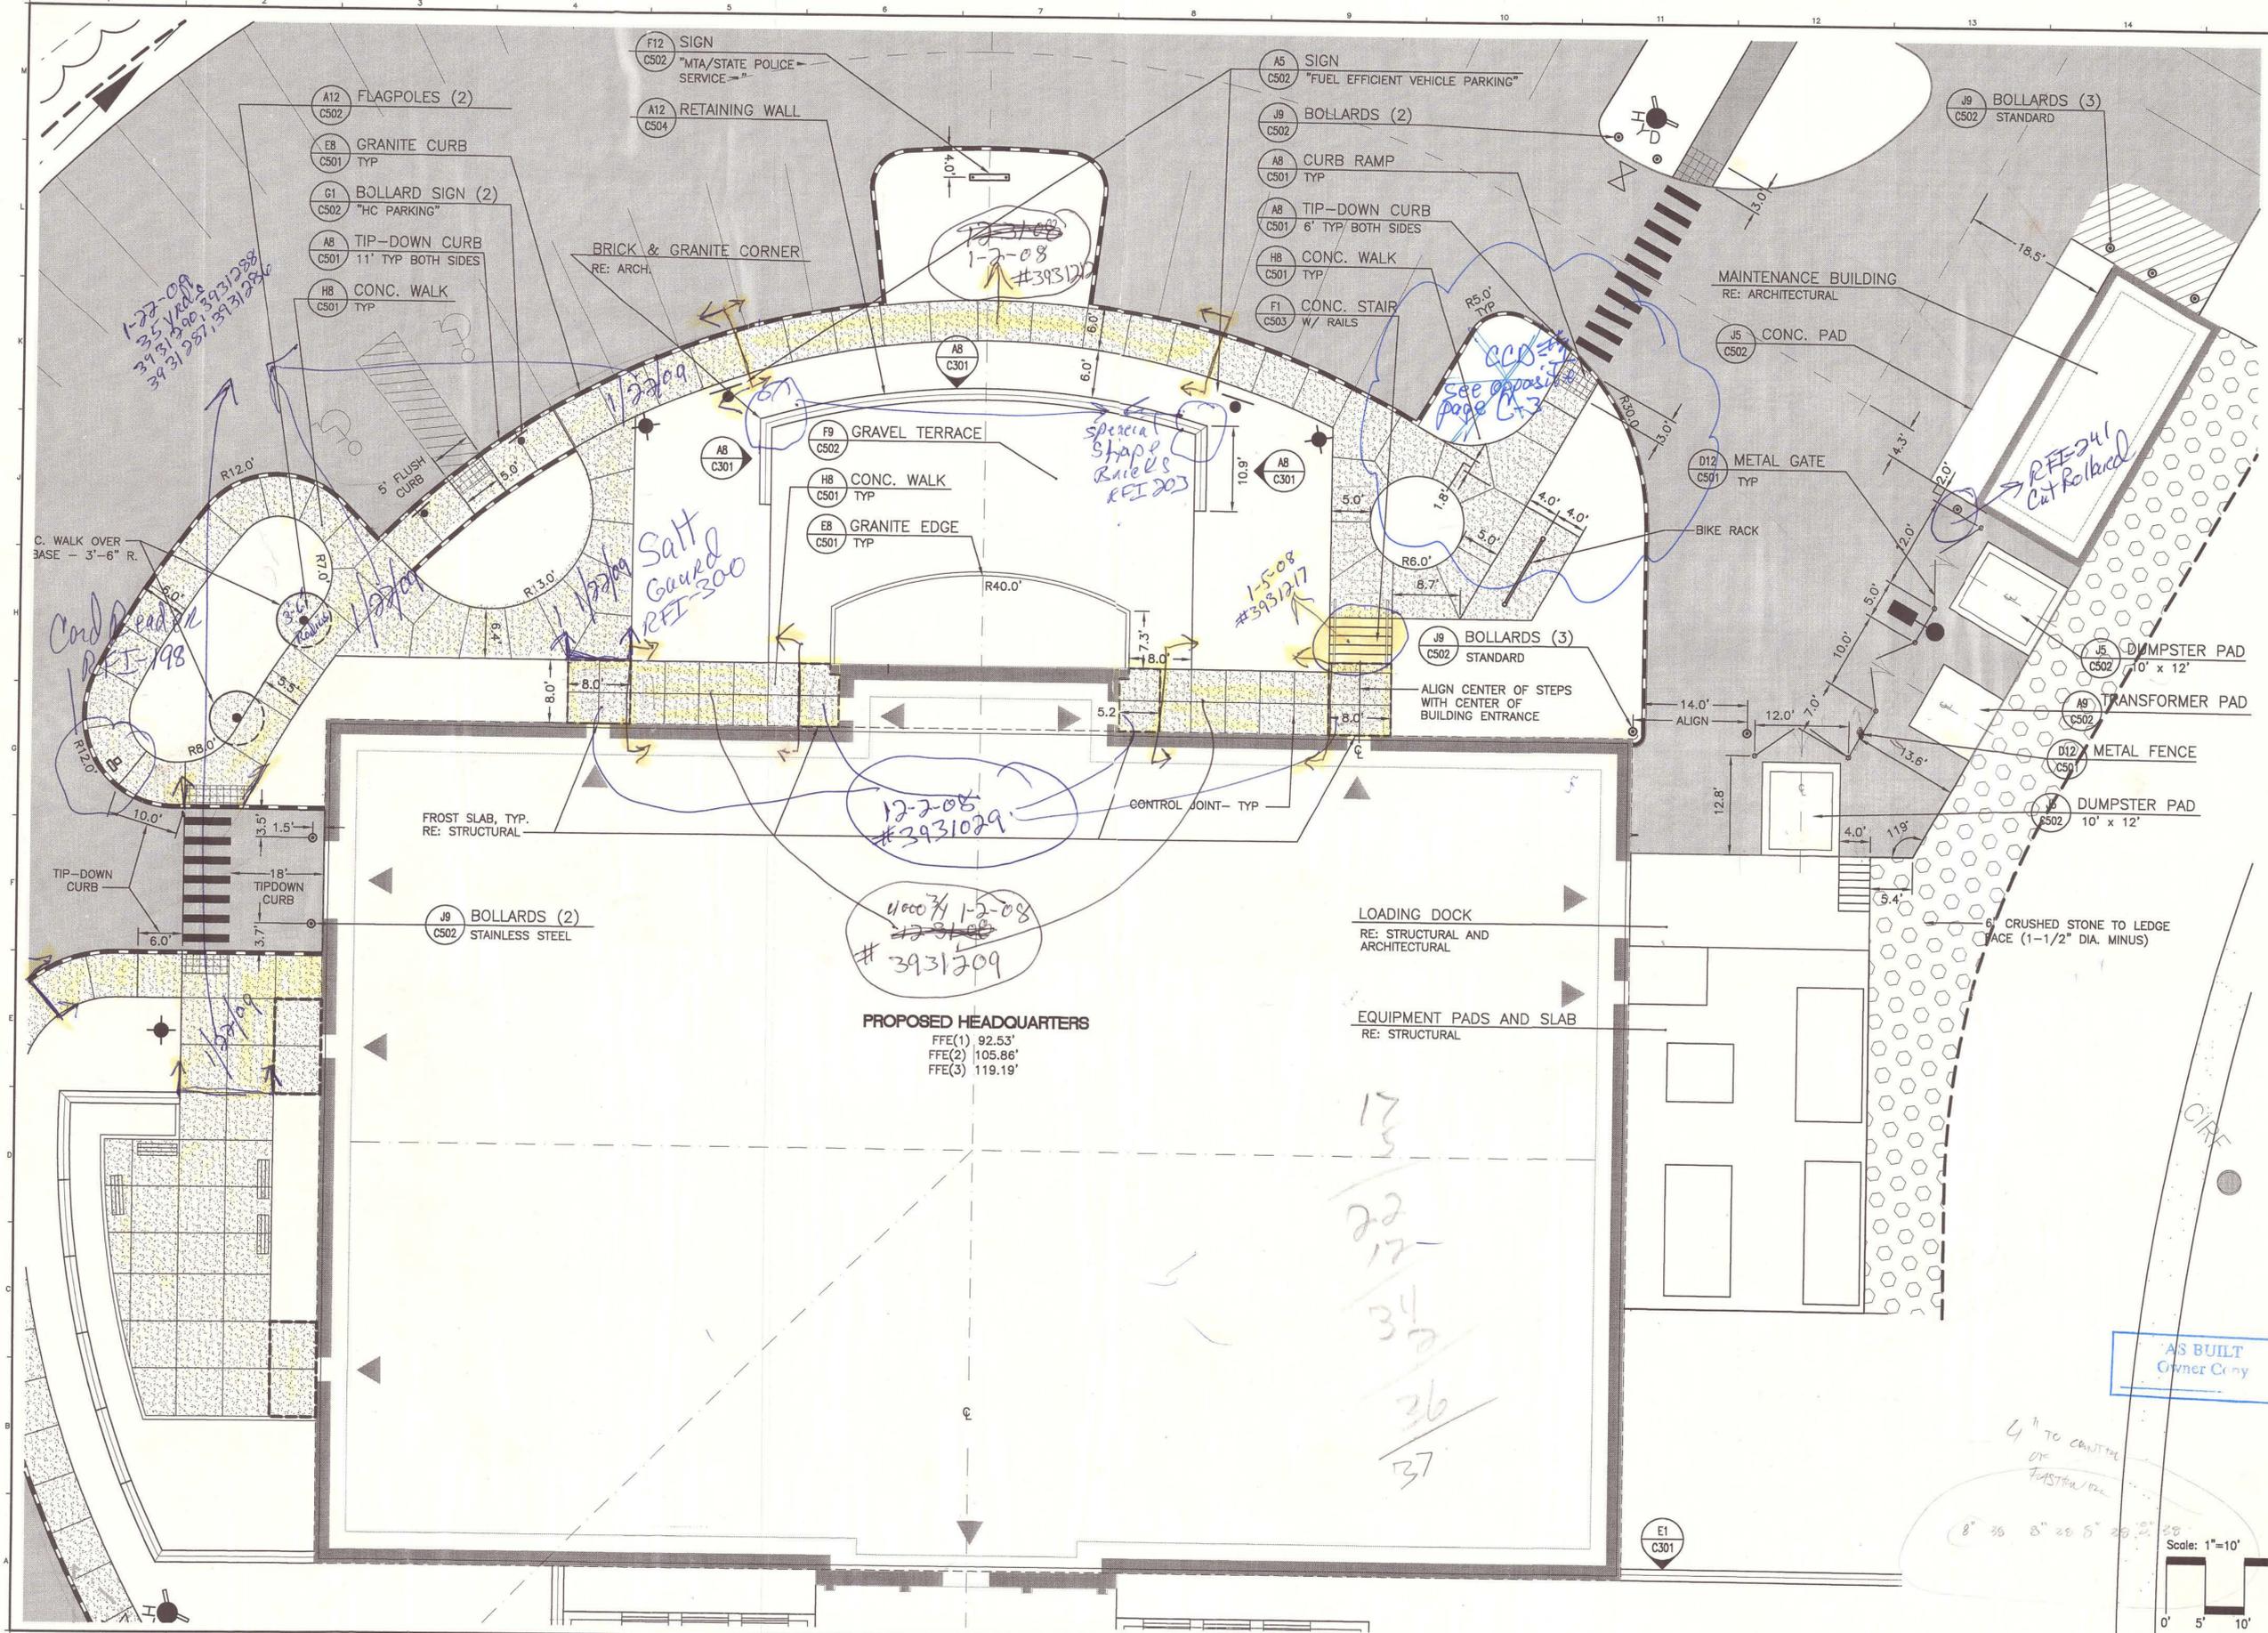

ARCHITECTURE ENGINEERING PLANNING
 SHIRT
 MARK G. JOHNSON
 NO. 1857
 LICENSED LANDSCAPE ARCHITECT
 144 Fore Street / 2nd Fl. Box 618
 Portland, Maine 04104
 tel. (207) 772-3846
 fax. (207) 772-1070




PROJECT TITLE:
**MAINE TURNPIKE AUTHORITY
 ADMINISTRATION BUILDING**
 PORTLAND, MAINE
ISSUED FOR BIDDING/CONSTRUCTION
 7-9-07

REV	DESCRIPTION	DATE
0	BIDDING/CONSTRUCTION	7-9-07

GRAPHIC SCALE:
 0" 1"
 SCALE: SHOWN
 PROJECT MANAGER: SLB
 JC/DRAWN BY: TCM/PAF
 A/E OF RECORD: MGJ
 CAD FILE: 06016-CP202
 PROJECT NO: 06016
 DATE: 7-9-07
 SHEET TITLE:
DETAIL LAYOUT PLAN






SHEET No. **CP202**

AS BUILT
 Owner Copy

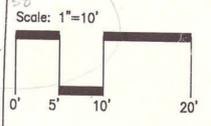

Handwritten notes in the center of the plan:
 17
 22
 12
 34
 36
 37


Handwritten notes at the bottom right:
 4" TO CENTER
 OF
 FASTENERS
 8" 36 8" 20 5" 20 2"

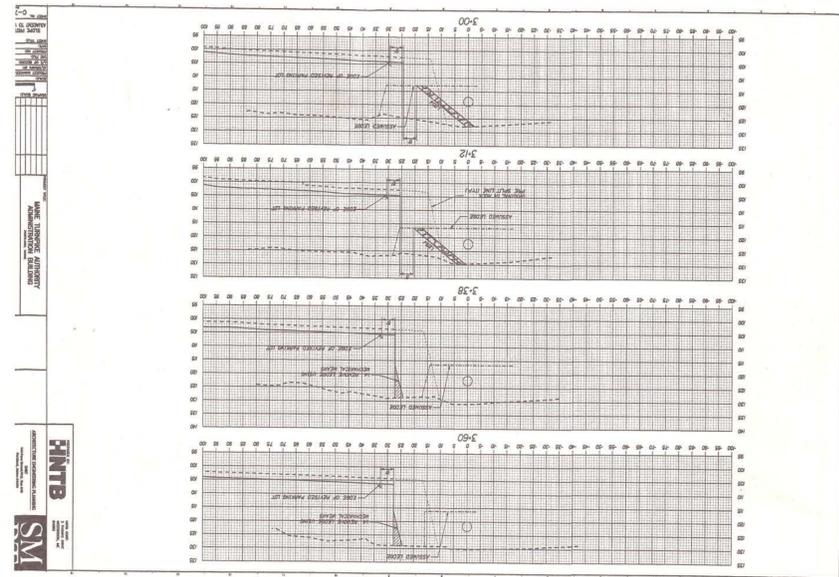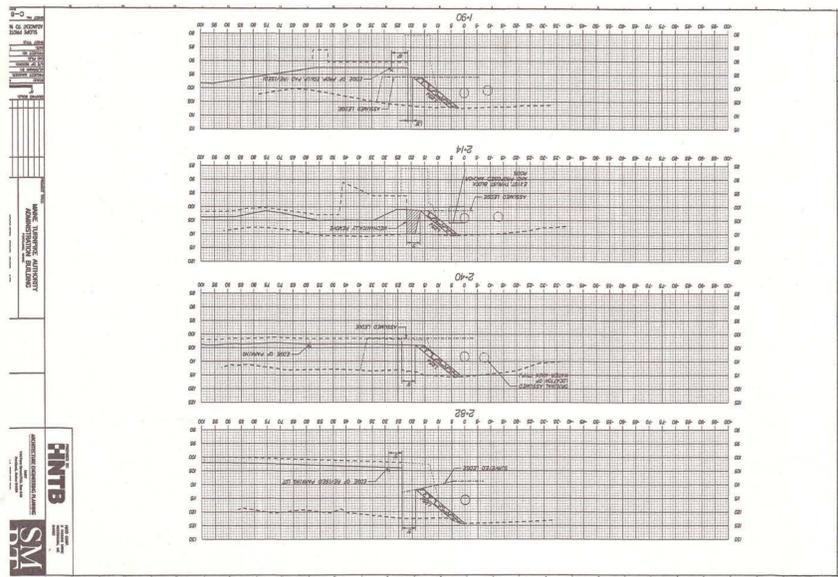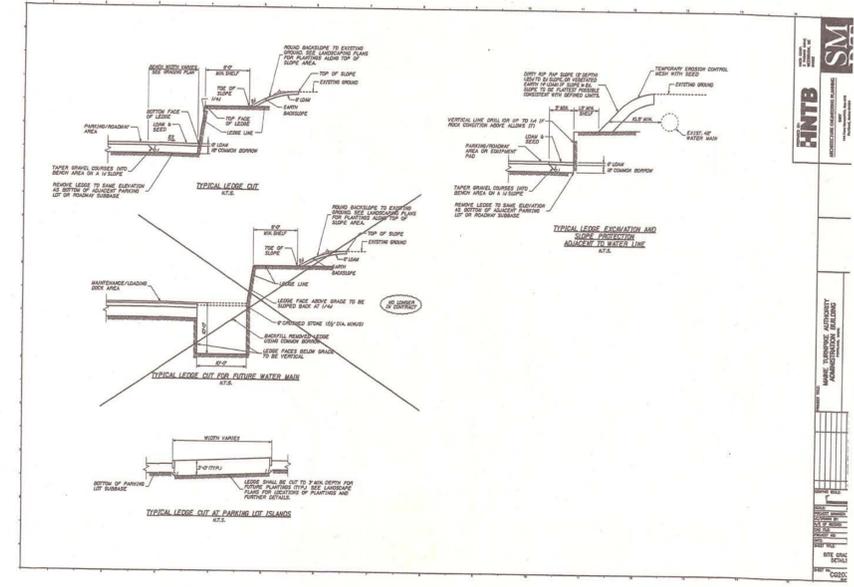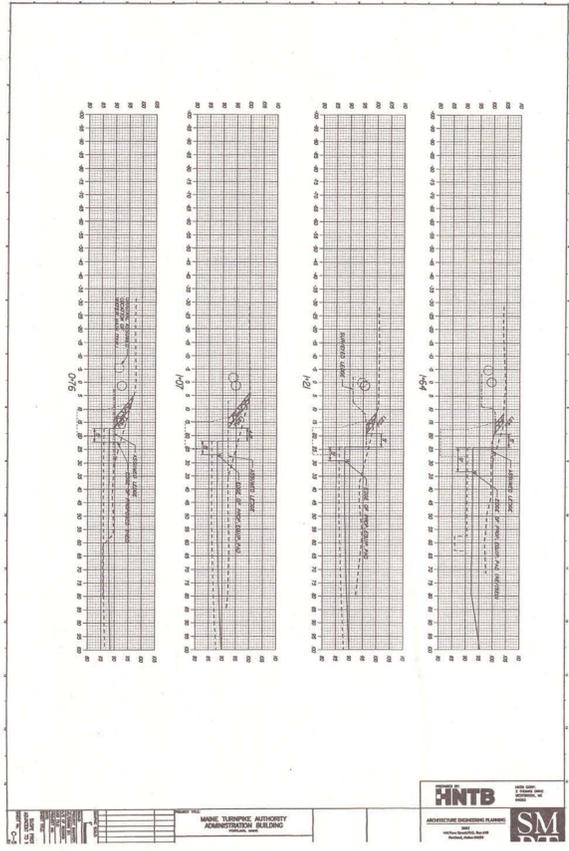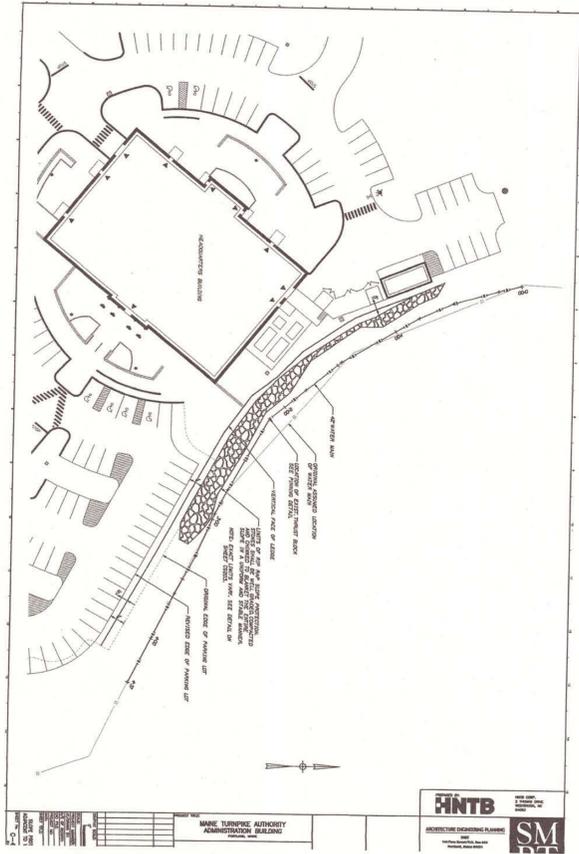


UTILITY OFFSETS



For UNDERGROUND WATER	Job No.	Sheet No.
Made by JHT	Checked by	Backchecked by
Date 4-9-08	Date	Date

HNTB

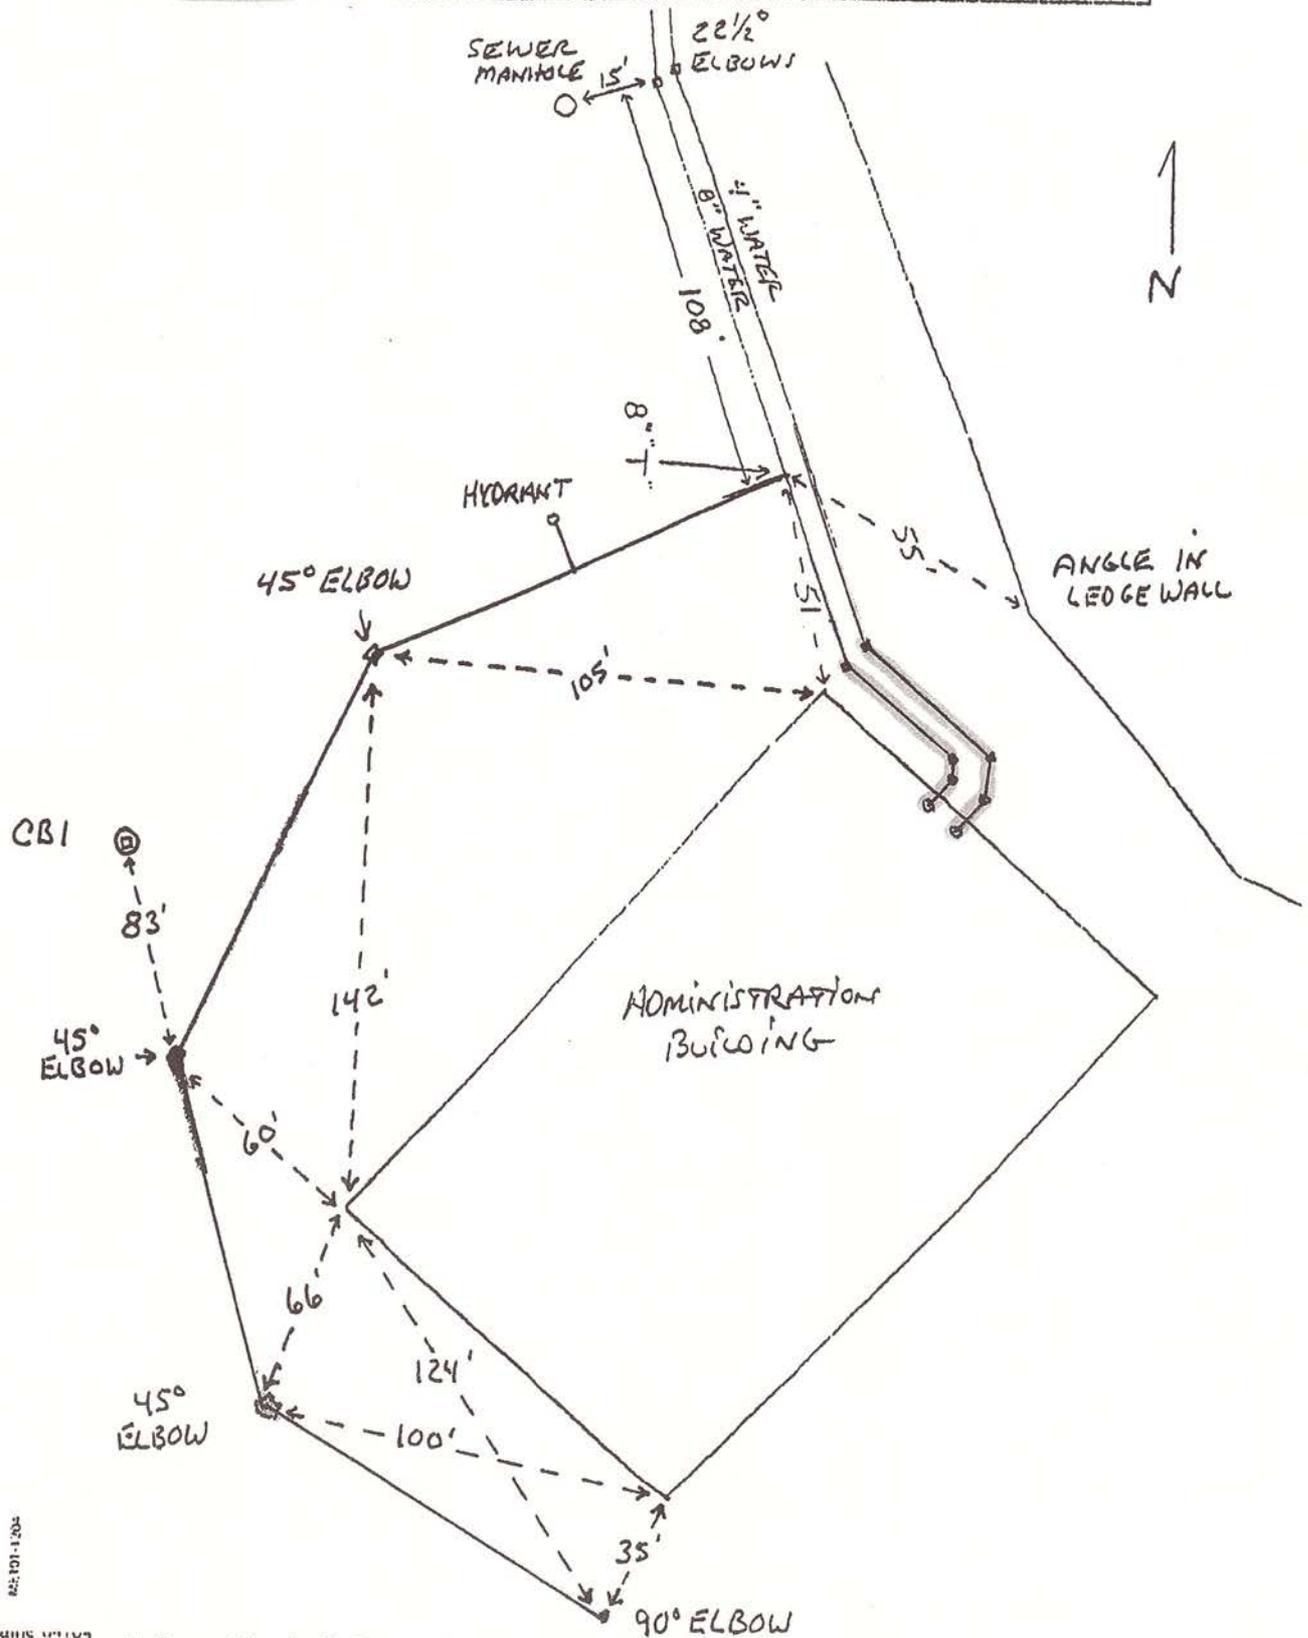

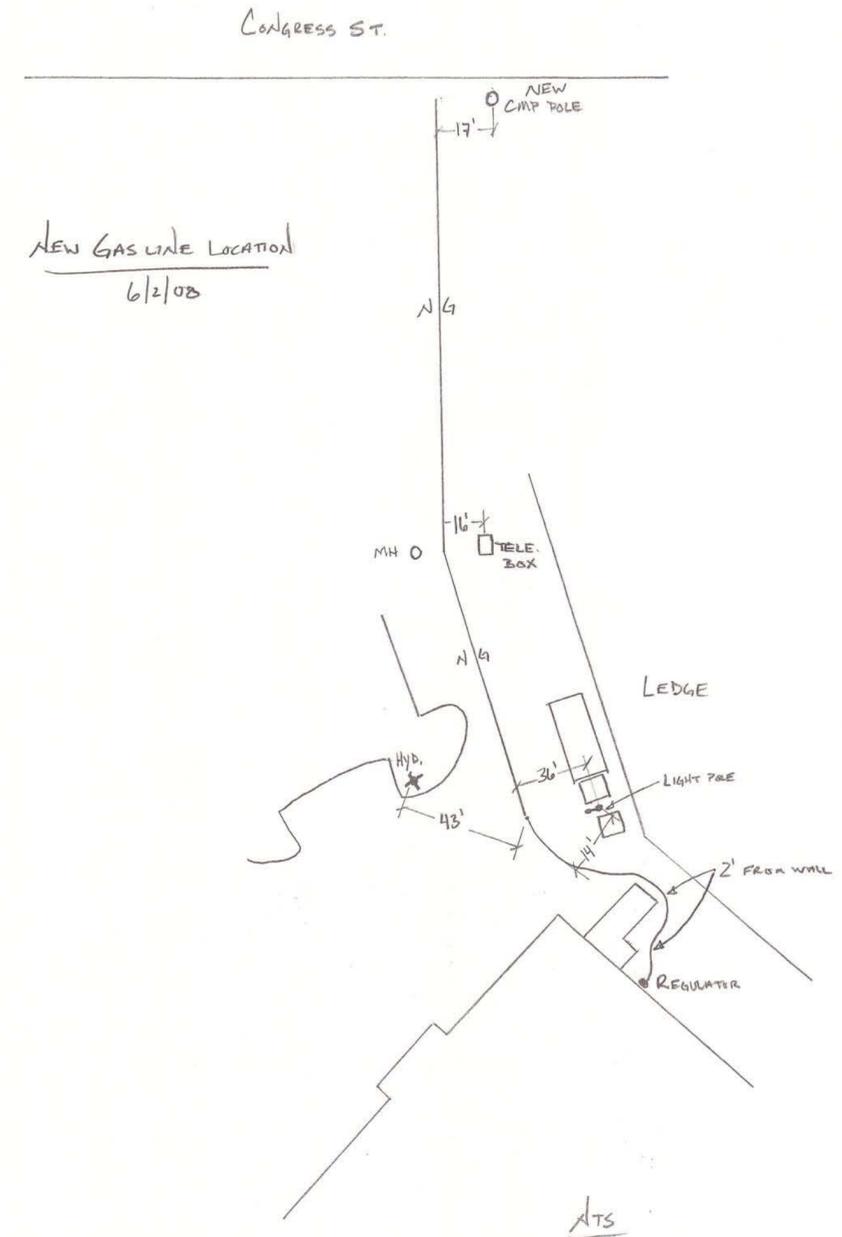


Calculations For <i>MTA HQ - UTILITY EXITS</i>	Job No.	Sheet No.
Made by <i>JPA</i>	Date <i>5/8/08</i>	
Checked by	Date	
Backchecked by	Date	

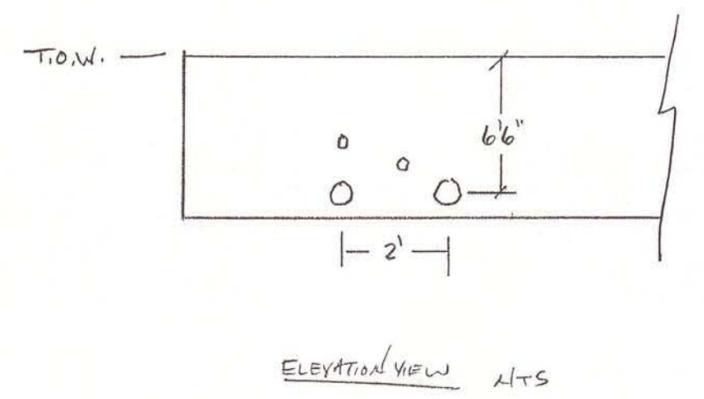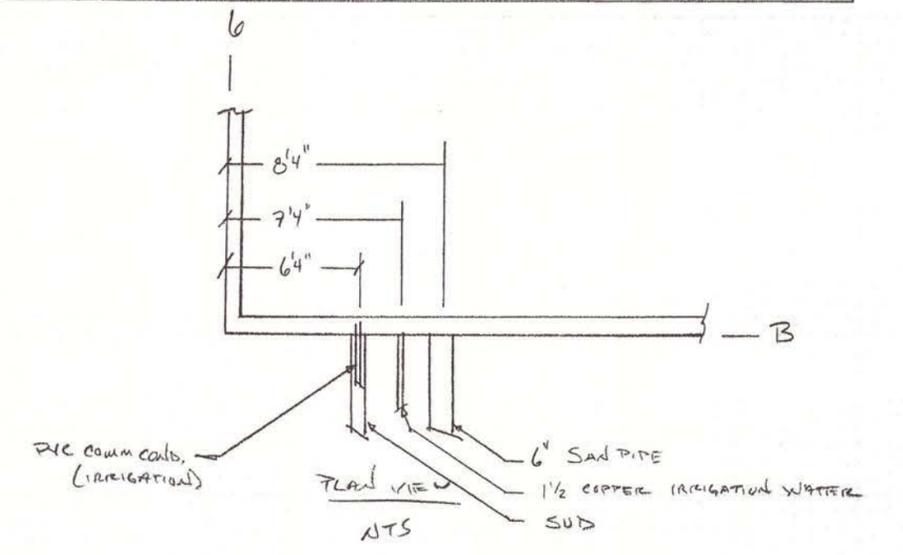


Calculations For 6" SAN EXIT	Job No. 2007.07	Sheet No.
Made by JRD	Date 5/13/08	
Checked by	Date	
Backchecked by	Date	

HNTB

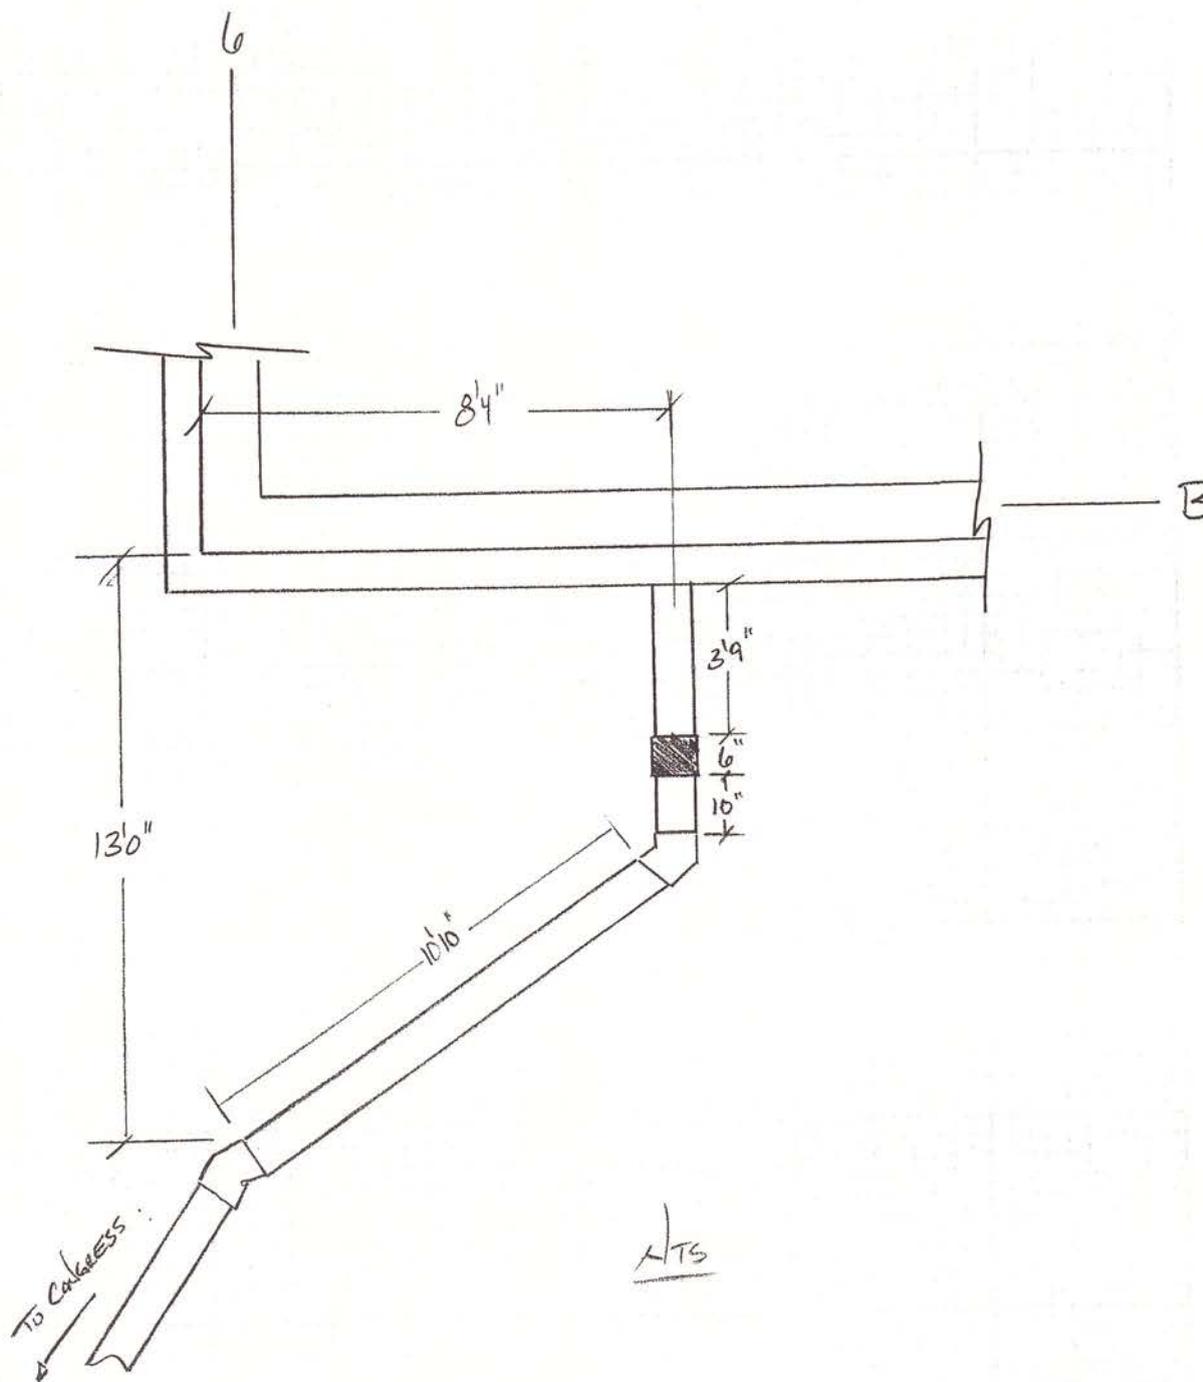



For <u>EXIT 46 W</u>	Job No.	Sheet No.
Made by <u>JH</u>	Checked by	Backchecked by
Date <u>3-6-08</u>	Date	Date

NEW 2" WATERLINE PUT IN SERVICE AT 1000 HRS.
 OLD 2" " " TAKEN OUT OF SERVICE

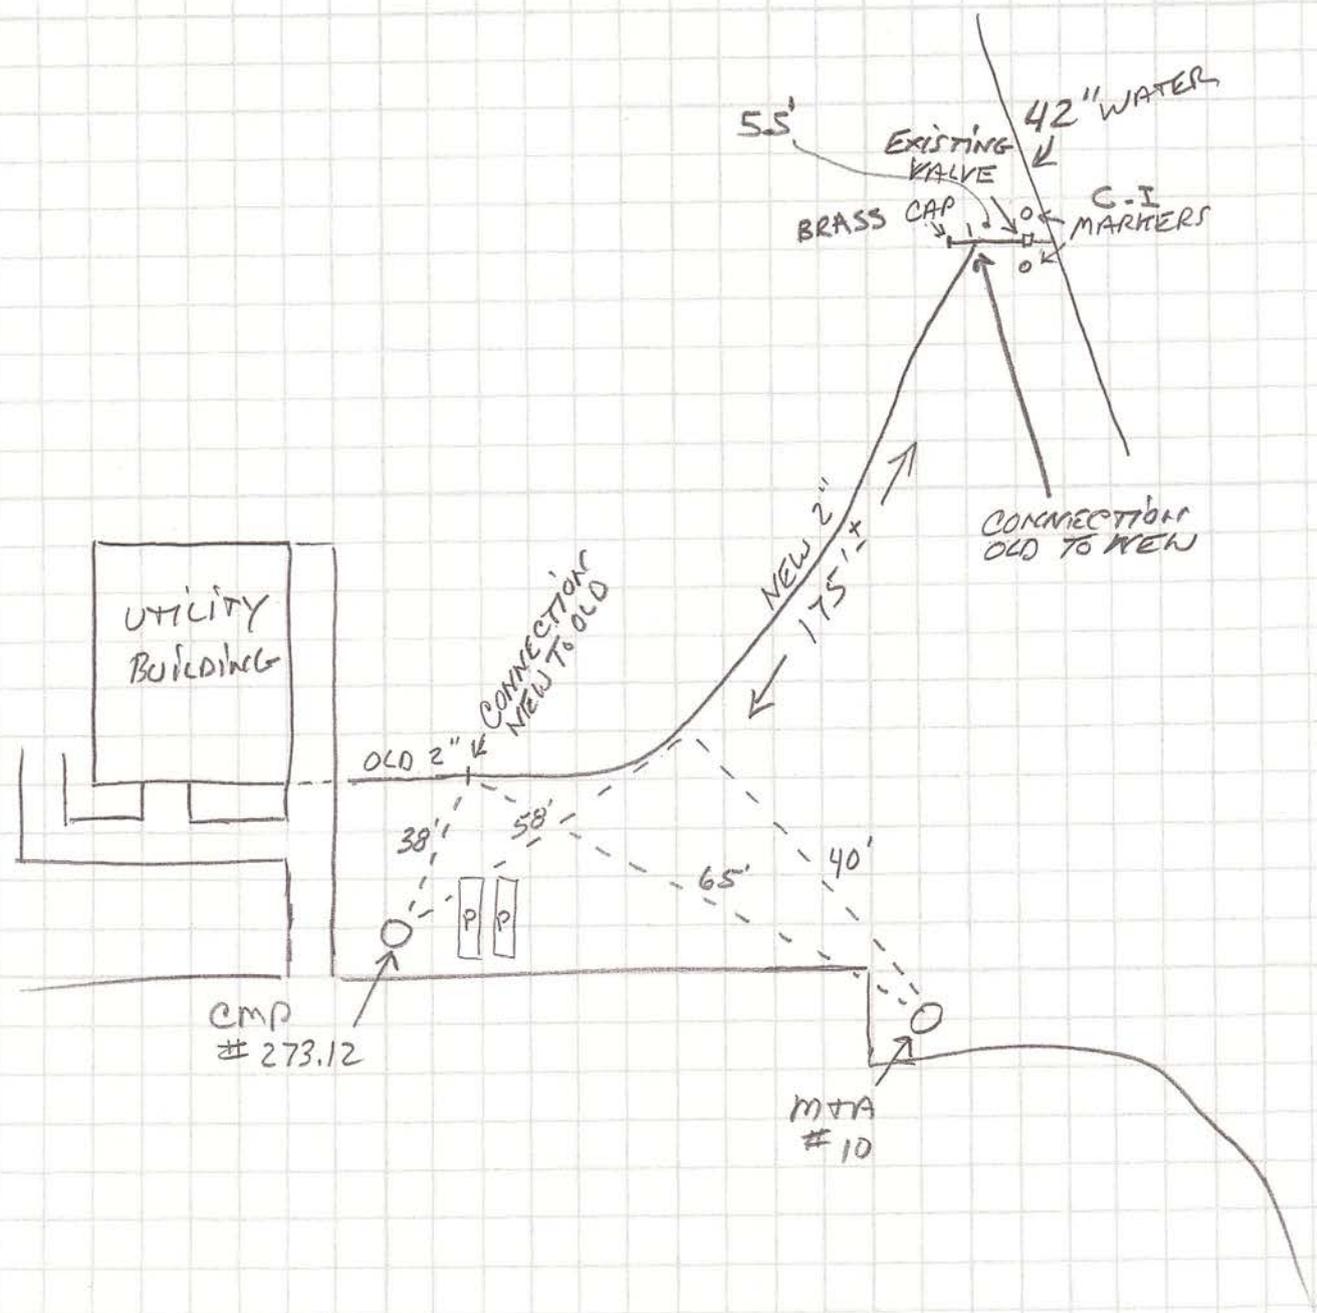

For <u>MTA HEADQUARTERS</u>	Job No.	Sheet No.
Made by <u>CFM</u>	Checked by	Backchecked by
Date <u>3/19</u>	Date	Date

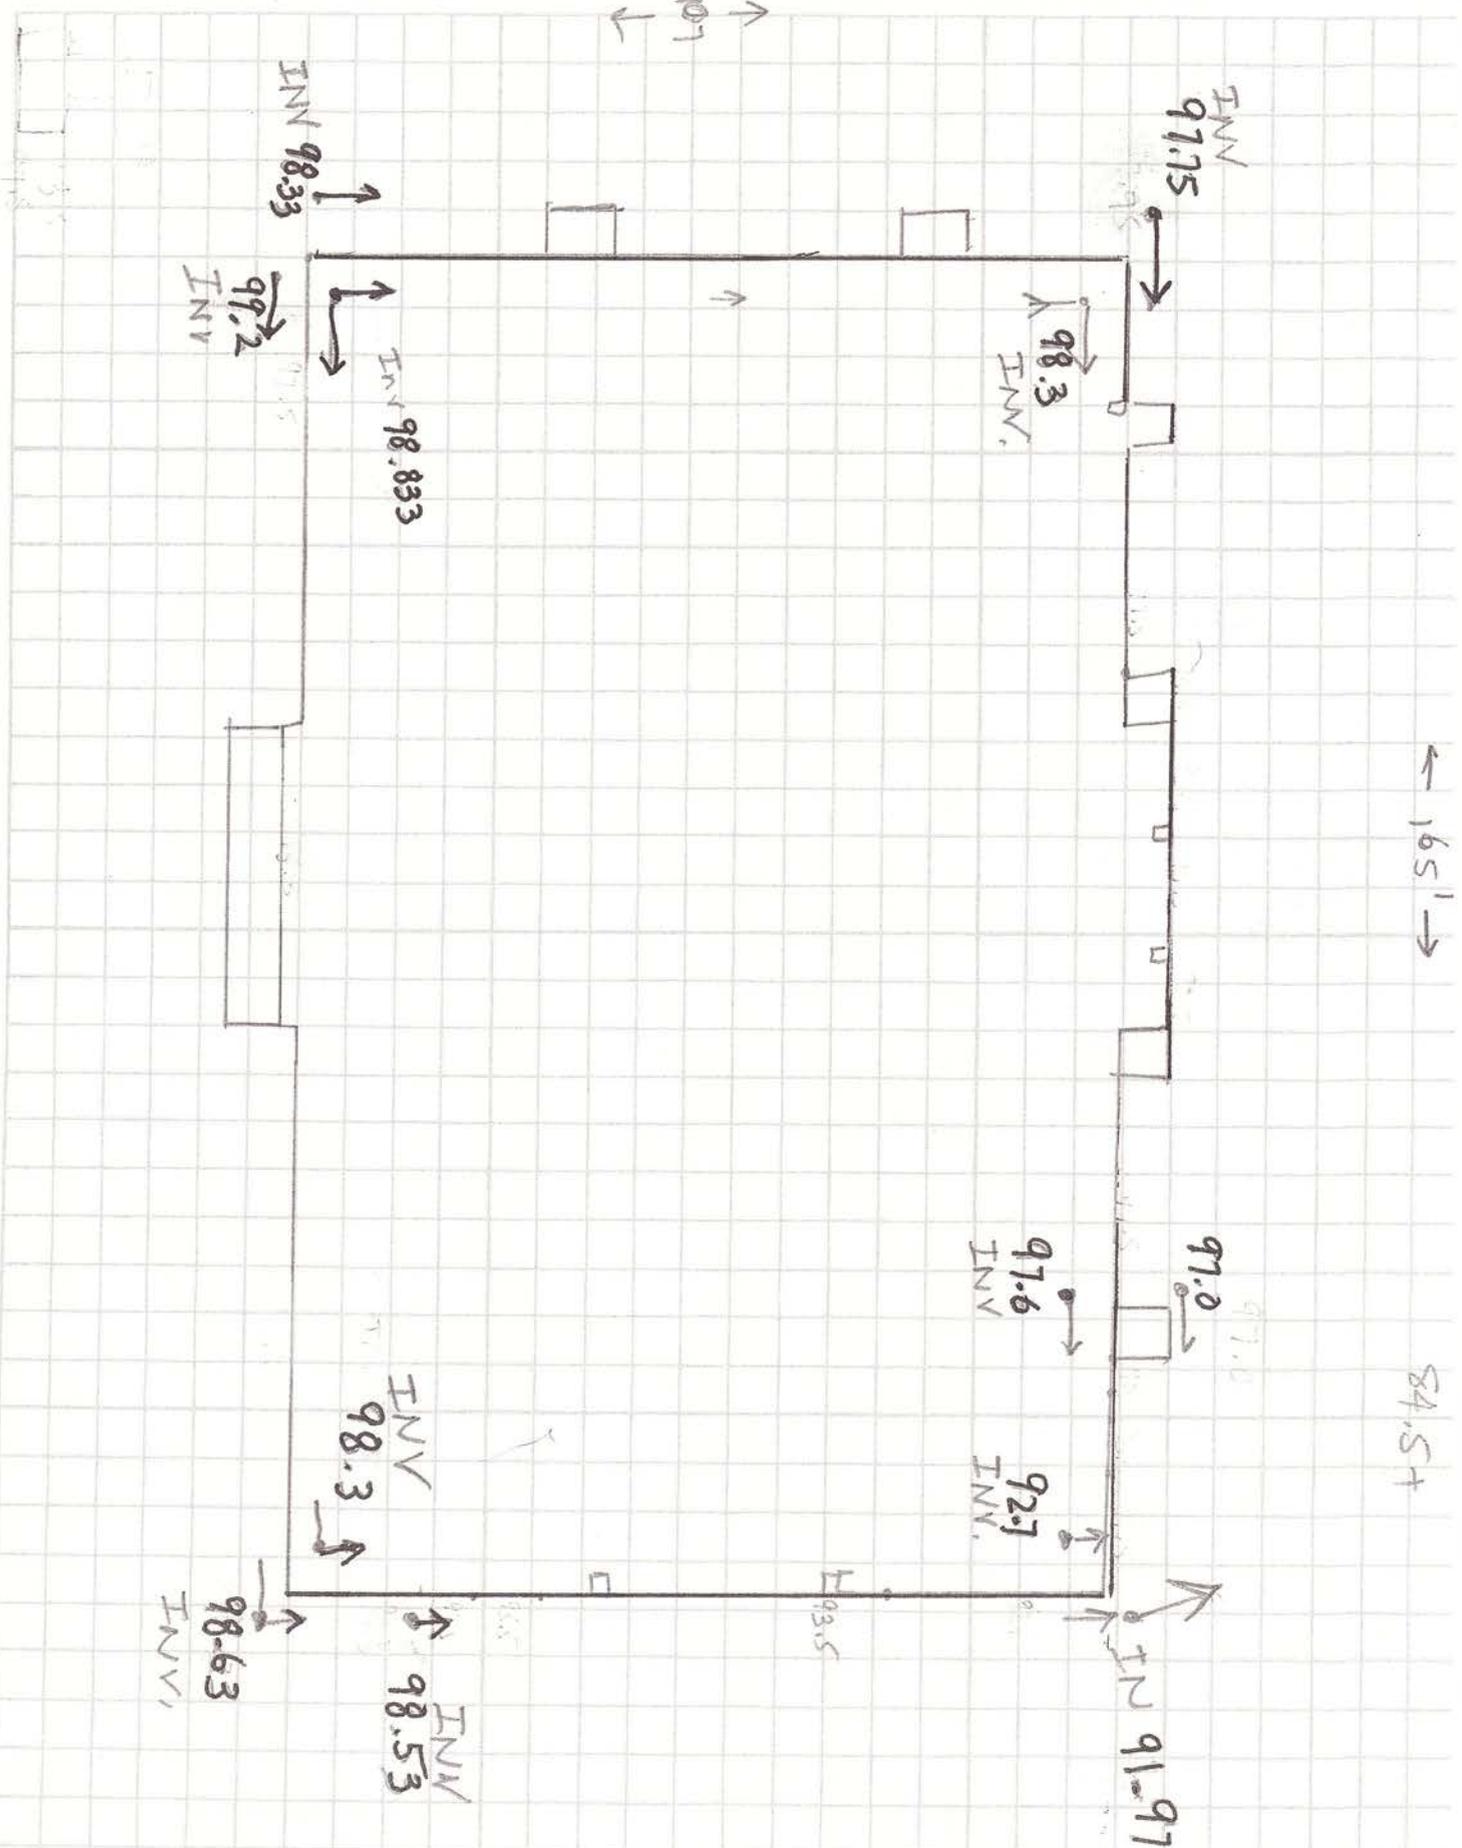

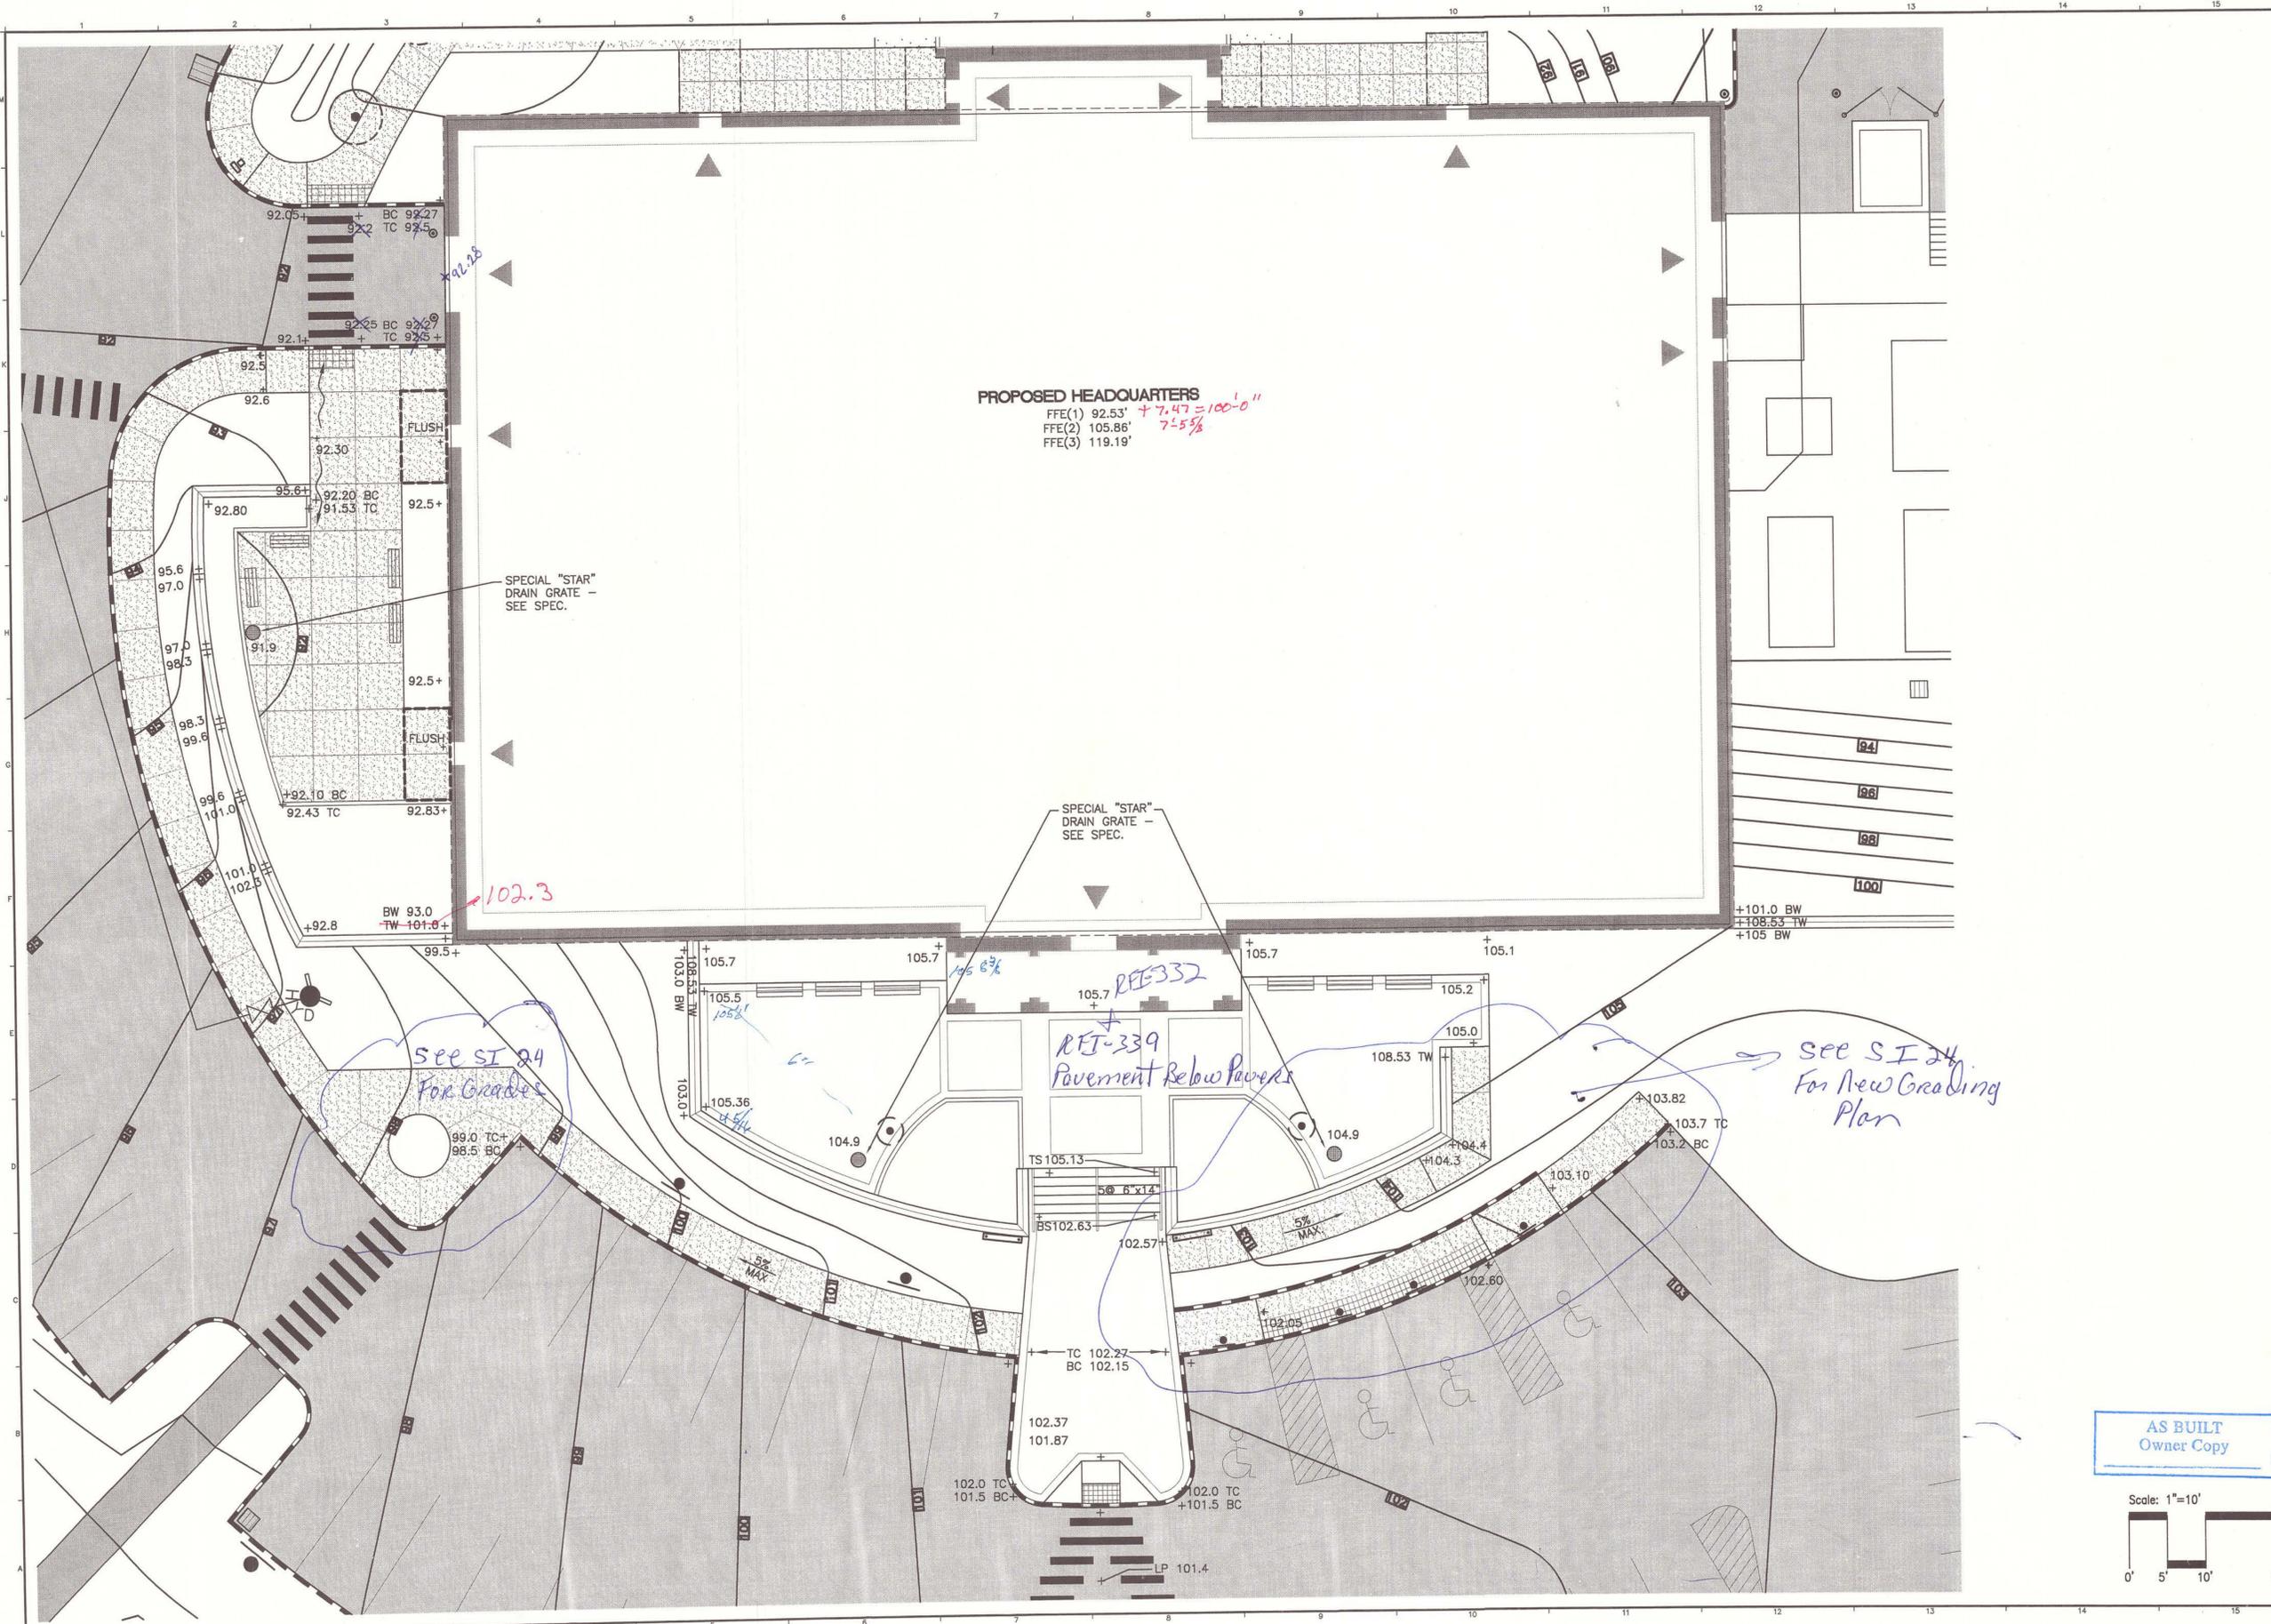

PROPOSED HEADQUARTERS
 FFE(1) 92.53' + 7.47' = 100'-0"
 FFE(2) 105.86' 7'-5 5/8"
 FFE(3) 119.19'

SPECIAL "STAR"
 DRAIN GRATE -
 SEE SPEC.


SPECIAL "STAR"
 DRAIN GRATE -
 SEE SPEC.

SEE ST 24
 FOR GRADES

REI-339
 Pavement Below Pavers

SEE S.I. 24
 FOR NEW GRADING
 PLAN

AS BUILT
 Owner Copy

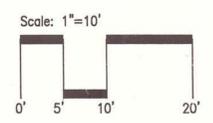

ARCHITECTURE ENGINEERING PLANNING
 SMRT
 144 Fore Street P.O. Box 618
 Portland, Maine 04104
 Tel. (207) 772-3946
 Fax. (207) 772-1070




PROJECT TITLE:
**MAINE TURNPIKE AUTHORITY
 ADMINISTRATION BUILDING**
 PORTLAND, MAINE

ISSUED FOR BIDDING/CONSTRUCTION
 7-9-07

REV	DESCRIPTION	DATE
0	BIDDING/CONSTRUCTION	7-9-07

GRAPHIC SCALE:
 0" 1"
 SCALE: SHOWN
 PROJECT MANAGER: SLB
 JC/DRAWN BY: TCM/PAF
 A/E OF RECORD: MGJ
 CAD FILE: 06016-CG201
 PROJECT NO: 06016
 DATE: 7-9-07
 SHEET TITLE:
**DETAIL GRADING
 PLAN**
 SHEET No. **CG201**

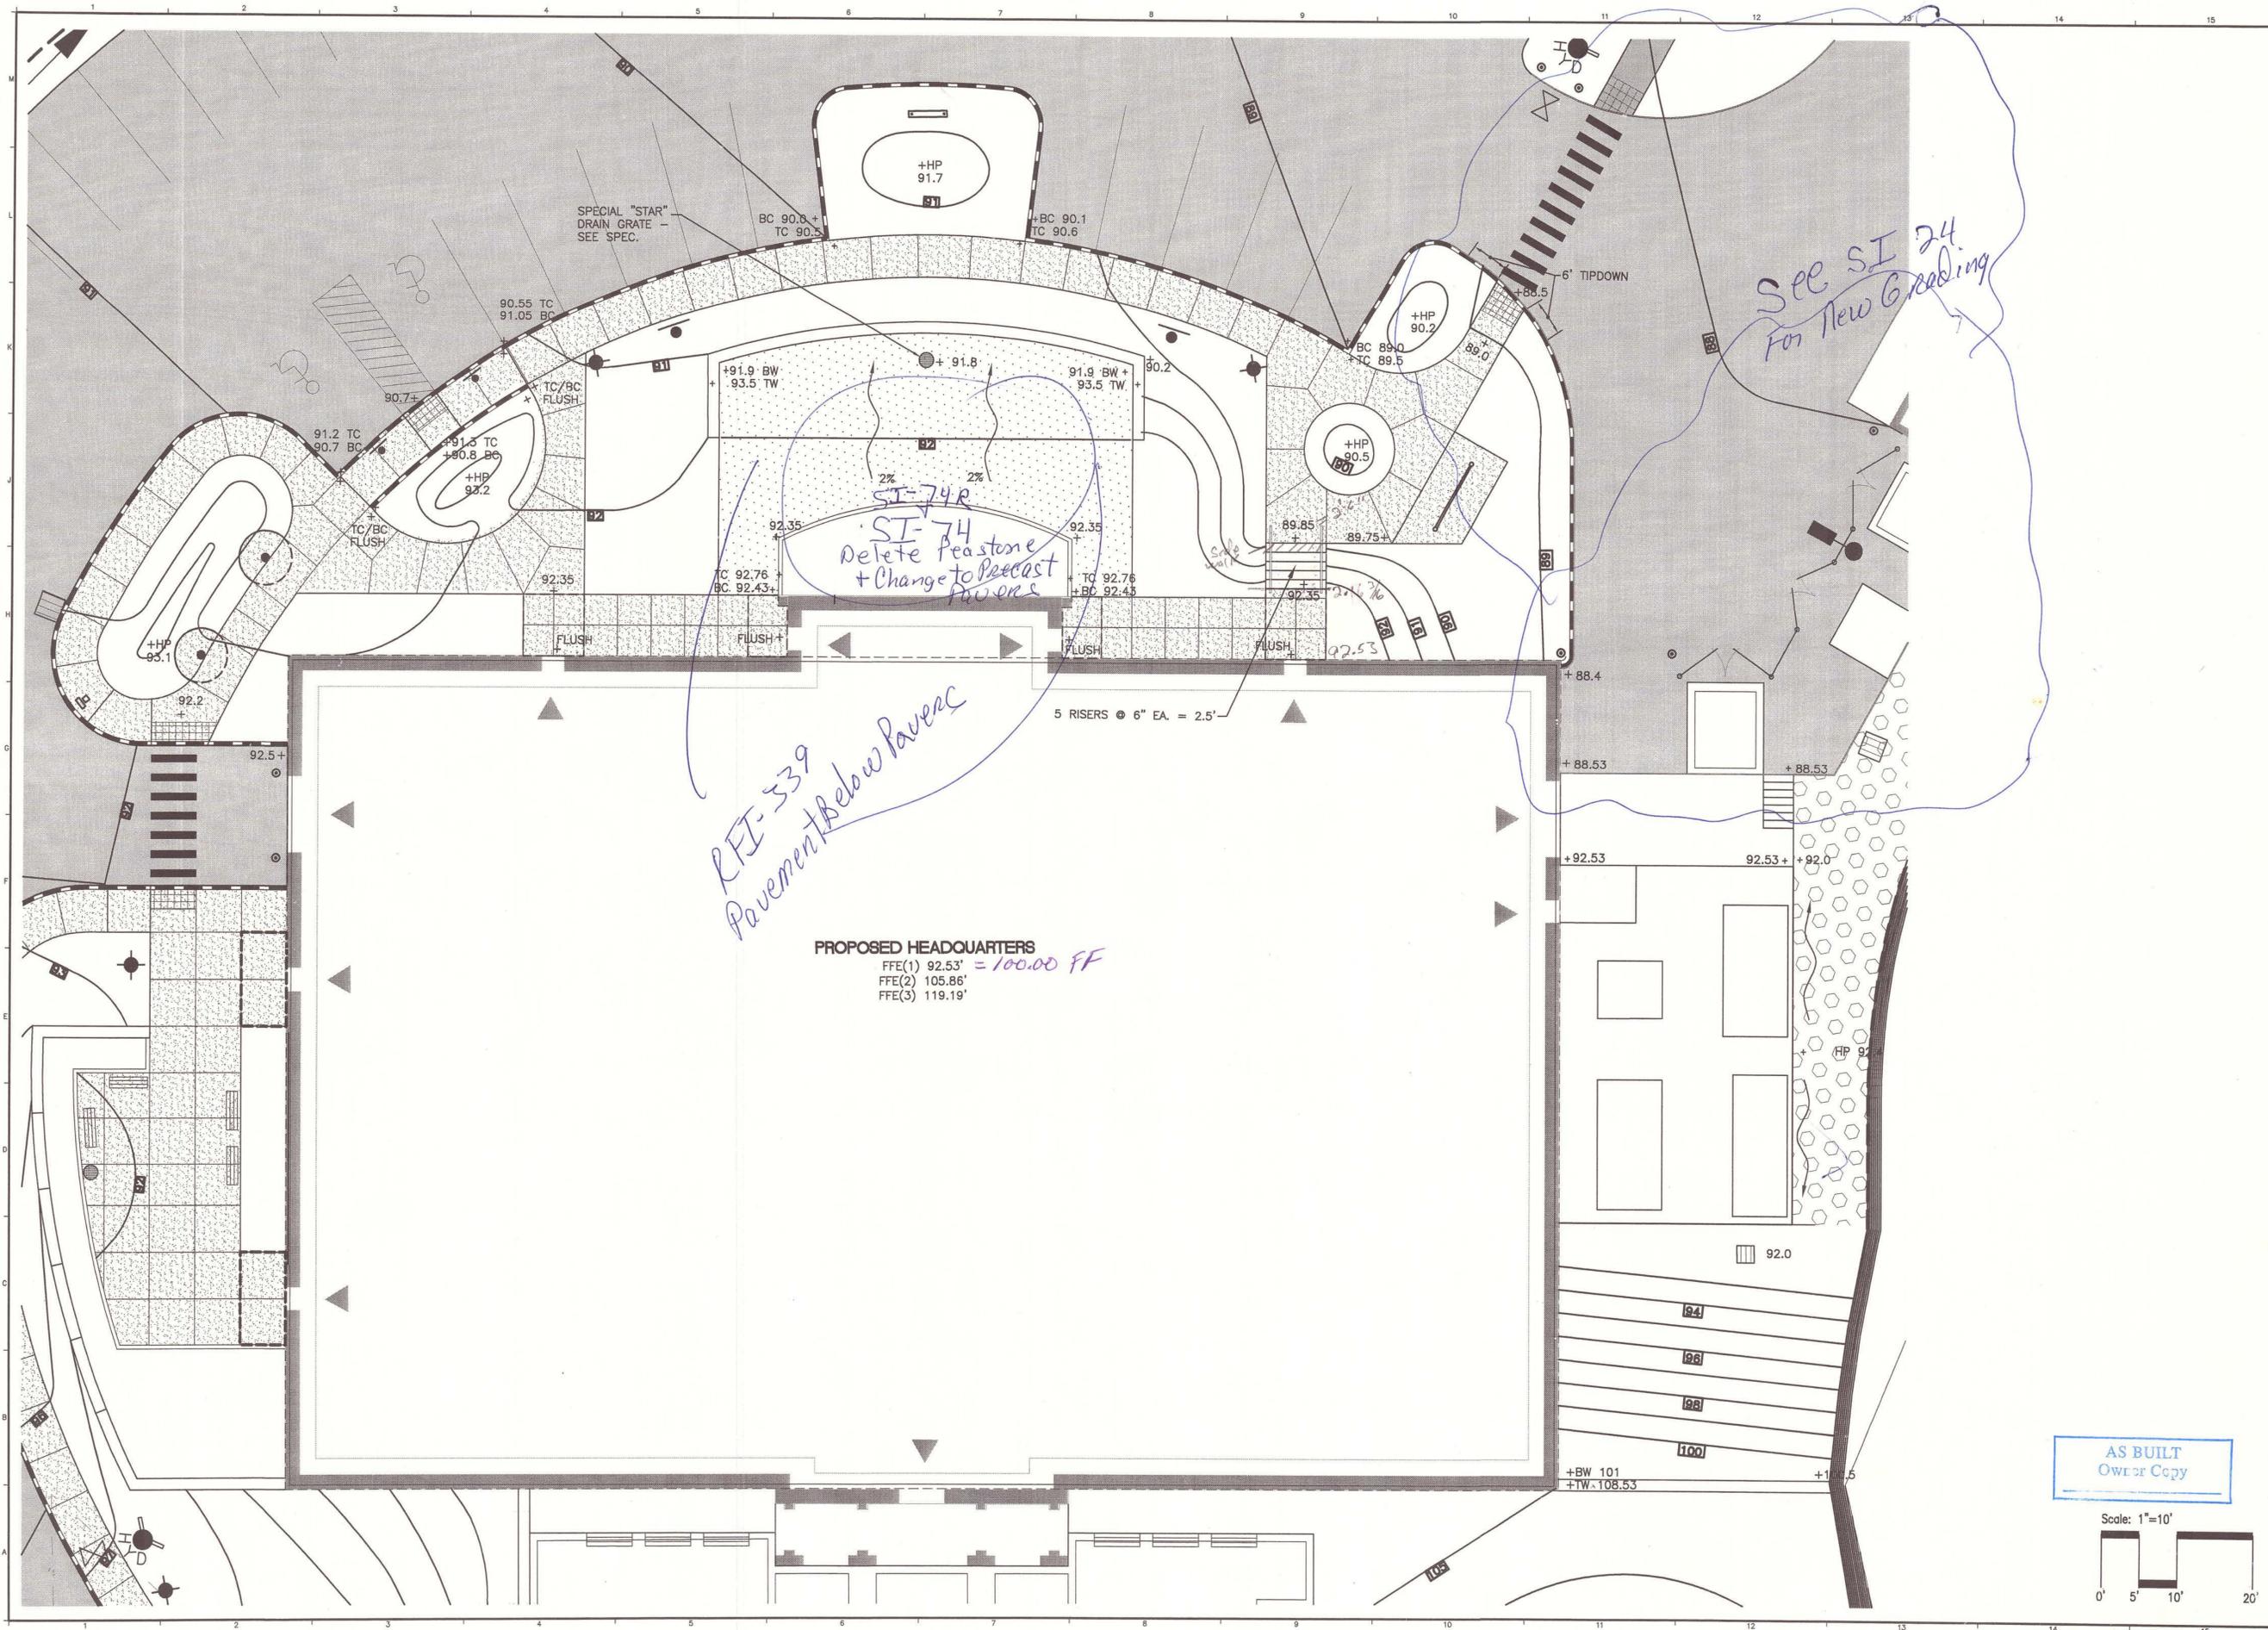


SI-74R
Delete Peastone
+ Change to Precast
Pavers

RFI-539
Pavement Below Pavers

PROPOSED HEADQUARTERS
FFE(1) 92.53' = 100.00 FF
FFE(2) 105.86'
FFE(3) 119.19'


See SI 24
For New Grading

AS BUILT
Owner Copy

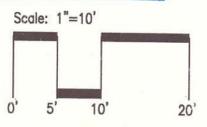

**S M
R T**

ARCHITECTURE ENGINEERING PLANNING
SMRT
144 Fore Street/P.O. Box 618
Portland, Maine 04104
tel. (207) 772-3846
fax. (207) 772-1070

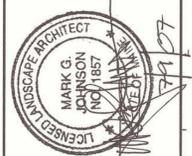




PROJECT TITLE:
**MAINE TURNPIKE AUTHORITY
ADMINISTRATION BUILDING
PORTLAND, MAINE**

**ISSUED FOR BIDDING/CONSTRUCTION
7-9-07**

REV	BIDDING/CONSTRUCTION DESCRIPTION	DATE
0		7-9-07


GRAPHIC SCALE:
0" 1"
SCALE: SHOWN
PROJECT MANAGER: SLB
JC/DRAWN BY: TCM/PAF
A/E OF RECORD: MGJ
CAD FILE: 06016-CG202
PROJECT NO: 06016
DATE: 7-9-07
SHEET TITLE:
**DETAIL GRADING
PLAN**
SHEET No. **CG202**

1 2 3 4 5 6 7 8 9 10 11 12 13 14 15

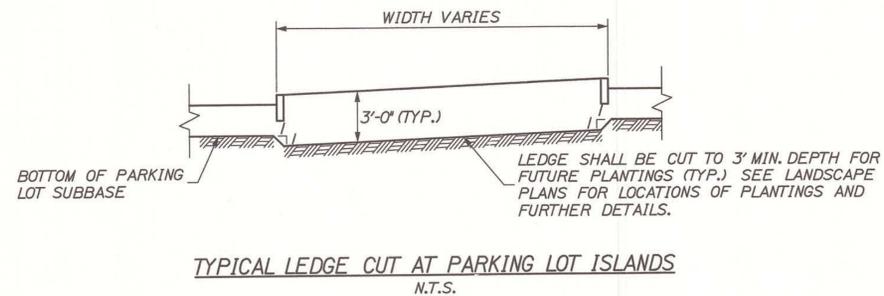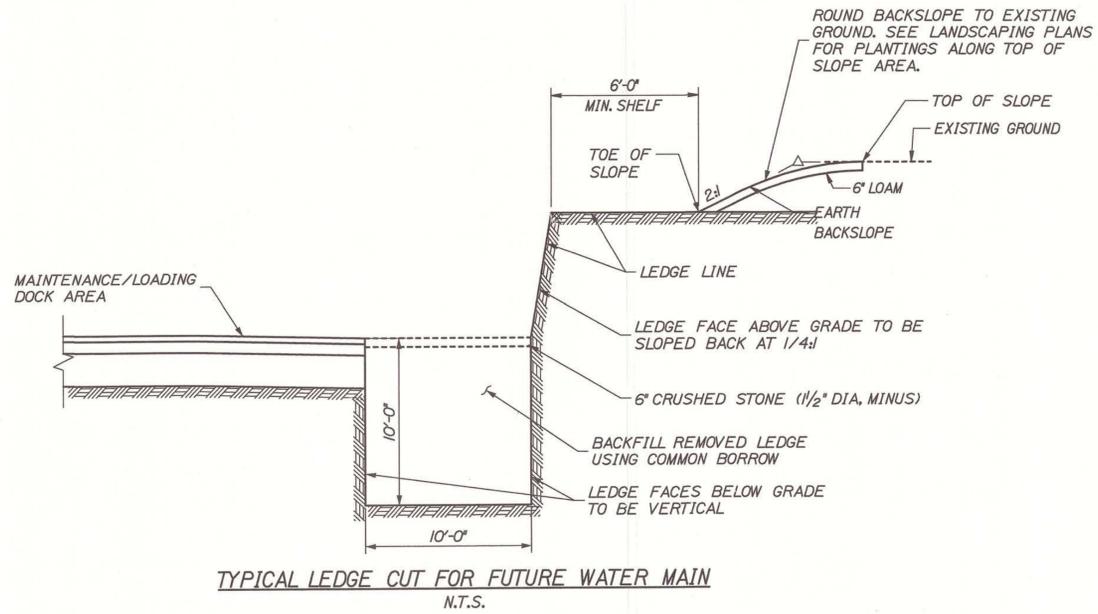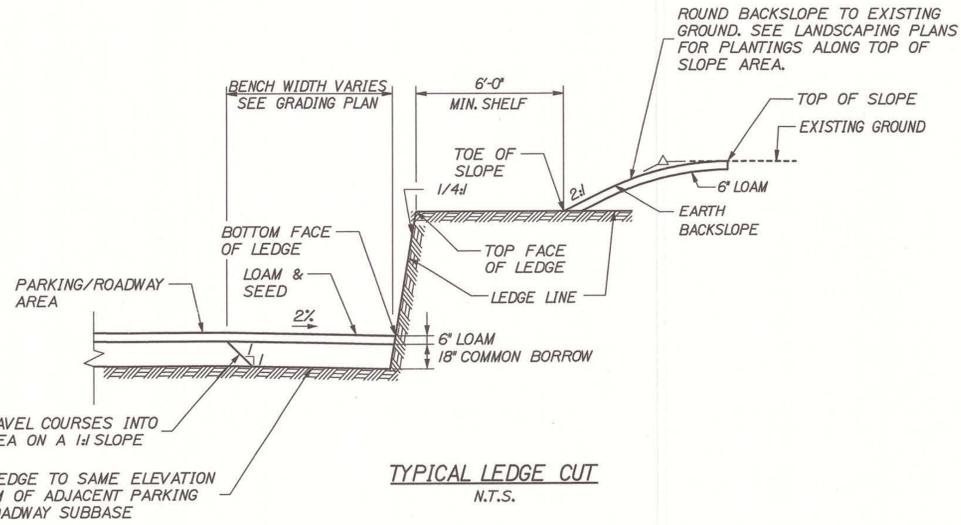

PREPARED BY:
HNTB
HNTB CORP.
1000 WESTERN AVENUE
WESTBROOK, ME
04092

SM RT
ARCHITECTURE ENGINEERING PLANNING
SMRT
144 Fore Street/P.O. Box 618
Portland, Maine 04104
tel. (207) 772-3646
fax. (207) 772-1070

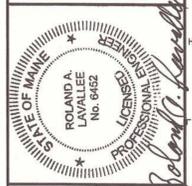

PROJECT TITLE:
**MAINE TURNPIKE AUTHORITY
ADMINISTRATION BUILDING
PORTLAND, MAINE**

**ISSUED FOR BIDDING/CONSTRUCTION
7-9-07**

REV	DESCRIPTION	DATE
4	DOCS FOR OWNER REVIEW	6-11-07
3	ISSUED FOR CITY REVIEW	5-03-07
2	100% OWNER REVIEW	3-23-07
1	ISSUED FOR PERMITTING	2-09-07
0	PRE-SUBMITTAL	1-16-07

GRAPHIC SCALE:
0" 1"

SCALE: AS NOTED

PROJECT MANAGER: GAB
JC/DRAWN BY: MPC
A/E OF RECORD: GAB
CAD FILE: X
PROJECT NO.: 2007.07
DATE: 01/07

SHEET TITLE:
**SITE GRADING
DETAILS**

**AS BUILT
Owner Copy**

SHEET No.
CG203

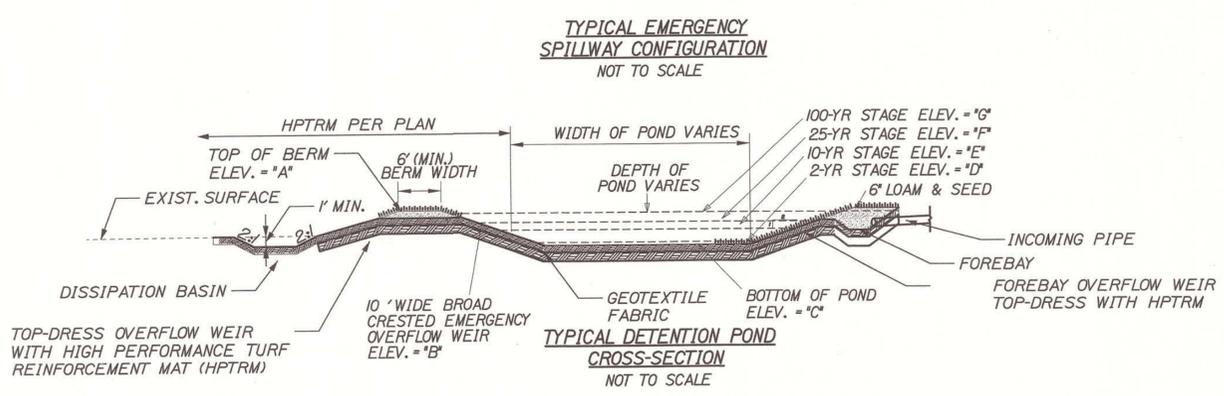
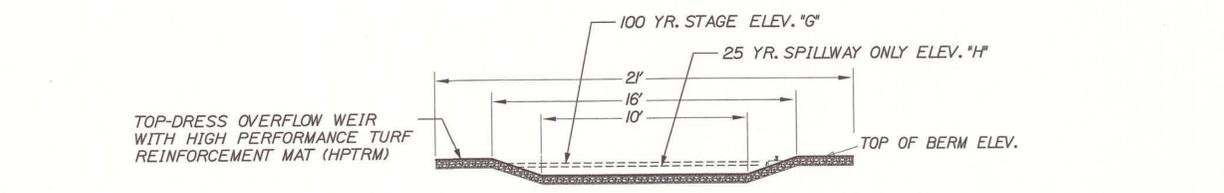
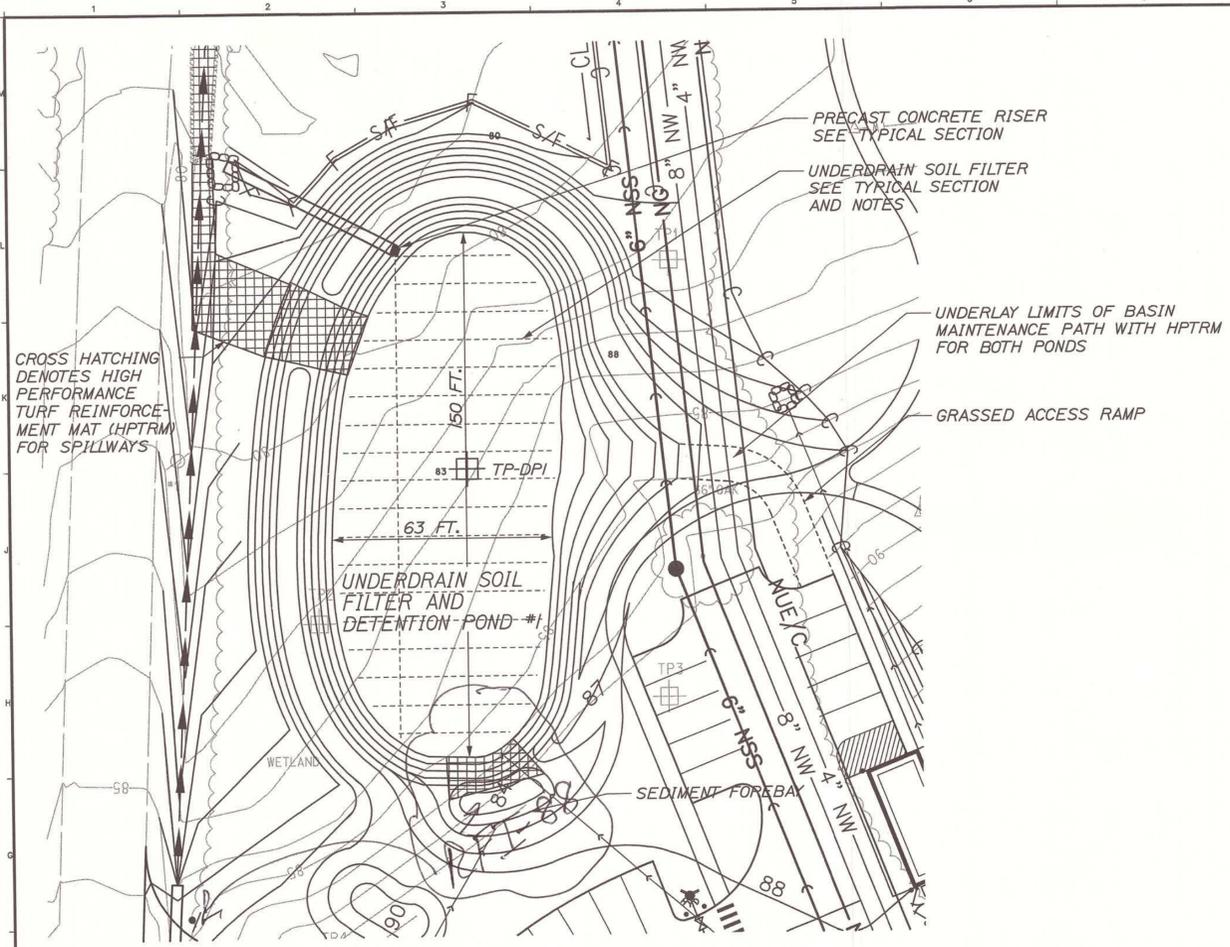


TABLE 1 SPILLWAY CROSS SECTION

	A	B	C	D	E	F	G	H
POND #1	88.00	86.50	83.00	85.06	86.08	86.22	86.46	86.80
POND #2	90.00	89.00	86.00	87.69	88.57	88.68	88.79	89.21



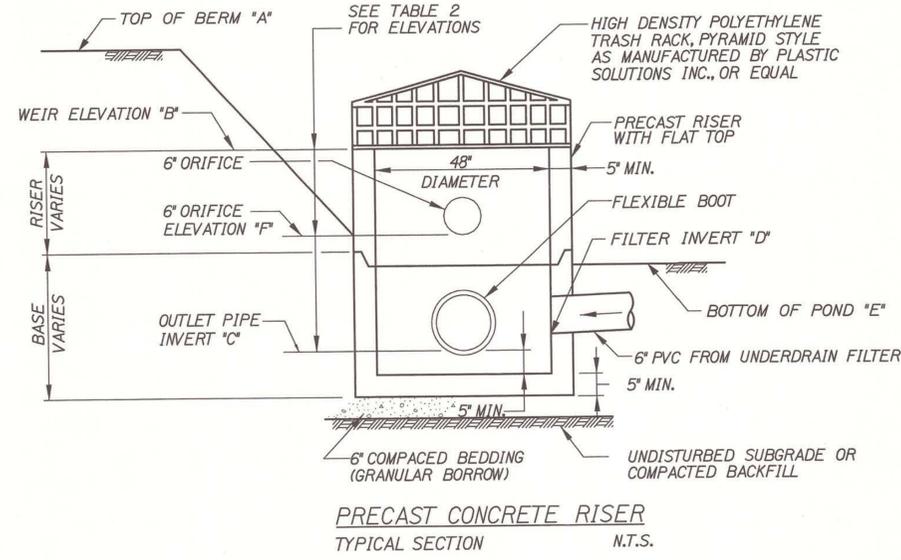


TABLE 2 OUTLET STRUCTURE ELEVATIONS

	A	B	C	D	E	F
POND #1	87.00	85.90	80.30	80.60	83.00	84.50
POND #2	90.00	88.50	83.30	83.60	86.00	87.50

- RISER NOTES:**
- MANHOLE SECTIONS AND STEEL REINFORCEMENT SHALL CONFORM TO ASTM C478, AND BE SUITABLE FOR HS-20 LOADINGS (TYP.).
 - 2 COATS BITUMINOUS DAMPROOFING

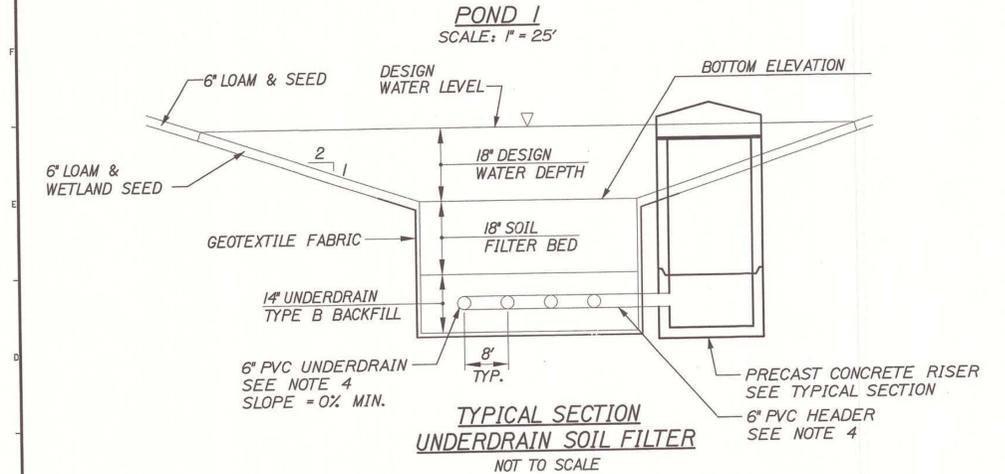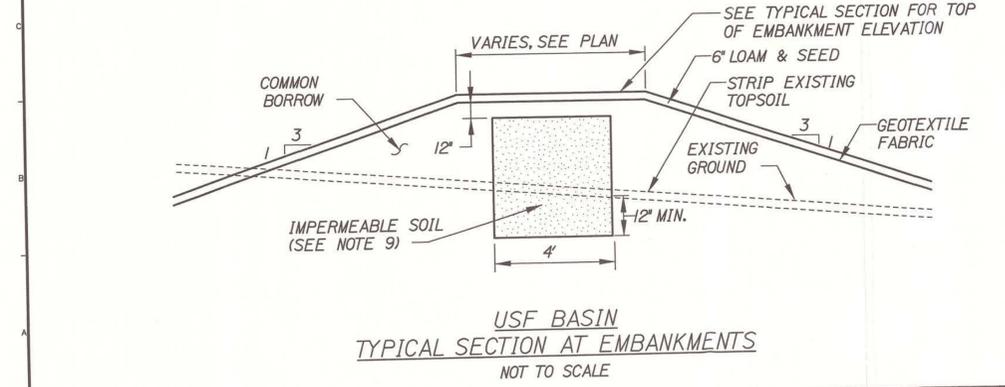

NOTES:

- SOIL FILTER BED MATERIAL SHALL BE A LIGHTLY COMPACTED THOROUGHLY BLENDED MIXTURE OF THE FOLLOWING:
 - SILTY SAND (75-80% BY VOLUME): MEDOT SPEC. 703.01 (FINE AGGREGATE FOR CONCRETE). SOIL SHALL HAVE NO GREATER THAN 2% CLAY CONTENT.
 - MULCH (20-25% BY VOLUME): MODERATELY FINE SHREDDED BARK MULCH OR WOOD FIBER MULCH.
 - TOTAL MIXTURE SHALL HAVE A RANGE OF 8-10% PASSING #200 SIEVE.
- UNDERDRAIN BACKFILL (BEDDING) SHALL BE WELL GRADED, CLEAN, COARSE GRAVEL MEETING MEDOT SPECIFICATION 703.22, TYPE B UNDERDRAIN BACKFILL NO MORE THAN 2% BY WEIGHT SHALL PASS THE #200 SIEVE.
- GEOTEXTILE FABRIC SHALL BE MEDOT SPECIFICATION 722.02, CLASS A DESIGNATION.
- UNDERDRAIN PIPE SHALL BE PVC CONFORMING TO ASTM D3034, SDR 35. (UNDERDRAIN LATERALS SHALL BE 6 INCH SLOTTED PVC. 6 INCH PVC HEADER/OUTLET PIPE SHALL NOT BE SLOTTED.)
- STONE DITCH PROTECTION FOR PIPE OUTLET/DITCH PROTECTION SHALL BE MEDOT SPECIFICATION 703.29, WITH 90-100% WEIGHT OF ROCK PASSING AN 8 INCH SIEVE AND 0-15% PASSING A 4 INCH SIEVE.
- SURFACE OF SOIL FILTER SHALL BE PLANTED WITH WETLAND SEED "NEW ENGLAND EROSION CONTROL/RESTORATION MIX" AS SUPPLIED BY NEW ENGLAND WETLAND PLANTS, INC. SEED MIX SHALL BE APPLIED AT DOUBLE THE MANUFACTURERS APPLICATION RATE. SURFACE SHALL BE STABILIZED WITH AN APPROVED EROSION CONTROL MATTING.
- STORMWATER FILTER SHALL BE CONSTRUCTED TO THE LIMITS AND DETAILS SHOWN ON THE PLANS AND THE ABOVE SPECIFICATIONS UNLESS OTHERWISE APPROVED BY THE ENGINEER. IF LEDGE IS ENCOUNTERED IN THE EXCAVATION FOR EITHER POND, THE CONTRACTOR SHALL REMOVE THE LEDGE TO ALLOW FOR A 1' SEPARATION BETWEEN THE EXPOSED BEDROCK AND THE BOTTOM OF THE UNDERDRAIN SOIL FILTER. BACKFILL UP TO THE BOTTOM OF THE UNDERDRAIN SOIL FILTER WITH SUITABLE, COMPACTED CLAY MATERIAL (SEE NOTE 9).
- HIGH PERFORMANCE TURF REINFORCEMENT MATS (HPTRM) SHALL MEET THE SPECIFICATIONS OF LANDLOK PYRAMAT HPTRM OR APPROVED EQUAL.
- IMPERMEABLE SOIL FOR EMBANKMENT CORE AND BEDROCK COVER SHALL MEET MEDOT SPECIFICATION 203.245, CLAY BORROW. ON-SITE CLAY MATERIAL MAY BE USED IF IT MEETS THE SPECIFICATION.
- STORMWATER FILTER SHALL BE CONSTRUCTED TO THE LIMITS AND DETAILS SHOWN ON THE PLANS AND THE ABOVE SPECIFICATIONS UNLESS OTHERWISE APPROVED BY THE ENGINEER.
- FILTER BED MATERIAL SHALL NOT BE PLACED IN USF BASINS UNTIL THE TRIBUTARY DRAINAGE AREA IS PERMANENTLY STABILIZED AGAINST EROSION.

AS BUILT
Owner Copy

PREPARED BY:
HNTB

HNTB CORP.
2 THOMAS DRIVE
WESTBROOK, ME
04092

ARCHITECTURE ENGINEERING PLANNING
SM
RT

SHIRT
144 Fore Street/P.O. Box 618
Portland, Maine 04104
Tel. (207) 772-3846
Fax. (207) 772-1070



PROJECT TITLE:
**MAINE TURNPIKE AUTHORITY
ADMINISTRATION BUILDING
PORTLAND, MAINE**

**ISSUED FOR BIDDING/CONSTRUCTION
7-9-07**

REV	DESCRIPTION	DATE
4	DOCS FOR OWNER REVIEW	6-11-07
3	ISSUED FOR CITY REVIEW	5-03-07
2	LOOK OWNER REVIEW	3-23-07
1	ISSUED FOR PERMITTING	2-09-07
0	PRE-SUBMITTAL	1-16-07

GRAPHIC SCALE:
0' 1'

SCALE: AS NOTED

PROJECT MANAGER: GAB

JC/DRAWN BY: MPC

A/E OF RECORD: GAB

CAD FILE: X

PROJECT NO: 2007.07

DATE: 01/07


SHEET TITLE:
**UNDERDRAIN SOIL FILTER
AND DETENTION POND
PLANS AND DETAILS**

SHEET No. **CG301**

P. 15/18

MAINE TURNPIKE


PLG-17-2007 15:41

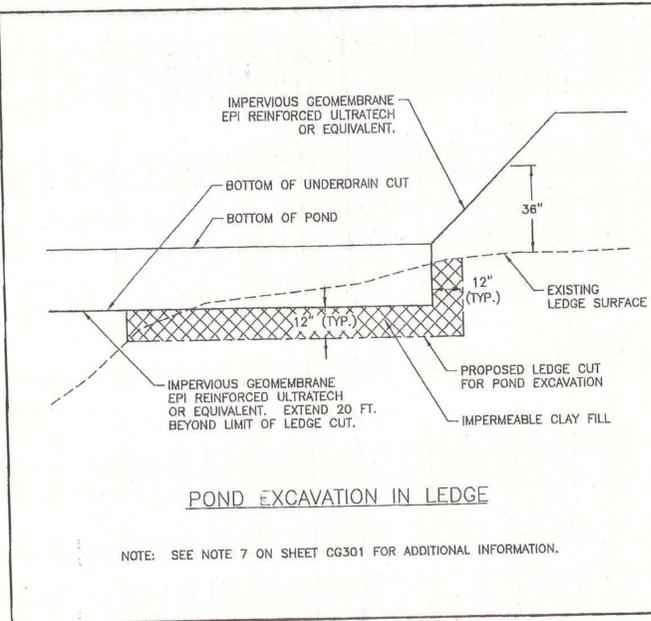

POND EXCAVATION IN LEDGE

NOTE: SEE NOTE 7 ON SHEET CG301 FOR ADDITIONAL INFORMATION.

		SCALE: NOT TO SCALE CAD FILE: CG302-06016 PROJECT No. 06016 REF. SHEET: CG302
	2 THOMAS DRIVE WESTBROOK, ME 04092 TEL: (207) 772-3846 / FAX: (207) 772-1070	PROJECT: MAINE TURNPIKE AUTHORITY ADMINISTRATION BUILDING SEPARATION DETAIL @ LEDGE

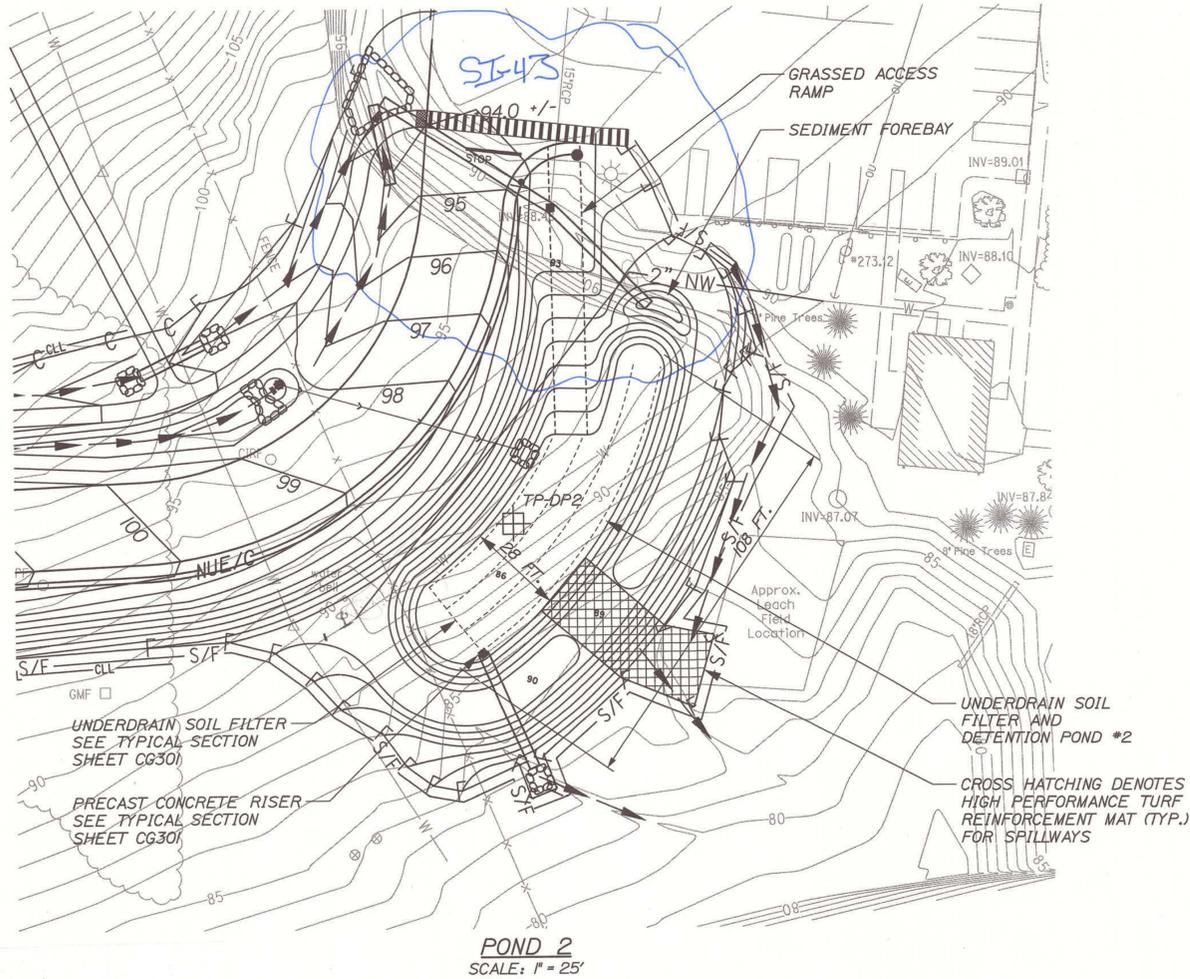

POND 2
SCALE: 1" = 25'

AS BUILT
Owner Copy

NOTE:
FOR NOTES, SEE SHEET CG301.

PREPARED BY: **HNTB**
 HNTB CORP.
 2 THOMAS DRIVE
 WESTBROOK, ME 04092

ARCHITECTURE ENGINEERING PLANNING
 SMRT
 144 Fore Street/P.O. Box 618
 Portland, Maine 04104
 tel. (207) 772-3846
 fax. (207) 772-1070

STATE OF MAINE
 REG. LAND SURVEYOR
 ROLAND A. LAVALLÉE
 No. 6452
 LICENSED PROFESSIONAL

PROJECT TITLE:
 MAINE TURNPIKE AUTHORITY
 ADMINISTRATION BUILDING
 PORTLAND, MAINE

ISSUED FOR BIDDING/CONSTRUCTION
 7-9-07

REV	DESCRIPTION	DATE
4	DOCS FOR OWNER REVIEW	6-11-07
3	ISSUED FOR CITY REVIEW	5-03-07
2	100% OWNER REVIEW	3-23-07
1	ISSUED FOR PERMITTING	2-09-07
0	PRE-SUBMITTAL	1-16-07

GRAPHIC SCALE:
 0" 1"

SCALE: AS NOTED
 PROJECT MANAGER: GAB
 JC/DRAWN BY: MPC
 A/E OF RECORD: GAB
 CAD FILE: X
 PROJECT NO.: 2007.07
 DATE: 01/07

SHEET TITLE:
 UNDERDRAIN SOIL FILTER
 AND DETENTION POND
 PLANS AND DETAILS

SHEET No. **CG302**
 © copyright 2007 HNTB, Inc.

PREPARED BY: **HNTB**
 HNTB CORP.
 2 THOMAS DRIVE
 WESTBROOK, ME
 04092

SM
RT

ARCHITECTURE ENGINEERING PLANNING
 SUITE
 144 Fore Street P.O. Box 618
 Portland, Maine 04104
 tel. (207) 772-3846
 fax. (207) 772-1070

AS BUILT
 Owner Copy



PROJECT TITLE:
**MAINE TURNPIKE AUTHORITY
 ADMINISTRATION BUILDING
 PORTLAND, MAINE**

**ISSUED FOR BIDDING/CONSTRUCTION
 7-9-07**

REV	DESCRIPTION	DATE
4	DOCS FOR OWNER REVIEW	6-11-07
3	ISSUED FOR CITY REVIEW	5-03-07
2	100% OWNER REVIEW	3-23-07
1	ISSUED FOR PERMITTING	2-09-07
0	PRE-SUBMITTAL	1-16-07


GRAPHIC SCALE:
 0" 1"

SCALE: AS NOTED

PROJECT MANAGER: GAB
 JC/DRAWN BY: MPC
 A/E OF RECORD: GAB
 CAD FILE: X
 PROJECT NO: 2007.07
 DATE: 01/07

SHEET TITLE:
UTILITIES PLAN

SHEET No. **CU101**

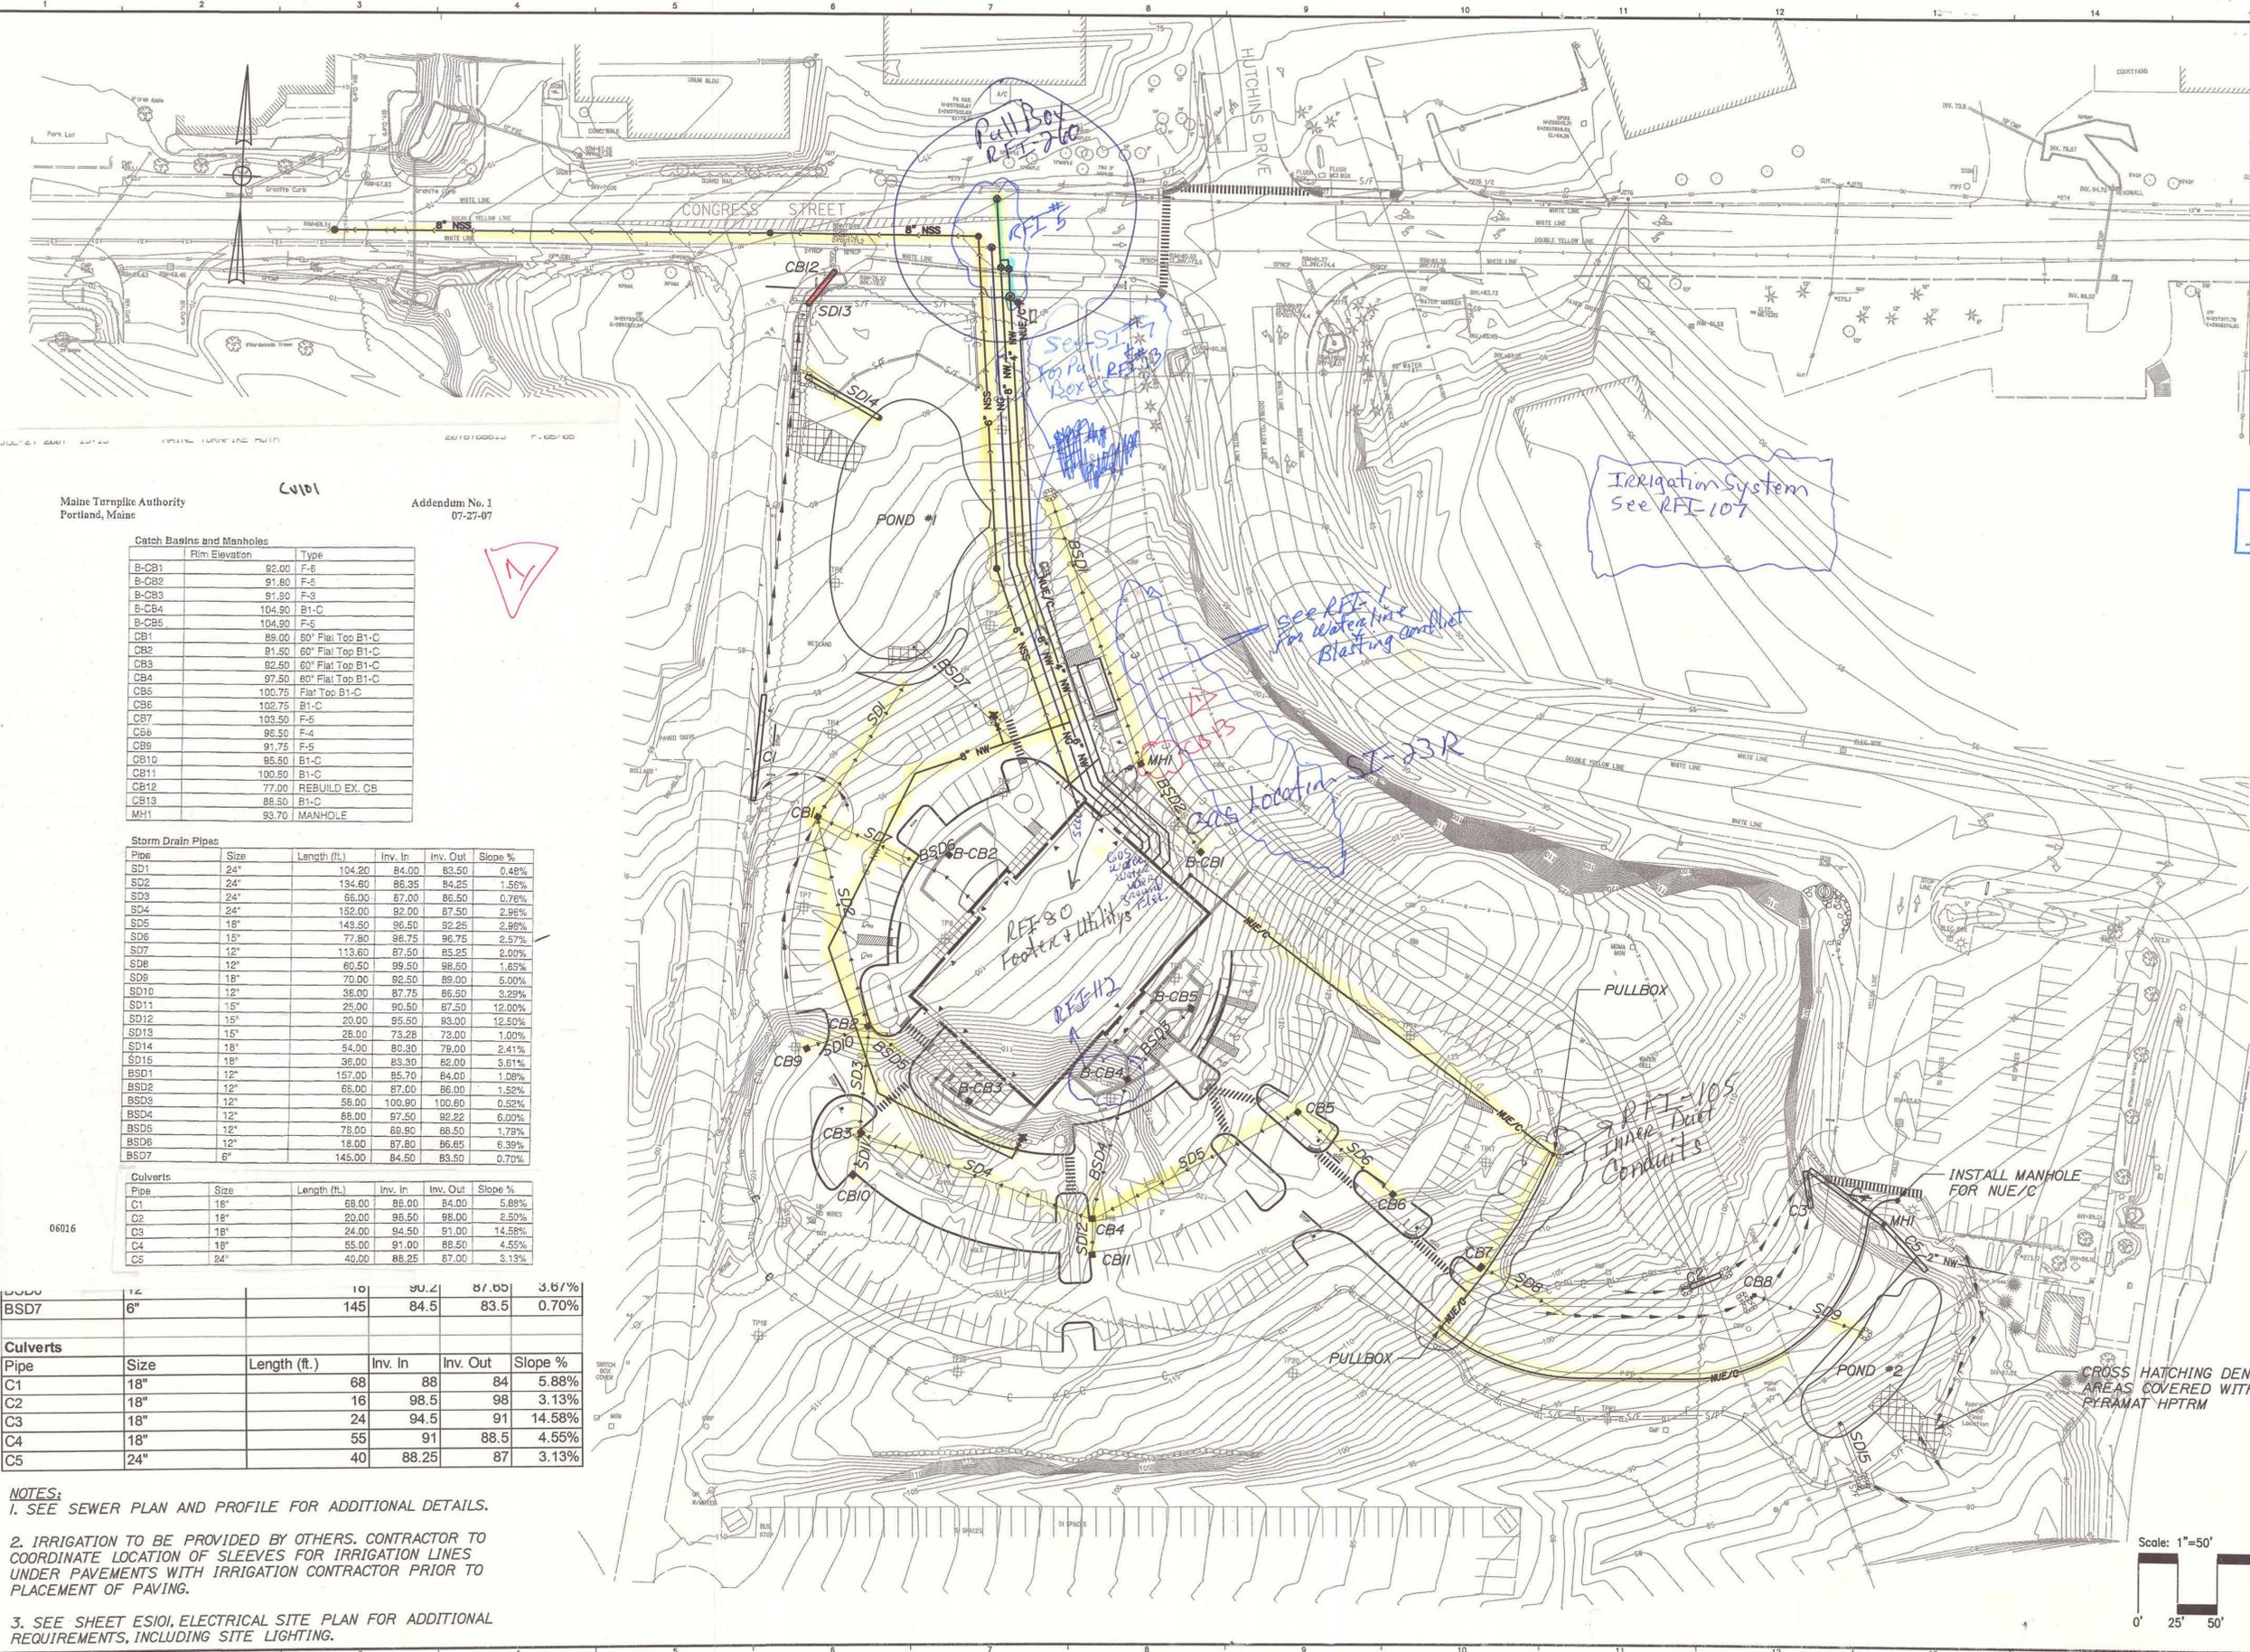

Maine Turnpike Authority
 Portland, Maine

CU101

Addendum No. 1
 07-27-07

Catch Basins and Manholes

CB	Rim Elevation	Type
B-CB1	92.00	F-6
B-CB2	91.80	F-5
B-CB3	91.80	F-3
B-CB4	104.90	B1-C
B-CB5	104.90	F-5
CB1	89.00	60" Flat Top B1-C
CB2	91.50	60" Flat Top B1-C
CB3	92.50	60" Flat Top B1-C
CB4	97.50	60" Flat Top B1-C
CB5	100.75	Flat Top B1-C
CB6	102.75	B1-C
CB7	103.50	F-5
CB8	95.50	F-4
CB9	91.75	F-5
CB10	85.50	B1-C
CB11	100.50	B1-C
CB12	77.00	REBUILD EX. CB
CB13	88.50	B1-C
MH1	93.70	MANHOLE

Storm Drain Pipes

Pipe	Size	Length (ft.)	Inv. In	Inv. Out	Slope %
SD1	24"	104.20	84.00	83.50	0.48%
SD2	24"	134.60	86.35	84.25	1.56%
SD3	24"	66.00	87.00	86.50	0.76%
SD4	24"	152.00	92.00	87.50	2.96%
SD5	18"	148.50	96.50	92.25	2.86%
SD6	15"	77.80	86.75	86.75	2.57%
SD7	12"	113.60	87.50	85.25	2.00%
SD8	12"	60.50	99.50	98.50	1.65%
SD9	18"	70.00	92.50	89.00	5.00%
SD10	12"	38.00	87.75	86.50	3.29%
SD11	15"	25.00	90.50	87.50	12.00%
SD12	15"	20.00	95.50	93.00	12.50%
SD13	15"	28.00	73.28	73.00	1.00%
SD14	18"	64.00	80.30	79.00	2.41%
SD15	18"	36.00	83.30	82.00	3.61%
BSD1	12"	157.00	85.70	84.00	1.09%
BSD2	12"	86.00	87.00	86.00	1.16%
BSD3	12"	58.00	100.90	100.60	0.32%
BSD4	12"	88.00	97.50	92.22	6.00%
BSD5	12"	78.00	89.90	88.50	1.79%
BSD6	12"	18.00	87.80	86.65	6.39%
BSD7	6"	145.00	84.50	83.50	0.70%


Culverts


Pipe	Size	Length (ft.)	Inv. In	Inv. Out	Slope %
C1	18"	68	88	84	5.88%
C2	18"	16	98.5	98	3.13%
C3	18"	24	94.5	91	14.58%
C4	18"	55	91	88.5	4.55%
C5	24"	40	88.25	87	3.13%

BSD7	6"	145	84.5	83.5	0.70%
------	----	-----	------	------	-------

Pipe	Size	Length (ft.)	Inv. In	Inv. Out	Slope %
C1	18"	68	88	84	5.88%
C2	18"	16	98.5	98	3.13%
C3	18"	24	94.5	91	14.58%
C4	18"	55	91	88.5	4.55%
C5	24"	40	88.25	87	3.13%

NOTES:
 1. SEE SEWER PLAN AND PROFILE FOR ADDITIONAL DETAILS.
 2. IRRIGATION TO BE PROVIDED BY OTHERS. CONTRACTOR TO COORDINATE LOCATION OF SLEEVES FOR IRRIGATION LINES UNDER PAVEMENTS WITH IRRIGATION CONTRACTOR PRIOR TO PLACEMENT OF PAVING.
 3. SEE SHEET ES101, ELECTRICAL SITE PLAN FOR ADDITIONAL REQUIREMENTS, INCLUDING SITE LIGHTING.

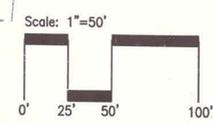

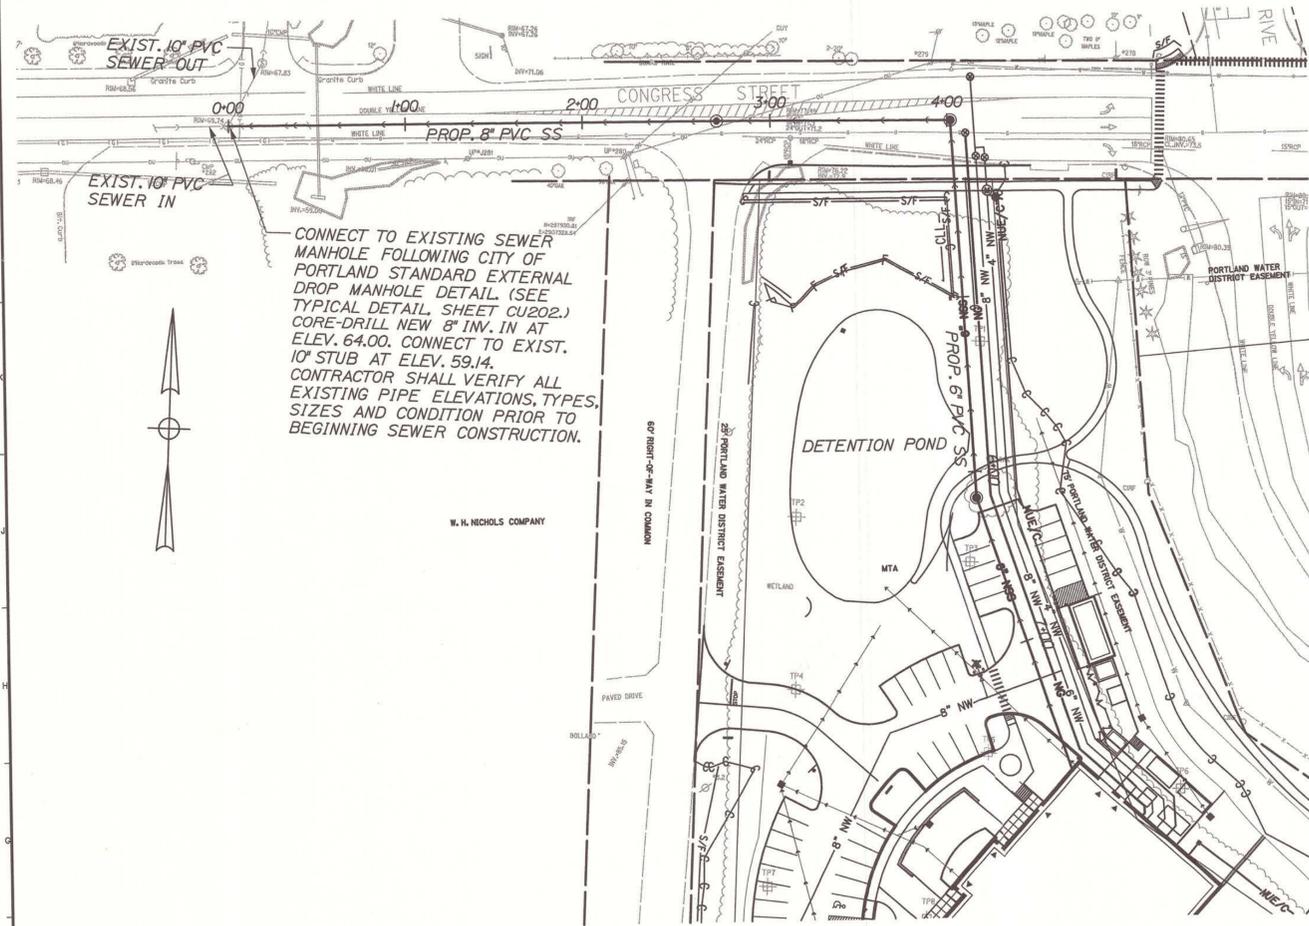


PLAN
1" = 50'

GENERAL NOTES FOR SEWERAGE CONSTRUCTION:

1. LOCATION OF ALL EXISTING UTILITIES ARE APPROXIMATE.
2. IT SHALL BE THE CONTRACTOR'S RESPONSIBILITY TO HAVE ALL THE UTILITIES LOCATE THEIR FACILITIES PRIOR TO THE START OF CONSTRUCTION.
3. PRIOR TO THE BEGINNING OF CONSTRUCTION, THE CONTRACTOR SHALL SECURE A STREET OPENING PERMIT FROM THE PORTLAND PUBLIC WORKS DEPARTMENT.
4. EXISTING PAVEMENT SHALL BE SAW CUT AND BUTTED TO THE NEW PAVEMENT. NO FEATHERING OF PAVEMENT WILL BE PERMITTED. THIS WORK SHALL BE CONSIDERED INCIDENTAL TO THE INSTALLATION OF SEWER PIPE IN THAT AREA. SEE TRENCH DETAILS ON SHEET CU202.
5. EXISTING DRAINAGE STRUCTURES SHALL NOT BE DISTURBED UNLESS OTHERWISE NOTED.
6. BEFORE CONNECTING NEW PIPES TO AN EXISTING SEWER LINE, THE CONTRACTOR SHALL NOTIFY THE SEWER MAINTENANCE DIVISION OF THE PORTLAND PUBLIC WORKS DEPARTMENT. NO WORK SHALL BE DONE WITHOUT THEIR APPROVAL.
7. THE CONTRACTOR SHALL BE RESPONSIBLE FOR REPAIRING ANY TRENCH PAVEMENT THAT HAS EXPERIENCED EXCESSIVE SETTLEMENT, CRACKING, OR OPENING OF JOINTS. REPAIRS MAY INCLUDE OVERLAY, REMOVAL OF UNACCEPTABLE MATERIALS, COMPLETE REPLACEMENT, JOINT SEALING, OR REBUTTING PAVEMENT AS REQUIRED. THIS WORK MAY BE NECESSARY AFTER FINAL ACCEPTANCE OF WORK OR PRIOR TO THE END OF THE ONE YEAR GUARANTEE. THIS WORK SHALL BE AT THE CONTRACTOR'S EXPENSE.
8. ALL MANHOLE FRAMES SHALL BE SUPPLIED WITH SOLID MANHOLE COVERS; SEE STANDARD DETAILS.
9. NO ADDITIONAL PAYMENT WILL BE MADE FOR THE REMOVAL OF EXISTING PIPES.
10. PROPOSED RIM ELEVATIONS SHOWN ARE INTERPOLATED FROM PROPOSED AND EXISTING GRADING INFORMATION. ACTUAL RIM ELEVATIONS SHALL BE BASED ON FINAL FIELD GRADING, ULTIMATE BUILDING ELEVATIONS AND RELATIVE POSITION OF RIM AS SHOWN ON THE DETAILS.
11. LOCATION OF PROPOSED UTILITIES SHALL BE IN ACCORDANCE WITH THE CITY OF PORTLAND STREET DESIGN STANDARDS, AND ALL APPLICABLE INDUSTRY/UTILITY CODES.



LOCUS MAP

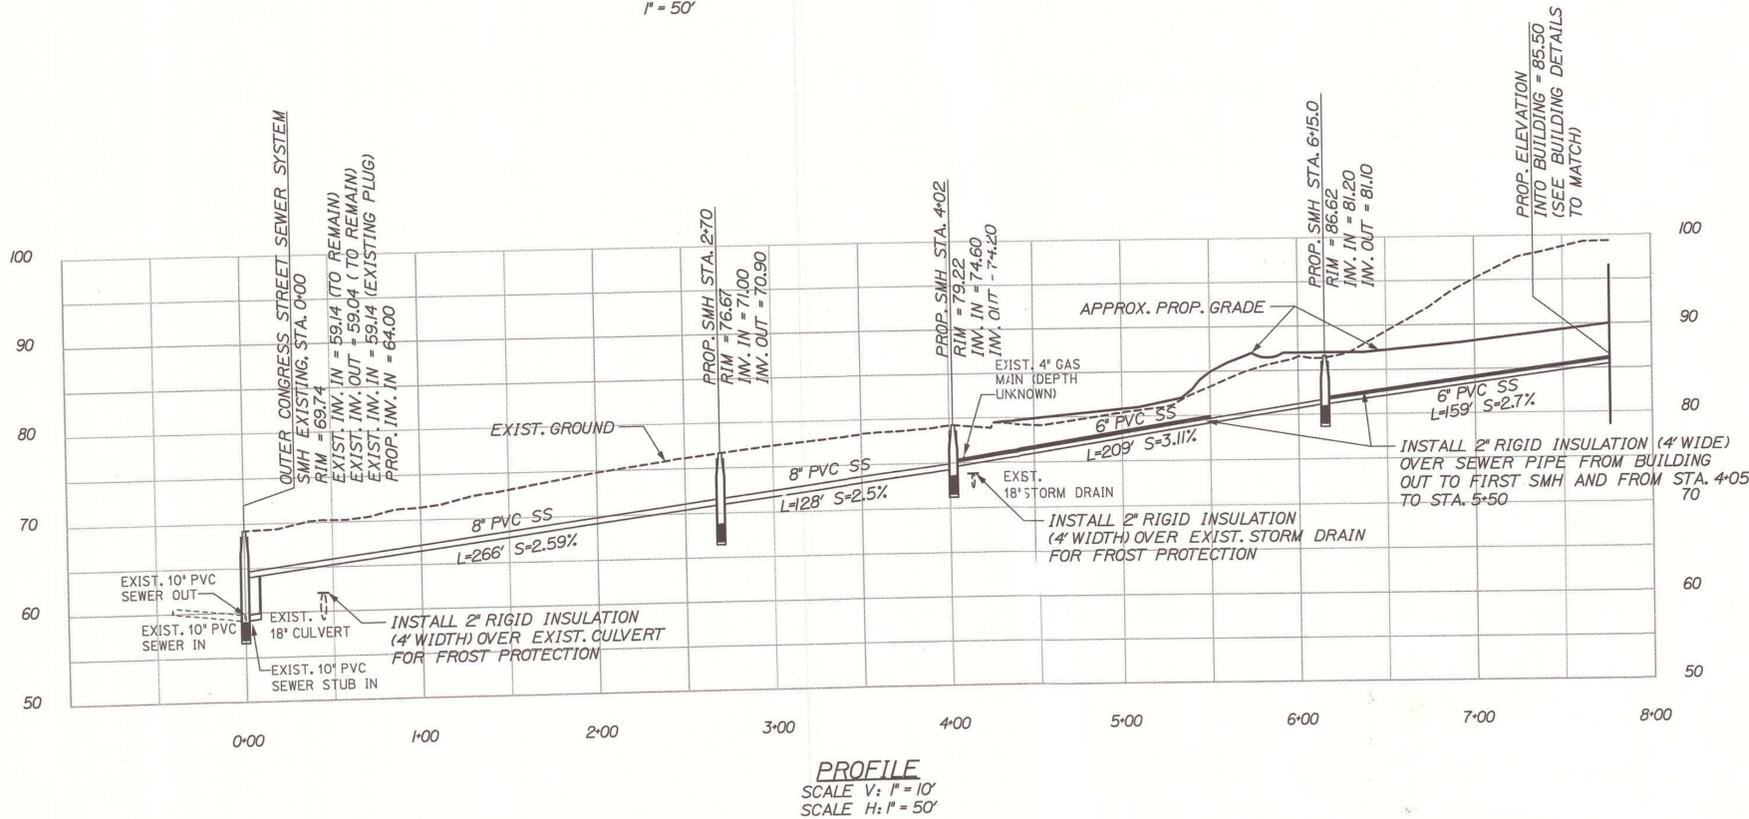

PROFILE
SCALE V: 1" = 10'
SCALE H: 1" = 50'

AS BUILT
Owner Copy

PREPARED BY: **HNTB**

HNTB CORP.
2 THOMAS DRIVE
WESTBROOK, ME
04092

**SM
RT**

ARCHITECTURE ENGINEERING PLANNING
SWRT
144 Fore Street/P.O. Box 618
Portland, Maine 04104
tel. (207) 772-3846
fax. (207) 772-1070



PROJECT TITLE:
**MAINE TURNPIKE AUTHORITY
ADMINISTRATION BUILDING
PORTLAND, MAINE**

**ISSUED FOR BIDDING/CONSTRUCTION
7-9-07**

REV	DESCRIPTION	DATE
3	DOCS FOR OWNER REVIEW	8-11-07
2	ISSUED FOR CITY REVIEW	5-03-07
1	100% OWNER REVIEW	3-23-07
0	ISSUED FOR PERMITTING	1-16-07

GRAPHIC SCALE:
0" = 1"


SCALE: AS NOTED

PROJECT MANAGER: GAB
JC/DRAWN BY: MPC
A/E OF RECORD: GAB
CAD FILE: X
PROJECT NO: 2007.07
DATE: 01/07


SHEET TITLE:
**SEWER PLAN
AND PROFILE**

SHEET No. **CU201**


M:\JOBS\09009\967 BUILDINGS AND MAINTENANCE AREAS\041 NEW ADMINISTRATION BUILDING\CAD\DETAIL SHEETS.DWG 06/29/07 13:35

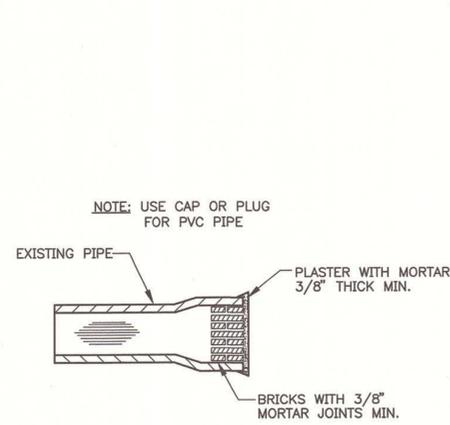


1 MASONRY PLUG DETAIL N.T.S.

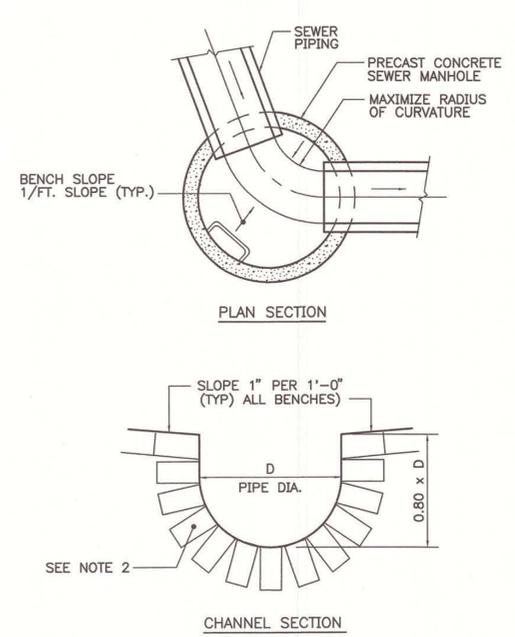


2 MANHOLE INVERT CHANNEL N.T.S.

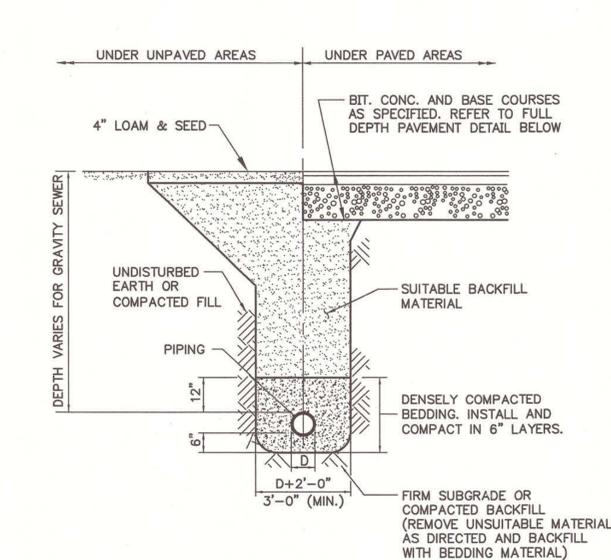


3 PIPE TRENCH TYPICAL SECTION N.T.S.

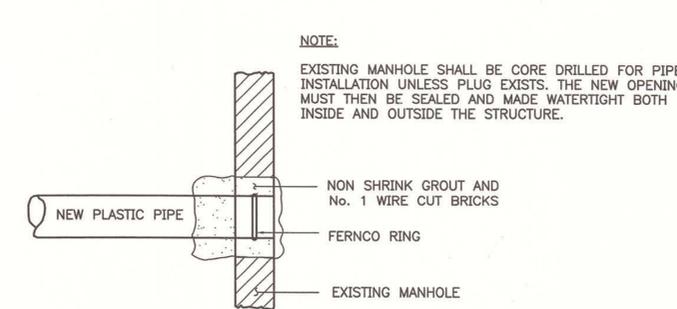

4 PIPE CONNECTION DETAIL N.T.S.

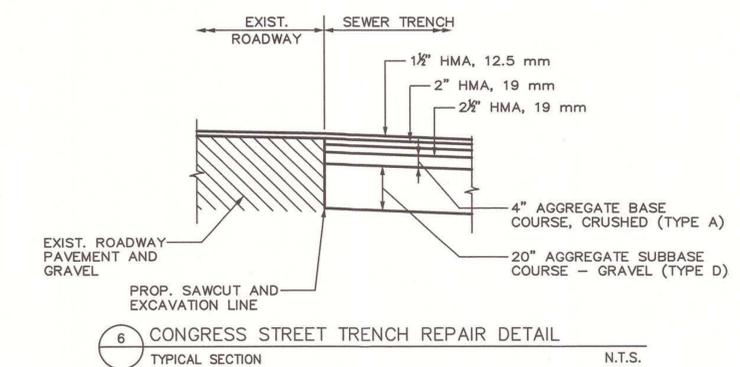

6 CONGRESS STREET TRENCH REPAIR DETAIL TYPICAL SECTION N.T.S.

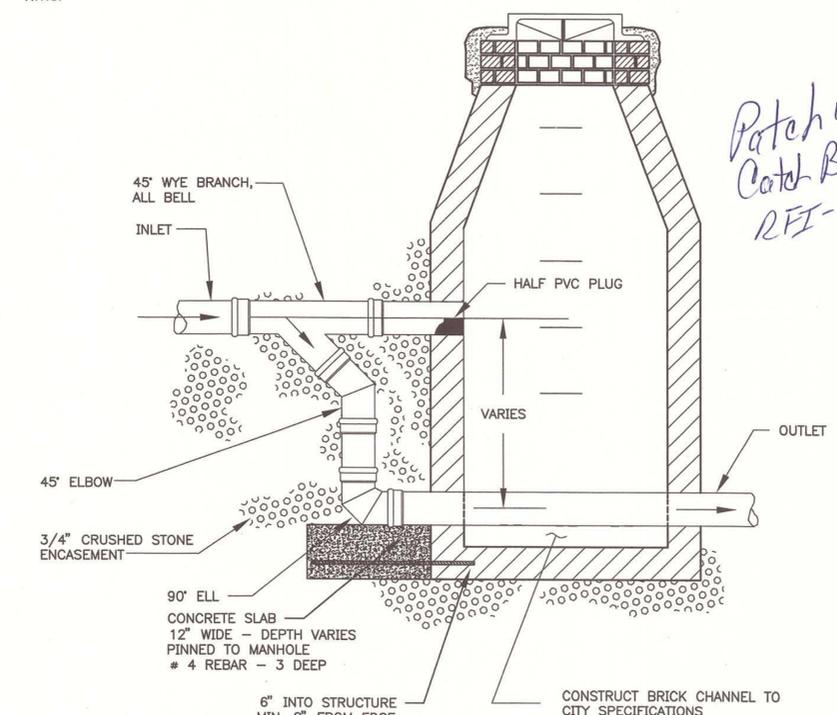

5 TYPICAL OUTSIDE DROP MANHOLE TYPICAL SECTION N.T.S.

Patching of Catch Basin's RFI-131

AS BUILT
Owner Copy

HNTB
PREPARED BY: HNTB
HNTB CORP.
2 THOMAS DRIVE
WESTBROOK, ME
04092

SM
RT
ARCHITECTURE ENGINEERING PLANNING
SMRT
144 Fore Street/P.O. Box 618
Portland, Maine 04104
Tel. (207) 772-3846
Fax. (207) 772-1070



PROJECT TITLE: MAINE TURNPIKE AUTHORITY ADMINISTRATION BUILDING PORTLAND, MAINE
ISSUED FOR BIDDING/CONSTRUCTION 7-9-07

REV	DESCRIPTION	DATE
1	ISSUED FOR CITY REVIEW	5-03-07

GRAPHIC SCALE: 0" = 1"
SCALE: AS NOTED
PROJECT MANAGER: GAB
JC/DRAWN BY: MPC
A/E OF RECORD: GAB
CAD FILE: X
PROJECT NO: 2007.07
DATE: 05/07

SHEET TITLE: SEWER DETAILS
SHEET No. CU202


M:\JOBS\09008\967 BUILDINGS AND MAINTENANCE AREAS\041 NEW ADMINISTRATION BUILDING\CAD\DETAIL SHEETS.DWG 06/29/07 13:35

Patching Catch Basin 5-131 RFI


NOTE:
MANHOLE CHANNELS REQUIRING CHANGE OF ALIGNMENT, TO BE BUILT ON SMOOTH RADIUS. CHANNEL TO BE SHAPED TO ACCEPT ADDITIONAL INLET PIPES.

SEWER MANHOLE LOCATIONS


MANHOLE	COORDINATES	
	NORTHING	EASTING
SMH 1 (EXISTING)	297953.5395	2907095.4069
SMH 2	297965.2958	2907371.0969
SMH 3	297970.3011	2907503.0420
SMH 4	297758.3340	2907525.5049

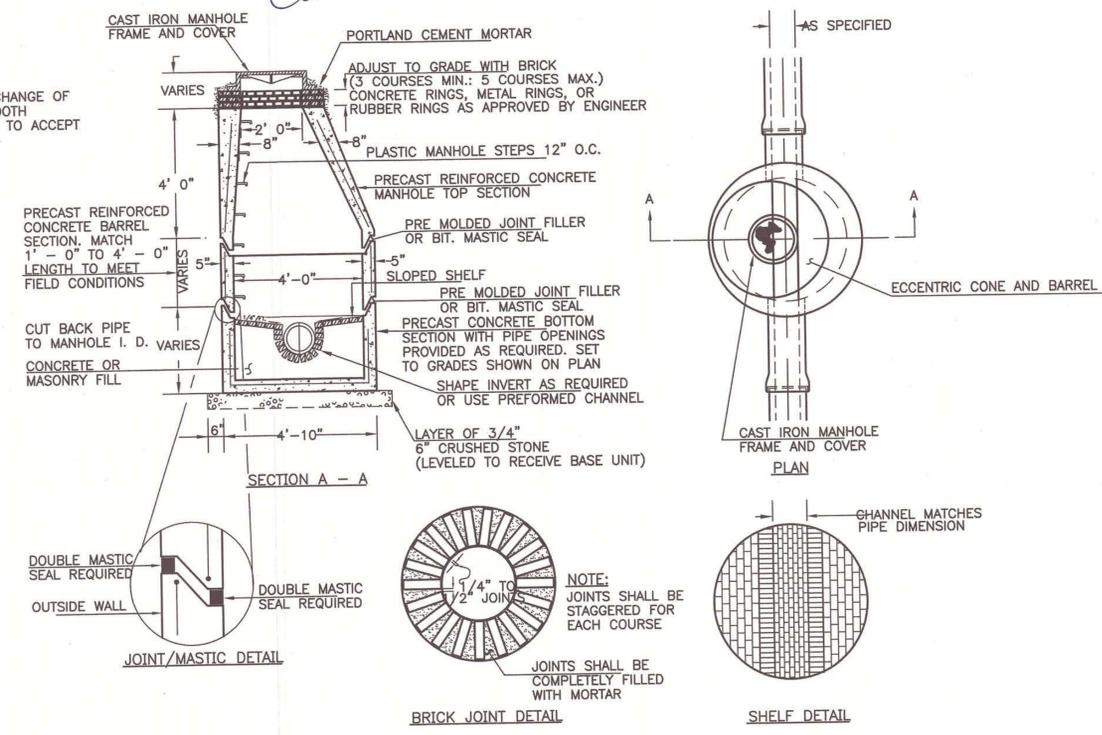

1 PRECAST CONCRETE SEWER MANHOLE
TYPICAL SECTION N.T.S.

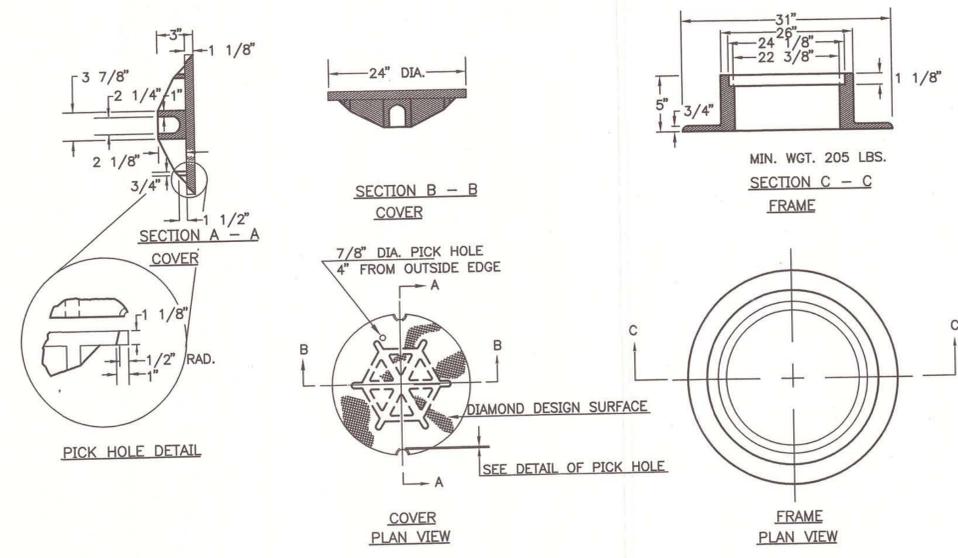

2 TYPE "A" CAST IRON MANHOLE COVER AND FRAME
N.T.S.

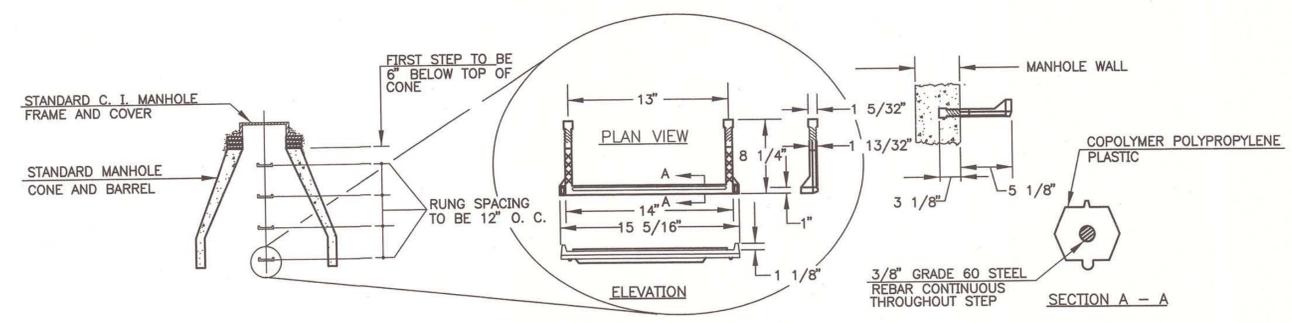


3 PLASTIC MANHOLE STEPS
N.T.S.

HNTB CORP.
2 THOMAS DRIVE
WESTBROOK, ME
04092

HNTB

ARCHITECTURE ENGINEERING PLANNING

SMRT
144 Fore Street/P.O. Box 618
Portland, Maine 04104
tel. (207) 772-3846
fax. (207) 772-1070

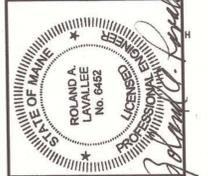

PROJECT TITLE:
MAINE TURNPIKE AUTHORITY
ADMINISTRATION BUILDING
PORTLAND, MAINE


ISSUED FOR BIDDING/CONSTRUCTION
7-9-07

REV	DESCRIPTION	DATE
1	ISSUED FOR CITY REVIEW	5-03-07

GRAPHIC SCALE:
0" 1"
SCALE: AS NOTED
PROJECT MANAGER: GAB
JC/DRAWN BY: MPC
A/E OF RECORD: GAB
CAD FILE: X
PROJECT NO: 2007.07
DATE: 05/07

SHEET TITLE:
SEWER DETAILS
SHEET 2
SHEET N.º: CU203

AS BUILT
Owner Copy

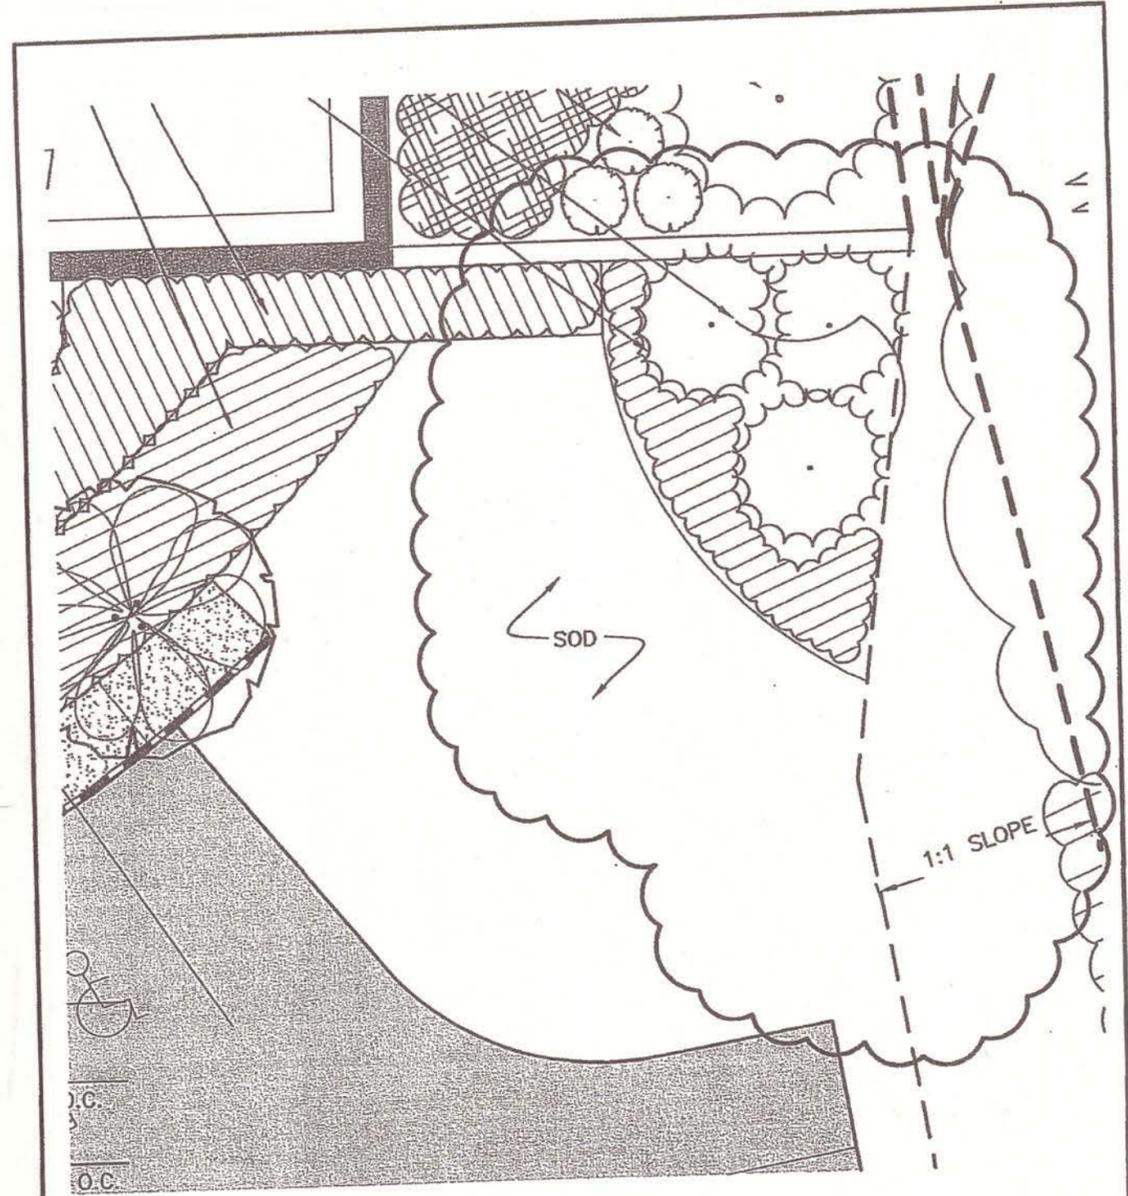


**SM
RT**

ARCHITECTURE ENGINEERING PLANNING
 SMRT
 144 Fore Street/P.O. Box 618 PORTLAND, MAINE 04104
 tel. (207) 772-3846 / fax. (207) 772-1070

SCALE: 1" = 10'
 CAD FILE: LP201-06016
 PROJECT No. 06016
 REF. SHEET: LP201
 PM: SLB
 A/E: MGJ
 DATE: 11-30-07

PROJECT: MAINE TURNPIKE AUTHORITY
 ADMINISTRATION BUILDING
 SUBJECT: PARKING LOT @ LEDGE
 PLANTING RECONFIGURATION

SUPPLEMENTAL INSTRUCTION
CCD-1
 SHEET NO.
L-2
 © COPYRIGHT 2007 SMRT INC.

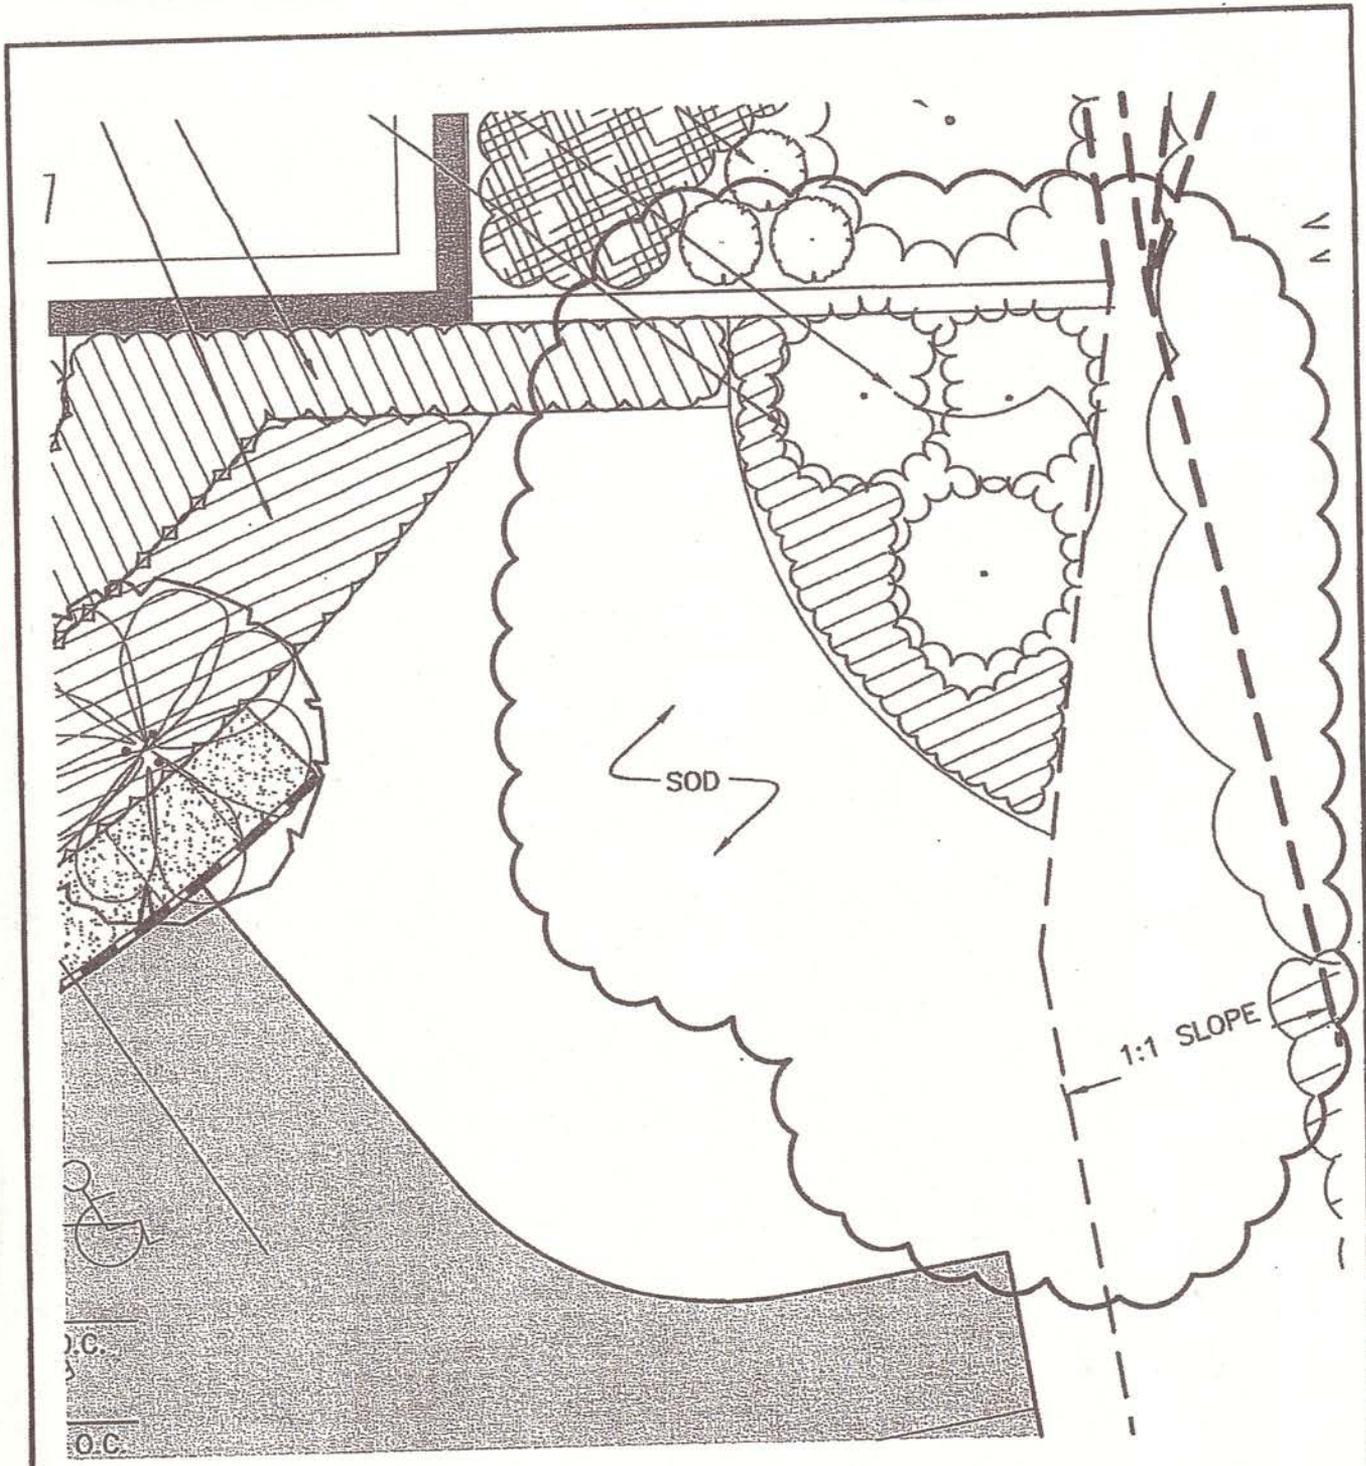

**SM
RT**

ARCHITECTURE ENGINEERING PLANNING

SMRT
144 Fore Street/P.O.Box 618 PORTLAND, MAINE 04104
tel. (207) 772-3846 / fax. (207) 772-1070

PROJECT:

**MAINE TURNPIKE AUTHORITY
ADMINISTRATION BUILDING**

SUBJECT:

**PARKING LOT @ LEDGE
PLANTING RECONFIGURATION**

SCALE: 1" = 10'

CAD FILE: LP201-06016

PROJECT No. 06016

REF. SHEET: LP201

PM: SLB


SUPPLEMENTAL INSTRUCTION
CCD-1

A/E: MGJ

SKETCH No.
L-2

DATE: 11-30-07

© COPYRIGHT 2007 SMRT INC.

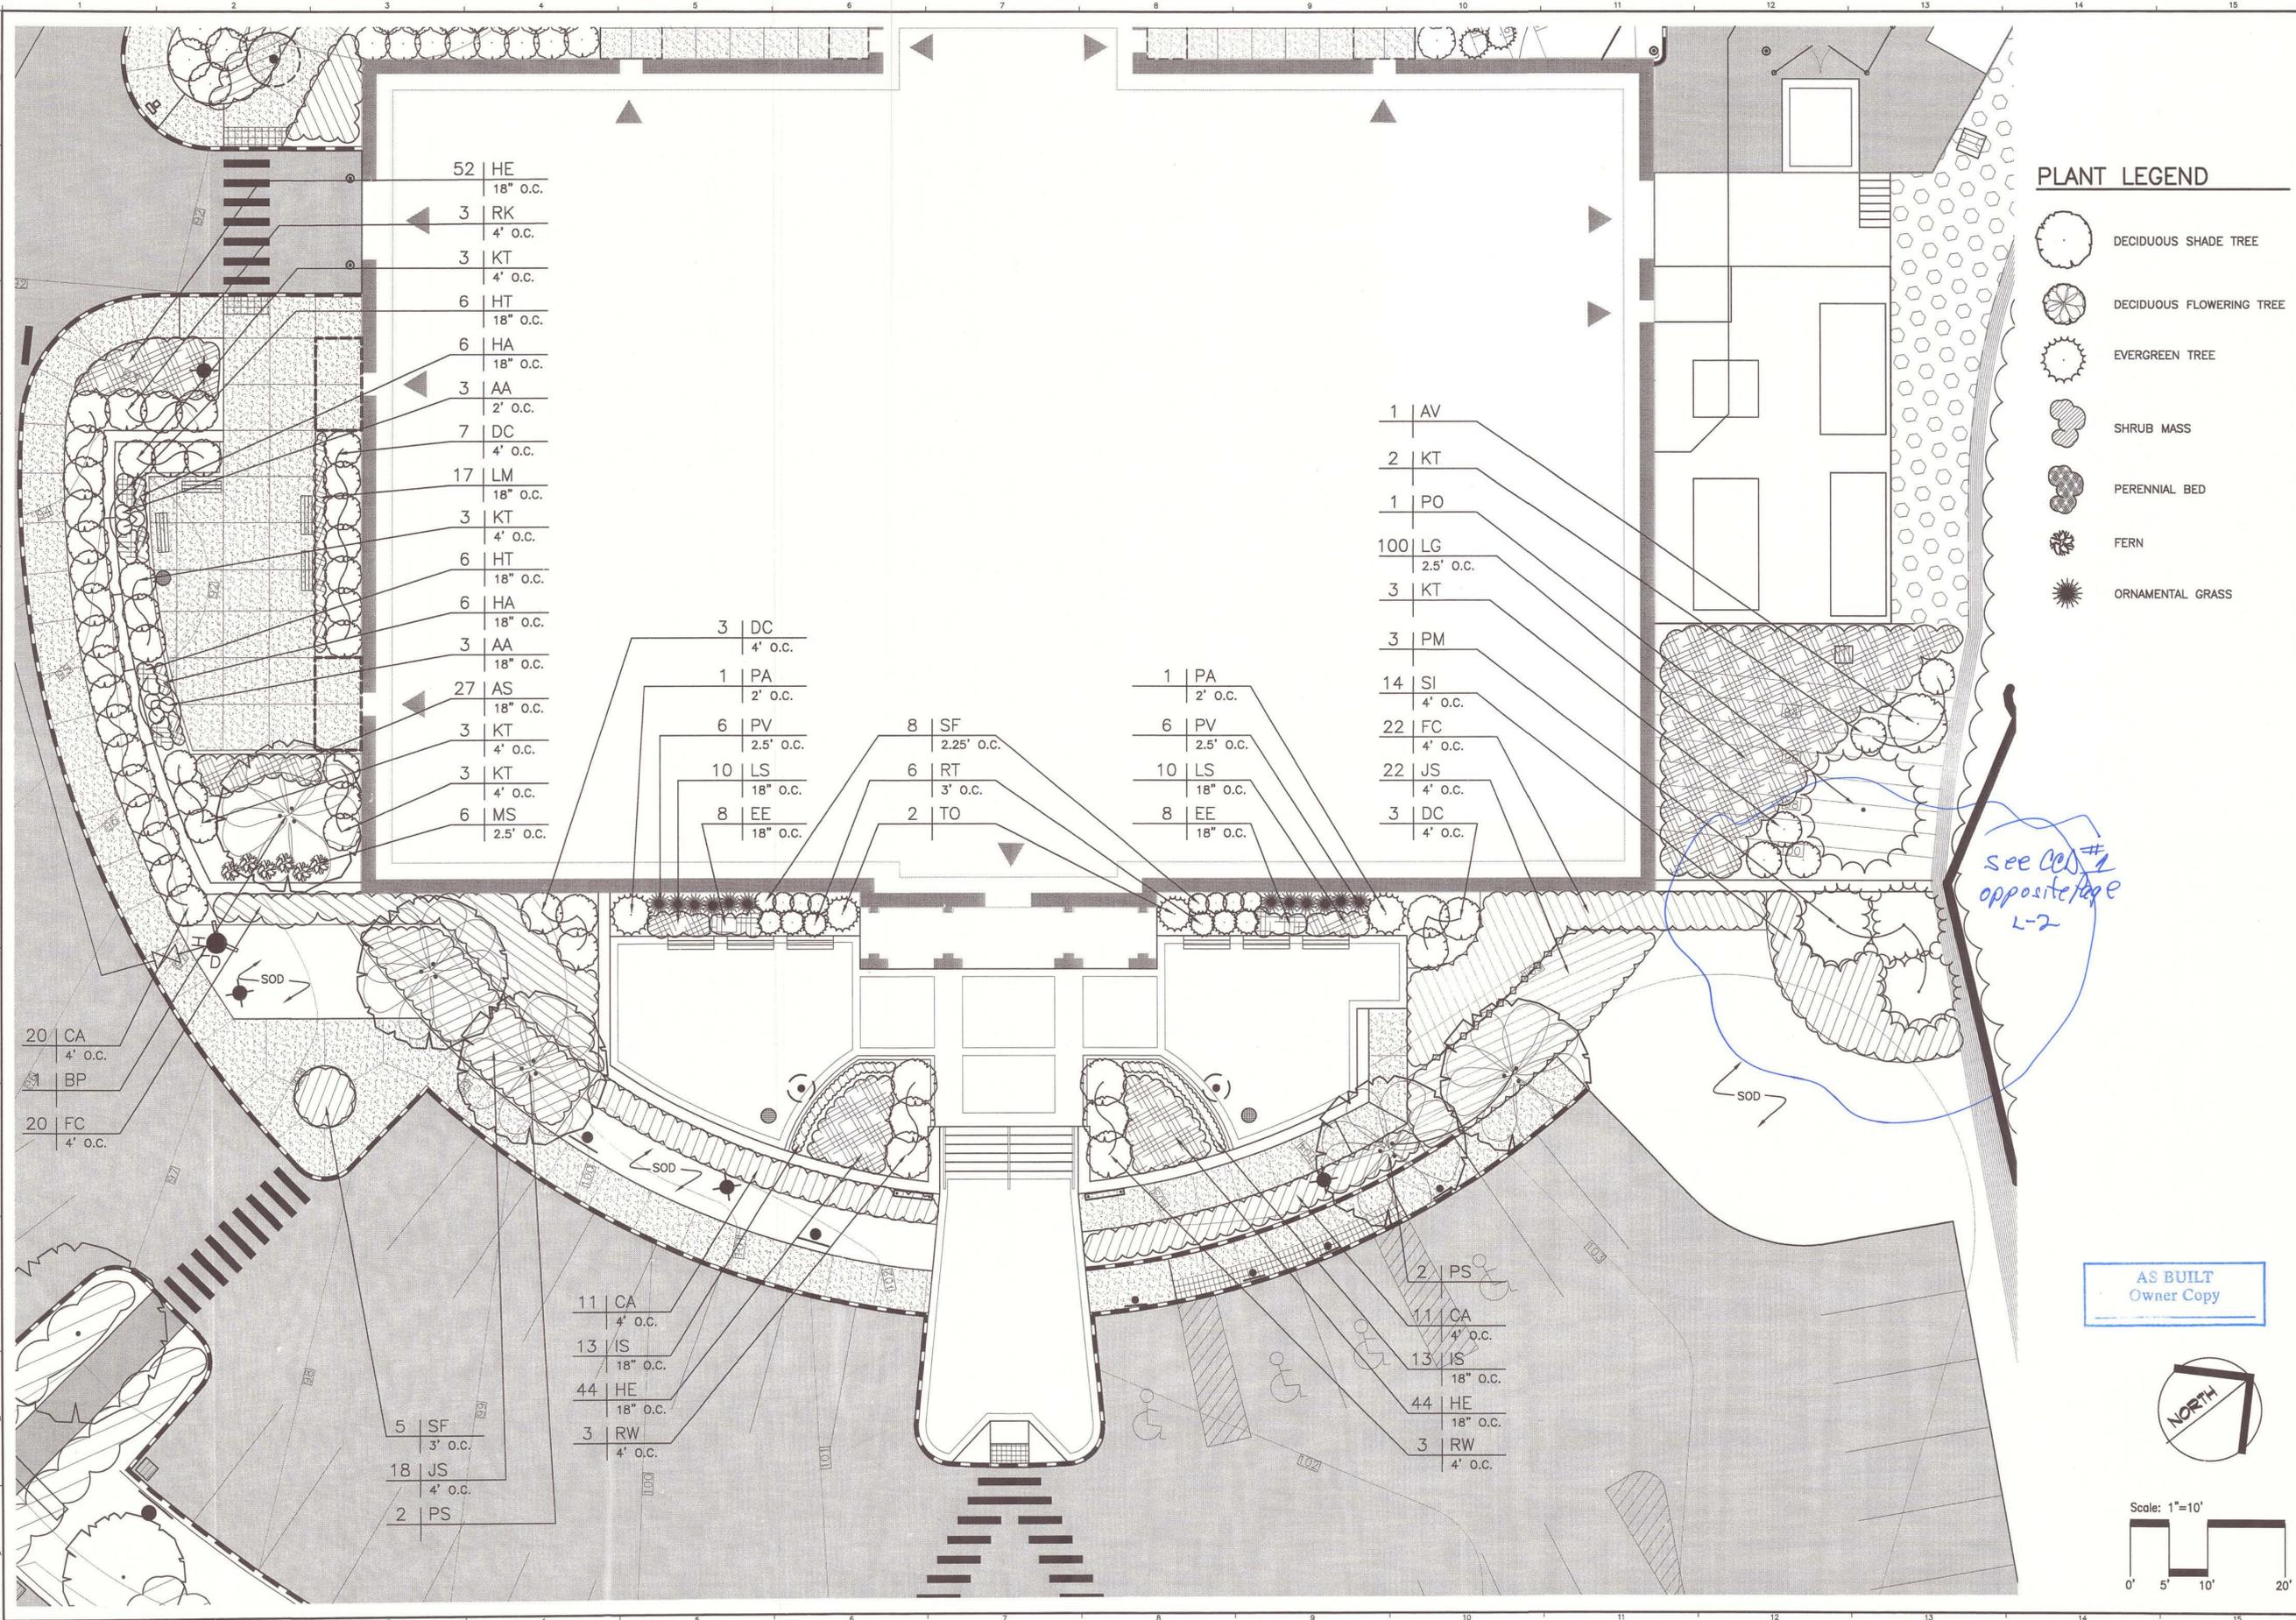


PLANT LEGEND

- DECIDUOUS SHADE TREE
- DECIDUOUS FLOWERING TREE
- EVERGREEN TREE
- SHRUB MASS
- PERENNIAL BED
- FERN
- ORNAMENTAL GRASS

*see CD #
opposite page
L-2*

**AS BUILT
Owner Copy**

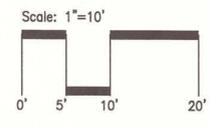

**SM
RT**

ARCHITECTURE ENGINEERING PLANNING
SMRT
144 Fore Street/P.O. Box 618
Portland, Maine 04104
tel. (207) 772-3846
fax. (207) 772-1070



PROJECT TITLE:
**MAINE TURNPIKE AUTHORITY
ADMINISTRATION BUILDING**
PORTLAND, MAINE

ISSUED FOR BIDDING/CONSTRUCTION
7-9-07


REV	DESCRIPTION	DATE
0	BIDDING/CONSTRUCTION	7-9-07

GRAPHIC SCALE:
0" 1"


SCALE: SHOWN
PROJECT MANAGER: SLB
JC/DRAWN BY: TCM/PAF
A/E OF RECORD: MGJ
CAD FILE: 06016-LP201
PROJECT NO: 06016
DATE: 7-9-07

SHEET TITLE:
**DETAIL LANDSCAPE
PLAN**

SHEET No.
LP201

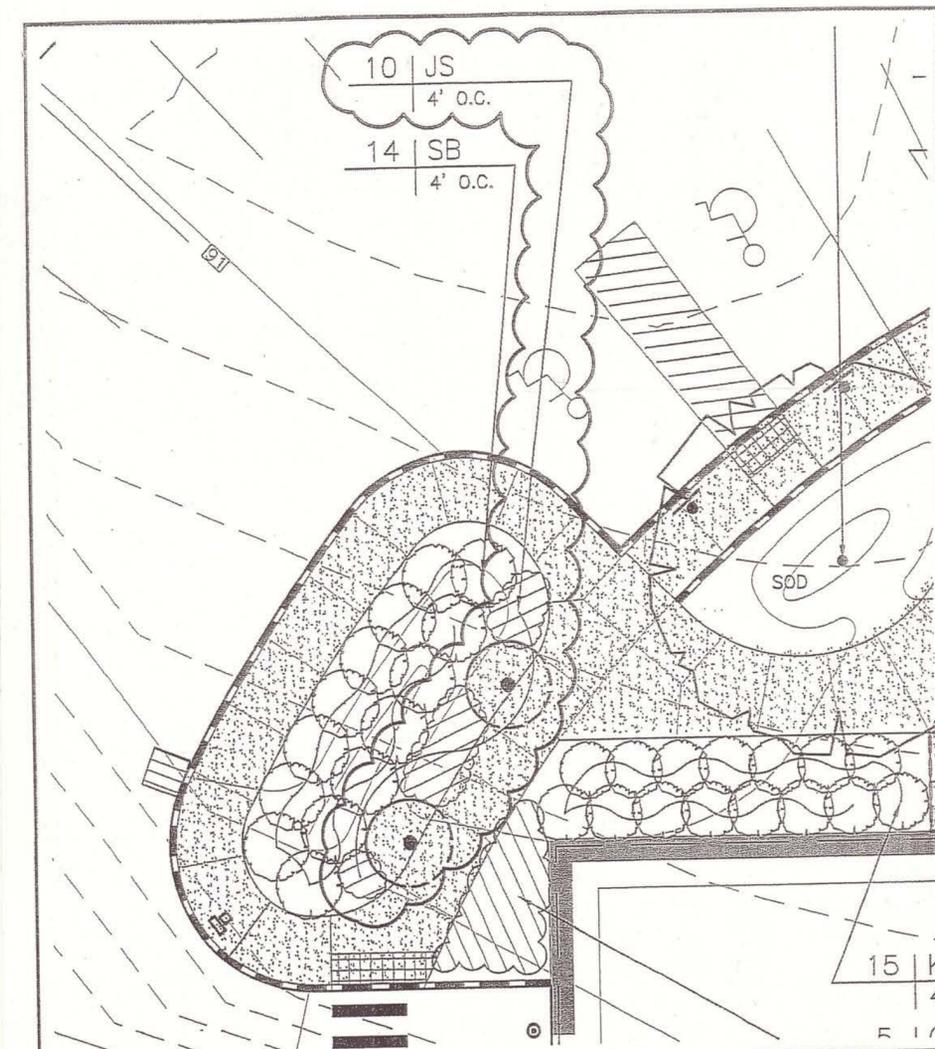

SM RT ARCHITECTURE ENGINEERING PLANNING SMRT 144 Fore Street/P.O.Box 618 PORTLAND, MAINE 04104 tel. (207) 772-3846 / fax. (207) 772-1070	SCALE: 1" = 10'
	CAD FILE: LP202-06016
PROJECT No. 06016	REF. SHEET: LP202
PM: SLB	ADD-4
A/E: MGJ	L-8
DATE: 8-10-07	
PROJECT: MAINE TURNPIKE AUTHORITY ADMINISTRATION BUILDING SUBJECT: PLANT CLARIFICATION	

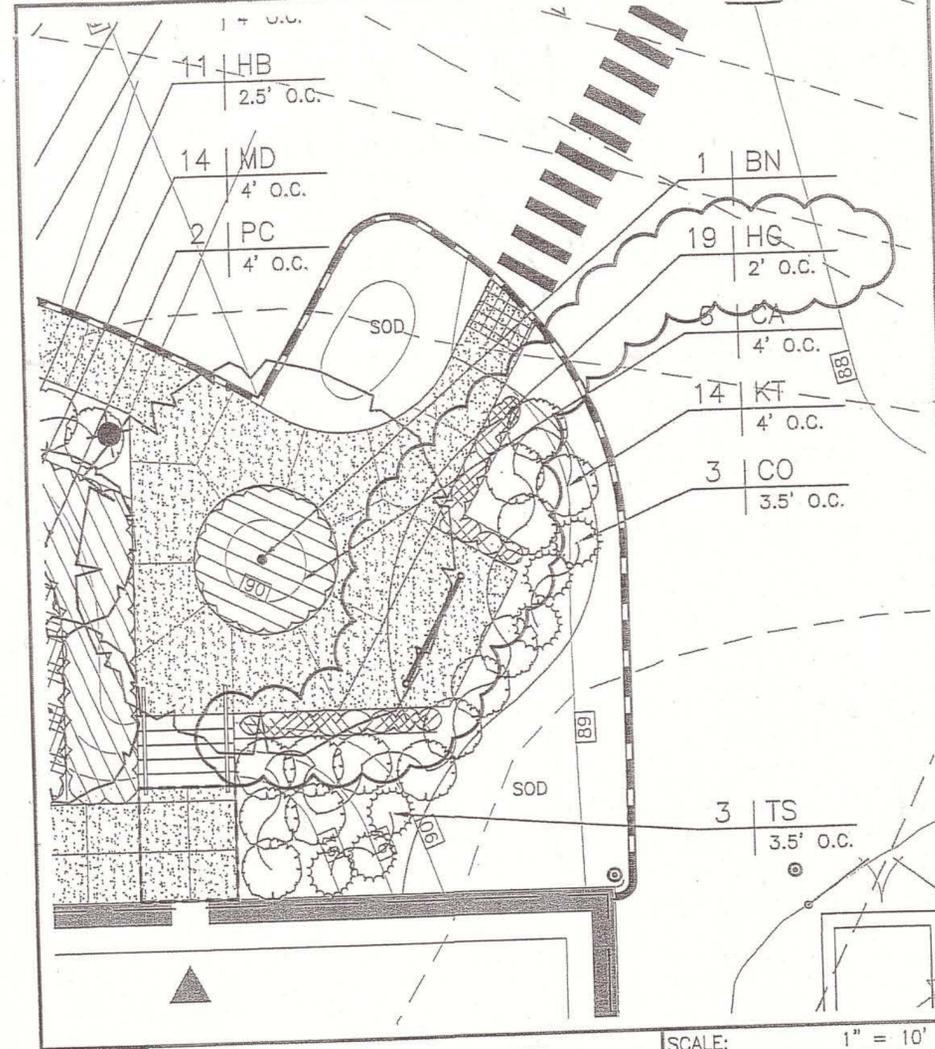

SM RT ARCHITECTURE ENGINEERING PLANNING SMRT 144 Fore Street/P.O.Box 618 PORTLAND, MAINE 04104 tel. (207) 772-3846 / fax. (207) 772-1070	SCALE: 1" = 10'
	CAD FILE: LP202-06016
PROJECT No. 06016	REF. SHEET: LP202
PM: SLB	ADD-4
A/E: MGJ	L-9
DATE: 8-10-07	
PROJECT: MAINE TURNPIKE AUTHORITY ADMINISTRATION BUILDING SUBJECT: PLANT CLARIFICATION	



REV	DESCRIPTION	DATE
0	BIDDING/CONSTRUCTION	7-9-07

GRAPHIC SCALE:
 0" 1"

SCALE: SHOWN
 PROJECT MANAGER: SLB
 JC/DRAWN BY: TCM/PAF
 A/E OF RECORD: MGJ
 CAD FILE: 06016-LP202
 PROJECT NO: 06016
 DATE: 7-9-07


SHEET TITLE:
**DETAIL LANDSCAPE
 PLAN**

SHEET No
LP202

PLANT LEGEND

- DECIDUOUS SHADE TREE
- DECIDUOUS FLOWERING TREE
- EVERGREEN TREE
- SHRUB MASS
- PERENNIAL BED
- FERN
- ORNAMENTAL GRASS

NOTE: LOAM AND
 SEED ALL AREAS
 NOT OTHERWISE
 DESIGNATED FOR
 PLANTING

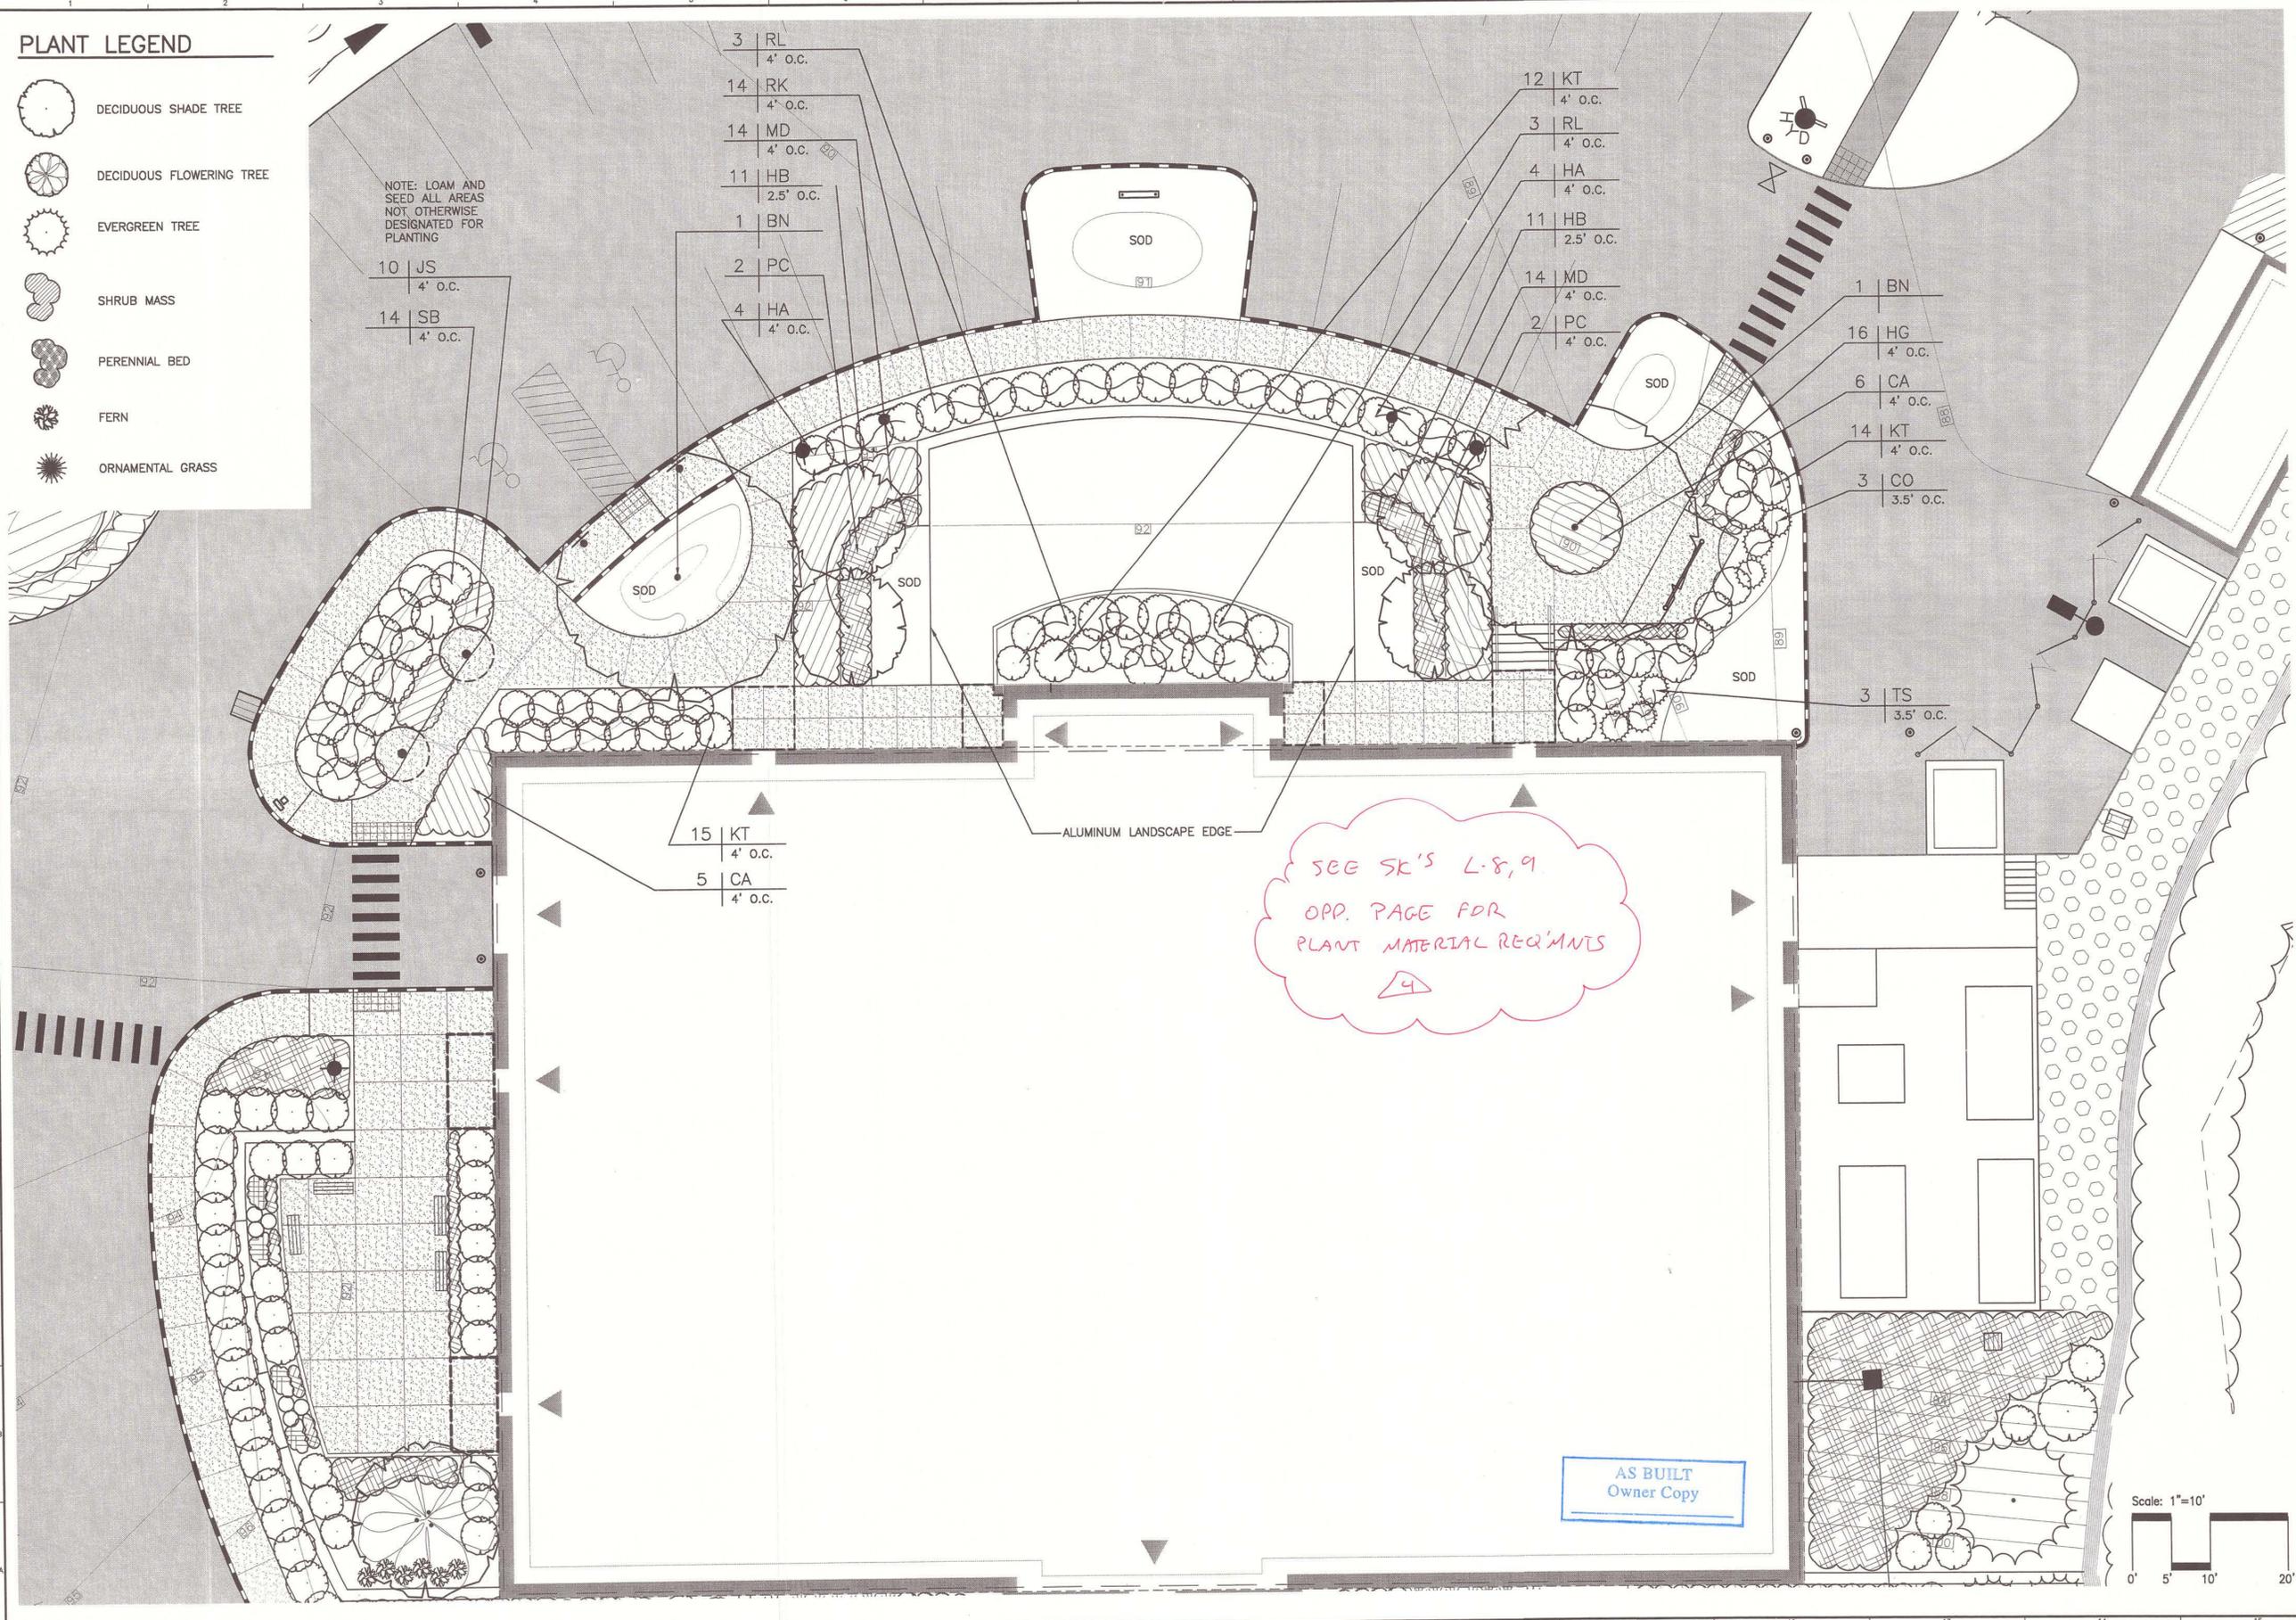

- 3 | RL
4' o.c.
- 14 | RK
4' o.c.
- 14 | MD
4' o.c.
- 11 | HB
2.5' o.c.
- 1 | BN
- 2 | PC
- 4 | HA
4' o.c.


- 12 | KT
4' o.c.
- 3 | RL
4' o.c.
- 4 | HA
4' o.c.
- 11 | HB
2.5' o.c.
- 14 | MD
4' o.c.
- 2 | PC
4' o.c.

- 1 | BN
- 16 | HG
4' o.c.
- 6 | CA
4' o.c.
- 14 | KT
4' o.c.
- 3 | CO
3.5' o.c.

- 15 | KT
4' o.c.
- 5 | CA
4' o.c.

SEE SK'S L-8,9
 OPP. PAGE FOR
 PLANT MATERIAL REQ'MENTS
 4

AS BUILT
 Owner Copy

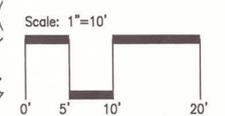

PLANT LIST: NATURALIZING MIX

QUANT.	MARK	SCIENTIFIC NAME / COMMON NAME	SIZE CAL.	SIZE HT.	ROOT	REMARKS
14		Acer rubrum / Red Maple	-	5-6'	container	Full
14		Betula papyrifera 'Renaissance Reflection' / White Birch	-	5-6'	container	Full
14		Fraxinus pennsylvanica / Green Ash	-	5-6'	container	Full
14		Juniperus virginiana / Eastern Red Cedar	-	2-3'	container	Full
14		Pinus resinosa / Red Pine	-	2-3'	container	Full
14		Pinus strobus / White Pine	-	2-3'	container	Full
46		Aronia arbutifolia / Black chokecherry	-	12-15"	container	Full
46		Lindera benzoin / Spicebush	-	12-15"	container	Full
46		Symphoricarpos alba / Common Snowberry	-	12-15"	container	Full

PLANT LIST: SHRUBS

QUANT.	MARK	SCIENTIFIC NAME / COMMON NAME	SIZE CAL.	SIZE HT.	ROOT	REMARKS
13	AV	Azalea vaseyi / Pinkshell Azalea	-	3-4'	B&B	Full
64	CA	Cotoneaster apiculata / Cranberry Cotoneaster	-	18-24"	B&B	Full
7	CC	Cotinus coggygria 'Royal Purple'	-	3-4'	B&B	Full
3	CO	Chamaecyparis obtusa 'Compacta' / Dwarf Hinoki Cypress	-	4-5"	B&B	Full
126	CP	Comptonia peregrina/Sweetfern	-	#1	Cont.	Full
13	DC	Daphne 'Carol Mackii' / Daphne	-	18-24"	B&B	Full
42	FC	Forsythia courtasol 'Weekend' / Forsythia	-	12-18"	B&B	Full
8	HA	Hydrangea arborescens 'Annabelle' / Hydrangea	-	2-2 1/2'	B&B	Full
2	IVs	Ilex verticillata v. 'Southern Gentleman' / Winterberry	-	3-4'	B&B	Male
6	IVw	Ilex verticillata v. 'Winter Red' / Winterberry	-	3-4'	B&B	Female
148	JB	Juniperus 'Bar Harbor' / Bar Harbor Juniper	-	-	B&B	Full
86	JC	Juniperus chinensis 'Seagreen' / Seagreen Juniper	-	2-2 1/2'	B&B	Full
95	JS	Juniperus sargentii / Sargent Juniper	-	12-18"	B&B	Full
58	KT	Kalmia 'Tiddlywinks' / Mountain Laurel	-	18-24"	B&B	Full
28	MD	Microbiota decussata / Siberian Carpet Cypress	-	-	B&B	Full
62	MP	Myrica pensylvanica/Northern Bayberry	-	#3	Cont.	Full
2	PA	Picea abies 'Nidiformis' / Birdsnest Spruce	-	12-18"	B&B	Full
36	PK	Potentilla 'Katharine Dykes' / Potentilla	-	18-24"	B&B	Full
3	PM	Pinus Mugo 'Mugo' / Dwarf Mugo Pine	-	2-2 1/2'	B&B	Full
26	PT	Prunus maritima/ Beach Plum	-	#3	Cont.	Full
20	RK	Rhododendron yakusimanum 'Ken Janek' / Rhododendron	-	18-24"	B&B	Full
6	RL	Rhododendron laetevirens / Wilson Rhododendron	-	18-24"	B&B	Full
6	RT	Rhododendron 'Tottenham' / Rhododendron	-	12-18"	B&B	Full
6	RW	Rhododendron 'Windbeam' / Rhododendron	-	18-24"	B&B	Full
44	RE	Rhus typhina 'Tiger Eyes' / Tiger Eyes Sumac	-	#5	Cont.	Full
41	RR	Rosa rugosa/Rugosa Rose	-	2-3'	Cont.	Full
14	SB	Spiraea x bumalda 'Anthony Waterer' / Spiraea	-	2-2 1/2'	B&B	Full
13	SF	Spiraea fritschiana 'Wilma' / Pink Parasols Spiraea	-	18-24"	B&B	Full
14	SI	Stephanandra incisa 'Crispa' / Cutleaf stephanandra	-	12-18"	B&B	Full
2	TO	Thuja occidentalis 'Sherwood Moss' / Arborvitae	-	2-2 1/2'	B&B	Matching
3	TS	Thuja occidentalis 'Smaragd' / Emerald Green Arborvitae	-	3-4'	B&B	Full
19	VC	Viburnum carlesii/Koreanspice viburnum	-	2-2 1/2'	Cont.	Full
5	VL	Viburnum lentago/Nannyberry Viburnum	-	#5	Cont.	Full
37	VP	Viburnum plic. tomen. 'Summer Snowflake' / Viburnum	-	2-2 1/2'	B&B	Full


PLANT LIST: TREES

QUANT.	MARK	SCIENTIFIC NAME / COMMON NAME	SIZE CAL.	SIZE HT.	ROOT	REMARKS
7	AR	Acer rubrum / Red Maple	2 1/2"	-	B&B	Full
2	BN	Betula nigra / River Birch	-	10-12'	B&B	Multi-stem
1	BP	Betula papyrifera 'Renaissance Reflection' / White Birch	-	8-10'	B&B	Multi-stem
8	CV	Crataegus viridis 'Winter King' / Hawthorne	2 1/2"	-	B&B	Full
22	FE	Fraxinus excelsior 'Aureafolia' / Gold. Des. European Ash	2 1/2"	-	B&B	Full
3	JP	Juniperus communis 'Pencil Point' / Pencil Point Juniper	-	6-7'	B&B	Full
2	LD	Larix decidua 'Pendula' / Weeping Larch	-	7-8'	B&B	Full
14	OV	Ostrya virginiana / Hophornbeam	2 1/2"	-	B&B	Full
4	PC	Pyrus calleryana 'Cleveland' / Callery Pear	2 1/2"	-	B&B	Matching
1	PO	Picea Omorika / Serbian Spruce	-	2 1/2'	B&B	Full
4	PS	Prunus 'Snow Goose' / Snow Goose Cherry	2 1/2"	-	B&B	Matching
8	UA	Ulmus americana 'Pioneer' / American Elm hybrid	2 1/2"	-	B&B	Full


PLANT LIST: PERENNIALS

QUANT.	MARK	SCIENTIFIC NAME / COMMON NAME	SIZE CAL.	SIZE HT.	ROOT	REMARKS
6	AA	Astilbe arendii 'Burgundy' / False Spiraea	-	-	1 gal. cont.	Full
27	AS	Astilbe simplicifolia 'Sprite' / False Spiraea	-	-	1 gal. cont.	Full
16	EE	Euphorbia epithimoides / Cushion Spurge	-	-	1 gal. cont.	Full
22	HB	Hosta 'Big Mama' / Plantain Lily	-	-	1 gal. cont.	Full
140	HE	Hemerocallis mixture	-	-	1 gal. cont.	Staggered blooms
28	HG	Heuchera americana 'Greenspice' / Coralbelle	-	-	1 gal. cont.	Full
255	HS	Hemerocallis 'Stella d'Oro' / Daylily	-	-	1 gal. cont.	Full
12	HT	Hosta tardiana 'Halcyon' / Plantain Lily	-	-	1 gal. cont.	Full
26	IS	Iberis sempervirens / Candytuft	-	-	1 gal. cont.	Full
20	LC	Leucanth. superbum 'Chris Hagemann' / Shasta Daisy	-	-	1 gal. cont.	Full
100	LG	Lamium stramonium 'Herman's Pride' / Yellow Archangel	-	-	1 gal. cont.	Full
17	LM	Lamium maculatum 'Red Nancy' / Dead Nettle	-	-	1 gal. cont.	Full
8	LA	Leymus archarius/Blue Lyme Grass	-	-	1 gal. cont.	Full
20	LS	Lavandula angustifolia 'Hidcote Superior' / Hidcote Superior English Lavender	-	-	1 gal. cont.	Full
12	PS	Panicum virgatum 'Shenandoah' / Shenan. Switch Grass	-	-	1 gal. cont.	Full
		LS - Lavandula angustifolia 'Hidcote Superior' / Hidcote Superior English Lavender - 1 gal. pot - full.				Full


NOTE:
ALL PERENNIALS TO BE 1 GAL. CONT., MIN.

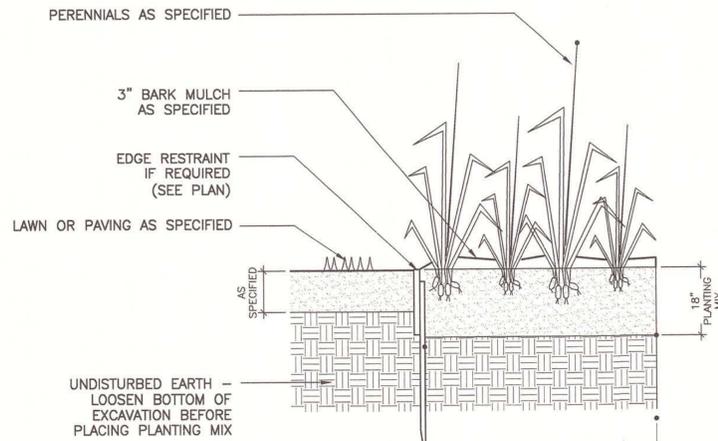


M7 PERENNIAL PLANTING DETAIL
NTS *

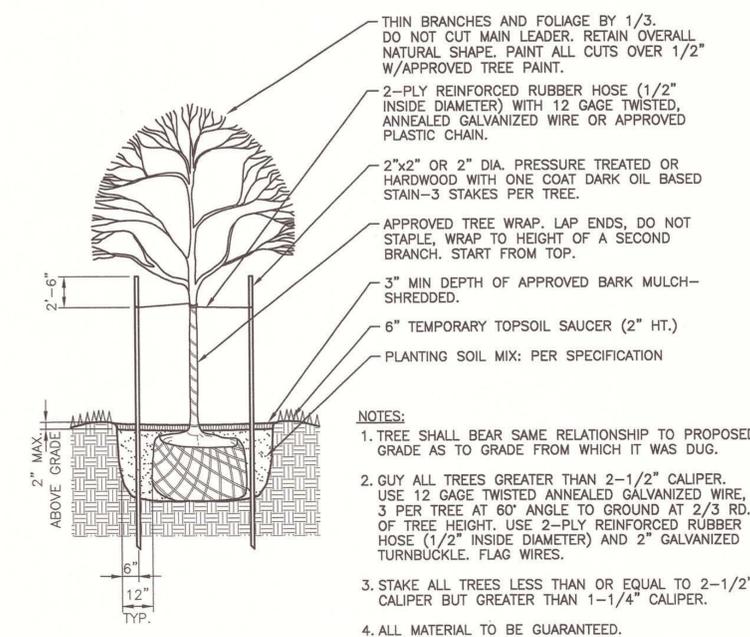

M13 DECIDUOUS TREE PLANTING DETAIL
NTS *

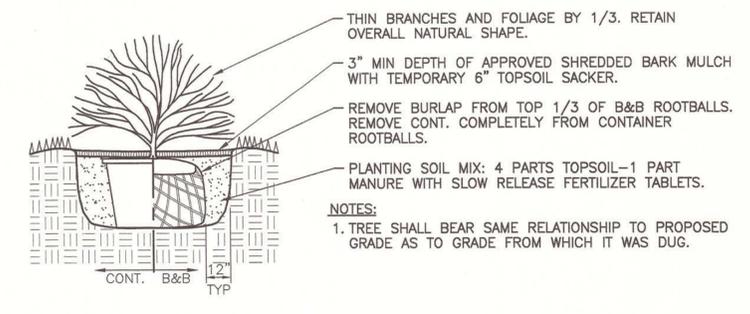

J13 SHRUB PLANTING DETAIL
NTS *

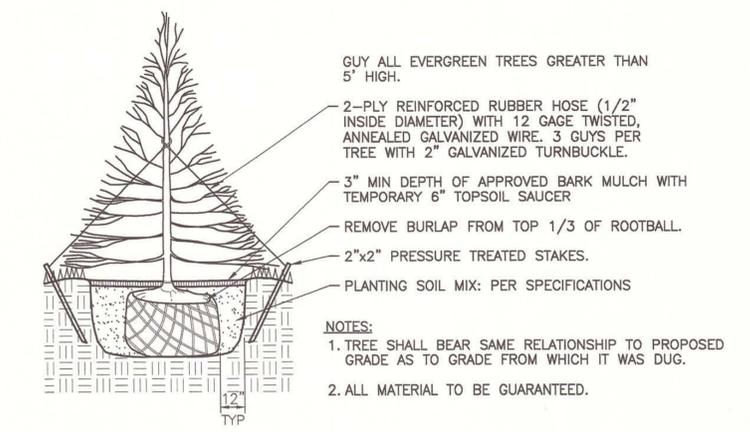

E13 EVERGREEN TREE PLANTING DETAIL
NTS *



ARCHITECTURE ENGINEERING PLANNING
SMRT
144 Fore Street/P.O. Box 618
Portland, Maine 04104
tel. (207) 772-3846
fax. (207) 772-1070



AS BUILT
Owner Copy

MAINE TURNPIKE AUTHORITY
ADMINISTRATION BUILDING
PORTLAND, MAINE


ISSUED FOR BIDDING/CONSTRUCTION
7-9-07

REV	DESCRIPTION	DATE
0	BIDDING/CONSTRUCTION	7-9-07

GRAPHIC SCALE:
0" 1"

SCALE: NTS
PROJECT MANAGER: SLB
JC/DRAWN BY: TCM/PAF
A/E OF RECORD: MGJ
CAD FILE: 06016-LP501
PROJECT NO: 06016
DATE: 7-9-07
SHEET TITLE:


LANDSCAPE DETAILS
/PLANT LISTS
SHEET No.
LP501

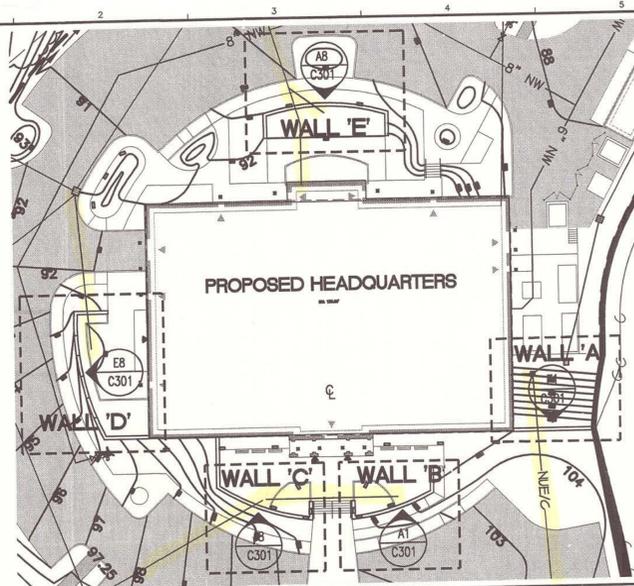

- NOTES:**
- SEE ARCHITECTURAL FOR GRANITE CAP DETAILS.
 - BRICK SHELVES TO BE 2 COURSES MINIMUM BELOW FINISHED GRADE.

*Brick Coursing Elevs.
RFI-95 SI 26+ SI 26R
Elev. + wall stems
RFI-101*

*RFI-103 on Elev. on
Footers, Tow. +
Brick Shelves*

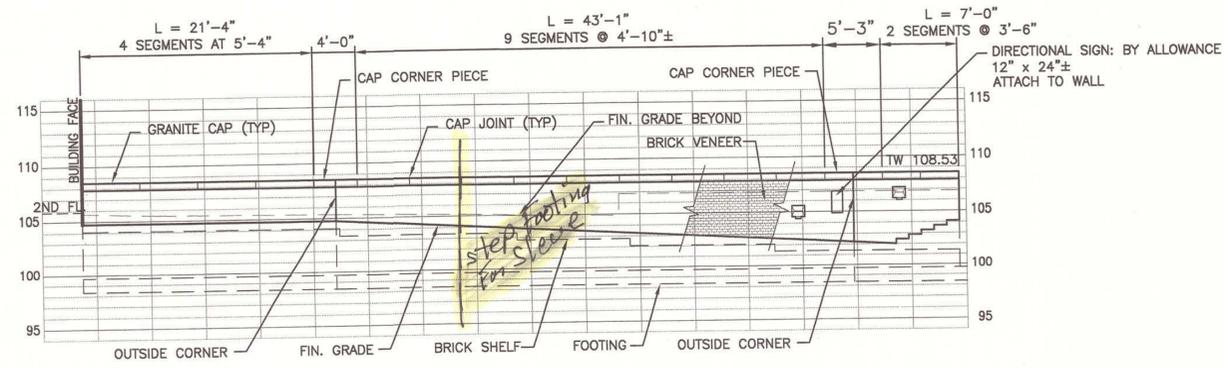


J8 WALL ELEVATION 'C': MAIN ENTRY LEFT


1/8" = 1'-0" *

J1 KEY MAP: WALL LOCATIONS

1" = 40' *

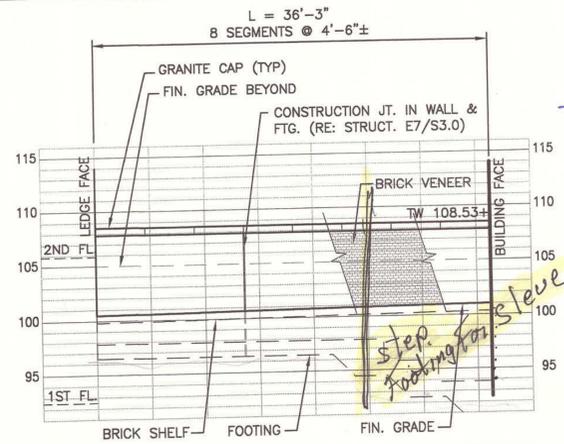

*See SI-30
For new Elevations*

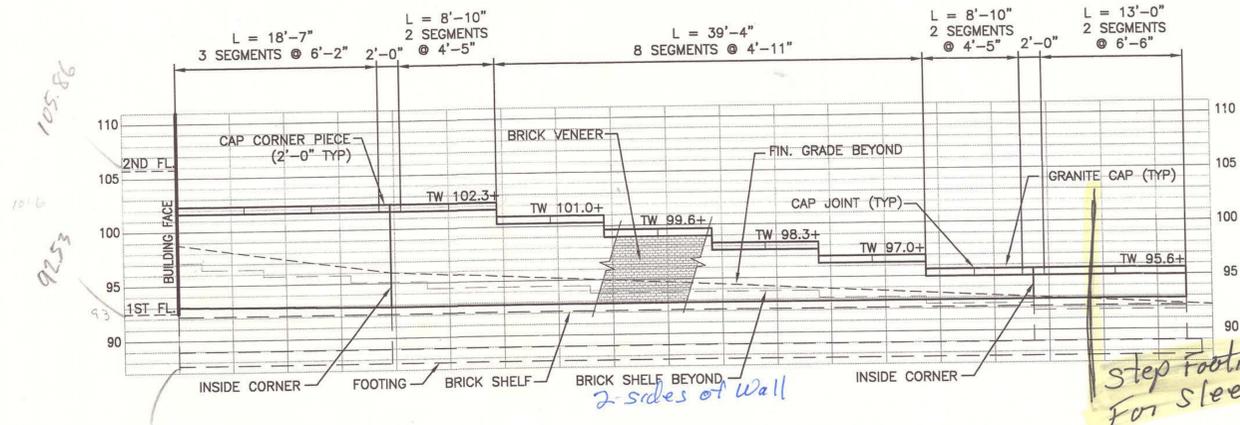


E8 WALL ELEVATION 'D': SIDE TERRACE

1/8" = 1'-0" *


E1 WALL ELEVATION 'A': SERVICE AREA

1/8" = 1'-0" *

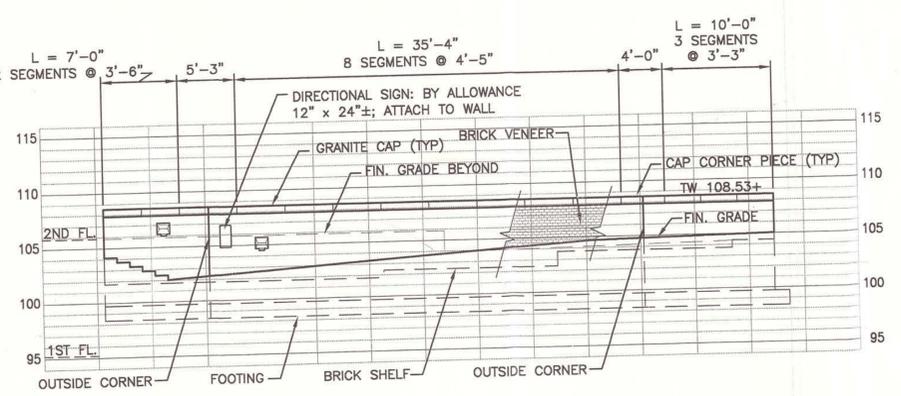

A1 WALL ELEVATION 'B': MAIN ENTRY RIGHT

1/8" = 1'-0" *

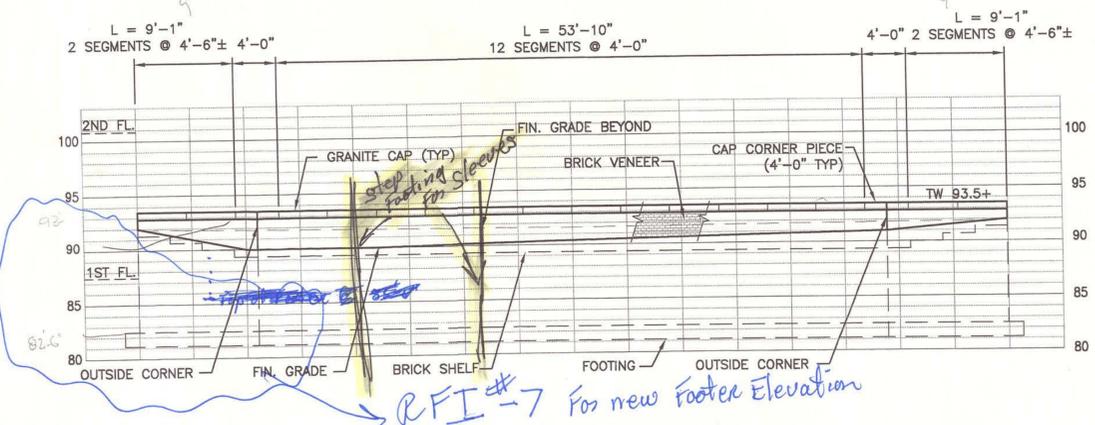

A8 WALL ELEVATION 'E': REAR TERRACE

1/8" = 1'-0" *

**SMT
RT**

ARCHITECTURE ENGINEERING PLANNING
SMT
144 Fore Street, P.O. Box 618
Portland, Maine 04104
tel. (207) 772-3846
fax. (207) 772-1070



PROJECT TITLE:
**MAINE TURNPIKE AUTHORITY
ADMINISTRATION BUILDING**
PORTLAND, MAINE

ISSUED FOR BIDDING/CONSTRUCTION
7-9-07

REV	DESCRIPTION	DATE
0	BIDDING/CONSTRUCTION	7-9-07

GRAPHIC SCALE:
0" 1"

SCALE: SHOWN
PROJECT MANAGER: SLB
JC/DRAWN BY: TCM/PAF
A/E OF RECORD: MGJ
CAD FILE: 06016-C3101
PROJECT NO: 06016
DATE: 7-9-07

SHEET TITLE:
SITE WALL ELEVATIONS

SHEET No. **C301**

**AS BUILT
Owner Copy**

RFI #7 For new Footer Elevation

Rick Paulison

From: Craig Hill [chill@wright-ryan.com]
Sent: Monday, November 17, 2008 11:00 AM
To: Rick Paulison
Cc: 'Bruce Brown'
Subject: RE: Sidewalk pavers

Yes, it came in last week. Shaw should have seen it in the mail by now, but if not "Oak Blend" was selected.

From: Rick Paulison
Sent: Monday, November 17, 2008 7:04 AM
To: Craig Hill
Cc: 'Bruce Brown'
Subject: Sidewalk pavers

Craig I could of sworn that the sidewalk paver color was answered. I cannot find it. Can you verify so Shaw's can do the work.

No virus found in this outgoing message.
Checked by AVG.

Version: 7.5.549 / Virus Database: 270.9.4/1793 - Release Date: 11/16/2008 7:58 PM





Internal Virus Database is out of date.
Checked by AVG - <http://www.avg.com>

Version: 8.0.175 / Virus Database: 270.9.2/1783 - Release Date: 11/12/2008 10:01 AM


No virus found in this incoming message.
Checked by AVG.

Version: 7.5.549 / Virus Database: 270.9.4/1794 - Release Date: 11/17/2008 8:48 AM

NOTE:
ALL SIGN AND WALL ASSOCIATED CONSTRUCTION SHALL BE INCLUDED IN CONTRACT UNLESS OTHERWISE NOTED.

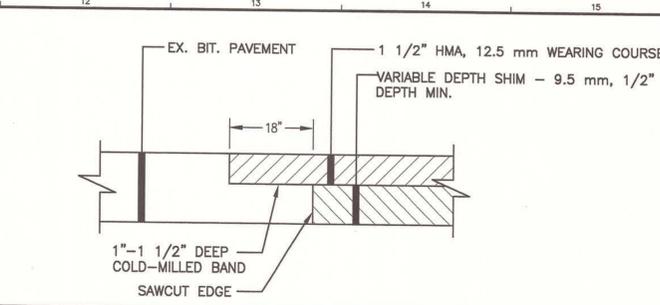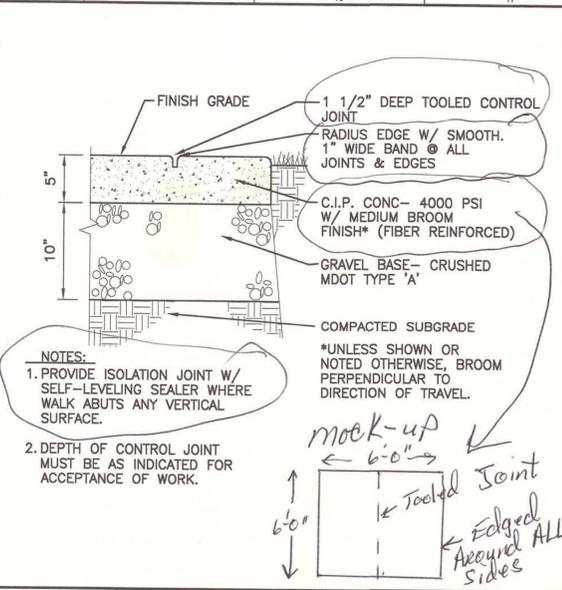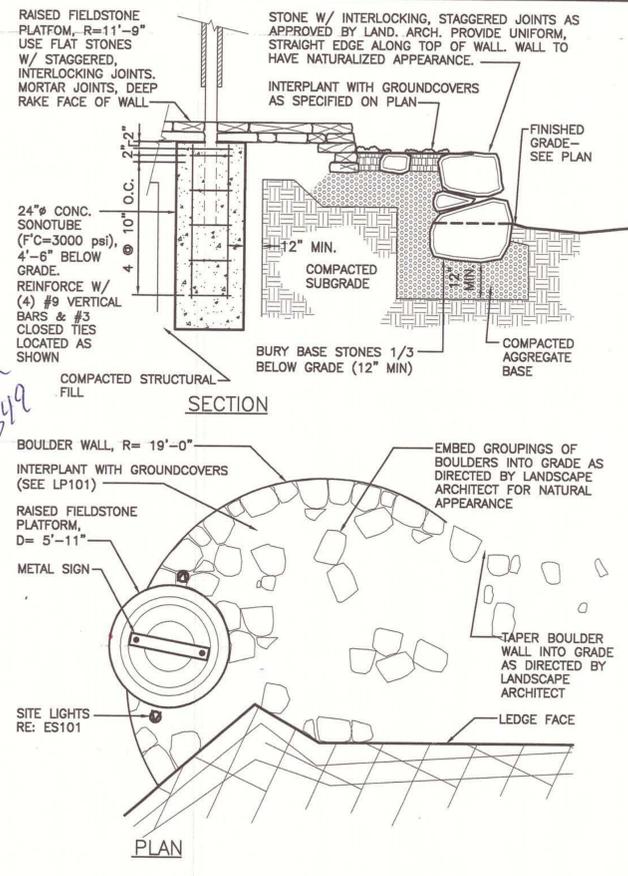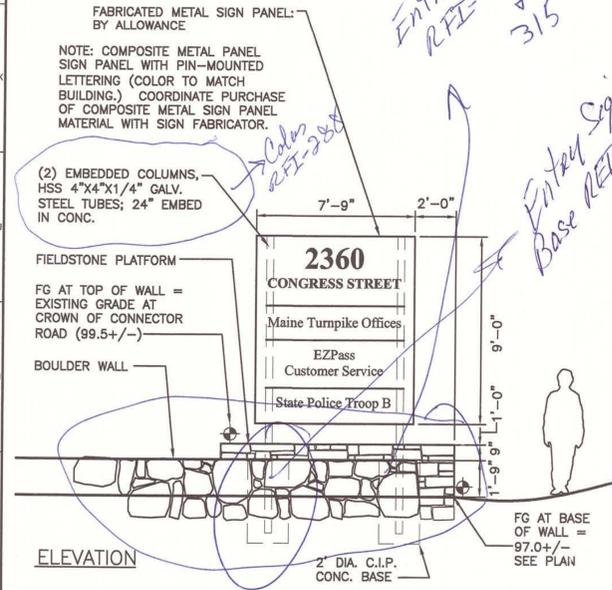


K12 BIT. PAVEMENT MATCHING DETAIL
NTS CP101

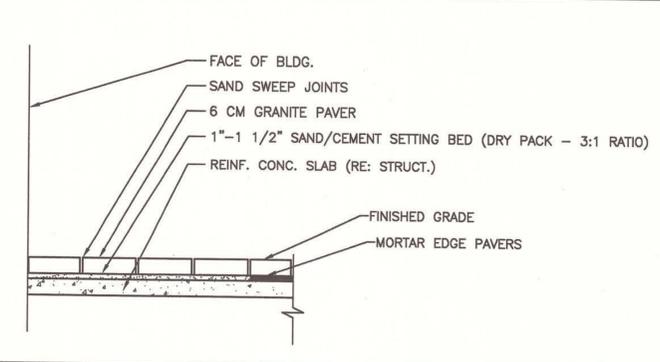


H12 PAVERS AT ENTRY CANOPY
NTS A1/C504


F1 ENTRY SIGN AND WALL
NTS CP101

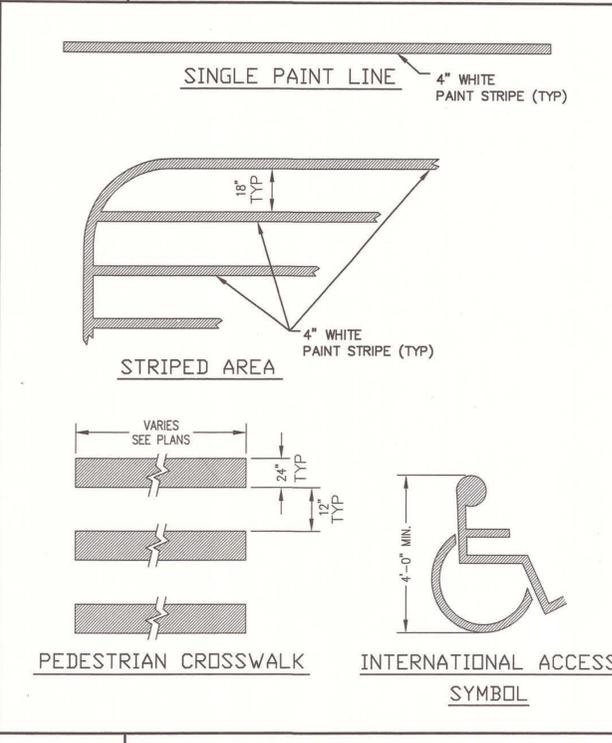

A1 PAINTED STRIPING DETAIL
NTS CP101

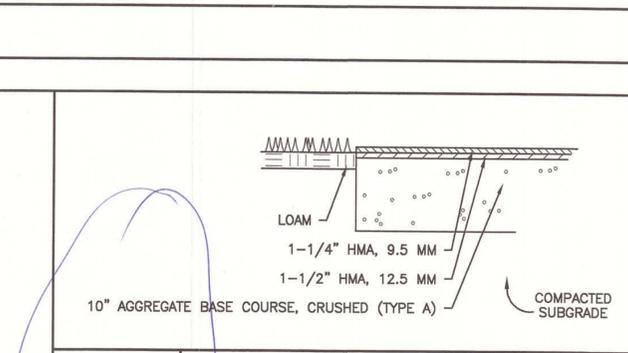


E8 GRANITE CURB DETAIL
NTS CP101

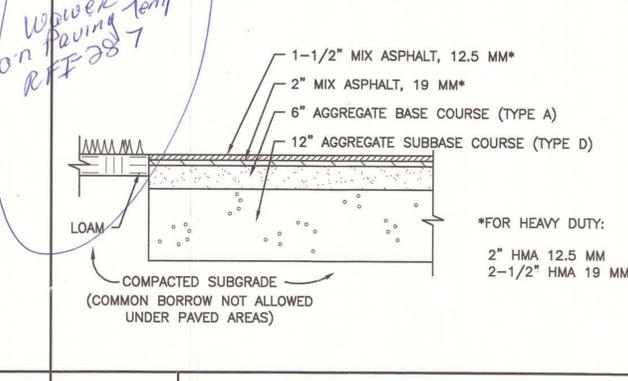


D5 BITUMINOUS WALK DETAIL
NTS CP101


H8 C.I.P. CONCRETE WALK DETAIL
NTS CP201

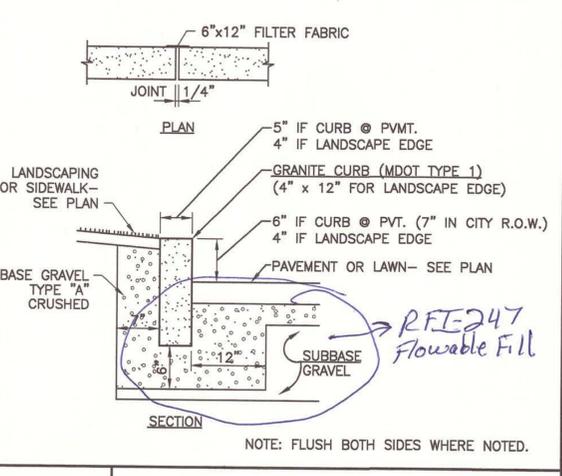


E8 GRANITE CURB DETAIL
NTS CP101

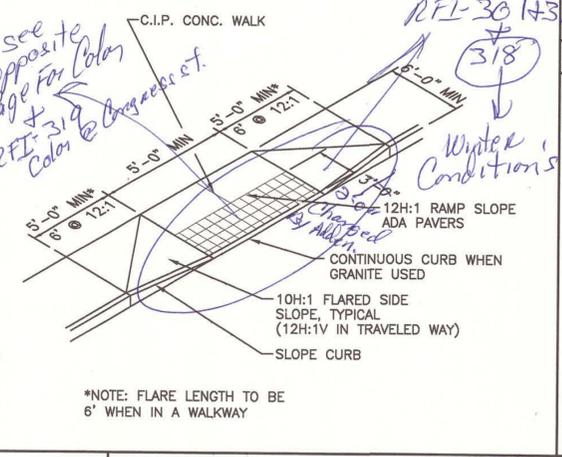

A8 CURB RAMP DETAIL
NTS CP101

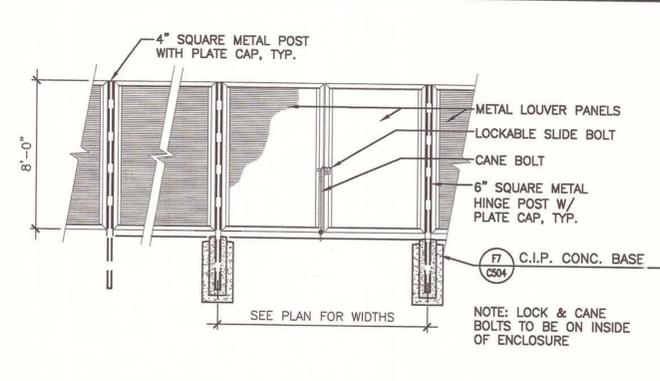

D12 METAL SCREEN FENCE AND GATE DETAIL
NTS CP202

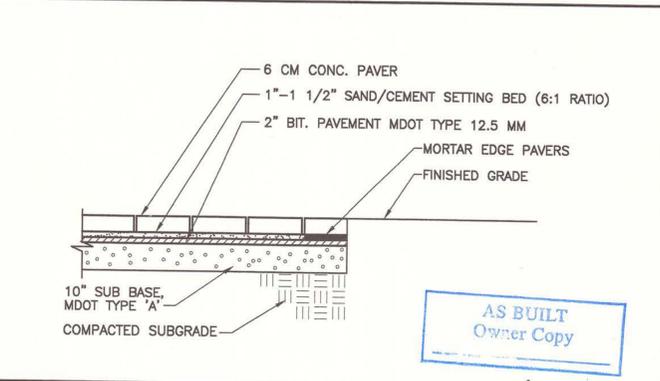


A12 CONCRETE PAVER DETAIL
NTS CP201

SM RT
ARCHITECTURE ENGINEERING PLANNING
144 Fore Street P.O. Box 618
Portland, Maine 04104
tel. (207) 772-3846
fax. (207) 772-1070


MARK G. JOHNSON
REGISTERED PROFESSIONAL ARCHITECT
LICENSE NO. 10001
STATE OF MAINE

PROJECT TITLE:
**MAINE TURNPIKE AUTHORITY
ADMINISTRATION BUILDING**
PORTLAND, MAINE
ISSUED FOR BIDDING/CONSTRUCTION
7-9-07


GRAPHIC SCALE:
0" = 1"
SCALE: SHOWN
PROJECT MANAGER: SLB
JC/DRAWN BY: TCM/PAF
A/E OF RECORD: MGJ
CAD FILE: 06016-C501
PROJECT NO: 06016
DATE: 7-9-07
SHEET TITLE:
SITE DETAILS
SHEET No. **C501**

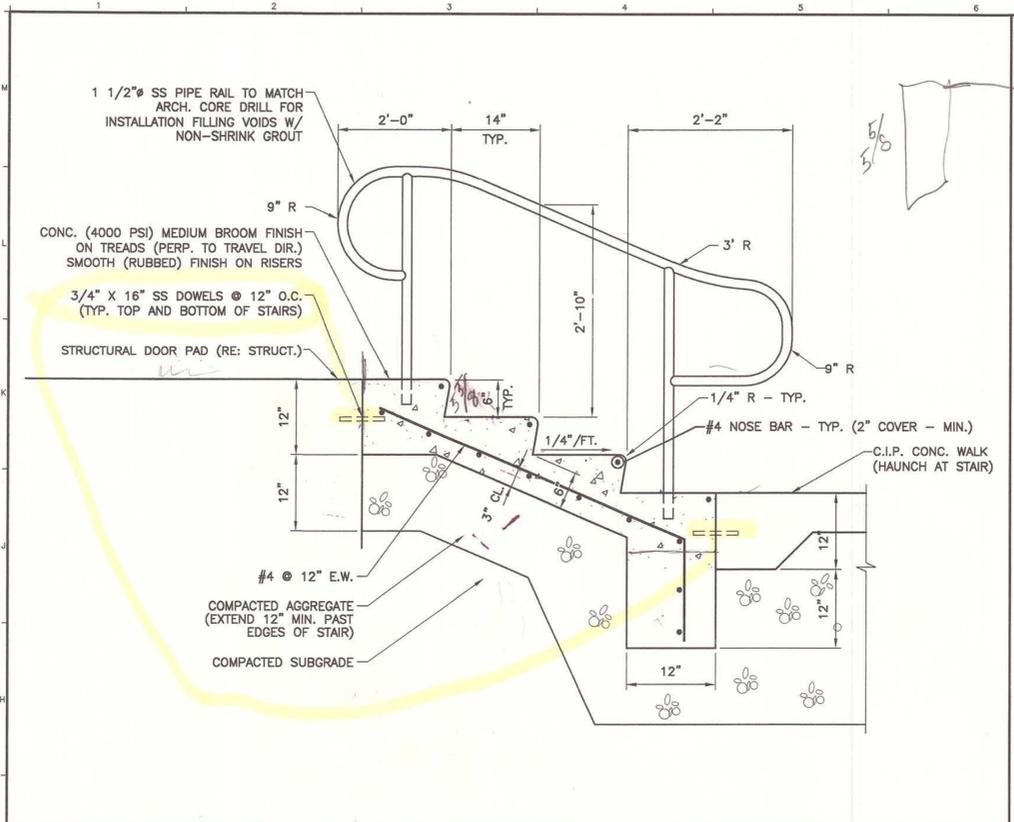


G1 CONCRETE STAIRS
NTS CP201

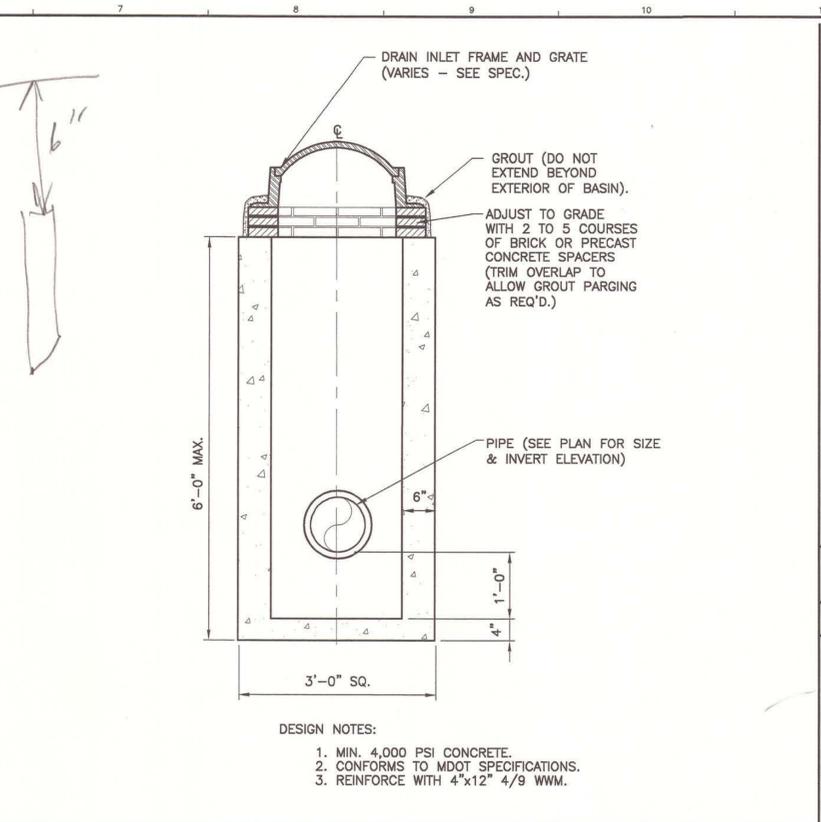


G7 DRAIN INLET DETAIL
NTS *

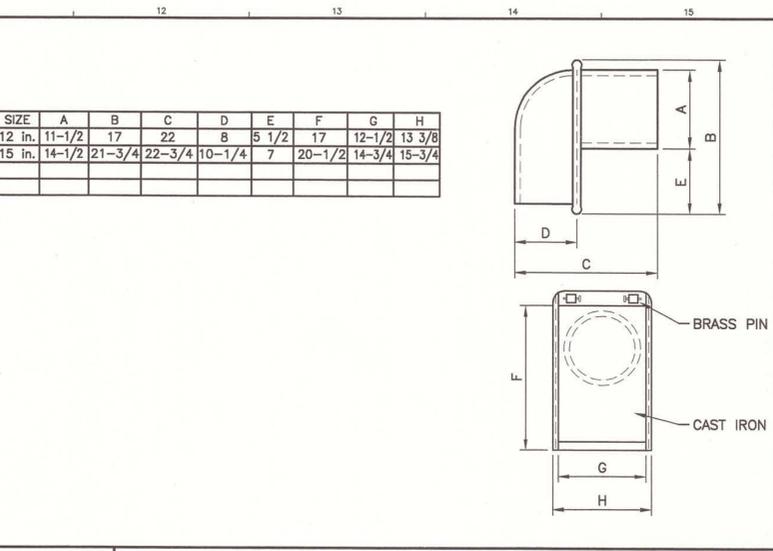


J11 CASCO TRAP
NTS *

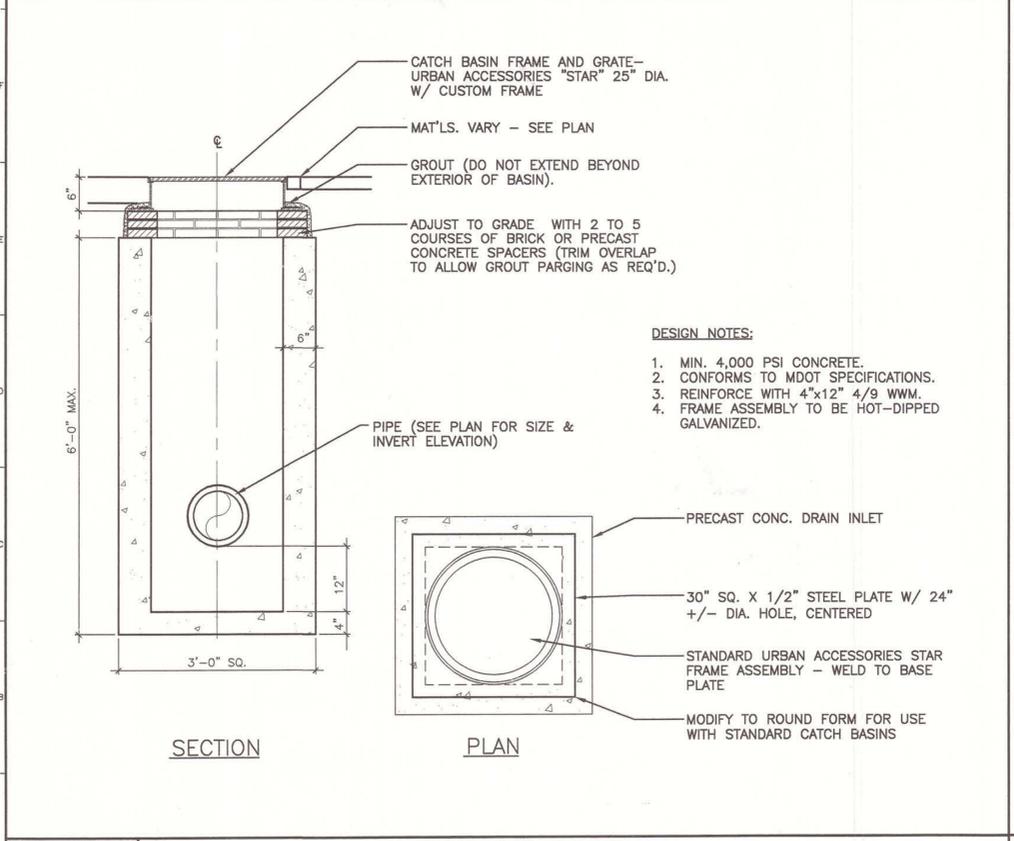

G7 CATCH BASIN DETAIL
NTS *

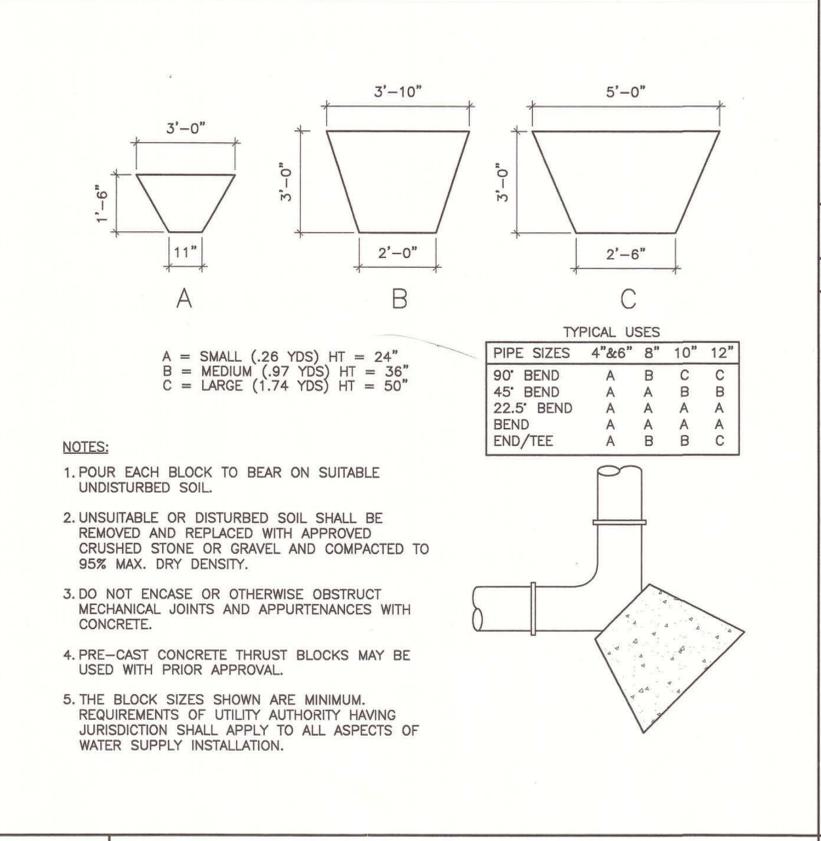

A1 THRUST BLOCKS DETAIL
NTS *

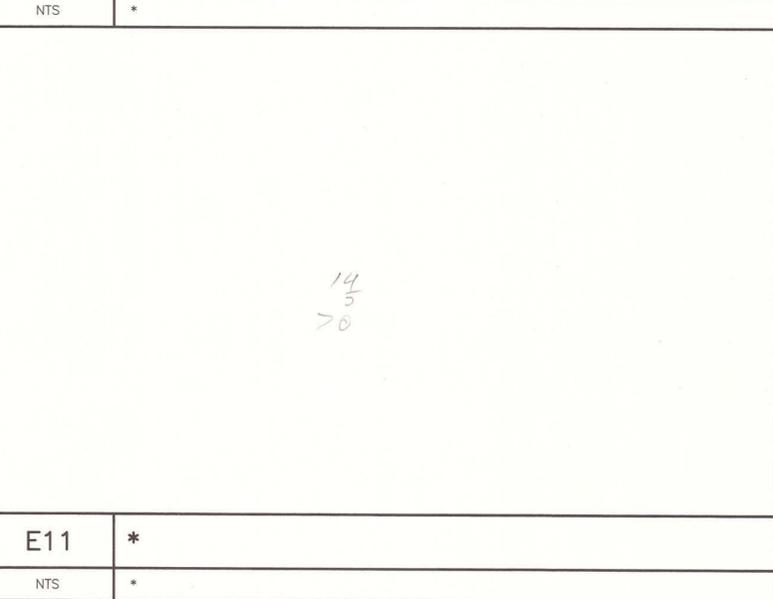

A11 CATCH BASIN DETAIL
NTS *



ARCHITECTURE ENGINEERING PLANNING
SMRT
144 Fore Street P.O. Box 618
Portland, Maine 04104
tel. (207) 772-3846
fax. (207) 772-1070






AS BUILT
Owner Copy

MAINE TURNPIKE AUTHORITY
ADMINISTRATION BUILDING
PORTLAND, MAINE
ISSUED FOR BIDDING/CONSTRUCTION
7-9-07

REV	DESCRIPTION	DATE
0	BIDDING/CONSTRUCTION	7-9-07

GRAPHIC SCALE:
0" 1"



SCALE: SHOWN
PROJECT NUMBER: SLB
JC/DRAWN BY: TCM/PAF
A/E OF RECORD: MGJ
CAD FILE: 06016-C503
PROJECT NO: 06016
DATE: 7-9-07
SHEET TITLE:
SITE DETAILS
SHEET No. **C503**

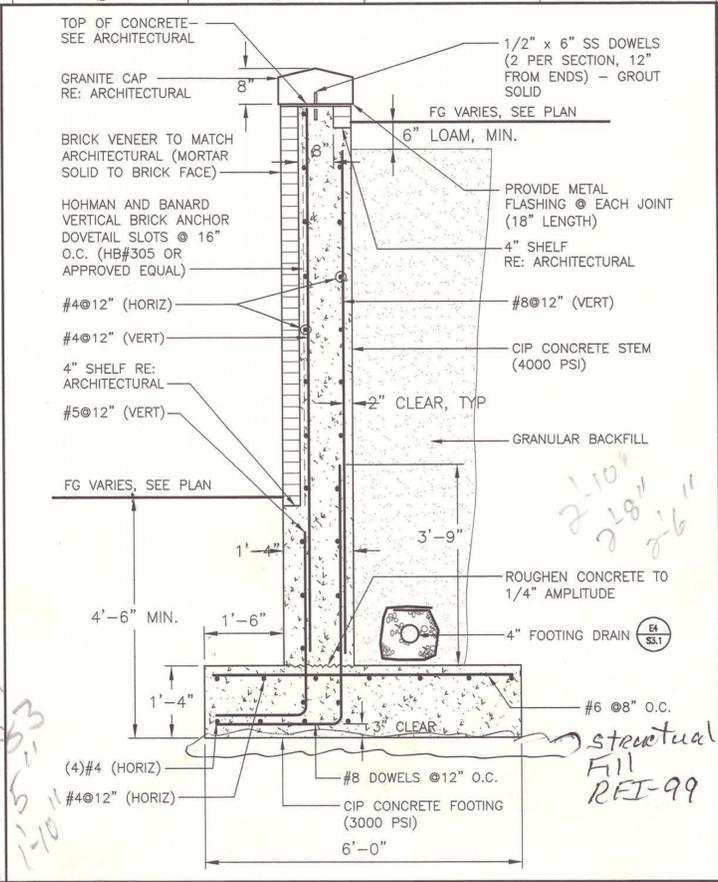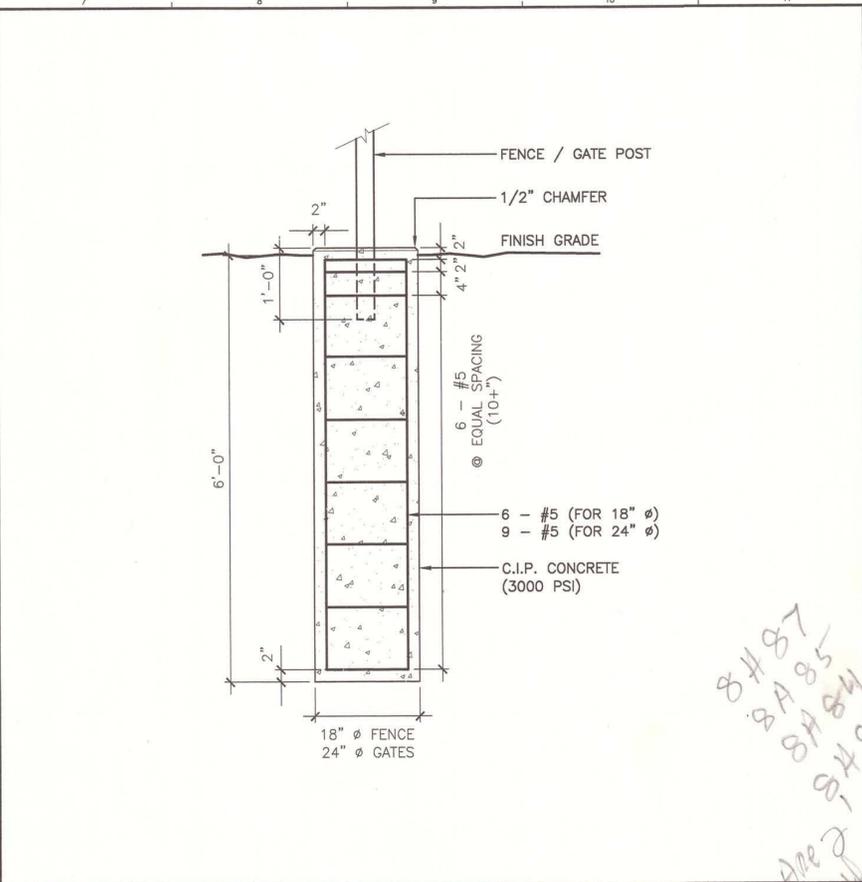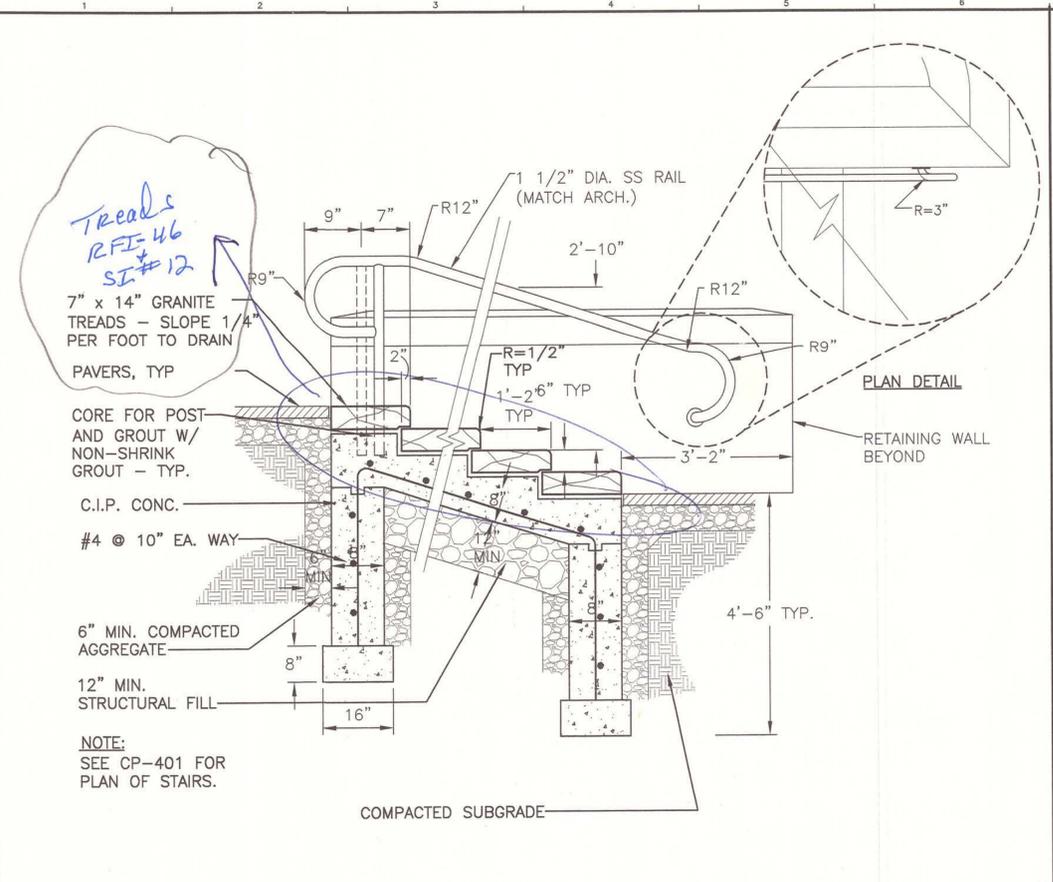

G1 GRANITE STEP AND RAIL DETAIL

F7 METAL SCREEN FENCE & GATE BASE DETAIL

F12 RETAINING WALL (OVER 4' HEIGHT)

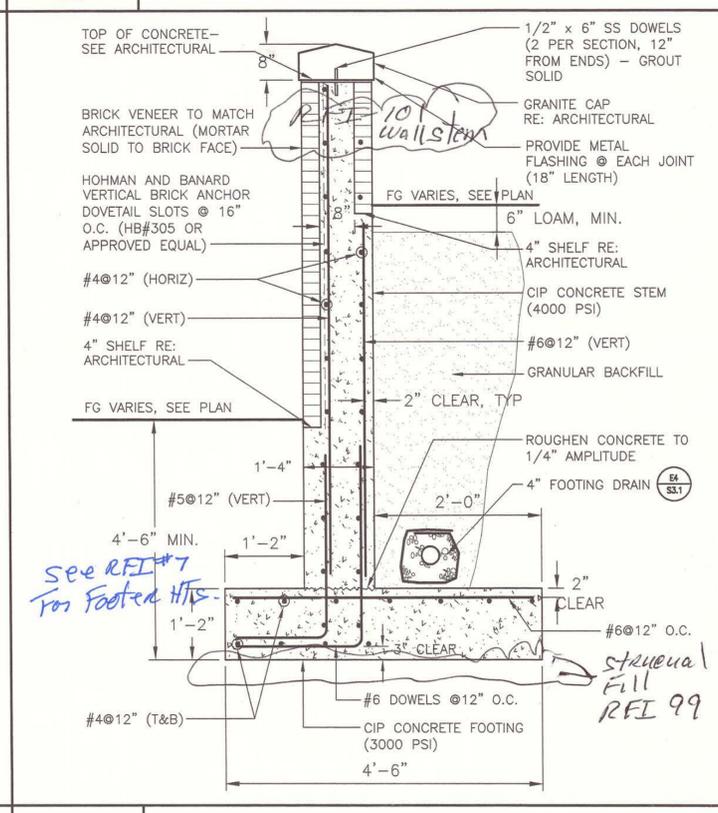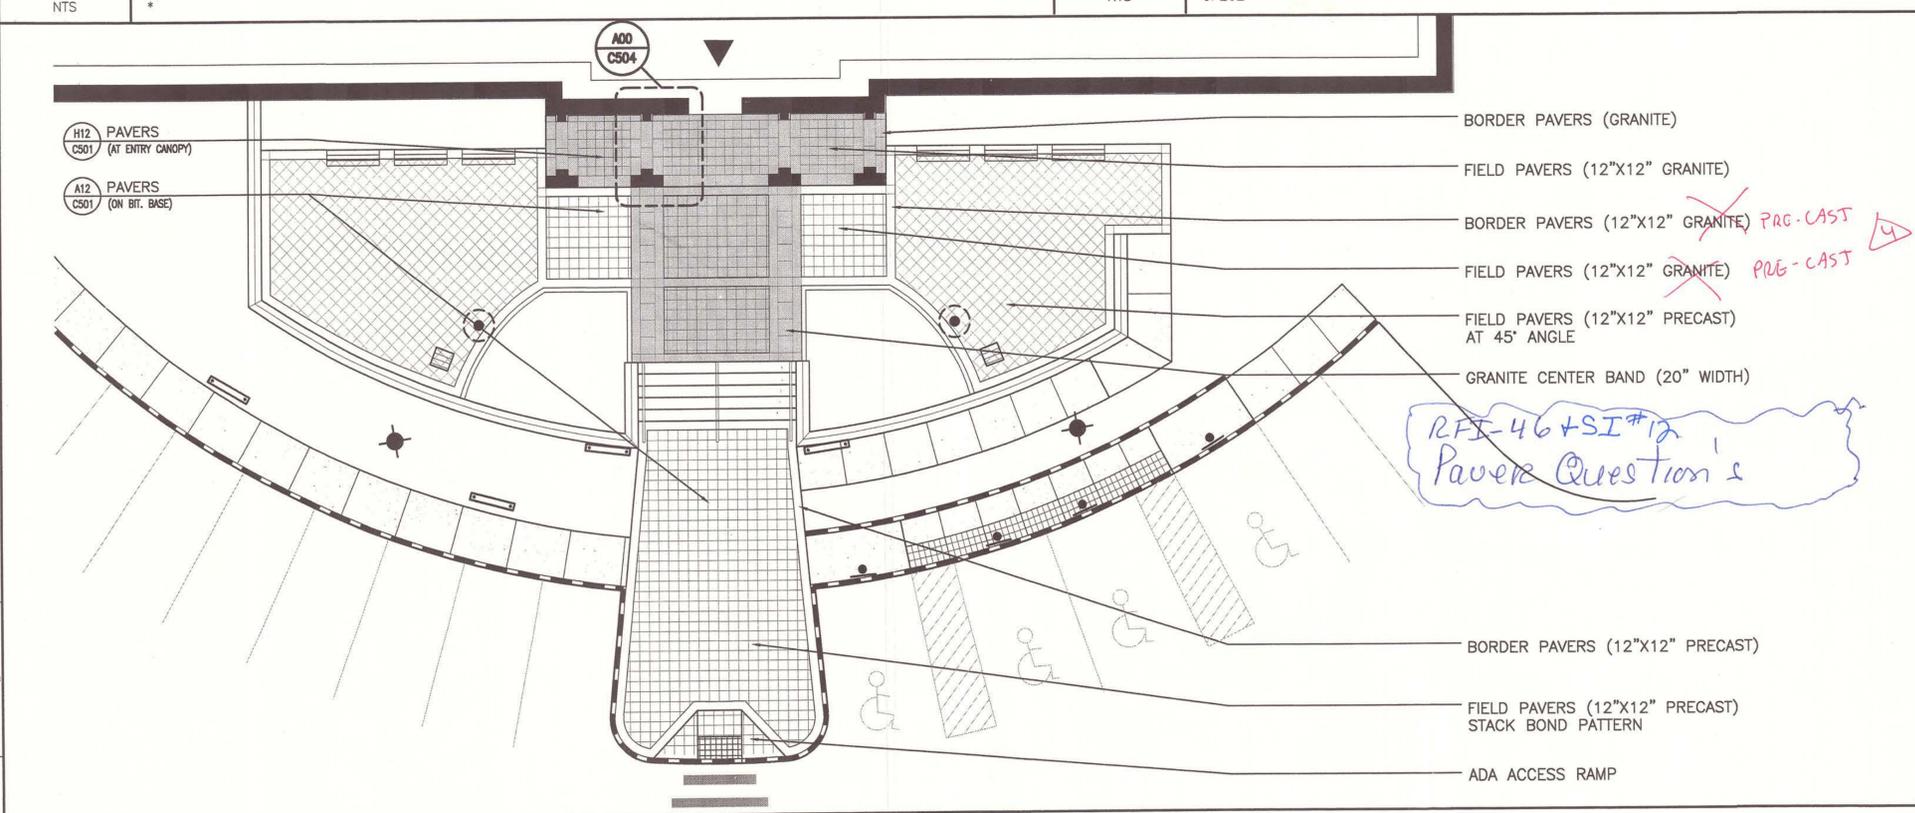

A1 PAVING DETAIL AT FRONT ENTRY

F7 METAL SCREEN FENCE & GATE BASE DETAIL

A12 RETAINING WALL (UNDER 4' HEIGHT)

SM RT

ARCHITECTURE ENGINEERING PLANNING

144 Fore Street, P. O. Box 618
Portland, Maine 04104
tel. (207) 772-3846
fax. (207) 772-1070

MARK G. JOHNSON
REGISTERED ARCHITECT
NO. 857

AS BUILT
Owner Copy

MAINE TURNPIKE AUTHORITY
ADMINISTRATION BUILDING
PORTLAND, MAINE

ISSUED FOR BIDDING/CONSTRUCTION
7-9-07

REV	DESCRIPTION	DATE
0	BIDDING/CONSTRUCTION	7-9-07

GRAPHIC SCALE: 0" = 1"

SCALE: SHOWN

PROJECT MANAGER: SLB

JC/DRAWN BY: TCM/PAF

A/E OF RECORD: MGJ



CAD FILE: 06016-C504

PROJECT NO: 06016

DATE: 7-9-07

SHEET TITLE: SITE DETAILS

SHEET No. **C504**

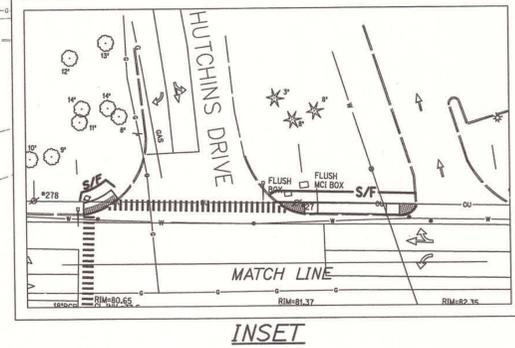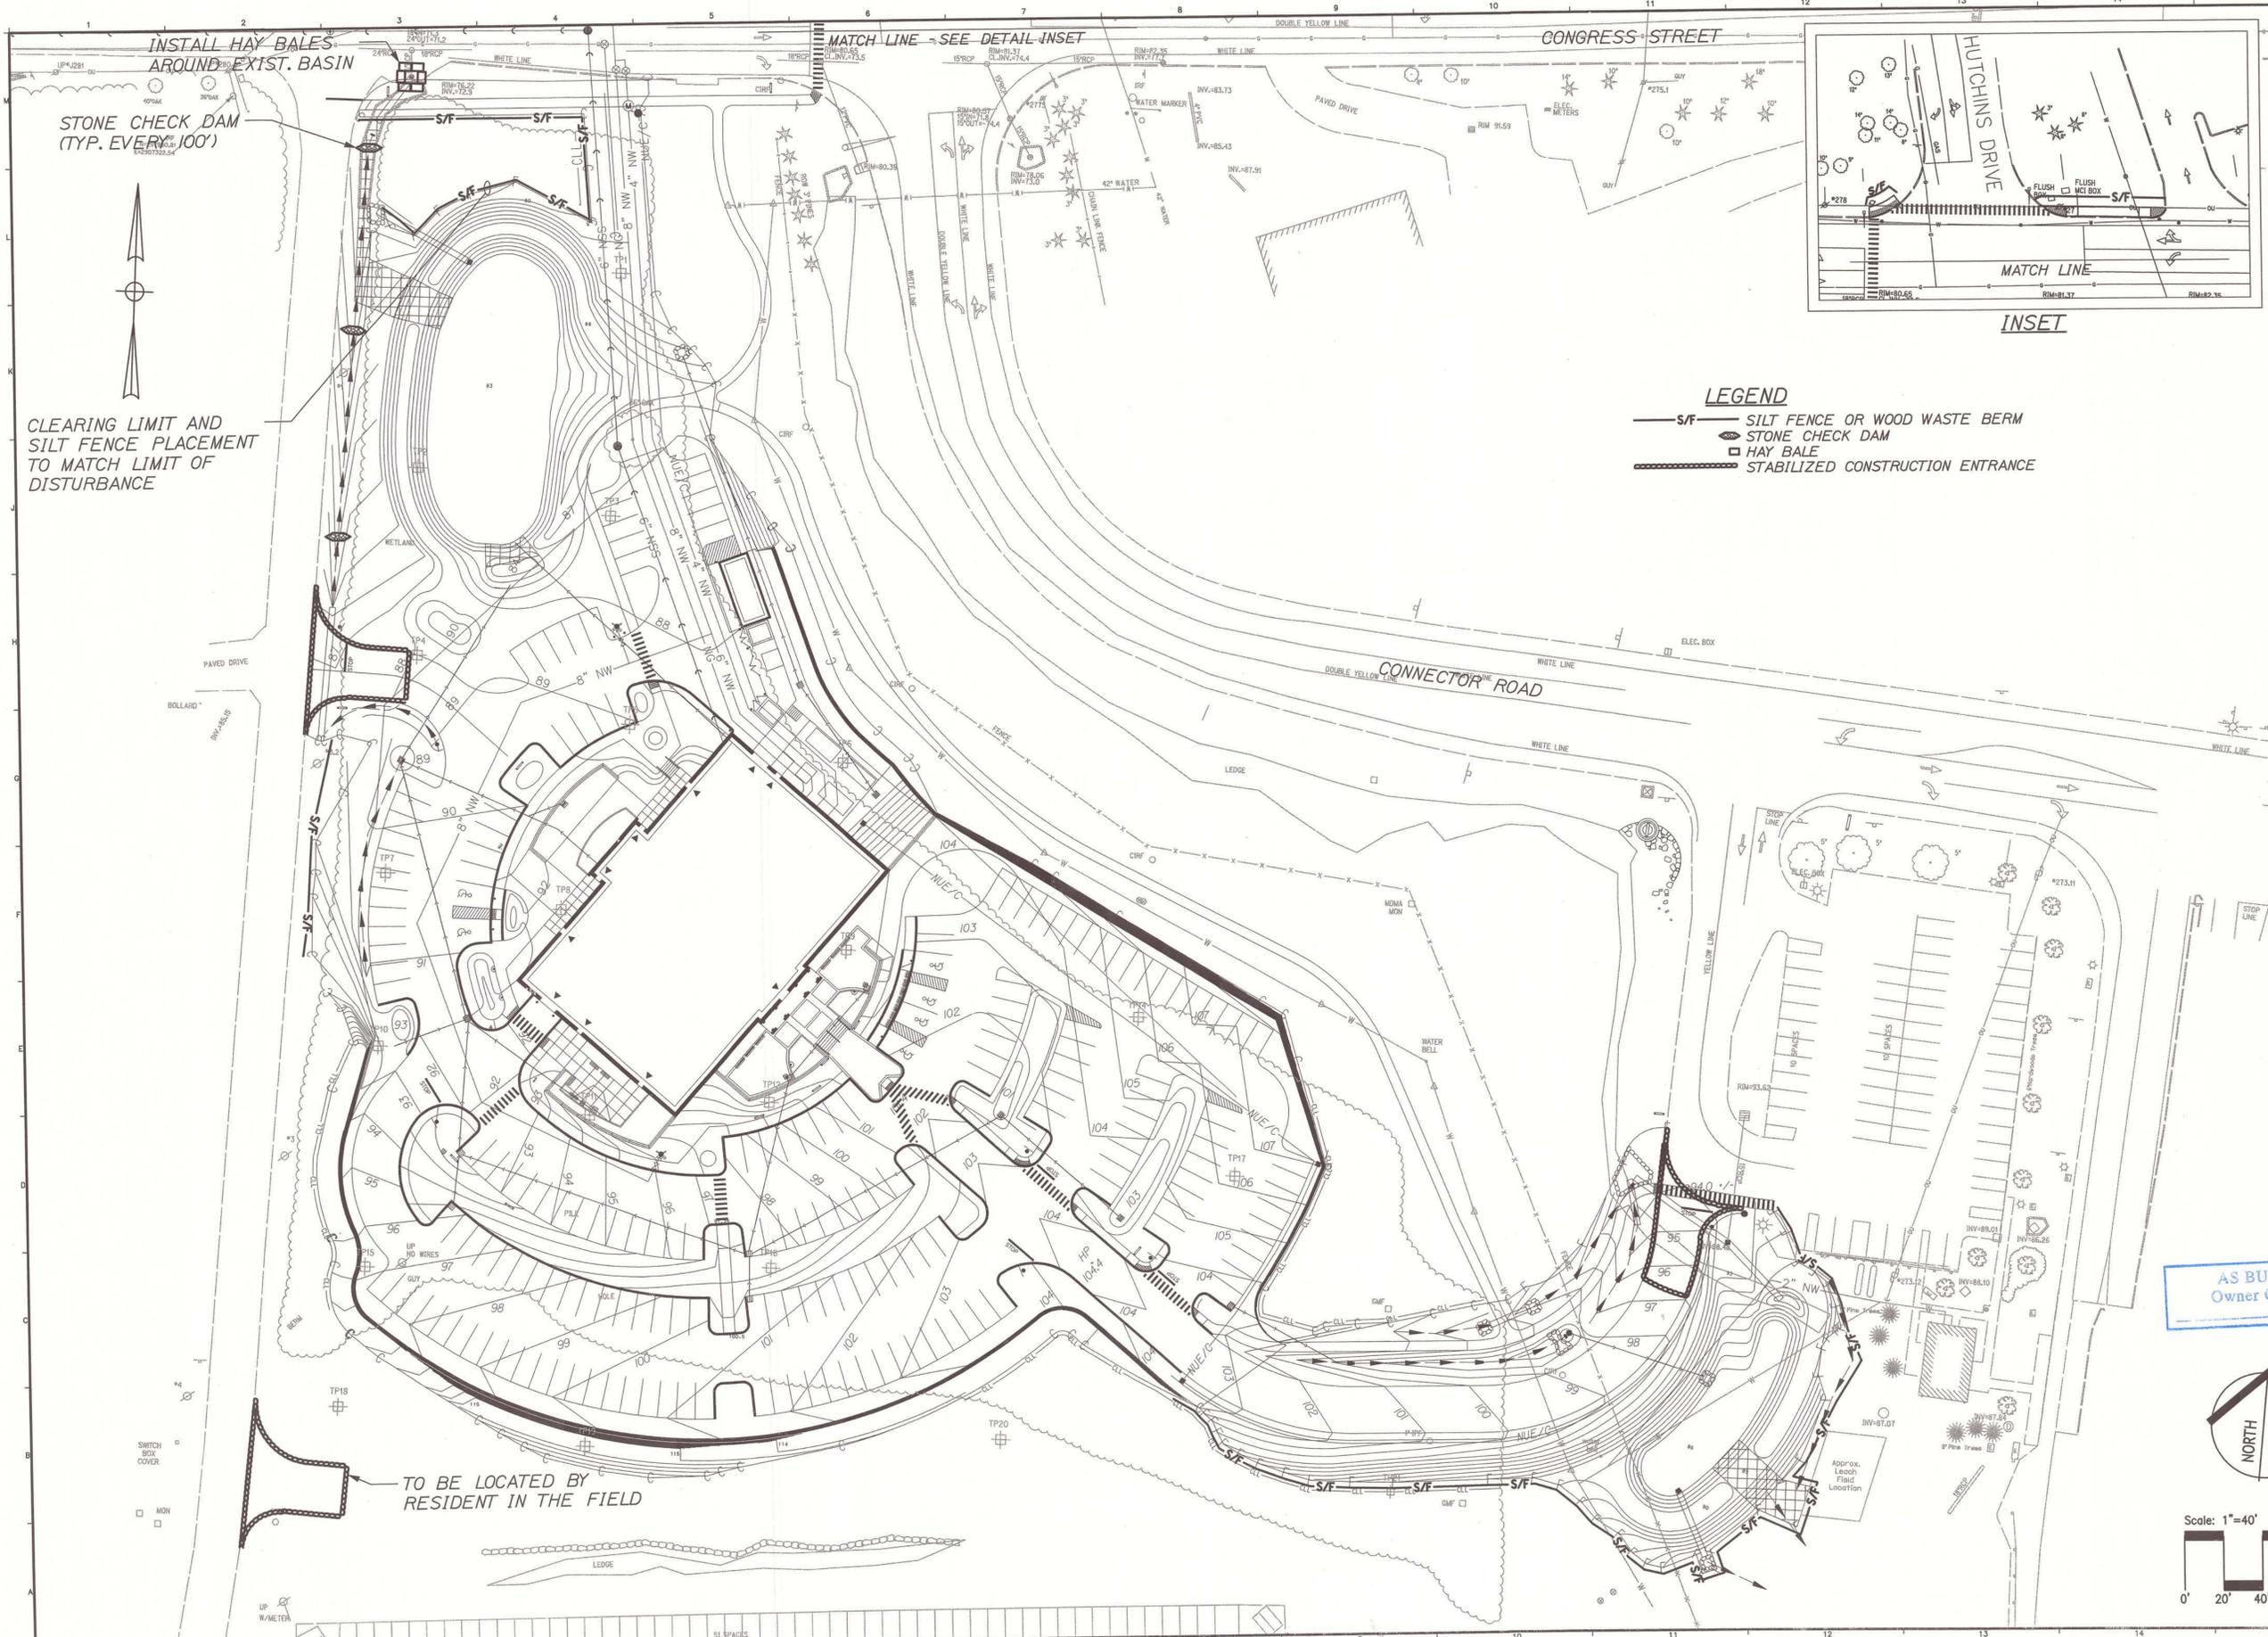

- LEGEND**
- S/F — SILT FENCE OR WOOD WASTE BERM
 - ⊕ STONE CHECK DAM
 - HAY BALE
 - ▬ STABILIZED CONSTRUCTION ENTRANCE

CLEARING LIMIT AND SILT FENCE PLACEMENT TO MATCH LIMIT OF DISTURBANCE

INSTALL HAY BALES AROUND EXIST. BASIN

STONE CHECK DAM (TYP. EVERY 100')

MATCH LINE - SEE DETAIL INSET


CONGRESS STREET

MATCH LINE

INSET

CONNECTOR ROAD

AS BUILT
Owner Copy

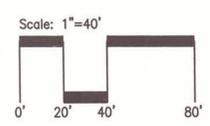


PREPARED BY:
HNTB

HNTB CORP.
2 THOMAS DRIVE
WESTBROOK, ME
04092

**SM
RT**

ARCHITECTURE ENGINEERING PLANNING
SMRT
144 Fore Street/P.O. Box 618
Portland, Maine 04104
tel. (207) 772-3846
fax. (207) 772-1070

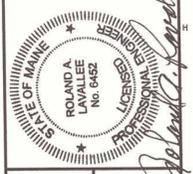

PROJECT TITLE:
MAINE TURNPIKE AUTHORITY
ADMINISTRATION BUILDING
PORTLAND, MAINE

ISSUED FOR BIDDING/CONSTRUCTION
7-9-07

REV	DESCRIPTION	DATE
4	DOCS FOR OWNER REVIEW	6-11-07
3	ISSUED FOR CITY REVIEW	5-03-07
2	100% OWNER REVIEW	3-23-07
1	ISSUED FOR PERMITTING	2-09-07
0	PRE-SUBMITTAL	1-18-07

GRAPHIC SCALE:
0" = 1"
SCALE: AS NOTED
PROJECT MANAGER: GAB
JC/DRAWN BY: MPC
A/E OF RECORD: GAB
CAD FILE: X
PROJECT NO: 2007.07
DATE: 01/07
SHEET TITLE:
EROSION AND
SEDIMENT CONTROL
PLAN
SHEET No. **CS301**

TO BE LOCATED BY
RESIDENT IN THE FIELD

EROSION AND SEDIMENTATION CONTROL NOTES

1. CONTRACTOR SHALL FOLLOW BEST MANAGEMENT PRACTICES OF THE CUMBERLAND COUNTY SOIL CONSERVATION SERVICE AND THE MAINE DOT BEST MANAGEMENT PRACTICES HANDBOOK.

GENERAL EROSION AND SEDIMENTATION CONTROL PRACTICES

1. EROSION/SEDIMENT CONTROL DEVICES, THE FOLLOWING EROSION SEDIMENTATION CONTROL DEVICES ARE PROPOSED FOR CONSTRUCTION ON THIS PROJECT. INSTALL THESE DEVICES AS INDICATED ON THE PLANS.

1.1 SILT FENCE: SILT FENCE WILL BE INSTALLED ALONG THE DOWN GRADIENT EDGES OF DISTURBED AREAS TO TRAP RUNOFF BORN SEDIMENTS UNTIL THE SITE IS STABILIZED. IN AREAS WHERE STORMWATER DISCHARGES, THE SILT FENCE WILL BE REINFORCED WITH HAY BALES TO HELP MAINTAIN THE INTEGRITY OF THE SILT FENCE AND TO PROVIDE ADDITIONAL TREATMENT. UPSTREAM GRADIENT FROM SILT FENCE SHALL NOT EXCEED 200 LINEAR FEET PER LINEAR FOOT OF TEMPORARY FENCE. WOOD WASTE COMPOST/BARK FILTER BERMS MAY BE USED IN LIEU OF SILT FENCE, AS APPROVED BY THE RESIDENT ENGINEER.

1.2 HAY BALES ARE TO BE PLACED IN LOW FLOW DRAINAGE SWALES AND PATHS TO TRAP SEDIMENTS AND REDUCE RUNOFF VELOCITIES. DO NOT PLACE HAY BALES IN FLOWING WATER OR STREAMS. DUMPED STONE CHECK DAMS MAY BE USED IN LIEU OF HAY BALES TO ACHIEVE THE SAME RESULT.

1.3 RIPRAP: PROVIDE RIPRAP IN AREAS WHERE CULVERTS DISCHARGE OR AS SHOWN ON THE PLANS.

1.4 LOAM, SEED, & MULCH: ALL DISTURBED AREAS, WHICH ARE NOT OTHERWISE TREATED, SHALL RECEIVE PERMANENT SEEDING AND MULCH TO STABILIZE THE DISTURBED AREAS. THE DISTURBED AREAS WILL BE REVEGETATED WITHIN 5 DAYS OF FINAL GRADING. SEEDING REQUIREMENTS ARE PROVIDED AT THE END OF THIS SPECIFICATION.

2. TEMPORARY EROSION/SEDIMENTATION CONTROL MEASURES, PROVIDE THE FOLLOWING TEMPORARY EROSION/SEDIMENT CONTROL MEASURES DURING CONSTRUCTION OF THE FACILITY.

2.1 PLACE SILTATION FENCE OR FILTER BERM ALONG THE DOWNGRADIENT SIDE OF THE ROADWAY AND PARKING AREAS AND OF ALL FILL SECTIONS. THE FENCE OR BERM WILL REMAIN IN PLACE UNTIL THE SITE IS 85% REVEGETATED.

2.2 HAY BALES PLACED AT KEY LOCATIONS TO SUPPLEMENT THE SILT FENCE

2.3 PROTECT TEMPORARY STOCKPILES OF STUMPS, GRUBBINGS, OR COMMON EXCAVATION AS FOLLOWS:

- A. SOIL STOCKPILE SIDE SLOPES SHALL NOT EXCEED 2:1.
B. AVOID PLACING TEMPORARY STOCKPILES IN AREAS WITH SLOPES OVER 10 PERCENT, OR NEAR DRAINAGE SWALES. SEE ITEM 3 IN CONSTRUCTION PHASE NOTES BELOW.
C. STABILIZE STOCKPILES WITHIN 15 DAYS BY TEMPORARILY SEEDING WITH HYDROSEED OR BY COVERING THE STOCKPILE.
D. SURROUND STOCKPILE SOIL WITH SILT FENCE AT BASE OF PILE.

2.4 ALL DENUDED AREAS WHICH HAVE BEEN ROUGH GRADED AND ARE NOT LOCATED WITHIN THE BUILDING PAD, OR PARKING AND DRIVEWAY SUBBASE AREAS SHALL RECEIVE MULCH WITHIN 30 DAYS OF INITIAL DISTURBANCE OF SOIL OR WITHIN 15 DAYS AFTER COMPLETING THE ROUGH GRADING OPERATIONS. IN THE EVENT THE CONTRACTOR COMPLETES FINAL GRADING AND INSTALLATION OF LOAM AND SEED WITHIN THE TIME PERIODS PRESENTED ABOVE, INSTALLATION OF MULCH AND NETTING, WHERE APPLICABLE, IS NOT REQUIRED.

2.5 IF WORK IS CONDUCTED BETWEEN OCTOBER 15 AND APRIL 15, ALL DENUDED AREAS ARE TO BE COVERED WITH HAY MULCH, APPLIED AT TWICE THE NORMAL APPLICATION RATE, AND ANCHORED WITH FABRIC NETTING. THE PERIOD BETWEEN FINAL GRADING AND MULCHING SHALL BE REDUCED TO A 15 DAY MAXIMUM.

2.6 TEMPORARY EROSION CONTROL MEASURES SHALL BE REMOVED ONCE THE SITE HAS BEEN STABILIZED OR IN AREAS WHERE PERMANENT EROSION CONTROL MEASURES HAVE BEEN INSTALLED.

3. PERMANENT EROSION CONTROL MEASURES, THE FOLLOWING PERMANENT CONTROL MEASURES ARE REQUIRED BY THIS EROSION/SEDIMENTATION CONTROL PLAN.

3.1 ALL AREAS DISTURBED DURING CONSTRUCTION BUT NOT SUBJECT TO OTHER RESTORATION (PAVING, RIPRAP, ETC.) WILL BE LOAMED, LIMED, FERTILIZED AND SEED. NATIVE TOPSOIL SHALL BE STOCKPILED AND REUSED FOR FINAL RESTORATION WHEN IT IS OF SUFFICIENT QUALITY.

3.2 NON-LEDGE SLOPES GREATER THAN 2:1 WILL RECEIVE RIPRAP.

CONSTRUCTION PHASE

THE FOLLOWING GENERAL PRACTICES WILL BE USED TO PREVENT EROSION DURING CONSTRUCTION OF THIS PROJECT.

1. ONLY THOSE AREAS UNDER ACTIVE CONSTRUCTION WILL BE CLEARED AND LEFT IN AN UNTREATED OR UNVEGETATED CONDITION. IF FINAL GRADING, LOAMING AND SEEDING WILL NOT OCCUR WITHIN 15 DAYS, SEE ITEM NO. 4.

2. PRIOR TO THE START OF CONSTRUCTION IN A SPECIFIC AREA, SILT FENCING, FILTER BERMS AND/OR HAY BALES WILL BE INSTALLED AT THE TOE OF SLOPE AND IN AREAS AS LOCATED ON THE PLANS TO PROTECT AGAINST ANY CONSTRUCTION RELATED EROSION. IMMEDIATELY FOLLOWING CONSTRUCTION OF CULVERTS AND SWALES, RIP RAP APRONS SHALL BE INSTALLED, AS SHOWN ON THE PLANS.

3. TOPSOIL WILL BE STOCKPILED WHEN NECESSARY IN AREAS WHICH HAVE MINIMUM POTENTIAL FOR EROSION AND WILL BE KEPT AS FAR AS POSSIBLE FROM THE EXISTING DRAINAGE COURSE. NO STOCKPILE SHALL BE CLOSER THAN 100' OF A RESOURCE INCLUDING, BUT NOT LIMITED TO, WETLANDS, STREAMS AND OPEN WATER BODIES. ALL STOCKPILES SHALL HAVE A SILT FENCE BELOW THEM REGARDLESS OF TIME OF PRESENCE. ALL STOCKPILES EXPECTED TO REMAIN LONGER THAN 15 DAYS SHALL BE:

- A. TREATED WITH ANCHORED MULCH WITHIN 5 DAYS OF THE LAST DEPOSIT OF STOCKPILED SOIL.
B. SEEDDED WITH CONSERVATION MIX AND MULCH IMMEDIATELY.
C. INSTALL SILT FENCE AROUND STOCKPILE AT BASE OF PILE.

4. ALL DISTURBED AREAS EXPECTED TO REMAIN LONGER THAN 30 DAYS SHALL BE EITHER:
A. TREATED WITH ANCHORED MULCH IMMEDIATELY, OR
B. SEEDDED WITH CONSERVATION MIX OF ANNUAL RYE GRASS (0.9 LBS/1000 SQ. FT) AND MULCHED IMMEDIATELY.

5. ALL NON-LEDGE GRADING WILL BE HELD TO A MAXIMUM 2:1 SLOPE WHERE PRACTICAL. ALL SLOPES WILL BE STABILIZED WITH PERMANENT SEEDING, OR WITH STONE, WITHIN 5 DAYS AFTER FINAL GRADING IS COMPLETE. (SEE POST-CONSTRUCTION REVEGETATION FOR SEEDING SPECIFICATION.)

6. ALL CULVERTS WILL BE PROTECTED WITH STONE RIPRAP (D50-6" UNLESS OTHERWISE SPECIFIED) AT INLETS AND OUTLETS.

POST-CONSTRUCTION REVEGETATION

THE FOLLOWING GENERAL PRACTICES WILL BE USED TO PREVENT EROSION AS SOON AS AN AREA IS READY TO UNDERGO FINAL GRADING:

1. A MINIMUM OF 4" OF LOAM WILL BE SPREAD OVER DISTURBED AREAS AND GRADED TO A UNIFORM DEPTH AND NATURAL APPEARANCE, OR STONE WILL BE PLACED ON SLOPES TO STABILIZE SURFACES.

2. IF FINAL GRADING IS REACHED DURING THE NORMAL GROWING SEASON (4/15 TO 9/15), PERMANENT SEEDING WILL BE DONE AS SPECIFIED BELOW. PRIOR TO SEEDING, LIMESTONE SHALL BE APPLIED AT A RATE OF 138 LBS/100 SQ. FT. AND 10:20:20 FERTILIZER AT A RATE OF 18.4 LBS/100 SQ. FT. WILL BE APPLIED. BROADCAST SEEDING AT THE FOLLOWING RATES.

LAWNS: KENTUCKY BLUE GRASS 0.46 LBS/1000 SF RED TOP 0.05 LBS/1000 SF
CREEPING RED FESCUE 0.46 LBS/1000 SF TALL FESCUE 0.46 LBS/1000 SF
PERENNIAL RYE GRASS 0.11 LB/1000 SF.

3. AN AREA SHALL BE MULCHED IMMEDIATELY AFTER IT HAS BEEN SEEDED. MULCHING SHALL CONSIST OF HAY MULCH, HYDRO-MULCH, JUTE NET OVER MULCH, PRE-MANUFACTURED EROSION MATS OR ANY SUITABLE SUBSTITUTE DEEMED ACCEPTABLE BY THE RESIDENT ENGINEER.

A. HAY MULCH SHALL BE APPLIED AT THE RATE OF 2 TONS PER ACRE. HAY MULCH SHALL BE SECURED BY EITHER:
I. BEING DRIVEN OVER BY TRACKED CONSTRUCTION EQUIPMENT ON GRADES OF 5% AND LESS.
II. BLANKETED BY TACKED PHOTODEGRADABLE/BIODEGRADABLE NETTING OR WITH SPRAY-ON.

III. SEE NOTE 6, GENERAL NOTES, AND NOTE 8, WINTER CONSTRUCTION.
B. HYDRO-MULCH SHALL CONSIST OF A MIXTURE OR EITHER ASPHALT, WOOD FIBER OR PAPER FIBER AND WATER SPRAYED OVER A SEEDED AREA. HYDRO-MULCH SHALL NOT BE USED BETWEEN 9/15 AND 4/15.

4. CONSTRUCTION SHALL BE PLANNED TO ELIMINATE THE NEED FOR SEEDING BETWEEN SEPTEMBER 15 AND APRIL 15. SHOULD SEEDING BE NECESSARY BETWEEN SEPTEMBER 15 AND APRIL 15 THE FOLLOWING PROCEDURE SHALL BE FOLLOWED. ALSO REFER TO NOTE 9 OF WINTER CONSTRUCTION.

- A. ONLY UNFROZEN LOAM SHALL BE USED.
B. LOAMING, SEEDING AND MULCHING WILL NOT BE DONE OVER SNOW OR ICE COVER. IF SNOW EXISTS, IT MUST BE REMOVED PRIOR TO PLACEMENT OF SEED.
C. WHERE PERMANENT SEEDING IS NECESSARY, ANNUAL WINTER RYE (1.2 LBS/1000 SQ. FT.) SHALL BE ADDED TO THE PREVIOUSLY NOTED AREAS.
D. WHERE TEMPORARY SEEDING IS REQUIRED, ANNUAL WINTER RYE (2.6 LBS/1000 SQ. FT) SHALL BE SOWN INSTEAD OF THE PREVIOUSLY NOTED SEEDING RATE.
E. FERTILIZING, SEEDING AND MULCHING SHALL BE APPLIED TO LOAM THE DAY THE LOAM IS SPREAD BY MACHINERY.
F. ALTERNATIVE HAY MULCH SHALL BE SECURED WITH PHOTODEGRADABLE/BIODEGRADABLE NETTING. TRACKING BY MACHINERY ALONE WILL NOT SUFFICE.

5. FOLLOWING FINAL SEEDING, THE SITE WILL BE INSPECTED EVERY 30 DAYS UNTIL 85% COVER HAS BEEN ESTABLISHED. RESEEDING WILL BE CARRIED OUT BY THE CONTRACTOR WITHIN 10 DAYS OF NOTIFICATION BY THE ENGINEER THAT THE EXISTING CATCH IS INADEQUATE.

MONITORING SCHEDULE

THE CONTRACTOR IS RESPONSIBLE FOR INSTALLING, MONITORING, MAINTAINING, REPAIRING, REPLACING AND REMOVING ALL OF THE EROSION AND SEDIMENTATION CONTROLS OR APPOINTING A QUALIFIED SUBCONTRACTOR TO DO SO. MAINTENANCE MEASURES WILL BE APPLIED AS NEEDED DURING THE ENTIRE CONSTRUCTION CYCLE. AFTER EACH RAINFALL, A VISUAL INSPECTION WILL BE MADE OF ALL EROSION AND SEDIMENTATION CONTROLS AS FOLLOWS.

1. HAY BALE BARRIERS, SILT FENCE, FILTER BERMS AND STONE CHECK DAMS SHALL BE INSPECTED AND REPAIRED ONCE A WEEK OR IMMEDIATELY FOLLOWING ANY SIGNIFICANT RAINFALL. SEDIMENT TRAPPED BEHIND THESE BARRIERS SHALL BE EXCAVATED WHEN IT REACHES A DEPTH OF 6" AND REDISTRIBUTED TO AREAS UNDERGOING FINAL GRADING. SHOULD THE HAY BALE BARRIERS PROVE TO BE INEFFECTIVE, THE CONTRACTOR SHALL INSTALL SILT FENCE BEHIND THE HAY BALES.

2. VISUALLY INSPECT RIPRAP ONCE A WEEK OR AFTER EACH SIGNIFICANT RAINFALL AND REPAIR AS NEEDED. REMOVE SEDIMENT TRAPPED BEHIND THESE DEVICES ONCE IT ATTAINS A DEPTH EQUAL TO 1/2 THE HEIGHT OF THE DAM OR RISER. DISTRIBUTE REMOVED SEDIMENT OFF-SITE OR TO AN AREA UNDERGOING FINAL GRADING.

3. REVEGETATION OF DISTURBED AREAS WITHIN 25 FT. OF DRAINAGE COURSE/STREAM WILL BE SEEDDED WITH "MEADOW AREA MIX" AND INSPECTED ON A WEEKLY BASIS OR AFTER EACH SIGNIFICANT RAINFALL AND RESEEDDED AS NEEDED. EXPOSED AREAS WILL BE RESEEDDED AS NEEDED UNTIL THE AREA HAS OBTAINED 100% GROWTH RATE. PROVIDE PERMANENT RIPRAP FOR SLOPES IN EXCESS OF 3:1 AND WITHIN 25' OF DRAINAGE COURSE.

WINTER MEASURES

1. WINTER CONSTRUCTION PERIOD: NOVEMBER 1 THROUGH APRIL 15.

2. WINTER EXCAVATION AND EARTHWORK SHALL BE COMPLETED SUCH THAT NO MORE THAN 1 ACRE OF THE SITE IS WITHOUT STABILIZATION AT ANY ONE TIME.

3. EXPOSED AREA SHALL BE LIMITED TO THOSE AREAS TO BE MULCHED IN ONE DAY PRIOR TO ANY SNOW EVENT. AT THE END OF EACH WORK WEEK NO AREAS MAY BE LEFT UNSTABILIZED OVER THE WEEKEND.

4. CONTINUATION OF EARTHWORK OPERATIONS ON ADDITIONAL AREAS SHALL NOT BEGIN UNTIL THE EXPOSED SOIL SURFACE ON THE AREA BEING WORKED HAS BEEN STABILIZED, SUCH THAT NO LARGER AREA OF THE SITE IS WITHOUT EROSION CONTROL PROTECTION AS LISTED IN ITEM 2 ABOVE.

5. AN AREA SHALL BE CONSIDERED TO HAVE BEEN STABILIZED WHEN EXPOSED SURFACES HAVE BEEN EITHER MULCHED WITH STRAW OR HAY AT A RATE OF 150 LB. PER 1000 SF WITH OR WITHOUT SEEDING OR DORMANT SEED, MULCHED AND ANCHORED SUCH THAT THE SOIL SURFACE IS NOT VISIBLE THROUGH THE MULCH. NOTE: AN AREA IS ALSO CONSIDERED STABLE IF SODDED, COVERED WITH GRAVEL (ROADWAY AND PARKING LOTS) OR STRUCTURAL SAND.

6. BETWEEN THE DATES OF OCTOBER 15 AND APRIL 1, LOAM OR SEED WILL NOT BE REQUIRED. DURING PERIODS OF ABOVE FREEZING TEMPERATURES THE SLOPES SHALL BE FINE GRADED AND EITHER PROTECTED WITH MULCH OR TEMPORARILY SEEDDED AND MULCHED UNTIL SUCH TIME AS THE FINAL TREATMENT CAN BE APPLIED. IF THE DATE IS AFTER NOVEMBER 1 AND IF THE EXPOSED AREA HAS BEEN LOAMED, FINAL GRADED WITH A UNIFORM SURFACE, THEN THE AREA MAY BE DORMANT SEEDDED AT A RATE OF 3 TIMES HIGHER THAN SPECIFIED FOR PERMANENT SEED AND THEN MULCHED. IF CONSTRUCTION CONTINUES DURING FREEZING WEATHER, ALL EXPOSED AREAS SHALL BE CONTINUOUSLY GRADED BEFORE FREEZING, AND THE SURFACE TEMPORARILY PROTECTED FROM EROSION BY THE APPLICATION OF MULCH. SLOPES SHALL NOT BE LEFT UNEXPOSED OVER THE WINTER OR ANY OTHER EXTENDED TIME OF WORK SUSPENSION, UNLESS TREATED IN THE ABOVE MANNER. UNTIL SUCH TIME AS WEATHER CONDITIONS ALLOW, DITCHES TO BE FINISHED WITH THE PERMANENT SURFACE TREATMENT. EROSION SHALL BE CONTROLLED BY THE INSTALLATION OF BALES OF HAY, SILT FENCE OR STONE CHECK DAMS IN ACCORDANCE WITH THE STANDARD DETAILS SHOWN ON THE DESIGN DRAWINGS. NOTE: DORMANT SEEDING SHOULD NOT BE ATTEMPTED UNLESS SOIL TEMPERATURE REMAINS BELOW 50 DEGREES AND DAY TIME TEMPERATURES REMAIN IN THE 30'S.

7. MULCH NETTING SHALL BE USED TO ANCHOR MULCH IN ALL DRAINAGE WAYS WITH A SLOPE GREATER THAN 3% FOR SLOPES EXPOSED TO DIRECT WINDS AND FOR ALL OTHER SLOPES GREATER THAN 8%. VEGETATED DRAINAGE SWALES SHALL BE LINED WITH EXCELSIOR OR CURLEX.

8. MULCH NETTING SHALL BE USED TO ANCHOR MULCH IN ALL DRAINAGE WAYS WITH SLOPES GREATER THAN 15%. AFTER OCTOBER 1 THE SAME APPLIES FOR ALL SLOPES GREATER THAN 8%.

9. BETWEEN THE DATES OF OCTOBER 15 TO NOVEMBER 1 WINTER RYE IS RECOMMENDED FOR STABILIZATION. AFTER NOVEMBER 1, WINTER RYE IS NOT EFFECTIVE. AROUND NOVEMBER 15 OR LATER, ONCE TEMPERATURES OF THE AIR AND SOIL PERMIT, DORMANT SEEDING IS EFFECTIVE.

10. IN THE EVENT OF SNOWFALL (FRESH OR CUMULATIVE) GREATER THAN 1 INCH DURING WINTER CONSTRUCTION PERIOD, ALL SNOW SHALL BE REMOVED FROM THE AREAS OF SEEDING AND MULCHING PRIOR TO PLACEMENT.

SITE INSPECTION AND MAINTENANCE

1. WEEKLY INSPECTIONS, AS WELL AS ROUTINE INSPECTIONS FOLLOWING RAIN FALLS, SHALL BE CONDUCTED BY THE GENERAL CONTRACTOR OF ALL TEMPORARY AND PERMANENT EROSION CONTROL DEVICES UNTIL FINAL ACCEPTANCE OF THE PROJECT (85% GRASS CATCH). NECESSARY REPAIRS SHALL BE MADE TO CORRECT UNDERMINING OR DETERIORATION. FINAL ACCEPTANCE SHALL INCLUDE A SITE INSPECTION TO VERIFY THE STABILITY OF ALL DISTURBED AREAS AND SLOPES. UNTIL FINAL INSPECTION, ALL EROSION AND SEDIMENTATION CONTROL MEASURES SHALL IMMEDIATELY BE CLEANED, AND REPAIRED BY THE GENERAL CONTRACTOR AS REQUIRED. DISPOSAL OF ALL TEMPORARY EROSION AND CONTROL DEVICES SHALL BE THE RESPONSIBILITY OF THE GENERAL CONTRACTOR.

2. SHORT-TERM SEDIMENTATION MAINTENANCE SHALL BE THE RESPONSIBILITY OF THE CONTRACTOR TO CLEAN OUT ALL SWALES AND STRUCTURES PRIOR TO TURNING PROJECT OVER.

3. LONG-TERM PROVISIONS FOR PERMANENT MAINTENANCE OF ALL EROSION AND SEDIMENTATION CONTROL DEVICES AFTER ACCEPTANCE OF THE PROJECT SHALL BE THE RESPONSIBILITY OF THE OWNER.

HNTB logo and contact information for Architecture Engineering Planning.




MAINE TURNPIKE AUTHORITY ADMINISTRATION BUILDING PORTLAND, MAINE. ISSUED FOR BIDDING/CONSTRUCTION 7-9-07.






Revision table with columns for REV, DESCRIPTION, DATE.

GRAPHIC SCALE: 1" = 10'. PROJECT MANAGER: GAB. PROJECT NO: 2007.07. SHEET No. CS302.

AS BUILT Owner Copy

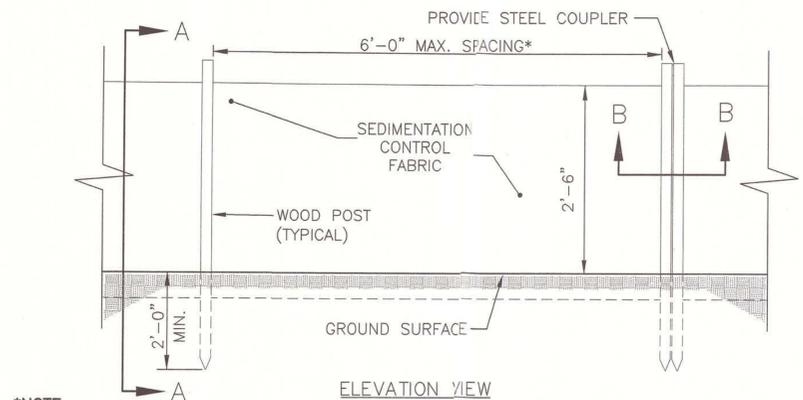

***NOTE:**
THE SILT FENCE SHOULD HAVE A MAXIMUM STAKING DISTANCE OF 6' UNLESS THE FENCE IS SUPPORTED BY WIRE FENCE REINFORCEMENT A MAXIMUM 14 GAUGE AND WITH A MINIMUM MESH SPACING OF 6".

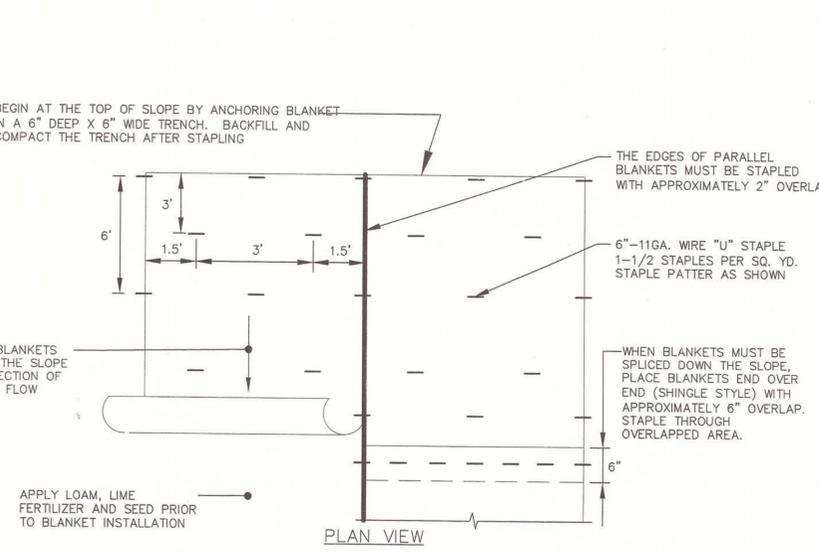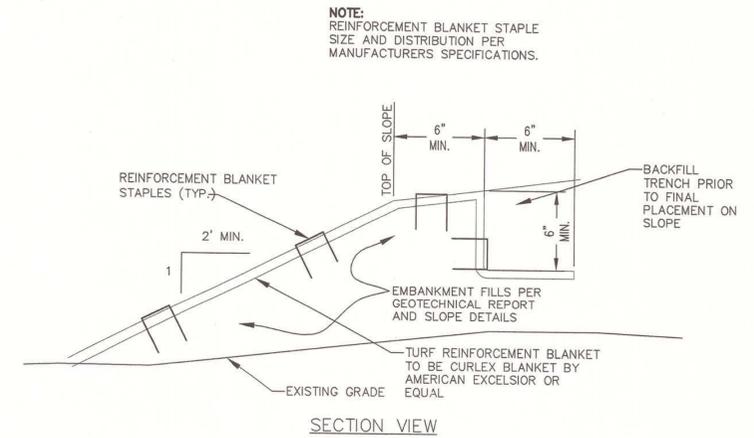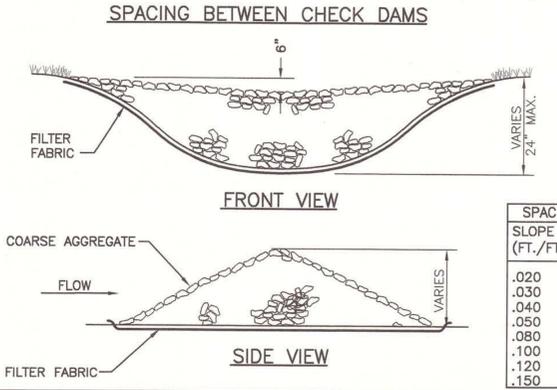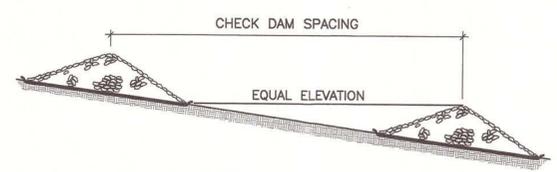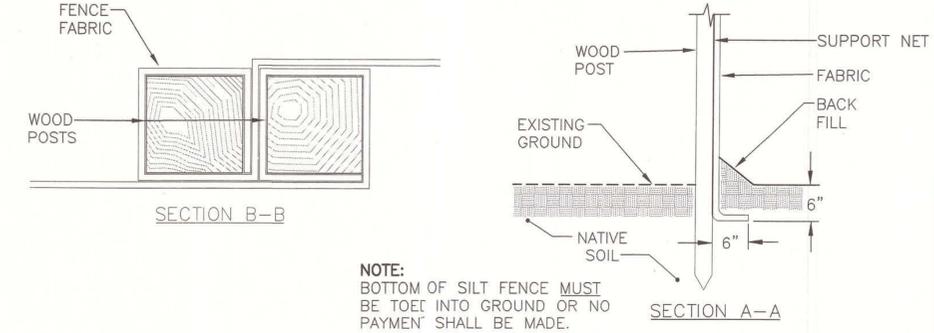


F1 SILTATION FENCE

NTS * *



F6 STONE CHECK DAM

NTS * *

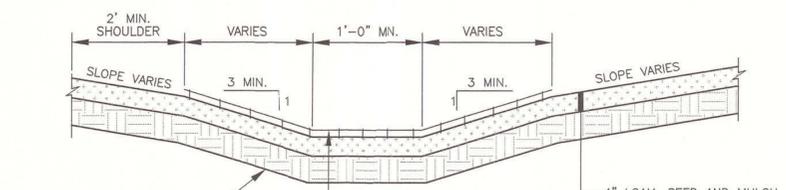

NOTES: MAINTENANCE OF THE VEGETATION IN THE GRASSED WATERWAY IS EXTREMELY IMPORTANT IN ORDER TO PREVENT RILLING, EROSION, AND FAILURE OF THE WATERWAY. MOWING SHOULD BE DONE FREQUENTLY ENOUGH TO CONTROL ENCROACHMENT OF WEEDS AND WOODY VEGETATION AND TO KEEP THE GRASSES IN A VIGOROUS CONDITION. THE VEGETATION SHOULD NOT BE MOWED TOO CLOSELY SO AS TO REDUCE THE EROSION RESISTANCE IN THE WATERWAY. THE WATERWAY SHOULD BE INSPECTED PERIODICALLY AND AFTER EVERY MAJOR STORM TO DETERMINE THE CONDITION OF THE WATERWAY. RILLS AND DAMAGED AREAS SHOULD BE PROMPTLY REPAIRED AND RE-VEGETATED AS NECESSARY TO PREVENT FURTHER DETERIORATION. PERIODIC APPLICATIONS OF LIME AND FERTILIZER MAY BE NEEDED TO MAINTAIN VIGOROUS GROWTH.

- CONSTRUCTION SPECIFICATIONS**
1. THE FOUNDATION AREA OF THE WATERWAY SHALL BE CLEARED AND GRUBBED OF ALL TREES, BRUSH, STUMPS, AND OTHER OBJECTIONABLE MATERIAL. MATERIALS REMOVED SHALL BE DISPOSED OF SO THEY WILL NOT INTERFERE WITH THE CONSTRUCTION OR PROPER FUNCTIONING OF THE WATERWAY.
 2. THE WATERWAY SHALL BE EXCAVATED OR SHAPED TO LINE, GRADE, AND CROSS SECTION AS REQUIRED TO MEET THE DESIGN CRITERIA. THE WATERWAY SHALL BE FREE OF IRREGULARITIES WHICH WILL IMPEDE NORMAL FLOW.
 3. EARTH FILLS REQUIRED TO MEET SUBGRADE REQUIREMENTS BECAUSE OF OVER EXCAVATION OR TOPOGRAPHY SHALL BE COMPACTED TO THE SAME DENSITY AS THE SURROUNDING SOIL TO PREVENT UNEQUAL SETTLEMENT THAT COULD CAUSE DAMAGE TO THE COMPLETED WATERWAY. EARTH REMOVED AND NOT NEEDED IN CONSTRUCTION SHALL BE SPREAD OR DISPOSED OF SO IT WILL NOT INTERFERE WITH THE FUNCTIONING OF THE WATERWAY.
 4. STONE AND BEDDING FOR ROCK LINED WATERWAYS SHALL MEET THE GRADATION REQUIREMENTS OF THE DESIGN AND SHALL BE DURABLE AND FREE OF SOIL AND OTHER DEBRIS.
 5. CONSTRUCTION OPERATIONS SHALL BE CARRIED OUT IN SUCH A MANNER AS TO MINIMIZE EROSION AND AIR AND WATER POLLUTION. ALL APPROPRIATE STATE AND LOCAL LAWS AND REGULATIONS SHALL BE COMPLIED WITH FOR DESIGN AND INSTALLATION.
 6. THE WATERWAY SHALL BE STABILIZED USING THE APPROPRIATE BEST MANAGEMENT PRACTICES FOR VEGETATIVE MEASURES OR STONE CENTER.

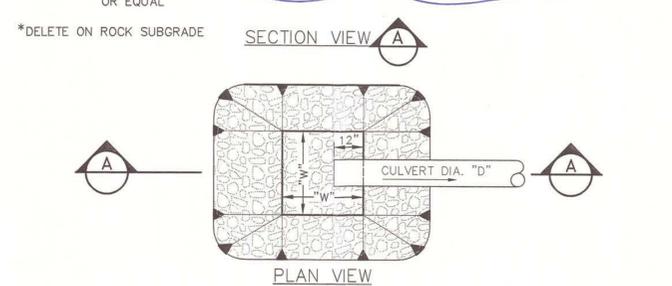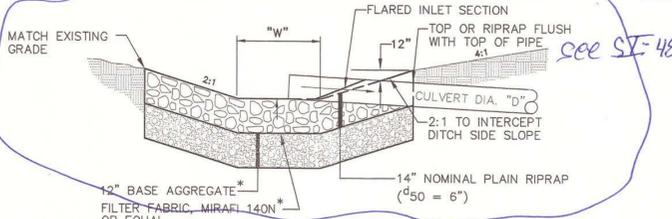


SCHEDULE			
CULVERT DIAMETER (D)	WIDTH (W)	STONE d ₅₀	RIPRAP THICKNESS
10"	4'	6"	14"
12"	4'	6"	14"
TWIN 18"	10'	6"	14"
TWIN 24"	10'	6"	14"
36"	9'	6"	14"

A6 RIPRAP INLET APRON DETAIL

NTS * *

E10 EROSION CONTROL BLANKET DETAIL

NTS * *

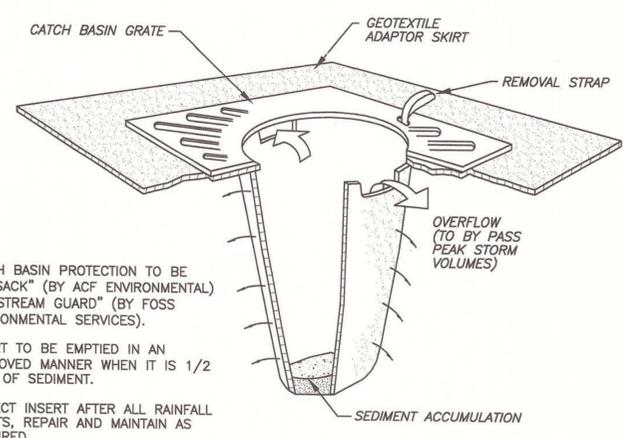

- NOTES**
1. CATCH BASIN PROTECTION TO BE "SILTSACK" (BY ACF ENVIRONMENTAL) OR "STREAM GUARD" (BY FOSS ENVIRONMENTAL SERVICES).
 2. INSERT TO BE EMPTIED IN AN APPROVED MANNER WHEN IT IS 1/2 FULL OF SEDIMENT.
 3. INSPECT INSERT AFTER ALL RAINFALL EVENTS, REPAIR AND MAINTAIN AS REQUIRED.

AS BUILT
Owner Copy

A1 VEGETATED DRAINAGE SWALE

NTS * *

A10 INLET PROTECTION DETAIL

NTS * *

S.M. RT

ARCHITECTURE ENGINEERING PLANNING

144 Fore Street/P.O. Box 618
Portland, Maine 04104
Tel. (207) 772-3846
Fax. (207) 772-1070

MARK G. JOHNSON
LICENSED LANDSCAPE ARCHITECT
NO. 1857

MAINE TURNPIKE AUTHORITY
ADMINISTRATION BUILDING
PORTLAND, MAINE

ISSUED FOR BIDDING/CONSTRUCTION
7-9-07

REV	DATE	DESCRIPTION
0	7-9-07	BIDDING/CONSTRUCTION

GRAPHIC SCALE: 0" = 1"

SCALE: SHOWN

PROJECT MANAGER: SLB

JC/DRAWN BY: TCM/PAF

A/E OF RECORD: MGJ

CAD FILE: 06016-C504

PROJECT No: 06016

DATE: 7-9-07

SHEET TITLE: EROSION/SEDIMENT CONTROL DETAILS

SHEET No. **CS501**

CODES AND STANDARDS APPLICABLE TO SCOPE OF PROFESSIONAL SERVICES REQUESTED:

LIFE SAFETY CODE:
 A. NFPA, INCLUDING:
 101 LIFE SAFETY CODE, 2003 EDITION.
 AUTHORITY HAVING JURISDICTION:
 MAINE STATE DEPARTMENT OF PUBLIC SAFETY, STEVEN DODGE
 PHONE: 207-624-8737
 FAX: 207-624-8767

BUILDING CODE:
 A. THE INTERNATIONAL BUILDING CODE, 2003 EDITION
 AUTHORITY HAVING JURISDICTION: MIKE NUGENT
 CITY OF PORTLAND BUILDING DEPARTMENT
 PHONE: 207-XXX-XXXX
 FAX: 207-XXX-XXXX

HANDICAPPED ACCESSIBILITY STANDARD:
 A. AMERICANS WITH DISABILITIES ACT ACCESSIBILITY GUIDELINES
 AUTHORITY HAVING JURISDICTION:
 MAINE STATE DEPARTMENT OF PUBLIC SAFETY, STEPHEN DODGE
 PHONE: 207-624-8737
 FAX: 207-624-8767

OTHER REFERENCES:

BASIC LIFE SAFETY AND BUILDING CODE CRITERIA:

DESCRIPTION OF BUILDING FUNCTION:
 NEW, MULTI-STORY, COMMERCIAL OFFICE BUILDING DESIGNED TO ACCOMMODATE A SINGLE TENANT. THE WORK OF THIS CONTRACT WILL INCLUDE BOTH SHELL AND CORE, AND FIT-UP FOR ALL THREE FLOORS.

OCCUPANT CLASSIFICATION(S):
 NFPA 101:
 NEW BUSINESS

USE GROUP CLASSIFICATION(S):
 THE INTERNATIONAL BUILDING CODE:
 BUSINESS

INCIDENTAL USE AREAS AND SPECIAL HAZARD PROTECTION AREAS:
 THE INTERNATIONAL BUILDING CODE: TABLE 302.1.1

DESCRIPTION:
 SHIP/RECEIVE
 MECHANICAL RM.
 ELECTRICAL ENTRANCE RM. (NFPA 70)
 ELEVATOR MACHINE ROOM
 SALLYPORT (ENCLOSED PARKING GARAGE)
 ARMORY
 SECURE EVIDENCE
 TRANSDUCERS & FULFILLMENT
 STORAGE RMS. > 100 SF.

SPECIAL USE AND OCCUPANCY:
 NONE IDENTIFIED

OTHER PORTIONS OF THE BUILDING TO RECEIVE FIRE SEPARATION/PROTECTION MEASURES:

DESCRIPTION:	SEPARATION:
TEL./DATA ROOMS	SPRINKLERS + SMOKE PARTITIONS
SECONDARY ELECTRICAL ROOMS	SPRINKLERS + SMOKE PARTITIONS
COMPUTER SERVER ROOMS (NFPA75)	CLEAN AGENT FIRE PROT. + 1 HOUR

ACCESSORY USE AREAS:
 THE INTERNATIONAL BUILDING CODE: 302.2
 ASSEMBLY: (LESS THAN 10% OF THE AREA OF EACH STORY - NON-SEPARATED)
 BREAKROOM
 CONFERENCE ROOMS
 AUTHORITY ROOM

COMMUNICATING SPACE(S):
 NFPA 101: 8.6.6
 THE INTERNATIONAL BUILDING CODE: 707.2, EXCEPTION 7

DESCRIPTION:
 HALL
 GALLERY

SEPARATION:
 SPRINKLERS + SMOKE PARTITIONS
 SPRINKLERS + SMOKE PARTITIONS

TYPE OF CONSTRUCTION:
 CAST-IN-PLACE CONCRETE FOUNDATION AND SLAB-ON-GRADE. STRUCTURAL STEEL FRAME, METAL DECK, AND CONCRETE TOPPING AT ALL FLOORS WITH STEEL JOISTS, AND METAL DECK ROOF. BRICK MASONRY OVER METAL STUD BACK-UP WITH ALUMINUM STOREFRONT AND WINDOW SYSTEMS IN MASONRY OPENINGS AT LOWER PORTION OF EXTERIOR WALLS, AND COMPOSITE ALUMINUM PANELS WITH ALUMINUM WINDOW SYSTEMS AT UPPER PORTION OF EXTERIOR WALLS.

NFPA: NO REQUIREMENTS.
 THE INTERNATIONAL BUILDING CODE: TYPE 2B

BUILDING WILL BE PROTECTED THROUGHOUT BY AUTOMATIC FIRE SPRINKLERS IN CONFORMANCE WITH NFPA 13, WITH THE EXCEPTION OF THOSE AREAS BEING PROTECTED BY CLEAN AGENT FIRE PROTECTION SYSTEMS IN CONFORMANCE WITH NFPA 2001 AND IBC, SECTION 904.

MINIMUM FIRE RESISTANCE RATINGS OF BUILDING ELEMENTS:
 THE INTERNATIONAL BUILDING CODE, TABLE 602 & NFPA 220, TABLE 3-1)

ELEMENT 2B/II(000)	0 HR.
STRUCTURAL FRAME	0 HR.
COL., GIRDERS & TRUSSES	0 HR.
LOADBEARING EXTERIOR WALLS	0 HR.
LOADBEARING INTERIOR WALLS	0 HR.
NONBEARING EXTERIOR WALLS/PARTITIONS	0 HR.
NONBEARING INTERIOR WALLS/PARTITIONS	0 HR.
FIRE SEPARATION ASSEMBLIES:	1 HR.
EXIT ENCLOSURES	1 HR.
SHAFTS & ELEV. HOISTWAYS	(NA)
MIXED USE SEPARATIONS	0 HR. TABLE 1011.4
EXIT ACCESS CORRIDORS	1 HR. (NOT REQUIRED BY CODE)
TENANT SPACES SEPARATION (MTA/S.P.)	0 HR.
SMOKE BARRIERS	0 HR.
FLOOR CONSTRUCTION INCLUDING BEAMS	0 HR.
ROOF/CEILING:	0 HR.

BUILDING HEIGHT:
 ALLOWABLE: (THE INTERNATIONAL BUILDING CODE, TABLE 503)
 TABLE 503 4 STORIES, 55 FEET
 WITH SPRINKLER MODIFICATION 5 STORIES, 75 FEET

ACTUAL: 3 STORIES, 41 FEET +/-

BUILDING AREA:
 ALLOWABLE: (THE BOCA, TABLE 503)
 TABLE 503 23,000 SF
 STREET FRONTAGE INCREASE 12,850 SF
 SPRINKLER MODIFICATION 46,000 SF
 MAX. ALLOWABLE AREA (FLOOR) 81,850 SF
 MAX. BLDG. AREA 244,950 SF

ACTUAL: FLOOR BUILDING 18,340 SF 54,716 SF

MEANS OF EGRESS:
 OCCUPANT LOAD:
 FIRST FLOOR: 284
 SECOND FLOOR: 338
 THIRD FLOOR: 340
 962

MINIMUM NUMBER: TWO, INCLUDING ALL ROOMS AND AREAS WITH OVER 50 OCCUPANTS.

CAPACITY:
 EXIT ACCESS: ALLOWABLE MINIMUM WIDTH 44 IN.
 DOORS: ALLOWABLE MINIMUM WIDTH 36 IN.

ARRANGEMENT:
 MAX. ALLOWABLE DEAD-END CORRIDOR: 50 FT.
 MAX. ALLOWABLE TRAVEL DISTANCE: 300 FT.
 MAX. ALLOWABLE COMMON PATH OF TRAVEL: 100 FT.

ILLUMINATION OF MEANS OF EGRESS:
 EGRESS WILL BE ILLUMINATED BY LIGHT FIXTURES ON A CIRCUIT POWERED BY AN EMERGENCY GENERATOR CONFORMING WITH NFPA 110.

PROTECTION FROM HAZARDS:
 WATER BASED AUTOMATIC FIRE PROTECTION SYSTEM CONFORMING WITH NFPA 13, TYPICAL THROUGHOUT THE BUILDING UNLESS NOTED OTHERWISE.

CLEAN AGENT AUTOMATIC FIRE PROTECTION SYSTEM CONFORMING WITH NFPA 2001 IN LIMITED AREAS AS DESCRIBED ON THE DRAWINGS.

SPECIAL HAZARD PROTECTION AREAS WILL BE FIRE OR SMOKE SEPARATED AS IDENTIFIED ABOVE.

PROTECTION OF VERTICAL OPENINGS:
 VERTICAL OPENINGS WILL BE PROTECTED TO MAINTAIN THE INTEGRITY OF AREA SEPARATIONS. REFERENCE MINIMUM FIRE RESISTANCE RATINGS OF STRUCTURAL ELEMENTS ABOVE.

INTERIOR FINISH:

WALL AND CEILING FINISHES:	EXITS	CORRIDORS	ROOMS
USE GROUP			
A			
FLAME SPREAD*	0-25	0-25 TYP.	0-75 CONF. & AUTH. RMS.
SMOKE DEVELOPMENT**	0-450	0-75 LOBBIES	0-200 TYP.
		0-450	0-450

*ASTM E84
 **NFPA 255

FLOOR FINISHES:

USE GROUP	EXITS	CORRIDORS	ROOMS
	NO REQUIREMENTS		
CRITICAL RADIANT FLUX*		CLASS II (0.22 WATTS/CM2)	
ASTM E648**			

*NFPA 253
 **IBC

DETECTION, ALARM AND COMMUNICATION SYSTEMS:
 A FIRE ALARM SYSTEM WILL BE REQUIRED IN ACCORDANCE WITH NFPA 101, 9.6.

EXTINGUISHMENT:
 PORTABLE EXTINGUISHERS IN ACCORDANCE WITH NFPA 101, 9.7.4.1.

END OF CODE COMPLIANCE STRATEGY REPORT

GENERAL NOTES:

1. SEE G1001 FOR PROJECT GENERAL NOTES.


AS BUILT
 Owner Copy

LEGEND:

- (LEGEND IS FOR THIS SHEET ONLY)
- HATCH INDICATES GENERAL AREAS OF HORIZONTAL STRUCTURAL STEEL TO RECEIVE SPRAY-ON FIREPROOFING AND VERTICAL AND DIAGONAL STRUCTURAL STEEL TO BE INDIVIDUALLY WRAPPED WITH GWB AND SEALED TIGHT. REFER TO STRUCTURAL DRAWINGS FOR ADDITIONAL INFORMATION.
 - HATCH INDICATES AREAS OF 1 HOUR FIRE-RATED SHAFTS.
 - HATCH INDICATES AREAS TO RECEIVE CLEAN AGENT FIRE PROTECTION.
 - HATCH INDICATES AREAS TO RECEIVE DOUBLE PRE-ACTION DRY FIRE PROTECTION.
 - SECURE 1 HOUR FIRE-RATED SEPARATION
 - NON-SECURE 1 HOUR FIRE-RATED SEPARATION
 - SMOKE BARRIER



ARCHITECTURE ENGINEERING PLANNING
 SMART
 144 Fore Street/P.O. Box 618
 Portland, Maine 04104
 tel. (207) 772-3846
 fax. (207) 772-1070

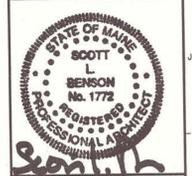




PROJECT TITLE:
**MAINE TURNPIKE AUTHORITY
 ADMINISTRATION BUILDING**
 PORTLAND, MAINE

CURRENT ISSUE STATUS:
**ISSUED FOR BIDDING/CONSTRUCTION
 7-9-07**

REV	DESCRIPTION	DATE
0	BIDDING/CONSTRUCTION	7-9-07
GRAPHIC SCALE: 		
SCALE: AS NOTED		
PROJECT MANAGER: SLB		
JC/DRAWN BY: TCM/TM		
A/E OF RECORD: SLB		
CAD FILE: AE001-06016		
PROJECT NO: 06016		
DATE: 7-9-07		
SHEET TITLE: CODE COMPLIANCE INFORMATION		
SHEET No. AE001		


F1 LIFE SAFETY AND BUILDING CODE COMPLIANCE STRATEGY REPORT

Fire Stopping Identification - RFE-361 changed to Stencils

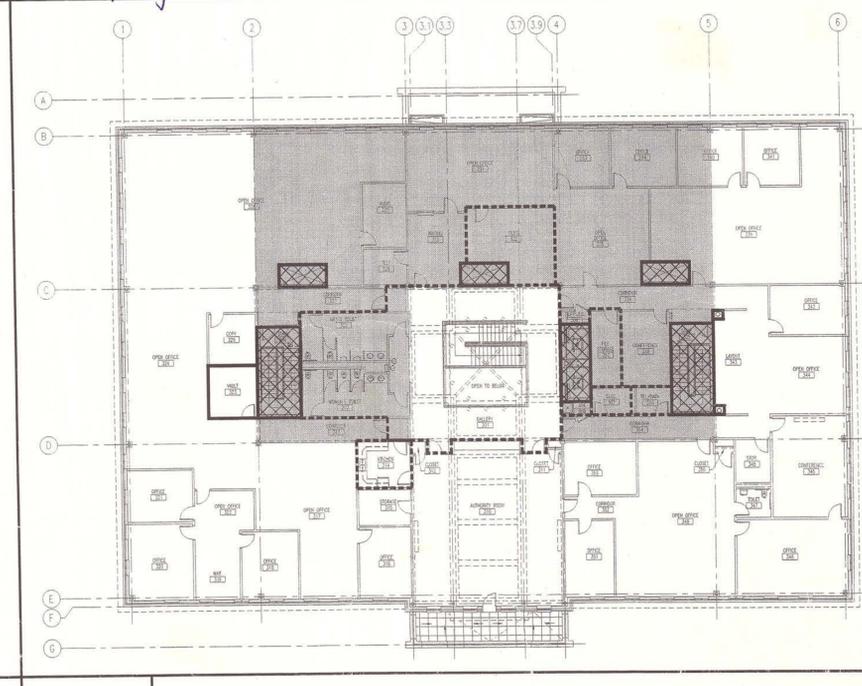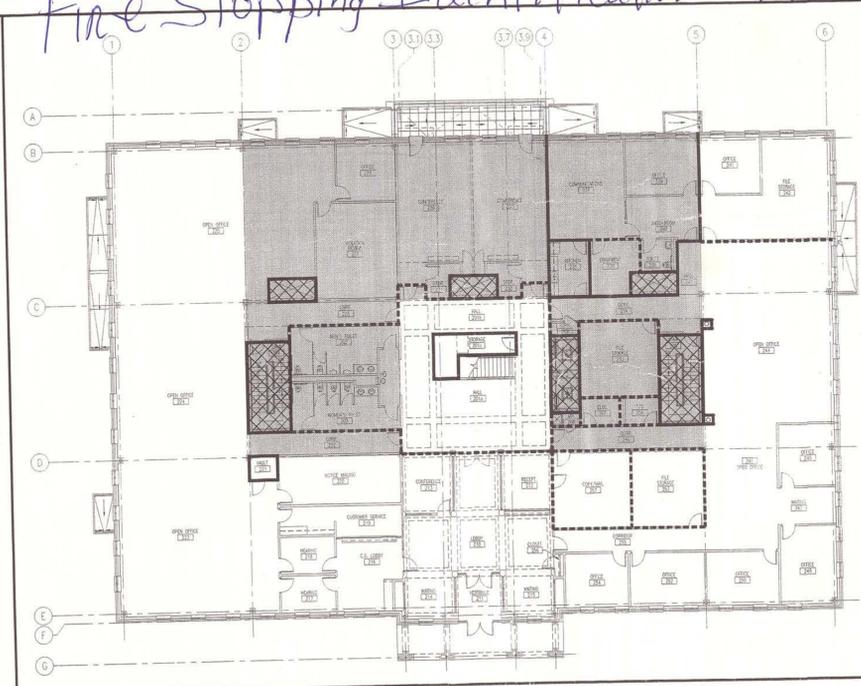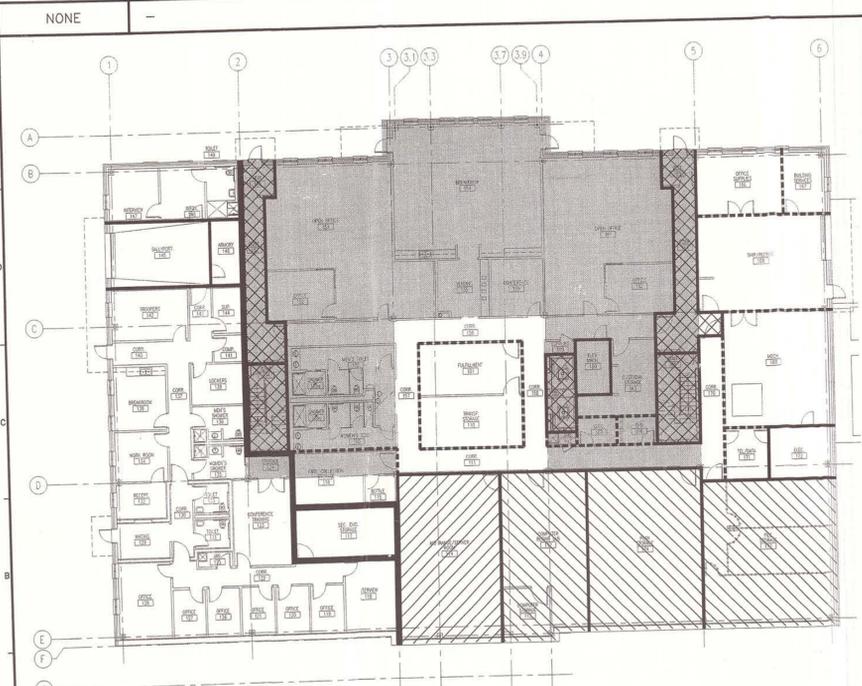

A1 FIRST FLOOR CODE DIAGRAM **A6 SECOND FLOOR CODE DIAGRAM** **A11 THIRD FLOOR CODE DIAGRAM**

1" = 20'-0"

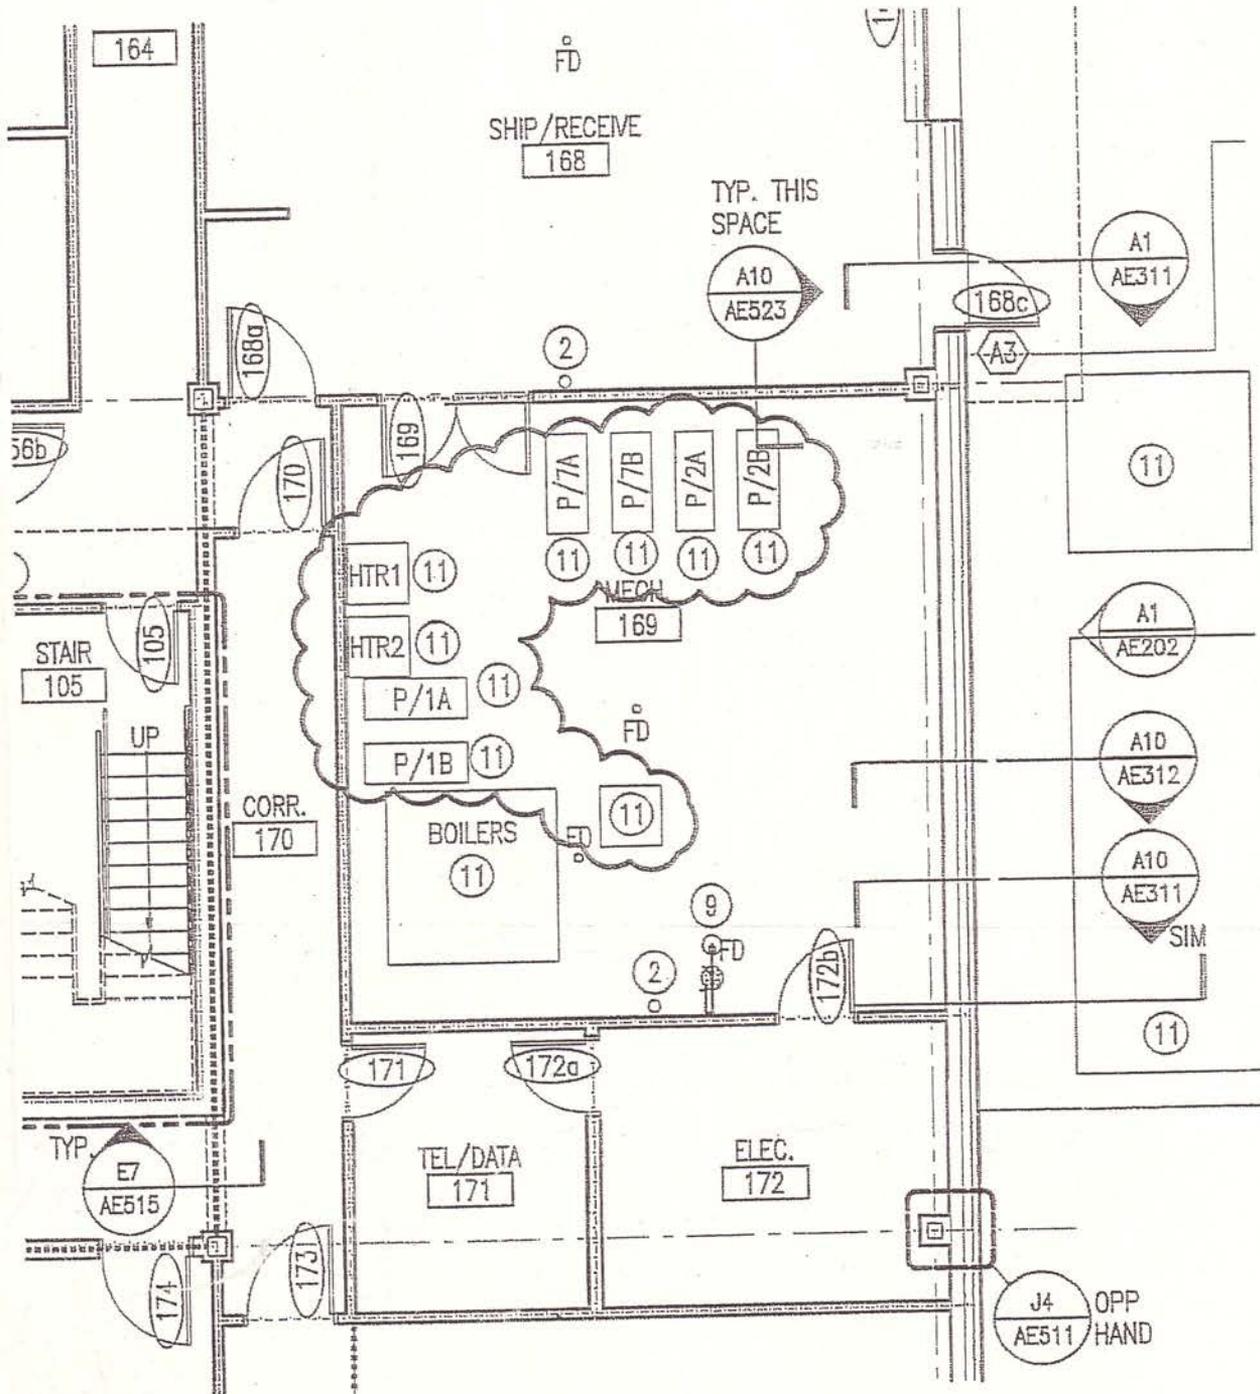

ARCHITECTURE ENGINEERING PLANNING
 SMRT
 144 Fore Street/P.O.Box 518 PORTLAND, MAINE 04104
 tel. (207) 772-3846 / fax. (207) 772-1070

SCALE: 1/8" = 1'-0"
 CAD FILE: AE101-06016
 PROJECT No. 06016
 REF. SHEET: AE101

PROJECT:

MAINE TURNPIKE AUTHORITY
 ADMINISTRATION BUILDING

PM: SLB

ADDENDUM No.
ADD-4

A/E: SLB


SKETCH No.
A-14

DATE: 8-10-07

© COPYRIGHT 2007 SMRT INC.

SUBJECT:

FIRST FLOOR PLAN
 REVISED AS NOTED

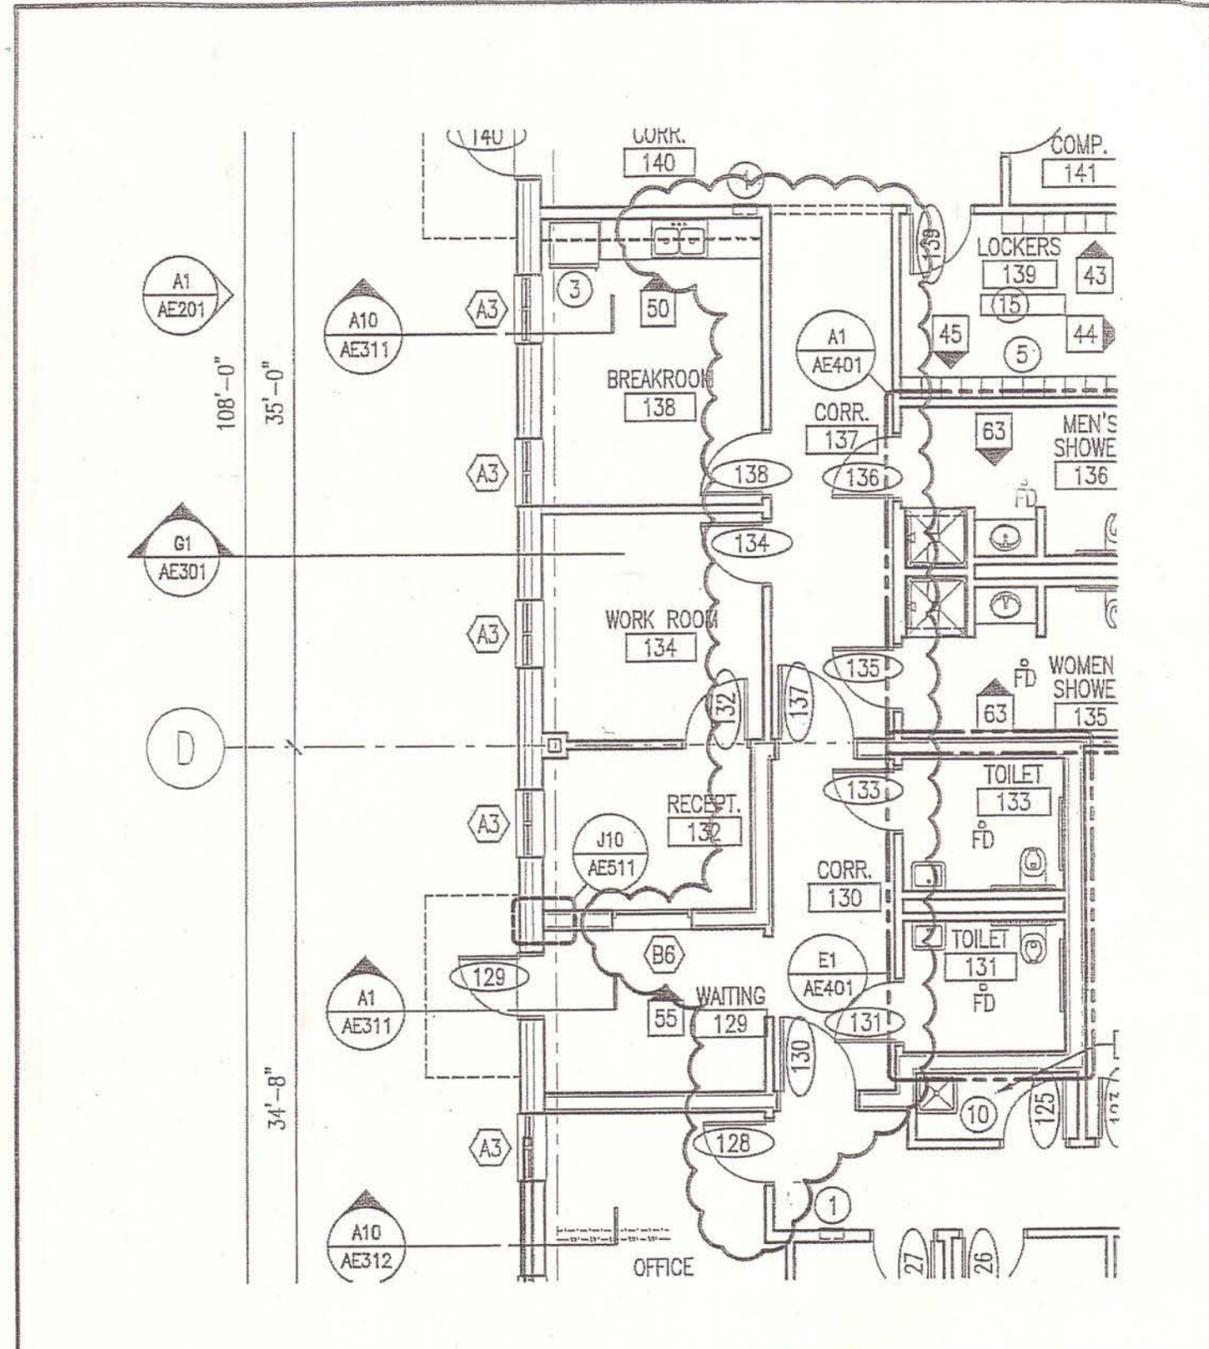


ARCHITECTURE ENGINEERING PLANNING
 SMRT
 144 Fore Street/P.O.Box 618 PORTLAND, MAINE 04104
 tel. (207) 772-3546 / fax. (207) 772-1070

SCALE: 1/8"=1'-0"
 CAD FILE: AE101-06016
 PROJECT No. 06016
 REF. SHEET: AE101

PROJECT: MAINE TURNPIKE AUTHORITY
 ADMINISTRATION BUILDING
 SUBJECT: FIRST FLOOR PLAN

PM: SLB
 A/E: SLB
 DATE: 8-10-07
 ADD-4
 A-1

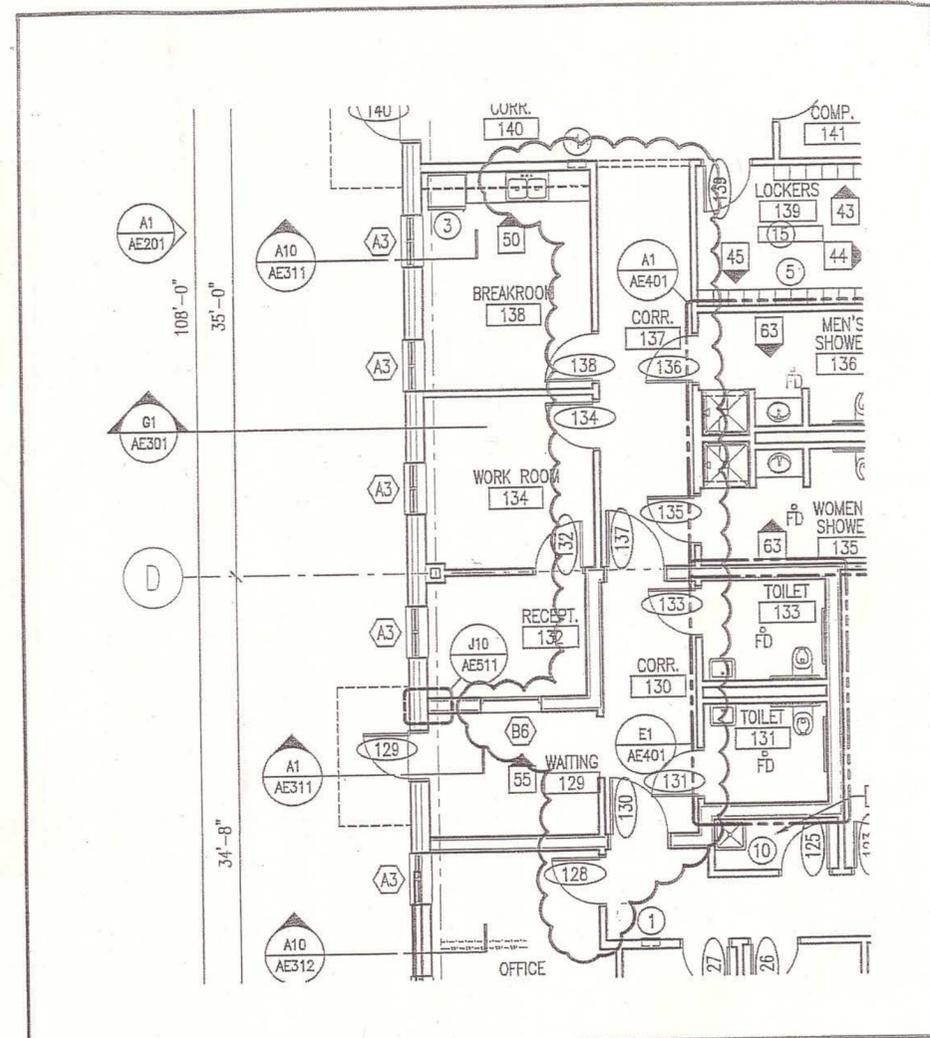


SMRT
 ARCHITECTURE ENGINEERING PLANNING
 SMRT
 144 Fore Street/P.O. Box 618 PORTLAND, MAINE 04104
 tel. (207) 772-3846 / fax. (207) 772-1070

PROJECT: MAINE TURNPIKE AUTHORITY
 ADMINISTRATION BUILDING
 SUBJECT: FIRST FLOOR PLAN

SCALE: 1/8"=1'-0"
 CAD FILE: AE101-06016
 PROJECT No. 06016
 REF. SHEET: AE101
 PM: SLB
 A/E: SLB
 DATE: 8-10-07

ADDENDUM No. **ADD-4**
 SHEET No. **A-1**

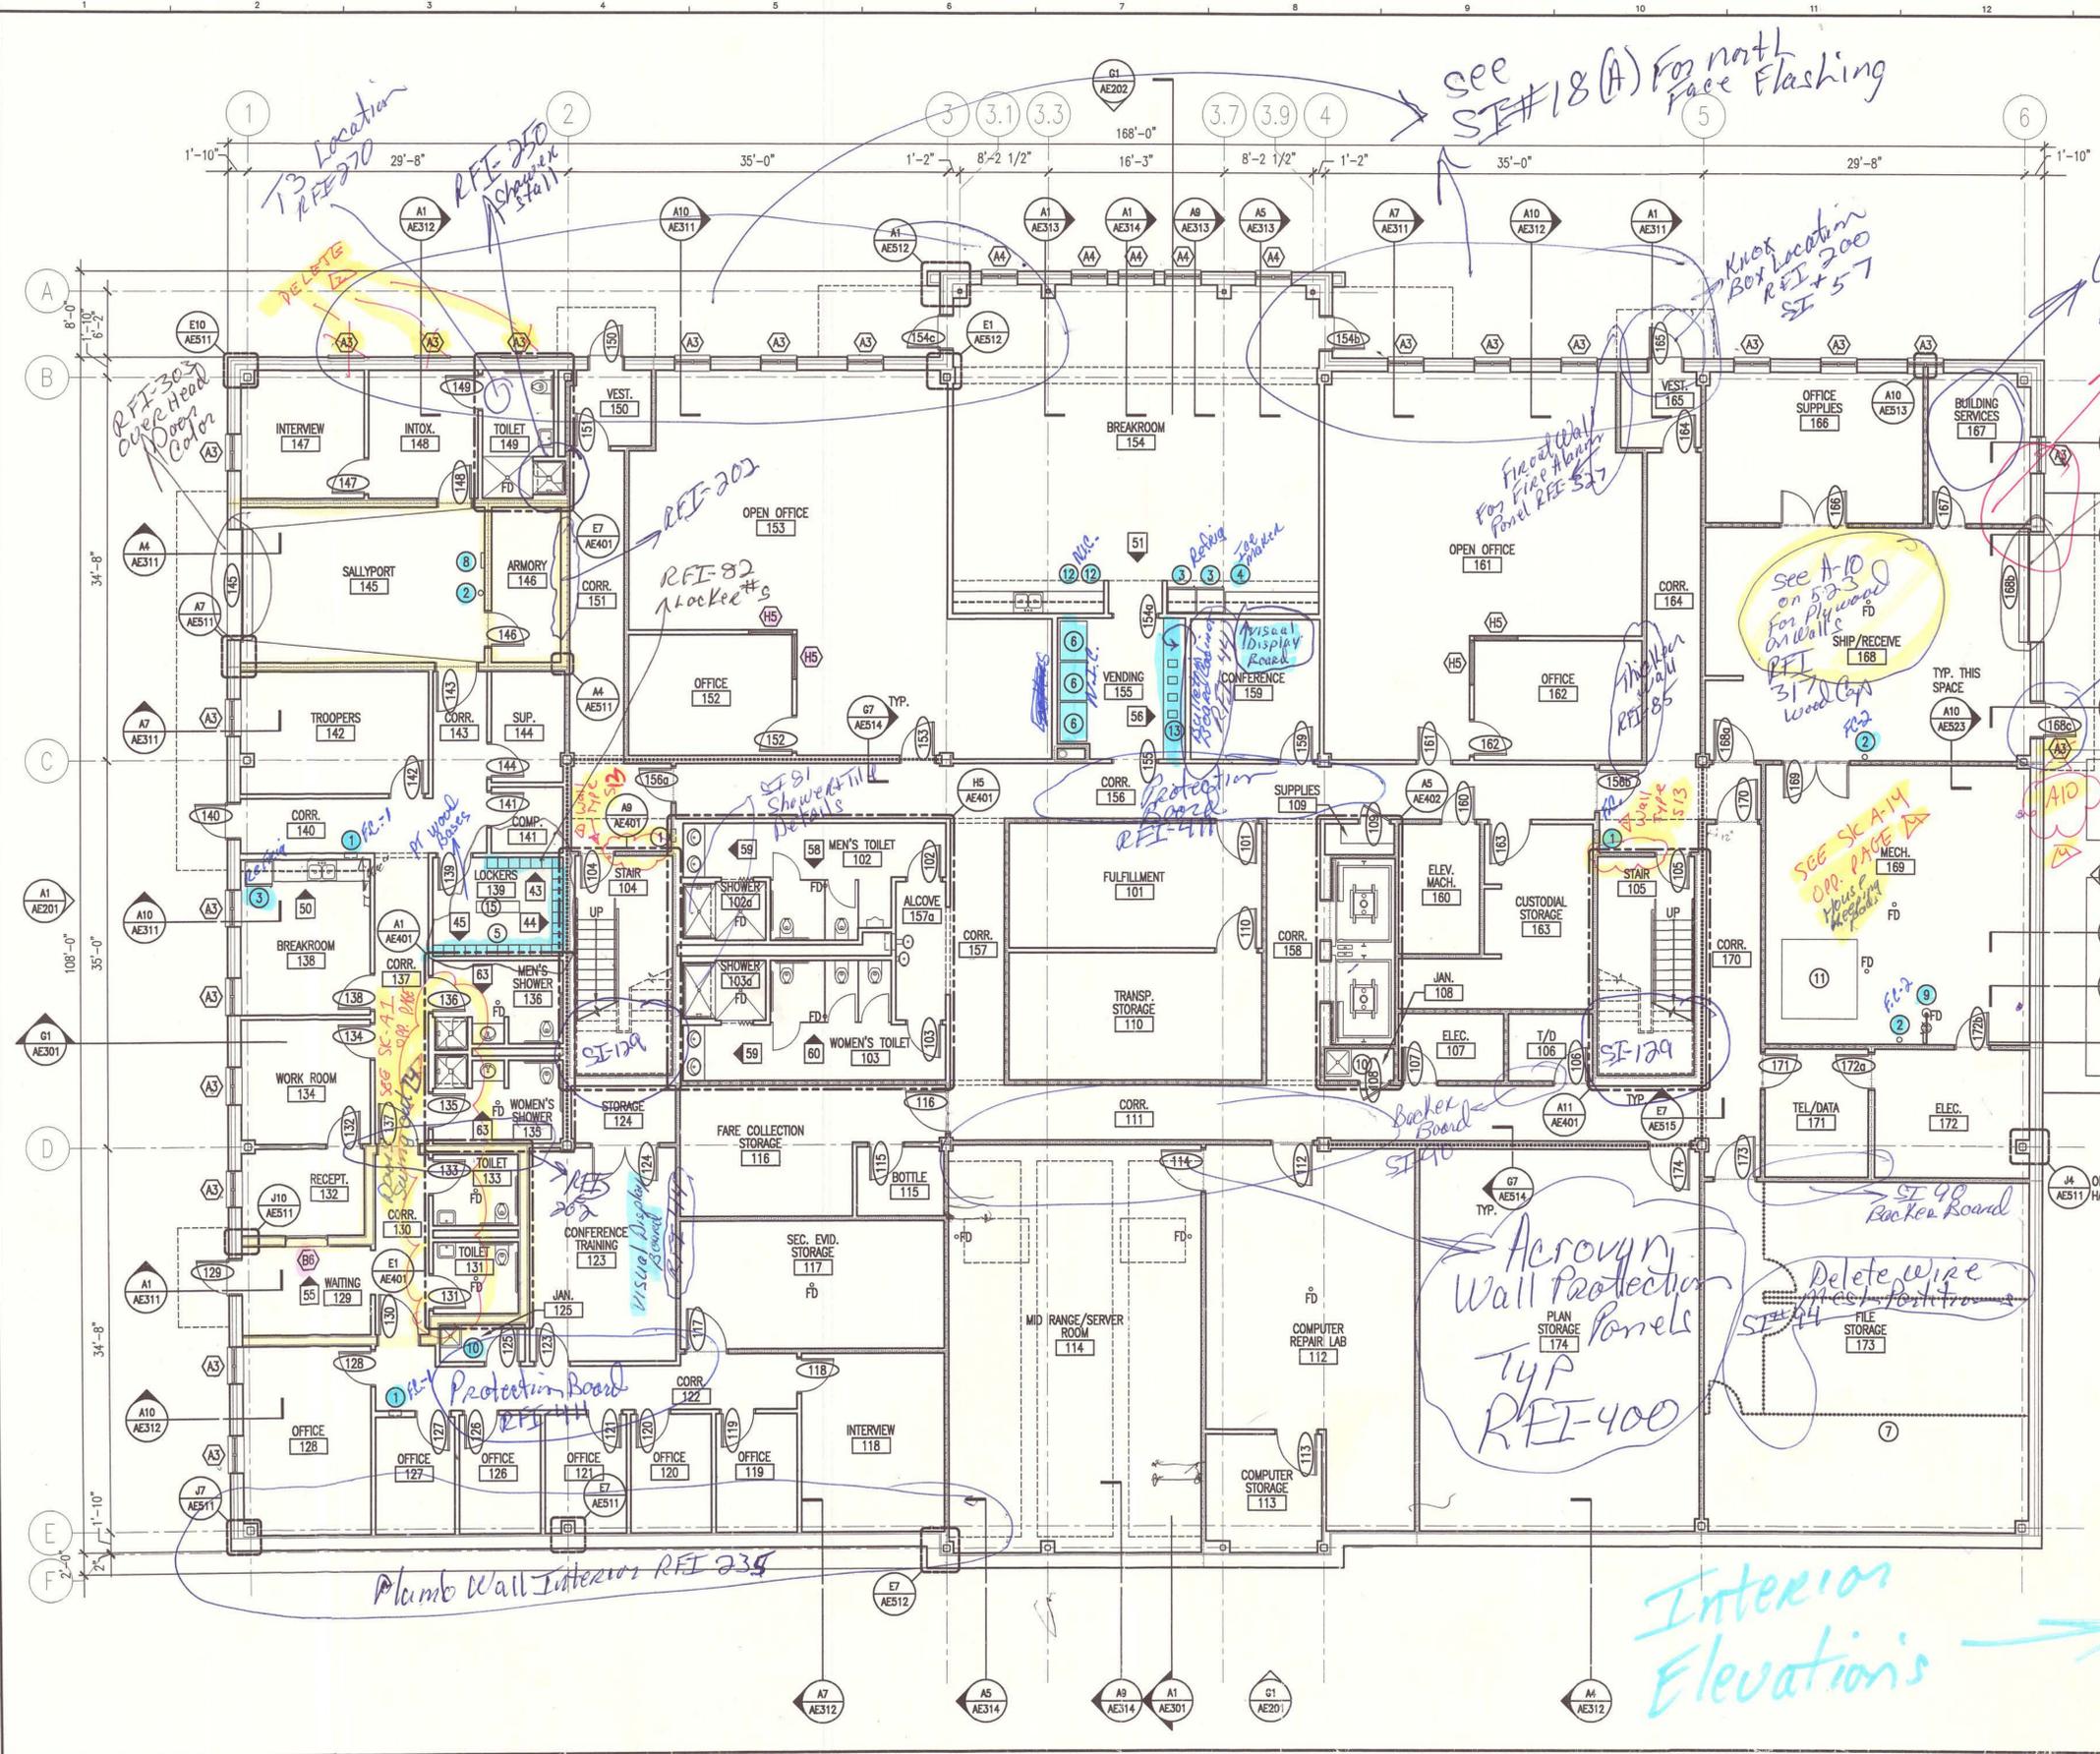


GENERAL NOTES:
 1. SEE G101 FOR PROJECT GENERAL NOTES.

FLOOR PLAN NOTES:
 1. REFER TO A600 SERIES DRAWINGS FOR WINDOW AND DOOR TYPES.

S.M. S.M. R.T.I.

ARCHITECTURE ENGINEERING PLANNING
 SWIRT
 144 Fore Street/P.O. Box 618
 Portland, Maine 04104
 tel. (207) 772-3846
 fax. (207) 772-1070

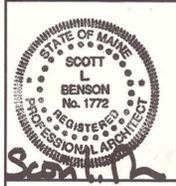

MAINE TURNPIKE AUTHORITY
 ADMINISTRATION BUILDING
 PORTLAND, MAINE

ISSUED FOR BIDDING/CONSTRUCTION
 7-9-07

- KEY NOTES:**
- 1 FIRE EXTINGUISHER FE-1
 - 2 FIRE EXTINGUISHER FE-2
 - 3 REFRIGERATOR
 - 4 ICE MAKER
 - 5 LOCKERS
 - 6 VENDING MACHINE, N.I.C.
 - 7 WIRE MESH PARTITIONS
 - 8 WALL MOUNTED EYE WASH
 - 9 EYE WASH/EMERGENCY SHOWER
 - 10 SLOP SINK W/ MOP RACK
 - 11 HOUSEKEEPING PADS, RE: STRUCT.
 - 12 COFFEE MAKER, N.I.C.
 - 13 BULLETIN BOARD CABINET
 - 14 AUTOMATED TELLER MACHINE, N.I.C.
 - 15 FIXED BENCH
 - 16 STEEL ROOF LADDER


④ 10ft high with 3ft. 8inches wide x 7ft. high doors

INTERIOR ELEVATION SCHEDULE (X)			
ELEVATION	ROOM NAME & NO.	WALL	ELEVATION REFERENCE
43	LOCKERS 139	N	J1/AE218
44	LOCKERS 139	E	J1/AE218
45	LOCKERS 139	S	J1/AE218
50	BREAKROOM 138	N	E9/AE218
51	BREAKROOM 154	S	A1/AE218
58	MEN'S SHOWER 102	S	J1/AE220
59	SHOWERS 102 & 103 (SINKS)	W	J6/AE220
60	WOMEN'S SHOWER 103	N	J6/AE220
63	SHOWERS 135 & 136	N/S	A1/AE220
55	Waiting 129	N	G1/AE219
56	Waiting 155	E	G5/AE219


A1 FIRST FLOOR PLAN
 1/8" = 1'-0"

AS BUILT
 Owner Copy

FIRST FLOOR PLAN
 SHEET No. AE101

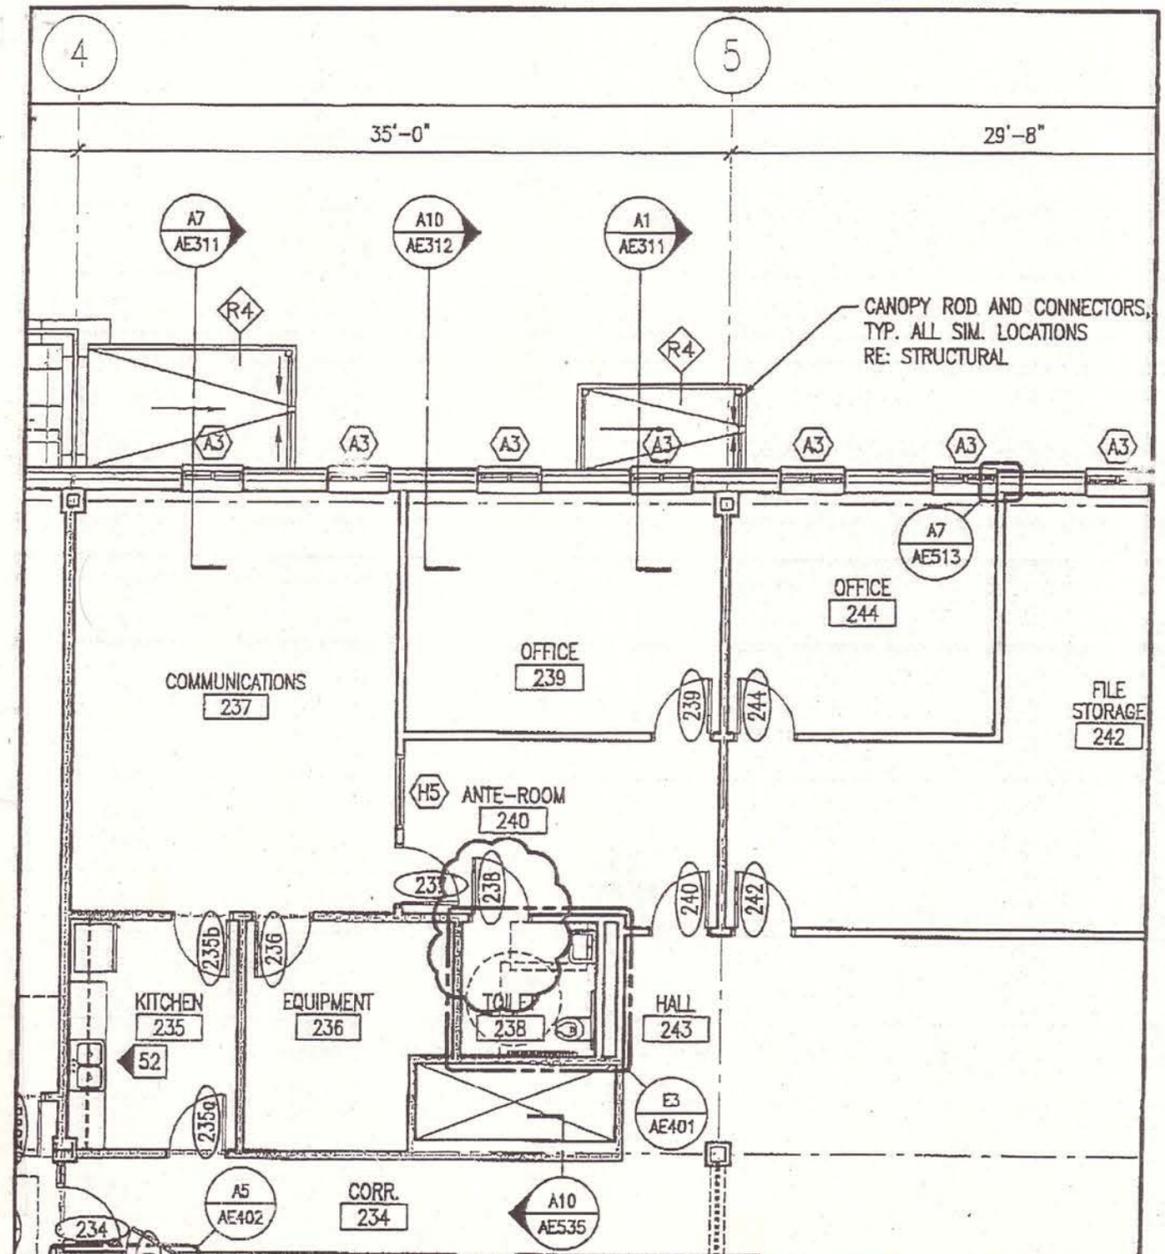

SM RT	ARCHITECTURE ENGINEERING PLANNING	SCALE: 1/8"=1'-0"
	144 Fore Street/P.O.Box 618 PORTLAND, MAINE 04104 tel. (207) 772-3846 / fax. (207) 772-1070	CAD FILE: AE102-06016
PROJECT: MAINE TURNPIKE AUTHORITY ADMINISTRATION BUILDING		PROJECT No. 06016
SUBJECT: REVISED DOOR SWING AT TOILET 238 SECOND FLOOR PLAN		REF. SHEET: AE102
		PM: SLB
		A/E: SLB
		DATE: 8-17-07
		ADD-5
		A-1

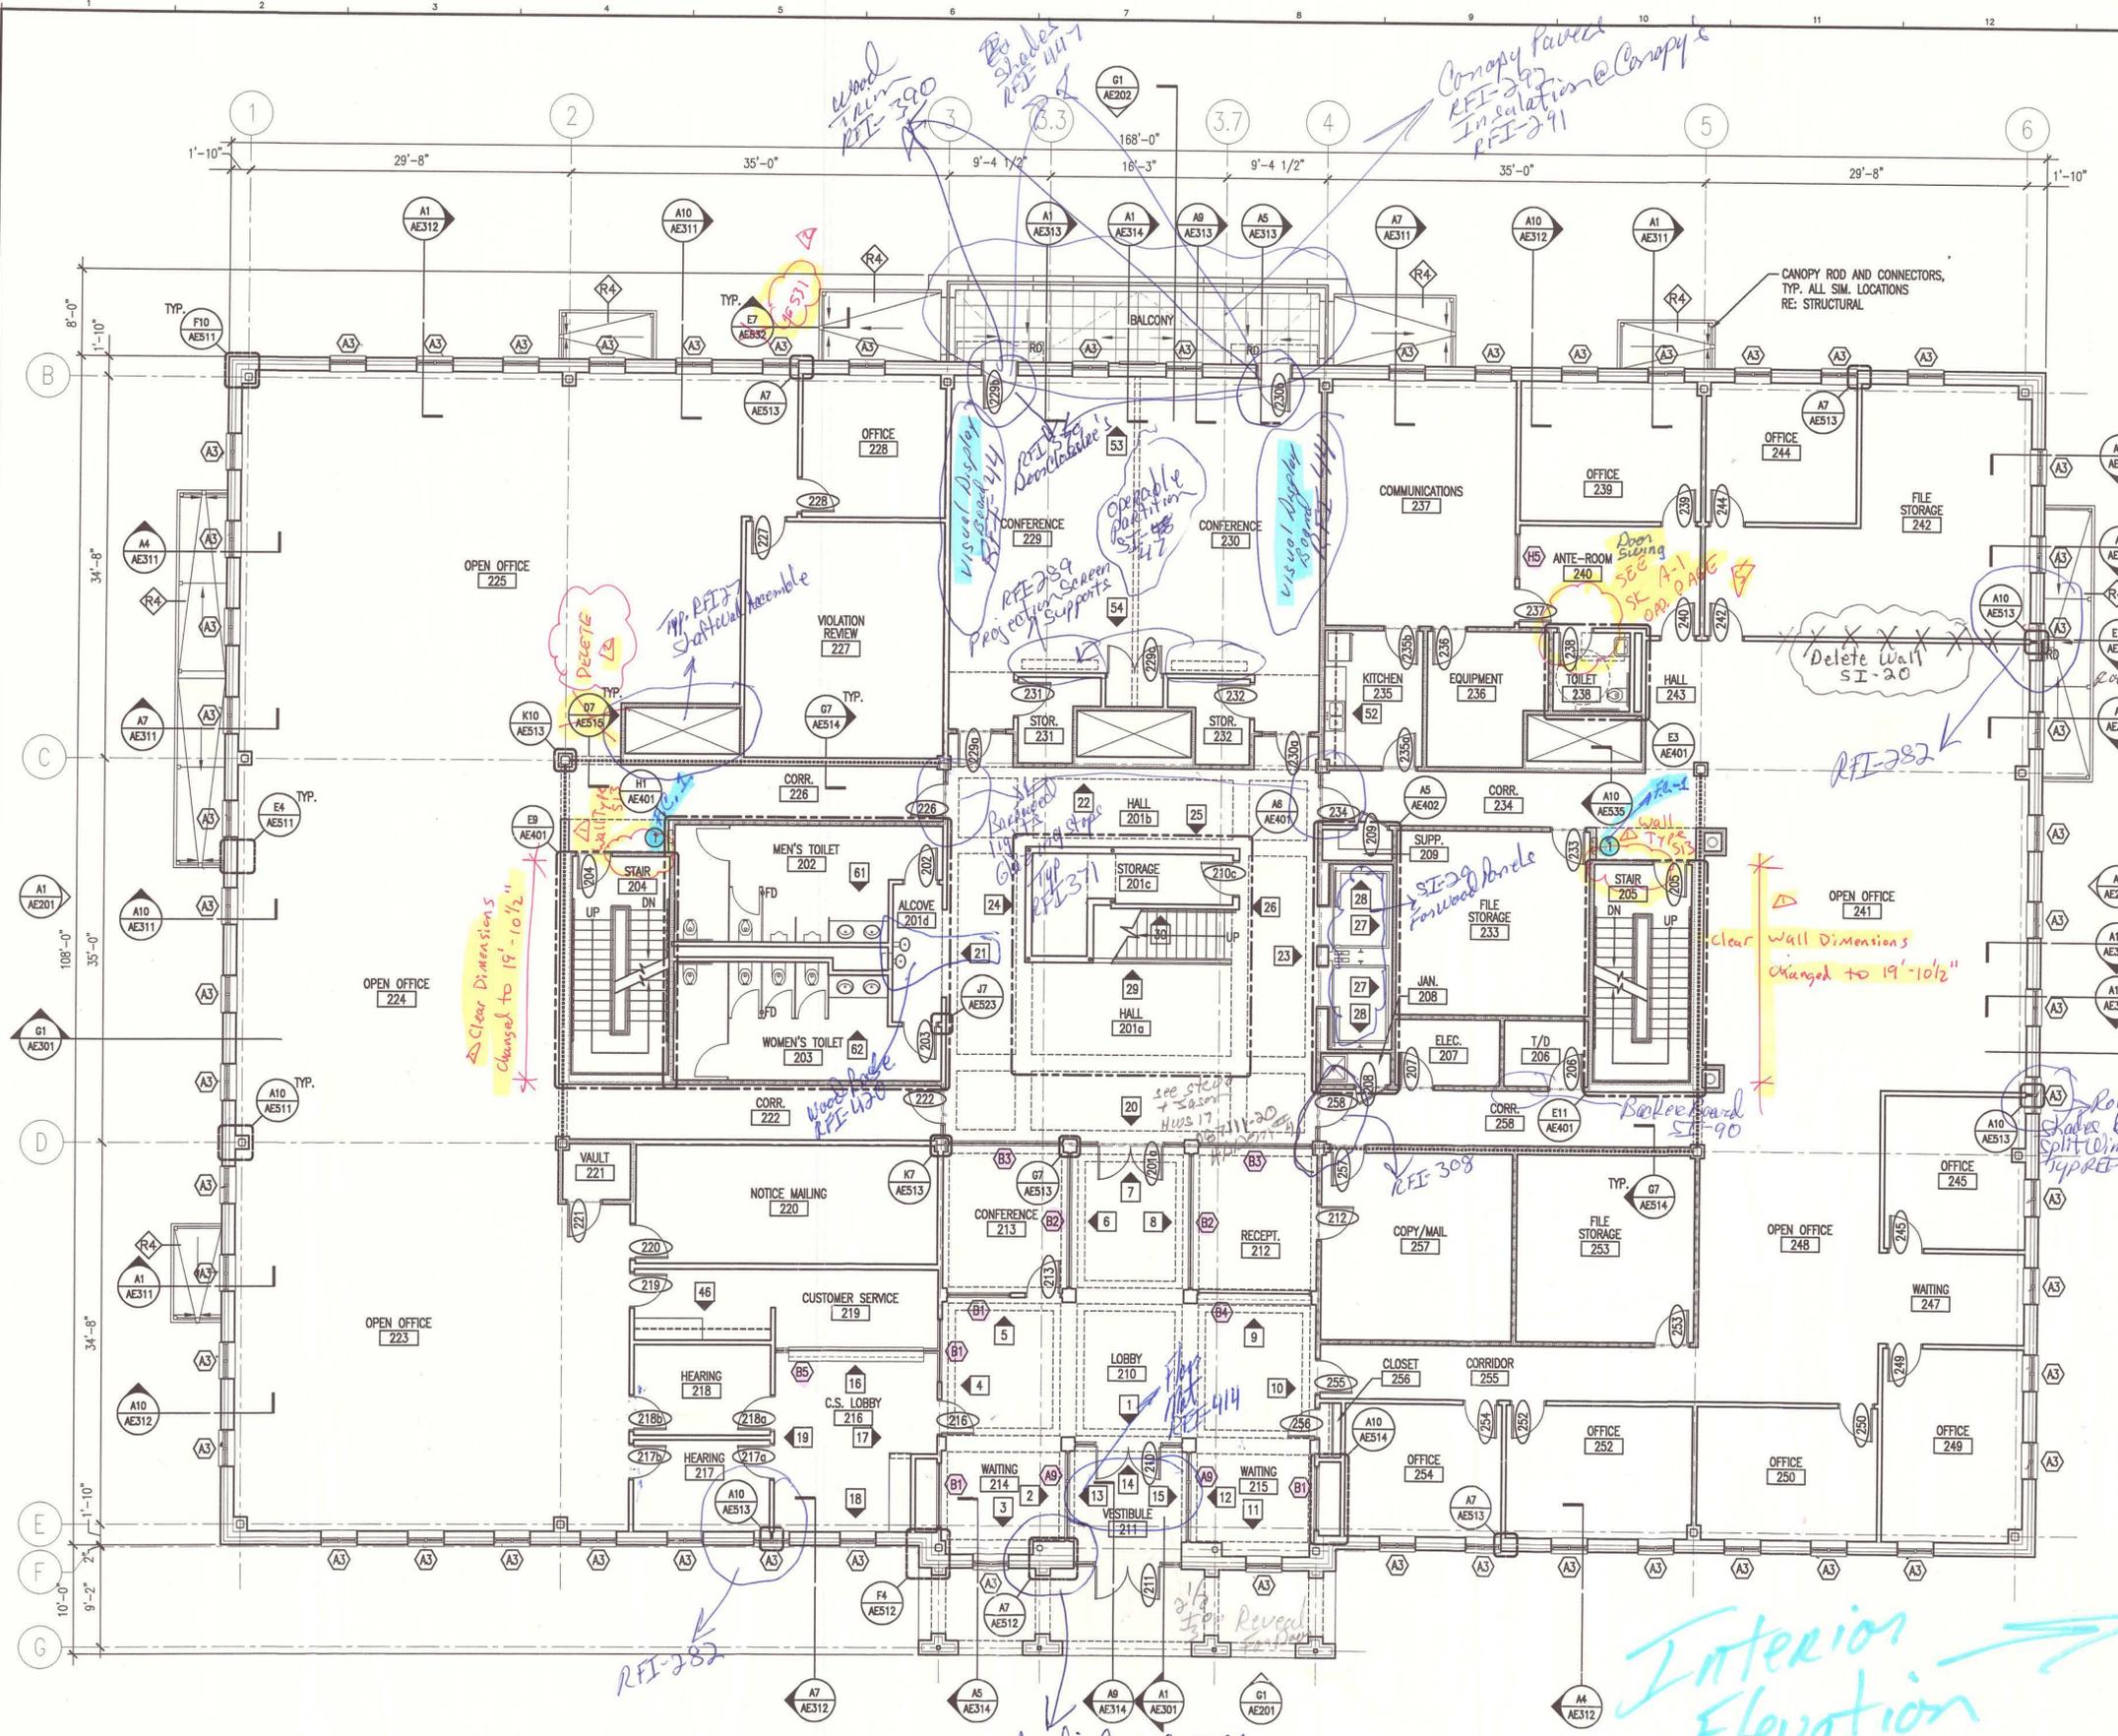

GENERAL NOTES:

1. SEE G101 FOR PROJECT GENERAL NOTES.

FLOOR PLAN NOTES:

- 1. REFER TO AE00 SERIES DRAWINGS FOR WINDOW AND DOOR TYPES.
- 2. REFER TO AE112 FOR PARTITION TYPES AND PARTITION LOCATION.

KEY NOTES:

- ① FIRE EXTINGUISHER FE-1
- ② FIRE EXTINGUISHER FE-2
- ③ REFRIGERATOR
- ④ ICE MAKER
- ⑤ LOCKERS
- ⑥ VENDING MACHINE, N.I.C.
- ⑦ WIRE MESH PARTITIONS
- ⑧ WALL MOUNTED EYE WASH
- ⑨ EYE WASH/EMERGENCY SHOWER
- ⑩ SLOP SINK W/ MOP RACK
- ⑪ HOUSEKEEPING PADS, RE: STRUCT.
- ⑫ COFFEE MAKER, N.I.C.
- ⑬ BULLETIN BOARD CABINET
- ⑭ AUTOMATED TELLER MACHINE, N.I.C.
- ⑮ FIXED BENCH
- ⑯ STEEL ROOF LADDER

AS BUILT
Owner Copy

INTERIOR ELEVATION SCHEDULE (X)

ELEVATION	ROOM NAME & NO.	WALL	ELEVATION REFERENCE
1	LOBBY 210	S	J1/AE211
2	WAITING 214	E	J1/AE211
3	WAITING 214	S	J1/AE211
4	LOBBY 210/WAITING 214	W	J1/AE211
5	LOBBY 210	N	E1/AE211
6	LOBBY 210	W	E1/AE211
7	LOBBY 210	N	E1/AE211
8	LOBBY 210	E	E1/AE211
9	LOBBY 210	N	E1/AE211
10	LOBBY 210/WAITING 214	E	A1/AE211
11	WAITING 215	S	J1/AE211
12	WAITING 215	W	J1/AE211
13	VESTIBULE 211	W	A6/AE211
14	VESTIBULE 211	N	A6/AE211
15	VESTIBULE 211	E	A6/AE211
16	C.S. LOBBY 216	N	J1/AE212
17	C.S. LOBBY 216	E	J1/AE212
18	C.S. LOBBY 216	S	J1/AE212
19	C.S. LOBBY 216	W	E1/AE212
20	HALL 201a	S	E6/AE212
21	HALL 201a	W	A1/AE212
22	HALL 201b	N	A8/AE212
23	HALL 201a	E	J1/AE213
24	HALL 201a	E	J1/AE213
25	HALL 201b	S	E1/AE213
26	HALL 201a	W	EB/AE213
27	ELEVATOR	E	A1/AE213
28	ELEVATOR	N.S	A1/AE213
29	HALL 201a	N	J1/AE214
30	HALL 201a	N	J1/AE214
46	CUSTOMER SERVICE 219	S	J9/AE218
52	KITCHEN 235	W	A9/AE218
53	CONFERENCE 229 & 230	N	J1/AE219
54	CONFERENCE 229 & 230	S	J1/AE219
61	MEN'S TOILET 202	S	E1/AE220
62	WOMEN'S TOILET 203	N	E6/AE220



ARCHITECTURE ENGINEERING PLANNING
144 Fore Street P.O. Box 618
Portland, Maine 04104
tel. (207) 772-3946
fax. (207) 772-1070



PROJECT TITLE:
**MAINE TURNPIKE AUTHORITY
ADMINISTRATION BUILDING**
PORTLAND, MAINE

ISSUED FOR BIDDING/CONSTRUCTION
7-9-07

REV	DESCRIPTION	DATE
0	BIDDING/CONSTRUCTION	7-9-07

GRAPHIC SCALE:
0" = 1"



SCALE: AS NOTED
PROJECT MANAGER: SLB
JC/DRAWN BY: TCM/TCM
A/E OF RECORD: SLB
CAD FILE: AE102-06016
PROJECT NO: 06016
DATE: 7-9-07

SHEET TITLE:
SECOND FLOOR PLAN

SHEET NO:
AE102

A1 SECOND FLOOR PLAN



1/8" = 1'-0"

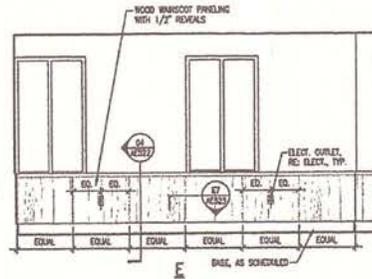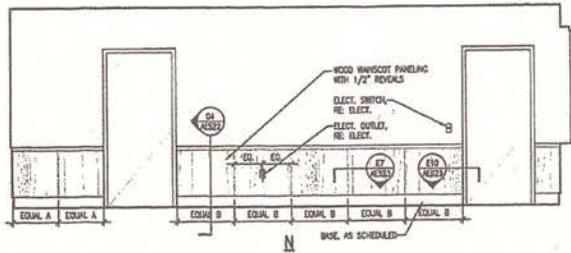

Rm # 346





GENERAL NOTES:
1. SEE 0201 FOR PROJECT GENERAL NOTES.

J1 INTERIOR ELEVATION - OFFICE 346
3/8" = 1'-0"

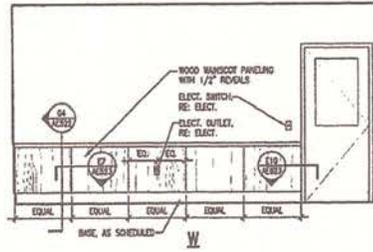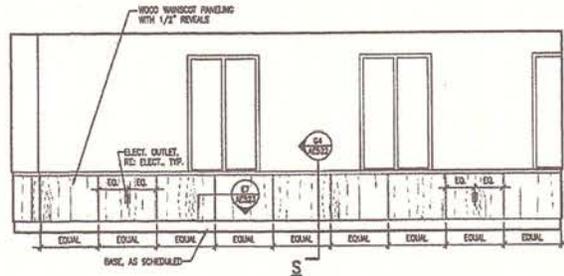

Rm # 346

E1 INTERIOR ELEVATION - OFFICE 346
3/8" = 1'-0"

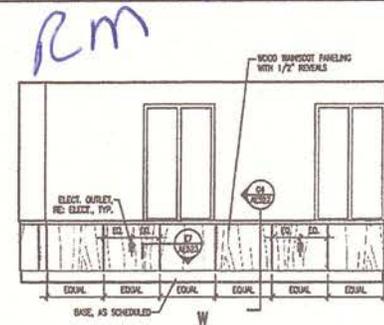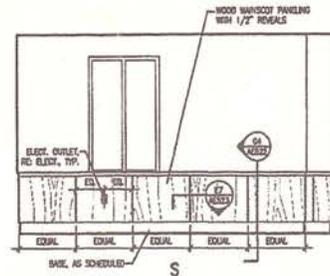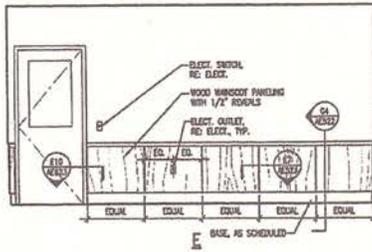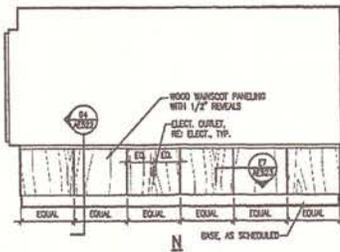

Rm

#320

A1 INTERIOR ELEVATION - OFFICE 320
3/8" = 1'-0"

SM RT


ARCHITECTURE ENGINEERING PLANNING
SMRT
144 Park Street, 9th Floor
Portland, Maine 04101
Tel: (207) 777-8800

MAINE TURNPIKE AUTHORITY
ADMINISTRATION BUILDING
PORTLAND, MAINE
ISSUED FOR BIDDING/CONSTRUCTION
7-9-07

PROJECT TITLE	MAINE TURNPIKE AUTHORITY ADMINISTRATION BUILDING
CURRENT ISSUE NUMBER	ISSUED FOR BIDDING/CONSTRUCTION
DATE	7-9-07
PROJECT NO.	AC221-08018
DATE	7-9-07
DRAWN BY	
CHECKED BY	
DATE	

GRAPHIC SCALE
SCALE: AS NOTED
PROJECT MANAGER: SLB
ARCHITECT: SMRT
DATE OF RECORDING: SLB
JOB FILED: AC221-08018
PROJECT NO.: 88018
DATE: 7-9-07
SHEET TITLE: INTERIOR ELEVATIONS

SHEET NO. AE221

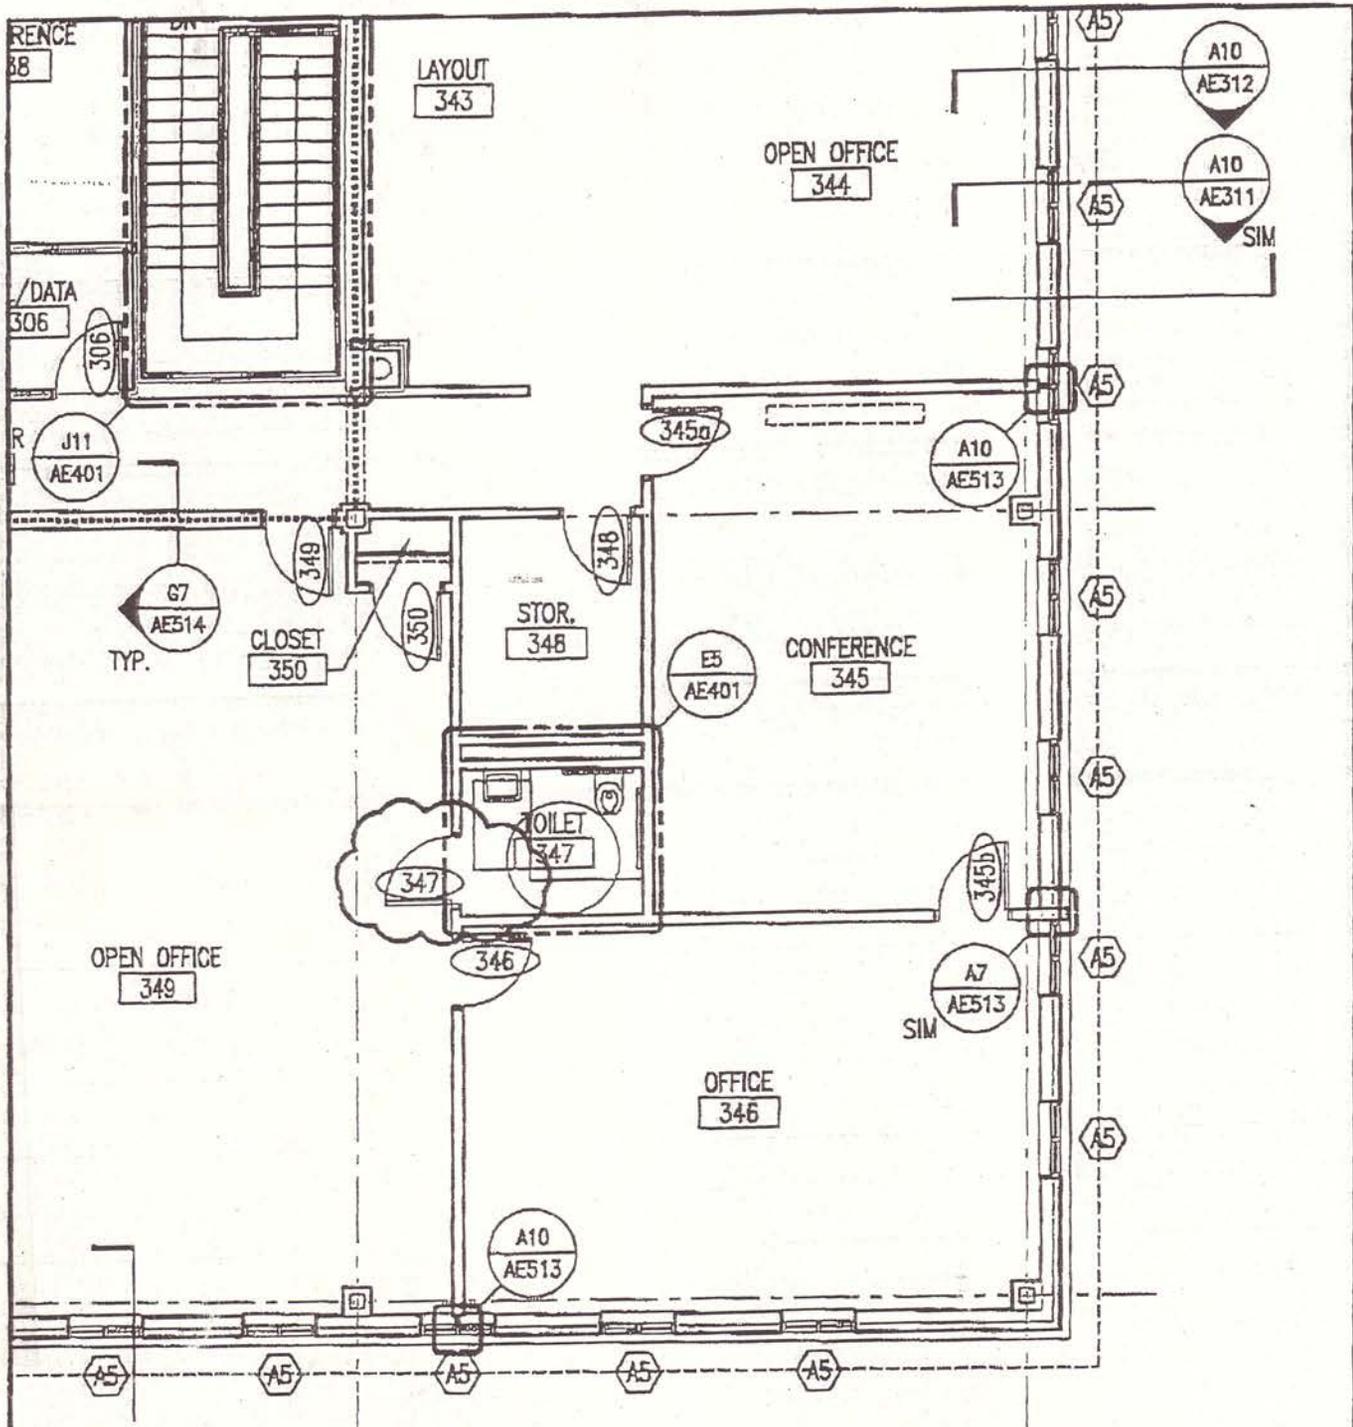

ARCHITECTURE ENGINEERING PLANNING

SMRT

144 Fore Street/P.O. Box 618 PORTLAND, MAINE 04104
tel. (207) 772-3846 / fax. (207) 772-1070

SCALE: 1/8"=1'-0"

CAD FILE: AE103-06016

PROJECT No. 06016

REF. SHEET: AE103

PM: SLB

ADD-DRAW. NO. **ADD-5**


A/E: SLB

DISTCH. NO. **A-2**

DATE: 8-17-07

© COPYRIGHT 2007 SMRT INC.

PROJECT: MAINE TURNPIKE AUTHORITY
ADMINISTRATION BUILDING
SUBJECT: REVISED DOOR SWING AT TOILET 347
THIRD FLOOR PLAN

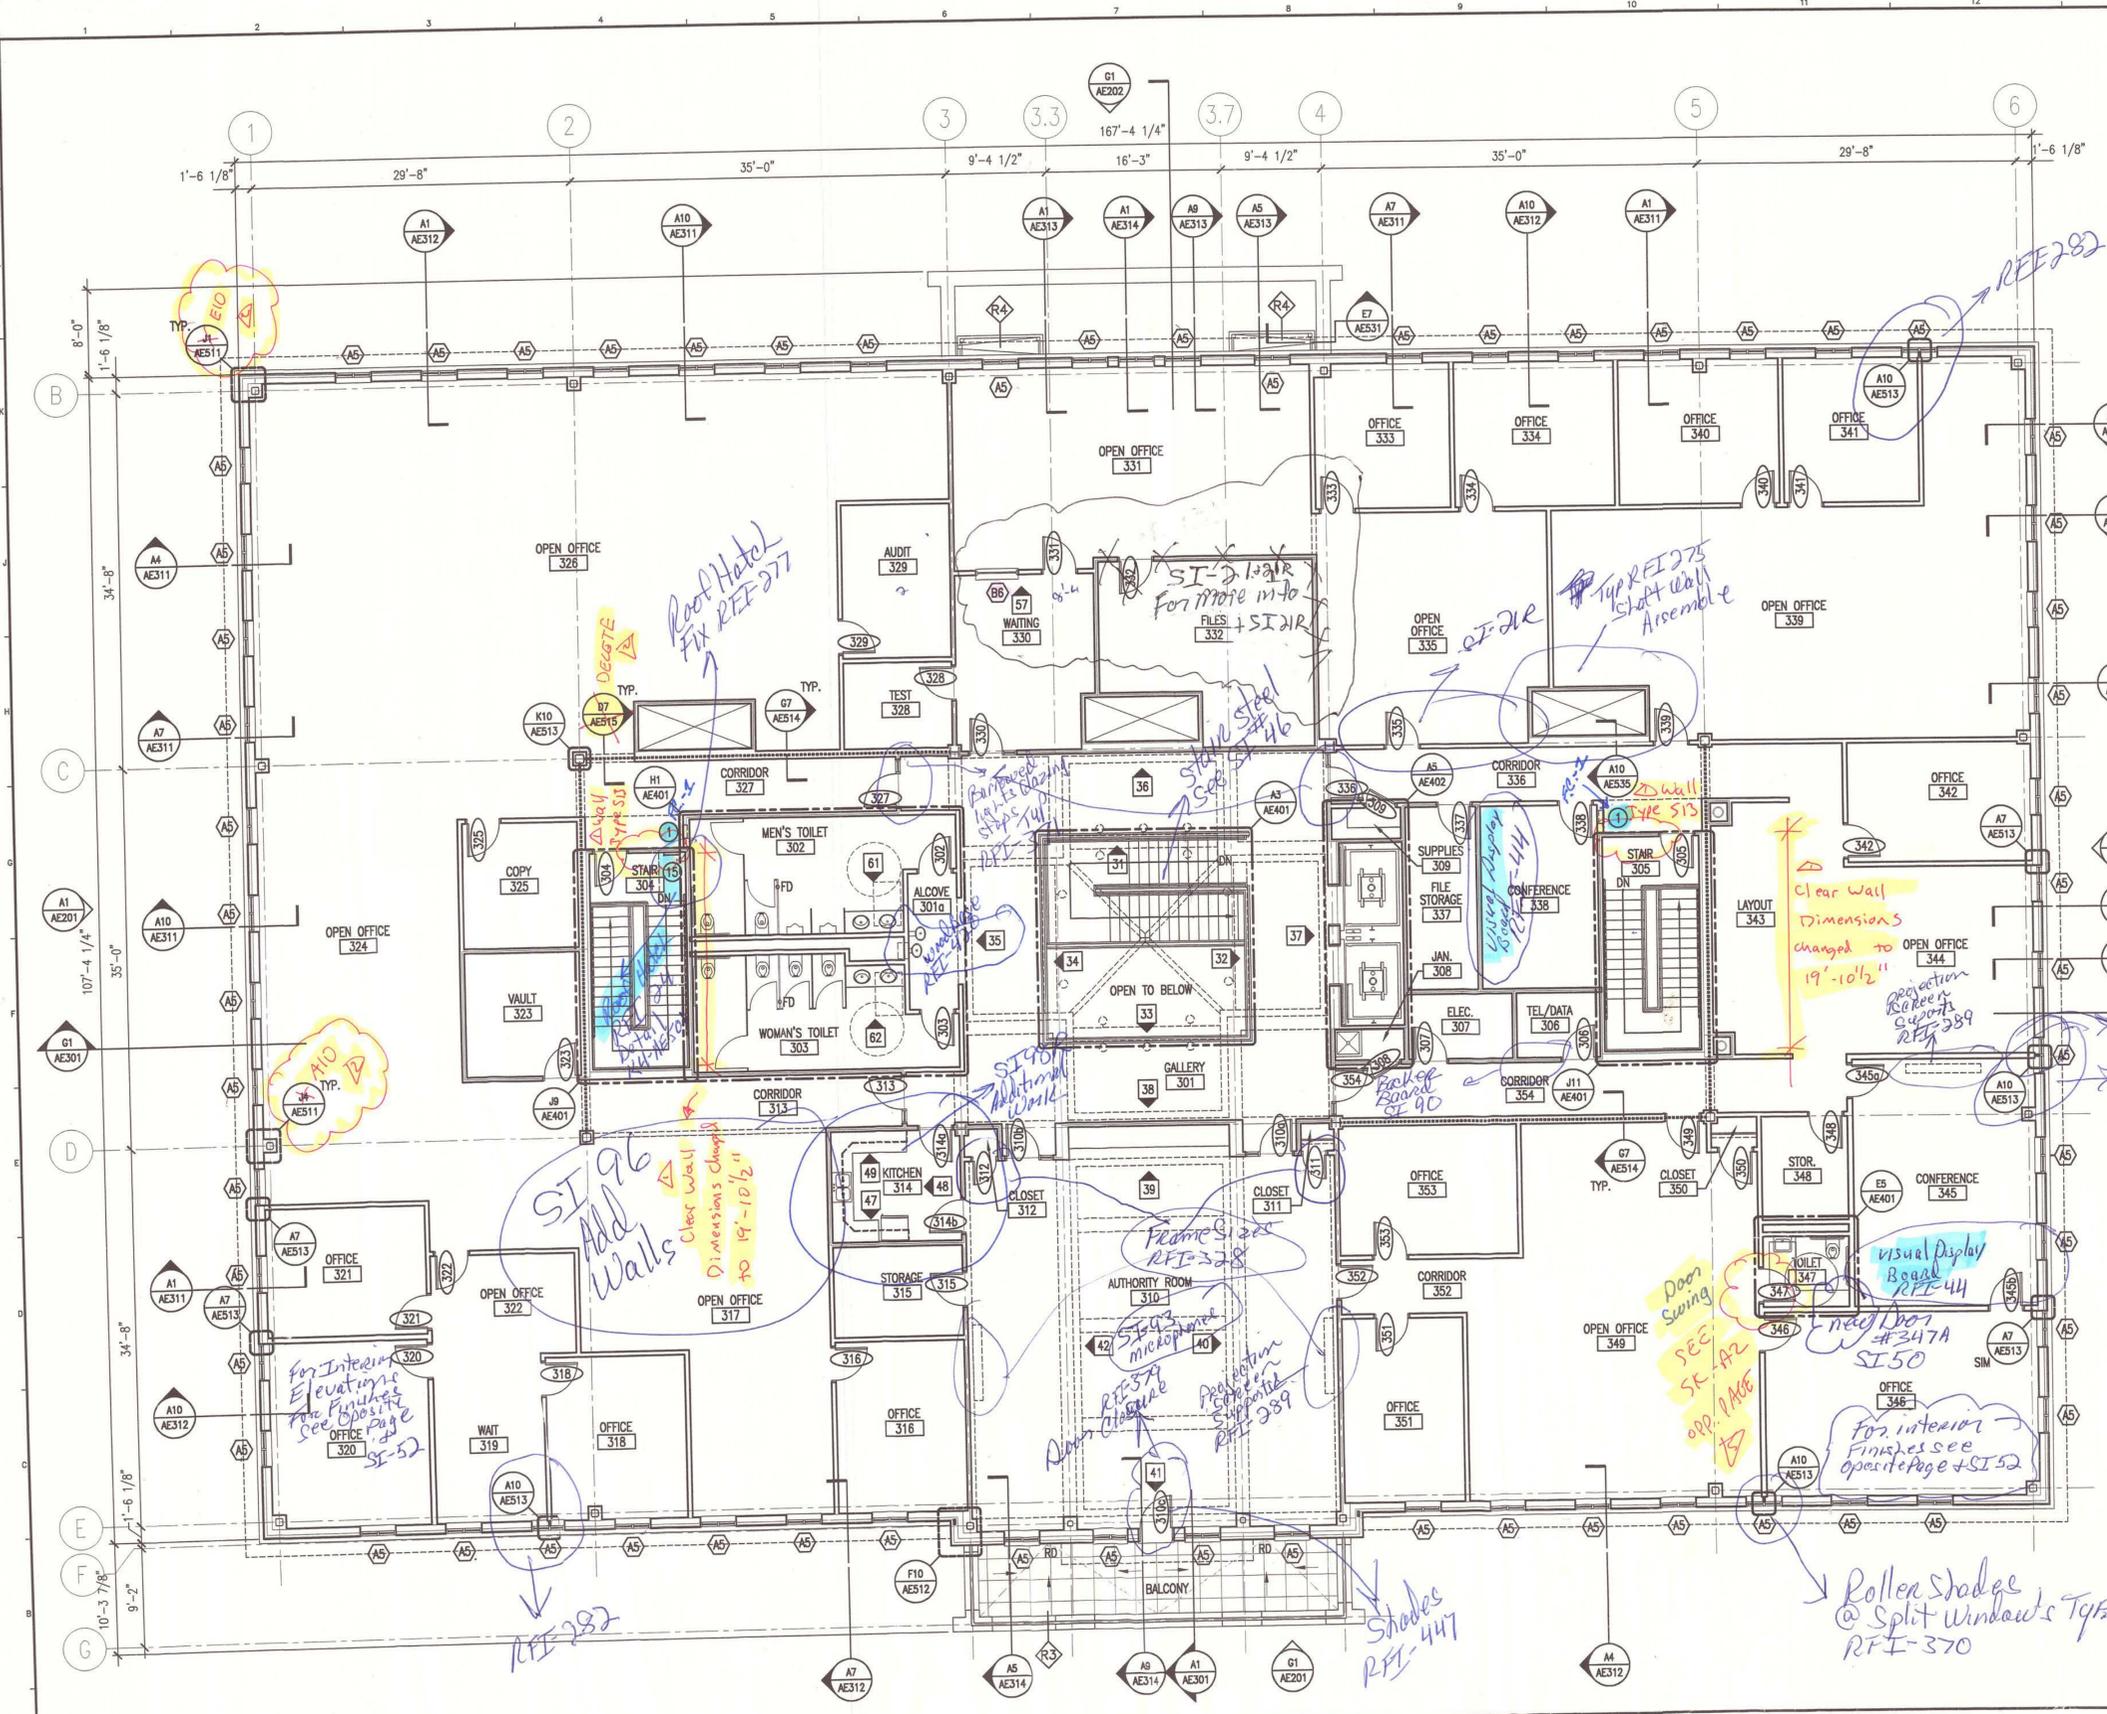


- GENERAL NOTES:**
 1. SEE G101 FOR PROJECT GENERAL NOTES.
- FLOOR PLAN NOTES:**
 1. REFER TO AE800 SERIES DRAWINGS FOR WINDOW AND DOOR TYPES.
 2. REFER TO AE113 FOR PARTITION TYPES & PARTITION LOCATIONS.
- KEY NOTES:**
- ① FIRE EXTINGUISHER FE-1
 - ② FIRE EXTINGUISHER FE-2
 - ③ REFRIGERATOR
 - ④ ICE MAKER
 - ⑤ LOCKERS
 - ⑥ VENDING MACHINE, N.I.C.
 - ⑦ WIRE MESH PARTITIONS
 - ⑧ WALL MOUNTED EYE WASH
 - ⑨ EYE WASH/EMERGENCY SHOWER
 - ⑩ SLOP SINK W/ MOP RACK
 - ⑪ HOUSEKEEPING PADS, RE-STRUCT.
 - ⑫ COFFEE MAKER, N.I.C.
 - ⑬ BULLETIN BOARD CABINET
 - ⑭ AUTOMATED TELLER MACHINE, N.I.C.
 - ⑮ FIXED BENCH
 - ⑯ STEEL ROOF LADDER

AS BUILT
Owner Copy

INTERIOR ELEVATION SCHEDULE (X)

ELEVATION	ROOM NAME & NO.	WALL	ELEVATION REFERENCE
31	GALLERY 301	N	A1/AE214
32	GALLERY 301	E	A1/AE214
33	GALLERY 301	S	J6/AE215
34	GALLERY 301	W	A6/AE215
35	GALLERY 301	W	J1/AE216
36	GALLERY 301	N	J1/AE216
37	GALLERY 301	E	A1/AE216
38	GALLERY 301	S	A1/AE216
39	AUTHORITY ROOM 310	N	J1/AE217
40	AUTHORITY ROOM 310	E	J1/AE217
41	AUTHORITY ROOM 310	S	A1/AE217
42	AUTHORITY ROOM 310	W	A1/AE217
47	KITCHEN 314	S	E1/AE218
48	KITCHEN 314	W	E1/AE218
49	KITCHEN 314	N	E1/AE218
61	MEN'S TOILET 302	S	E1/AE220
62	WOMEN'S TOILET 303	N	E9/AE220

SI 57 Waiting 330 N E9/AE219

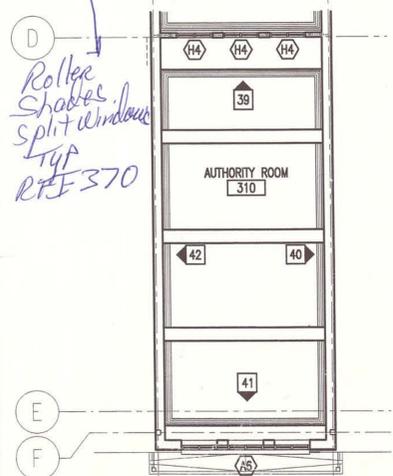

SM RT

ARCHITECTURE ENGINEERING PLANNING
 SHIRT
 144 Fore Street/P.O. Box 618
 Portland, Maine 04104
 Tel. (207) 772-3846
 Fax. (207) 772-1070

STATE OF MAINE
 SCOTT L. BENSON
 No. 1772
 REGISTERED PROFESSIONAL ARCHITECT

PROJECT NORTH

PROJECT TITLE: MAINE TURNPIKE AUTHORITY ADMINISTRATION BUILDING
 PORTLAND, MAINE
 CURRENT ISSUE STATUS:
 ISSUED FOR BIDDING/CONSTRUCTION
 7-9-07

REV	DESCRIPTION	DATE
0	BIDDING/CONSTRUCTION	7-9-07

GRAPHIC SCALE:
 0" = 1"


SCALE: AS NOTED
 PROJECT MANAGER: SLB
 JC/DRAWN BY: TCM/TCM
 A/E OF RECORD: SLB
 CAD FILE: AE103-06016
 PROJECT NO: 06016
 DATE: 7-9-07
 SHEET TITLE: THIRD FLOOR PLAN
 SHEET No. AE103

A1 THIRD FLOOR PLAN

A13 CLERESTORY PLAN

1/8" = 1'-0"


1/8" = 1'-0"

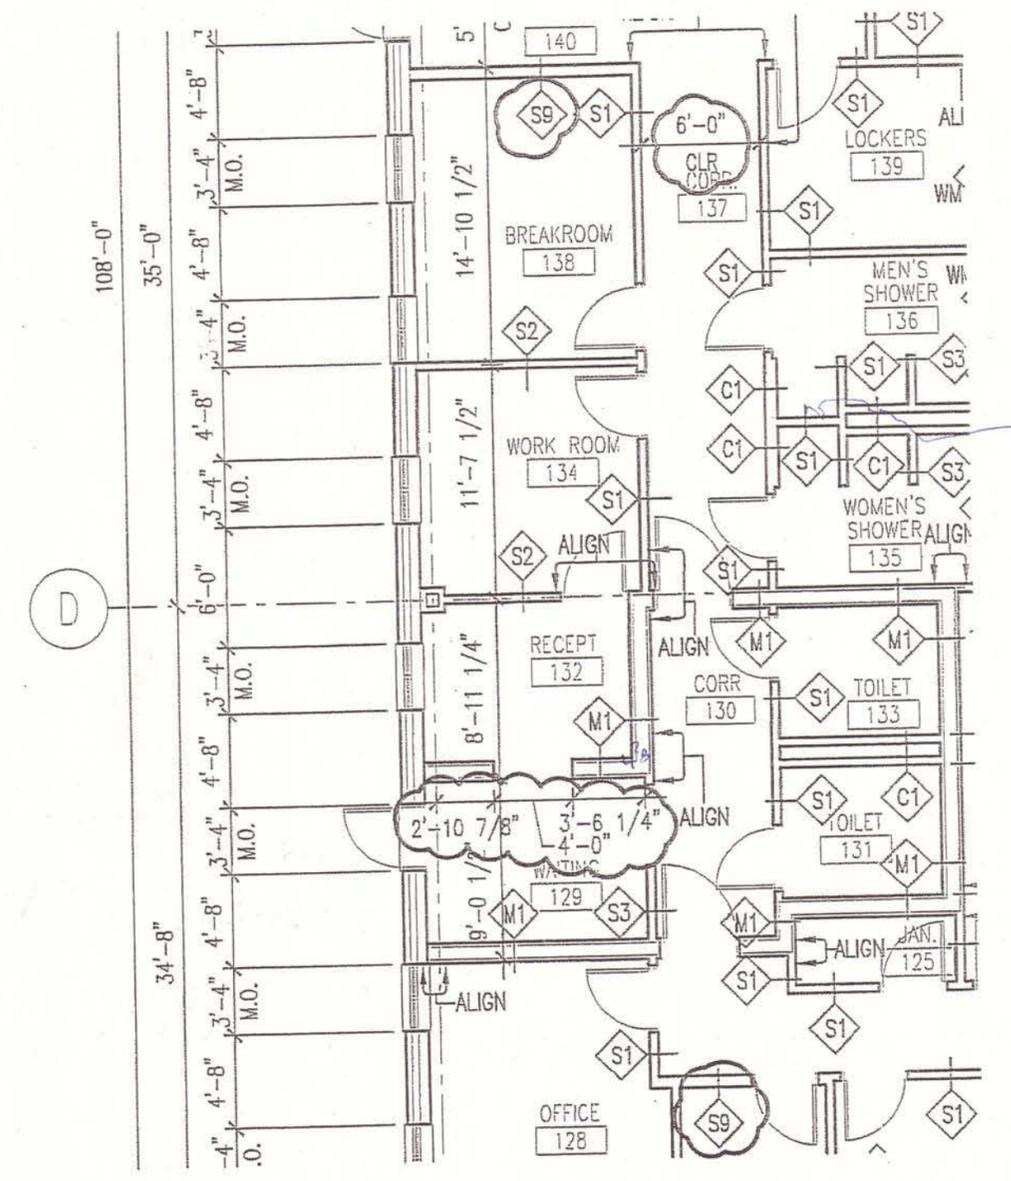


ARCHITECTURE ENGINEERING PLANNING
 SMRT
 144 Fore Street/P.O. Box 618 PORTLAND, MAINE 04104
 tel. (207) 772-3846 / fax. (207) 772-1070

PROJECT: MAINE TURNPIKE AUTHORITY
 ADMINISTRATION BUILDING
 SUBJECT: FIRST FLOOR LAYOUT PLAN
 REVISIONS AS NOTED

SCALE:	1/8" = 1'-0"
CAD FILE:	AE111-06016
PROJECT No.	06016
REF. SHEET:	AE111
PM:	SLB
A/E:	SLB
DATE:	8-10-07
ADDENDUM No.	ADD-4
SKETCH No.	A-2

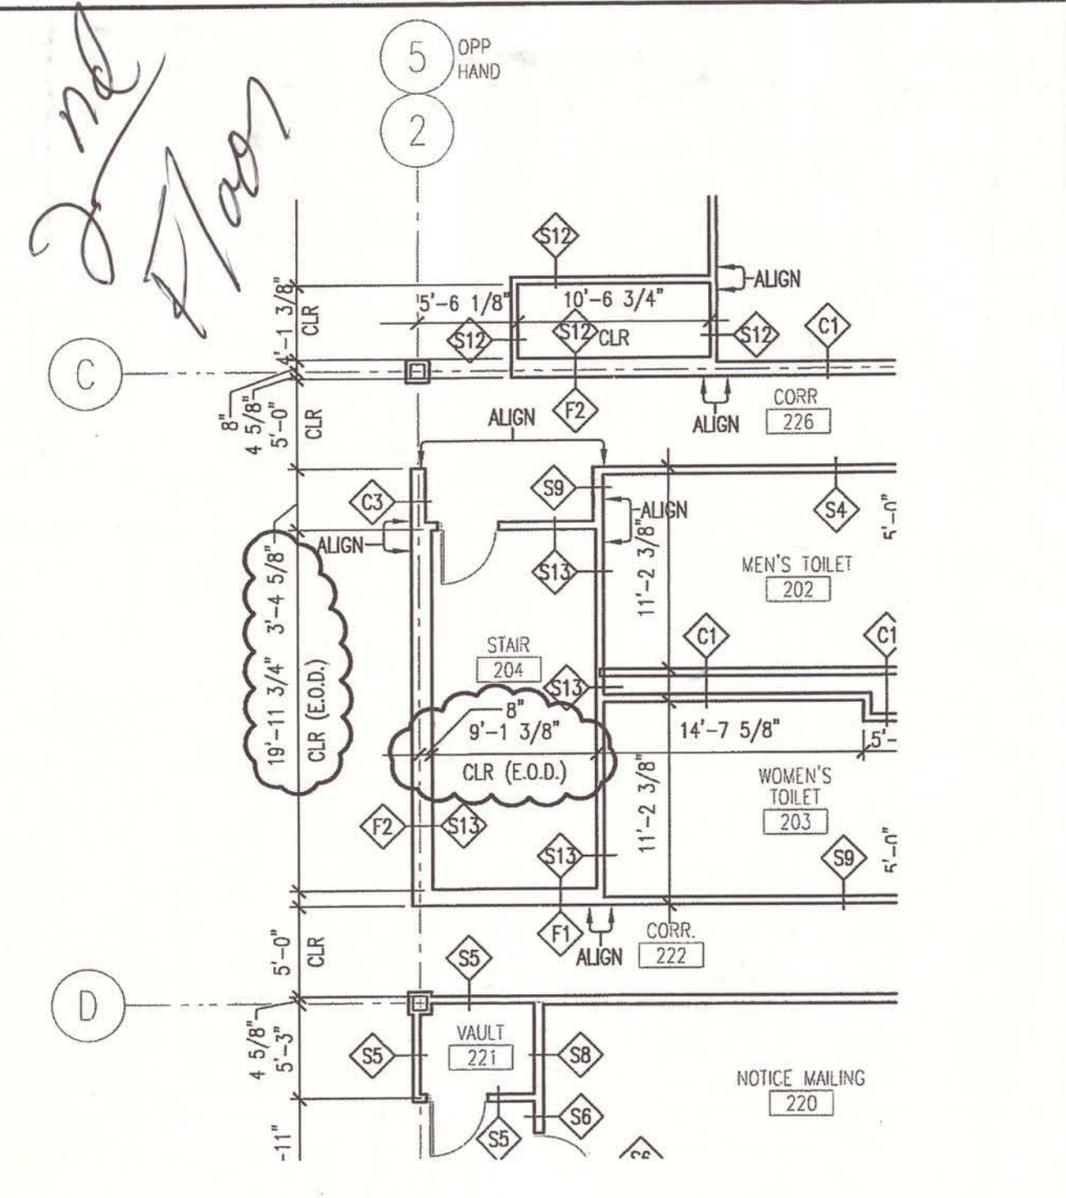

SM RT	ARCHITECTURE ENGINEERING PLANNING	SCALE: 1/8" = 1'-0"
	SMRT 144 Fore Street/P.O.Box 618 PORTLAND, MAINE 04104 tel. (207) 772-3846 / fax. (207) 772-1070	CAD FILE: AE112-06016
PROJECT: MAINE TURNPIKE AUTHORITY ADMINISTRATION BUILDING		PROJECT No. 06016
SUBJECT: REVISED DIMENSIONS @ STAIR SHAFTS STAIRS 104,204,304 & 105,205,305(OPP. HAND)		REF. SHEET: AE111-AE113
		PM: SLB A/E: SLB DATE:
		SUPPLEMENTAL INSTRUCTION RFI 81-170 SKETCH No. A-1 © COPYRIGHT 2008 SMRT INC.

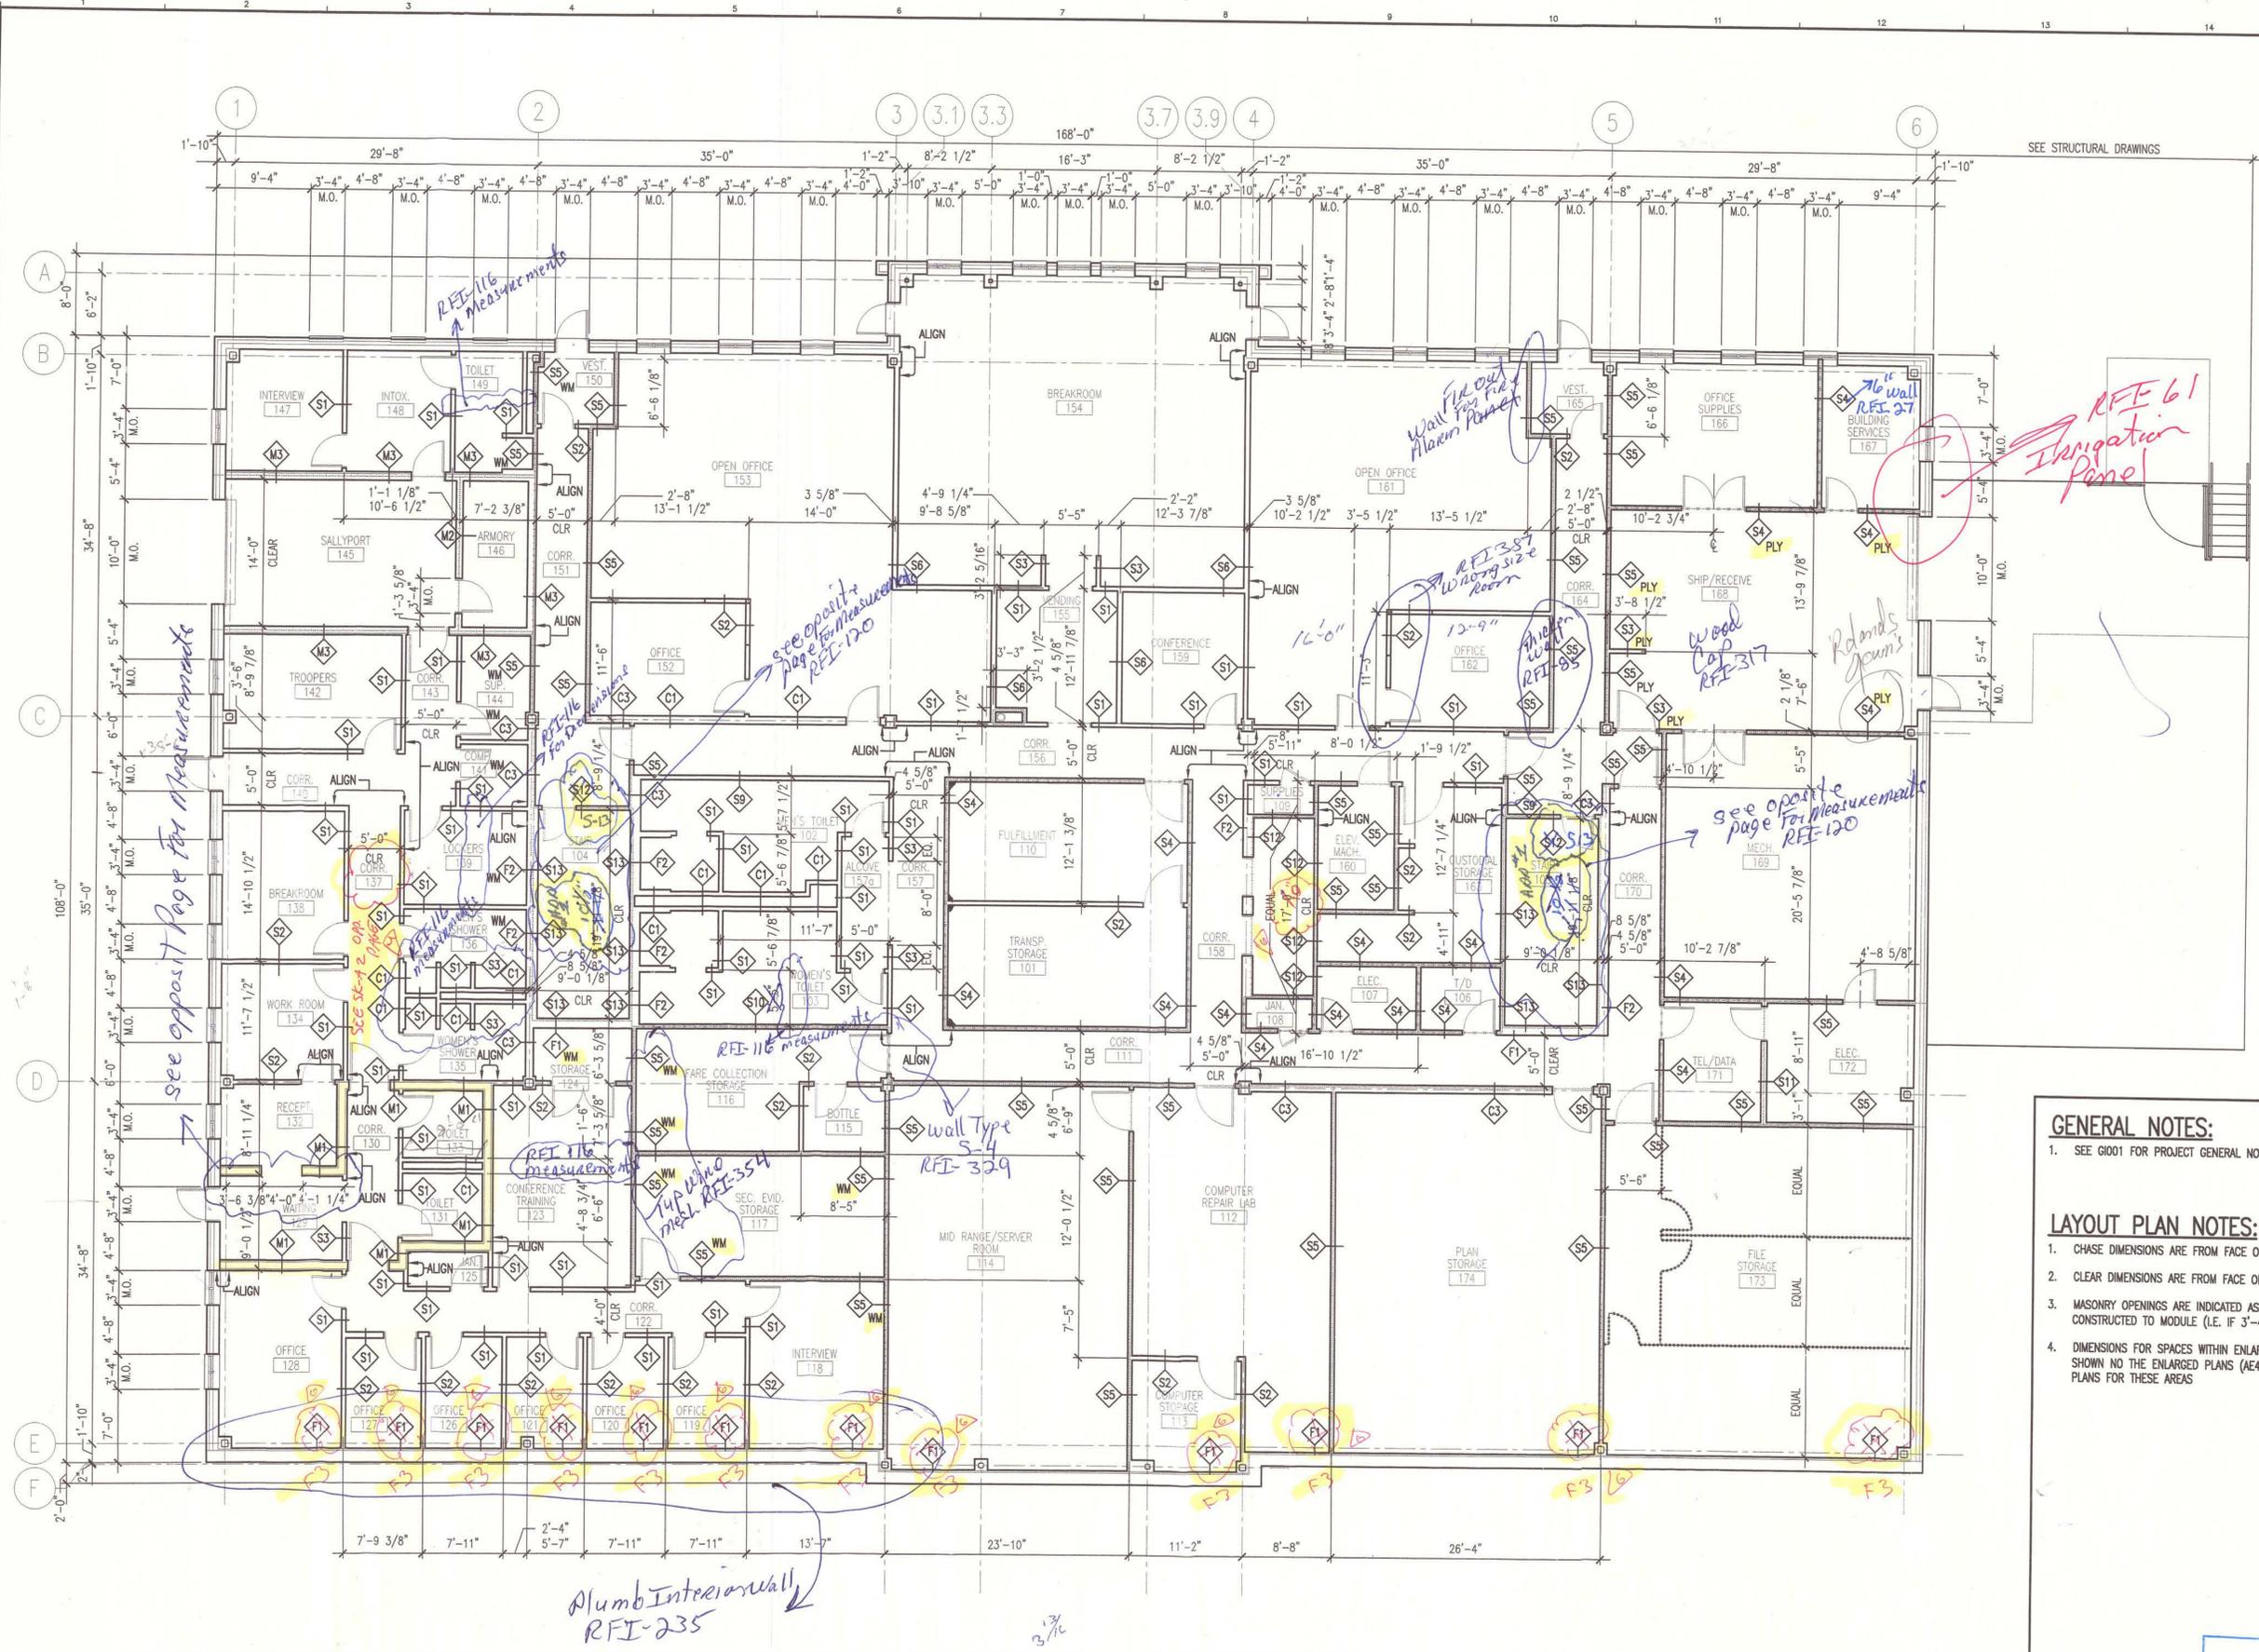

SEE STRUCTURAL DRAWINGS

GENERAL NOTES:

- SEE G001 FOR PROJECT GENERAL NOTES.


LAYOUT PLAN NOTES:

- CHASE DIMENSIONS ARE FROM FACE OF SUBSTRATE BOARD
- CLEAR DIMENSIONS ARE FROM FACE OF SUBSTRATE BOARD
- MASONRY OPENINGS ARE INDICATED AS NOMINAL AND SHALL BE CONSTRUCTED TO MODULE (I.E. IF 3'-4", M.O. = 3'-4 3/8")
- DIMENSIONS FOR SPACES WITHIN ENLARGED PLAN AREAS ARE SHOWN ON THE ENLARGED PLANS (AE400 SERIES) RE: FLOOR PLANS FOR THESE AREAS

AS BUILT
Owner Copy



ARCHITECTURE ENGINEERING PLANNING
SMRT
144 Fore Street P.O. Box 618
Portland, Maine 04104
tel. (207) 772-3846
fax. (207) 772-1070

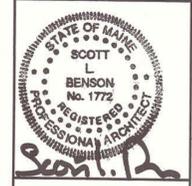

PROJECT TITLE:
**MAINE TURNPIKE AUTHORITY
ADMINISTRATION BUILDING**
PORTLAND, MAINE

CURRENT ISSUE STATUS:
**ISSUED FOR BIDDING/CONSTRUCTION
7-9-07**

REV	DESCRIPTION	DATE
0	BIDDING/CONSTRUCTION	7-9-07

GRAPHIC SCALE:
0" = 1"


SCALE: AS NOTED
PROJECT MANAGER: SLB
JC/DRAWN BY: TCM/TCM
A/E OF RECORD: SLB
CAD FILE: AE111-06016
PROJECT No: 06016
DATE: 7-9-07

SHEET TITLE:
**FIRST FLOOR
LAYOUT PLAN**


SHEET No.
AE111

A1 FIRST FLOOR LAYOUT PLAN


1/8" = 1'-0"

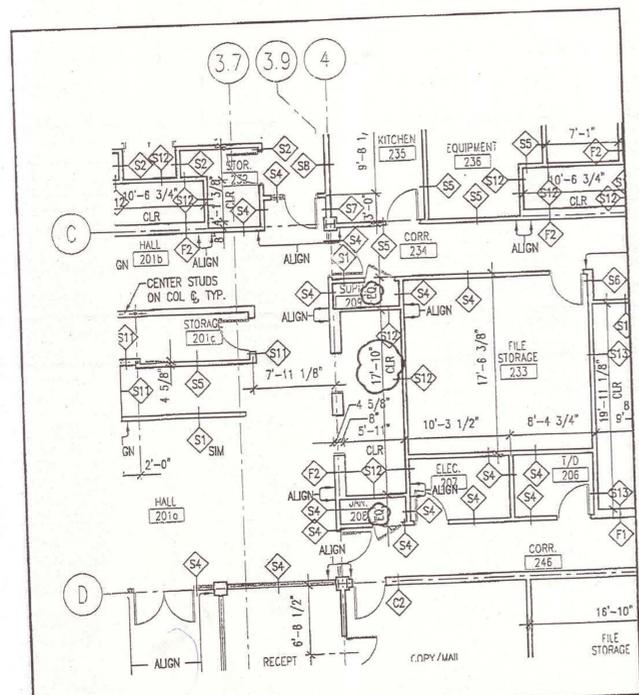


SM RT	ARCHITECTURE ENGINEERING PLANNING	SCALE: 1/8" = 1'-0"
	144 Fore Street/P.O. Box 618 PORTLAND, MAINE 04104 tel. (207) 772-3846 / fax. (207) 772-1070	CAD FILE: AE112-06016
PROJECT:	MAINE TURNPIKE AUTHORITY ADMINISTRATION BUILDING	PROJECT No. 06016
SUBJECT:	SECOND FLOOR LAYOUT PLAN REVISED AS NOTED	REF. SHEET: AE112
	PM: SLB	DATE: 8-23-07
	A/E: SLB	DATE: 8-23-07
	DATE: 8-23-07	DATE: 8-23-07

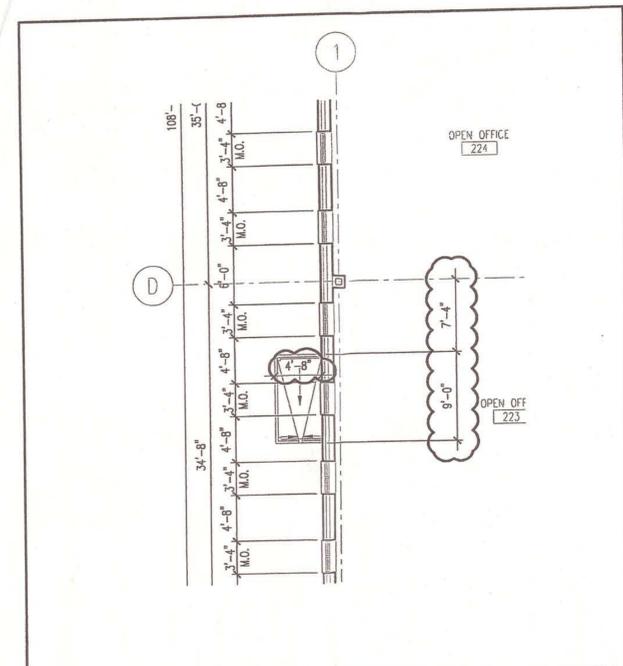


SM RT	ARCHITECTURE ENGINEERING PLANNING	SCALE: 1/8" = 1'-0"
	144 Fore Street/P.O. Box 618 PORTLAND, MAINE 04104 tel. (207) 772-3846 / fax. (207) 772-1070	CAD FILE: AE112-06016
PROJECT:	MAINE TURNPIKE AUTHORITY ADMINISTRATION BUILDING	PROJECT No. 06016
SUBJECT:	ADDED DIMENSIONS @ CANOPIES SECOND FLOOR LAYOUT PLAN	REF. SHEET: AE112
	PM: SLB	DATE: 3-11-08
	A/E: SLB	DATE: 3-11-08
	DATE: 3-11-08	DATE: 3-11-08

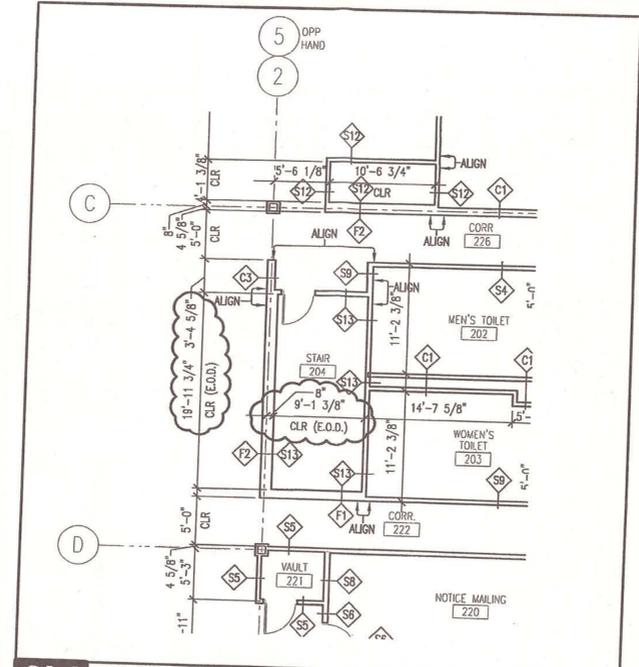

SM RT	ARCHITECTURE ENGINEERING PLANNING	SCALE: 1/8" = 1'-0"
	144 Fore Street/P.O. Box 618 PORTLAND, MAINE 04104 tel. (207) 772-3846 / fax. (207) 772-1070	CAD FILE: AE112-06016
PROJECT:	MAINE TURNPIKE AUTHORITY ADMINISTRATION BUILDING	PROJECT No. 06016
SUBJECT:	REVISED DIMENSIONS @ STAIR SHAFTS STAIRS 104,204,304 & 105,205,305(OPP. HAND)	REF. SHEET: AE111-AE113
	PM: SLB	DATE: 3-11-08
	A/E: SLB	DATE: 3-11-08
	DATE: 3-11-08	DATE: 3-11-08

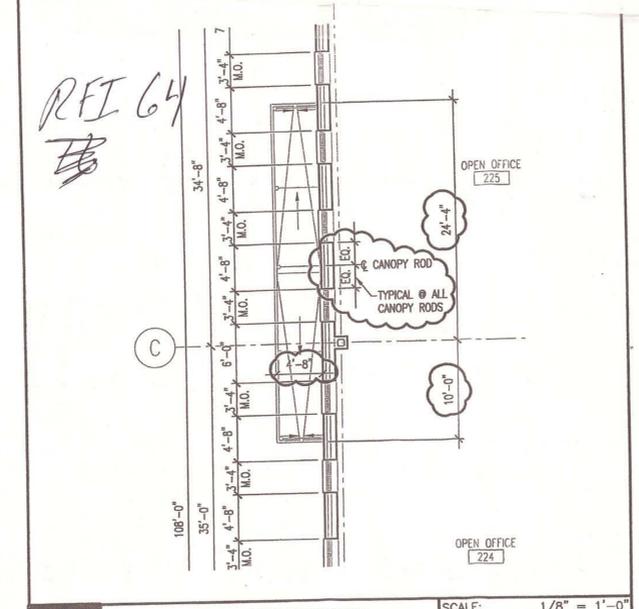

SM RT	ARCHITECTURE ENGINEERING PLANNING	SCALE: 1/8" = 1'-0"
	144 Fore Street/P.O. Box 618 PORTLAND, MAINE 04104 tel. (207) 772-3846 / fax. (207) 772-1070	CAD FILE: AE112-06016
PROJECT:	MAINE TURNPIKE AUTHORITY ADMINISTRATION BUILDING	PROJECT No. 06016
SUBJECT:	ADDED DIMENSIONS @ CANOPIES SECOND FLOOR LAYOUT PLAN	REF. SHEET: AE112
	PM: SLB	DATE: 3-11-08
	A/E: SLB	DATE: 3-11-08
	DATE: 3-11-08	DATE: 3-11-08

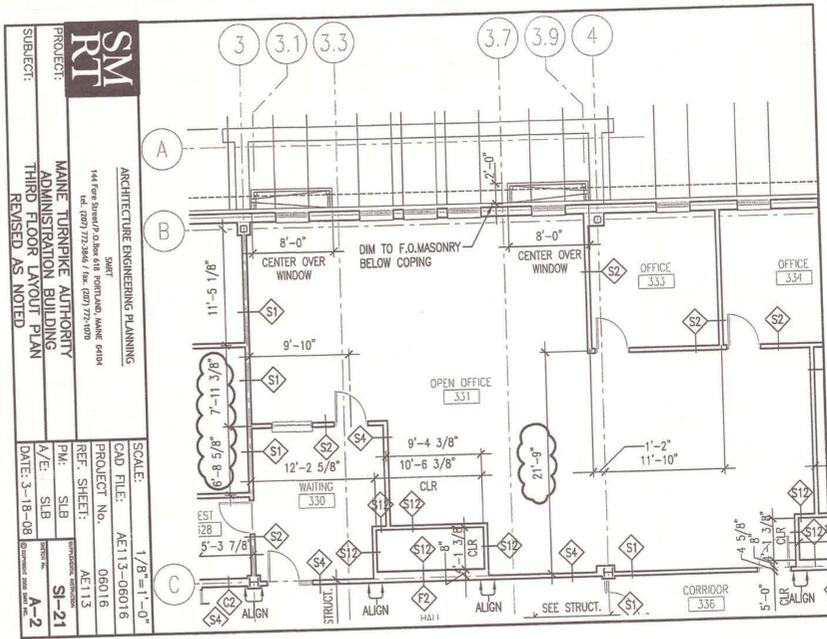


SM RT
 ARCHITECTURE ENGINEERING PLANNING
 144 Fore Street/P.O. Box 618 Portland, Maine 04104
 tel. (207) 772-3646 / fax. (207) 772-1070

PROJECT: MAINE TURNPIKE AUTHORITY ADMINISTRATION BUILDING
 SUBJECT: THIRD FLOOR LAYOUT PLAN
 REVISED AS NOTED

SCALE: 1/8" = 1'-0"
 CAD FILE: AE113-06016
 PROJECT No. 06016
 REF. SHEET: AE113
 PM: SLB
 A/E: SLB
 DATE: 3-18-08

SI-21
 A-2

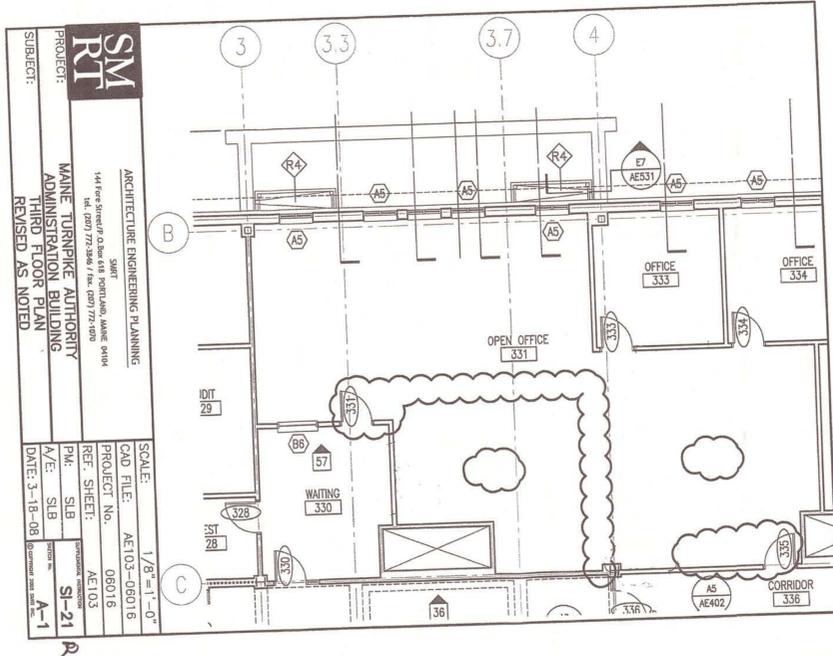


SM RT
 ARCHITECTURE ENGINEERING PLANNING
 144 Fore Street/P.O. Box 618 Portland, Maine 04104
 tel. (207) 772-3646 / fax. (207) 772-1070

PROJECT: MAINE TURNPIKE AUTHORITY ADMINISTRATION BUILDING
 SUBJECT: THIRD FLOOR LAYOUT PLAN
 REVISED AS NOTED

SCALE: 1/8" = 1'-0"
 CAD FILE: AE103-06016
 PROJECT No. 06016
 REF. SHEET: AE103
 PM: SLB
 A/E: SLB
 DATE: 3-18-08

SI-21
 A-1

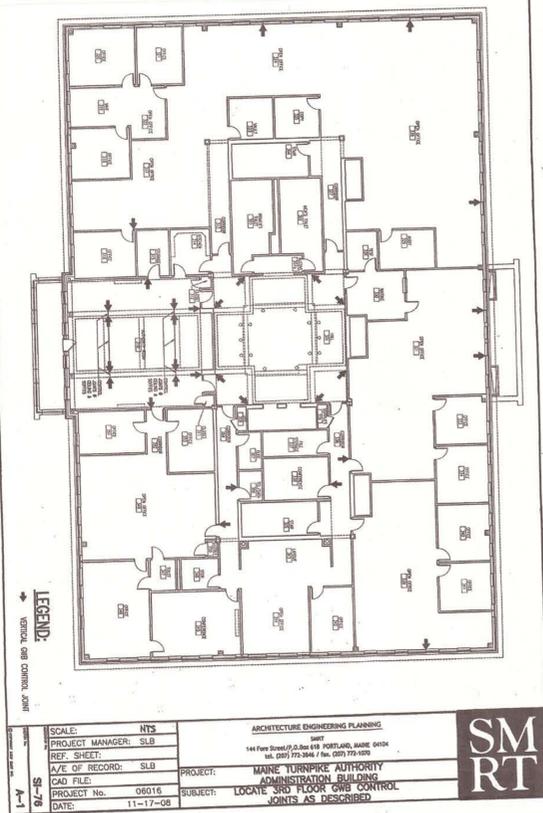

SM RT
 ARCHITECTURE ENGINEERING PLANNING
 144 Fore Street/P.O. Box 618 Portland, Maine 04104
 tel. (207) 772-3646 / fax. (207) 772-1070


PROJECT: MAINE TURNPIKE AUTHORITY ADMINISTRATION BUILDING
 SUBJECT: LOCATE 3RD FLOOR CMB CONTROL JOINTS AS DESCRIBED

SCALE: 1/8" = 1'-0"
 CAD FILE: AE103-06016
 PROJECT No. 06016
 REF. SHEET: AE103
 PM: SLB
 A/E: SLB
 DATE: 11-17-08

SI-21
 A-1

SI-21 Cont/Part 575
 1st Floor

AUG-24-2007 19:04 RADIO ROOM 12077566250 P.019/026

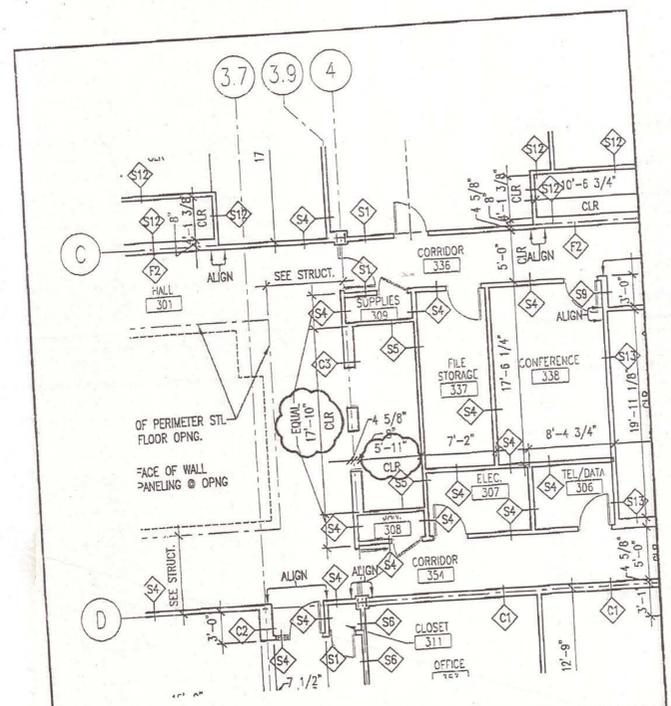


SM RT
 ARCHITECTURE ENGINEERING PLANNING
 144 Fore Street/P.O. Box 618 Portland, Maine 04104
 tel. (207) 772-3646 / fax. (207) 772-1070

PROJECT: MAINE TURNPIKE AUTHORITY ADMINISTRATION BUILDING
 SUBJECT: THIRD FLOOR LAYOUT PLAN
 REVISED AS NOTED

SCALE: 1/8" = 1'-0"
 CAD FILE: AE113-06016
 PROJECT No. 06016
 REF. SHEET: AE113
 PM: SLB
 A/E: SLB
 DATE: 8-23-07

ADD-6
 A-3

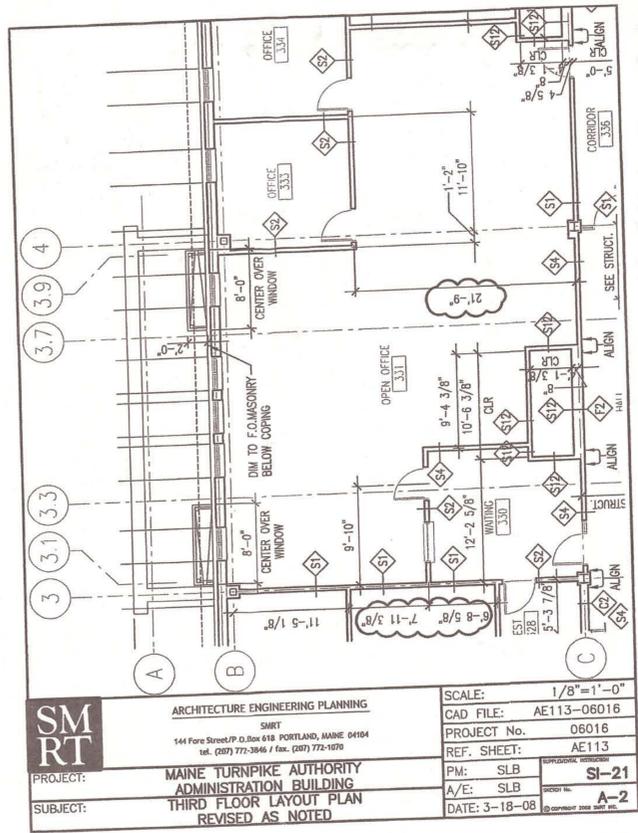


SM RT
 ARCHITECTURE ENGINEERING PLANNING
 144 Fore Street/P.O. Box 618 Portland, Maine 04104
 tel. (207) 772-3646 / fax. (207) 772-1070

PROJECT: MAINE TURNPIKE AUTHORITY ADMINISTRATION BUILDING
 SUBJECT: THIRD FLOOR LAYOUT PLAN
 REVISED AS NOTED

SCALE: 1/8" = 1'-0"
 CAD FILE: AE113-06016
 PROJECT No. 06016
 REF. SHEET: AE113
 PM: SLB
 A/E: SLB
 DATE: 3-18-08

SI-21
 A-2

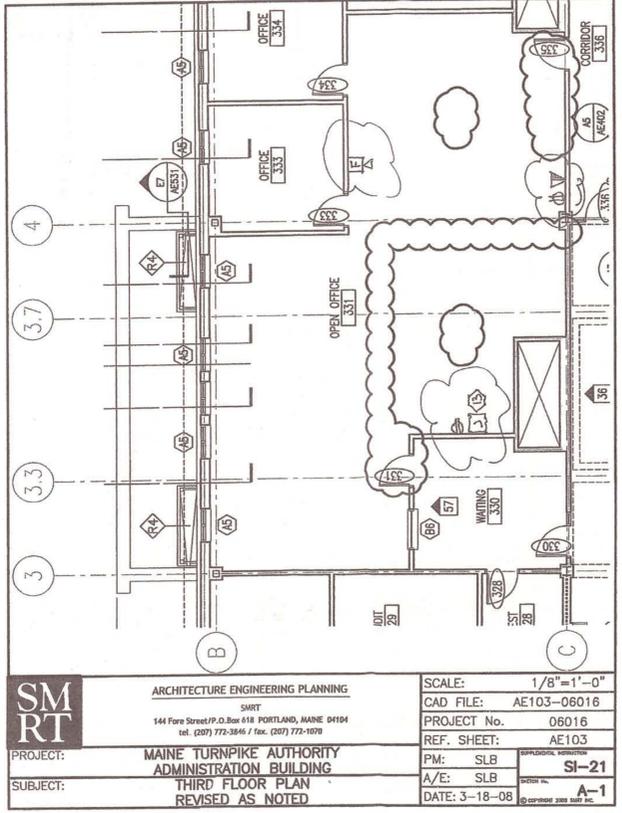


SM RT
 ARCHITECTURE ENGINEERING PLANNING
 144 Fore Street/P.O. Box 618 Portland, Maine 04104
 tel. (207) 772-3646 / fax. (207) 772-1070

PROJECT: MAINE TURNPIKE AUTHORITY ADMINISTRATION BUILDING
 SUBJECT: THIRD FLOOR LAYOUT PLAN
 REVISED AS NOTED

SCALE: 1/8" = 1'-0"
 CAD FILE: AE103-06016
 PROJECT No. 06016
 REF. SHEET: AE103
 PM: SLB
 A/E: SLB
 DATE: 3-18-08

SI-21
 A-1

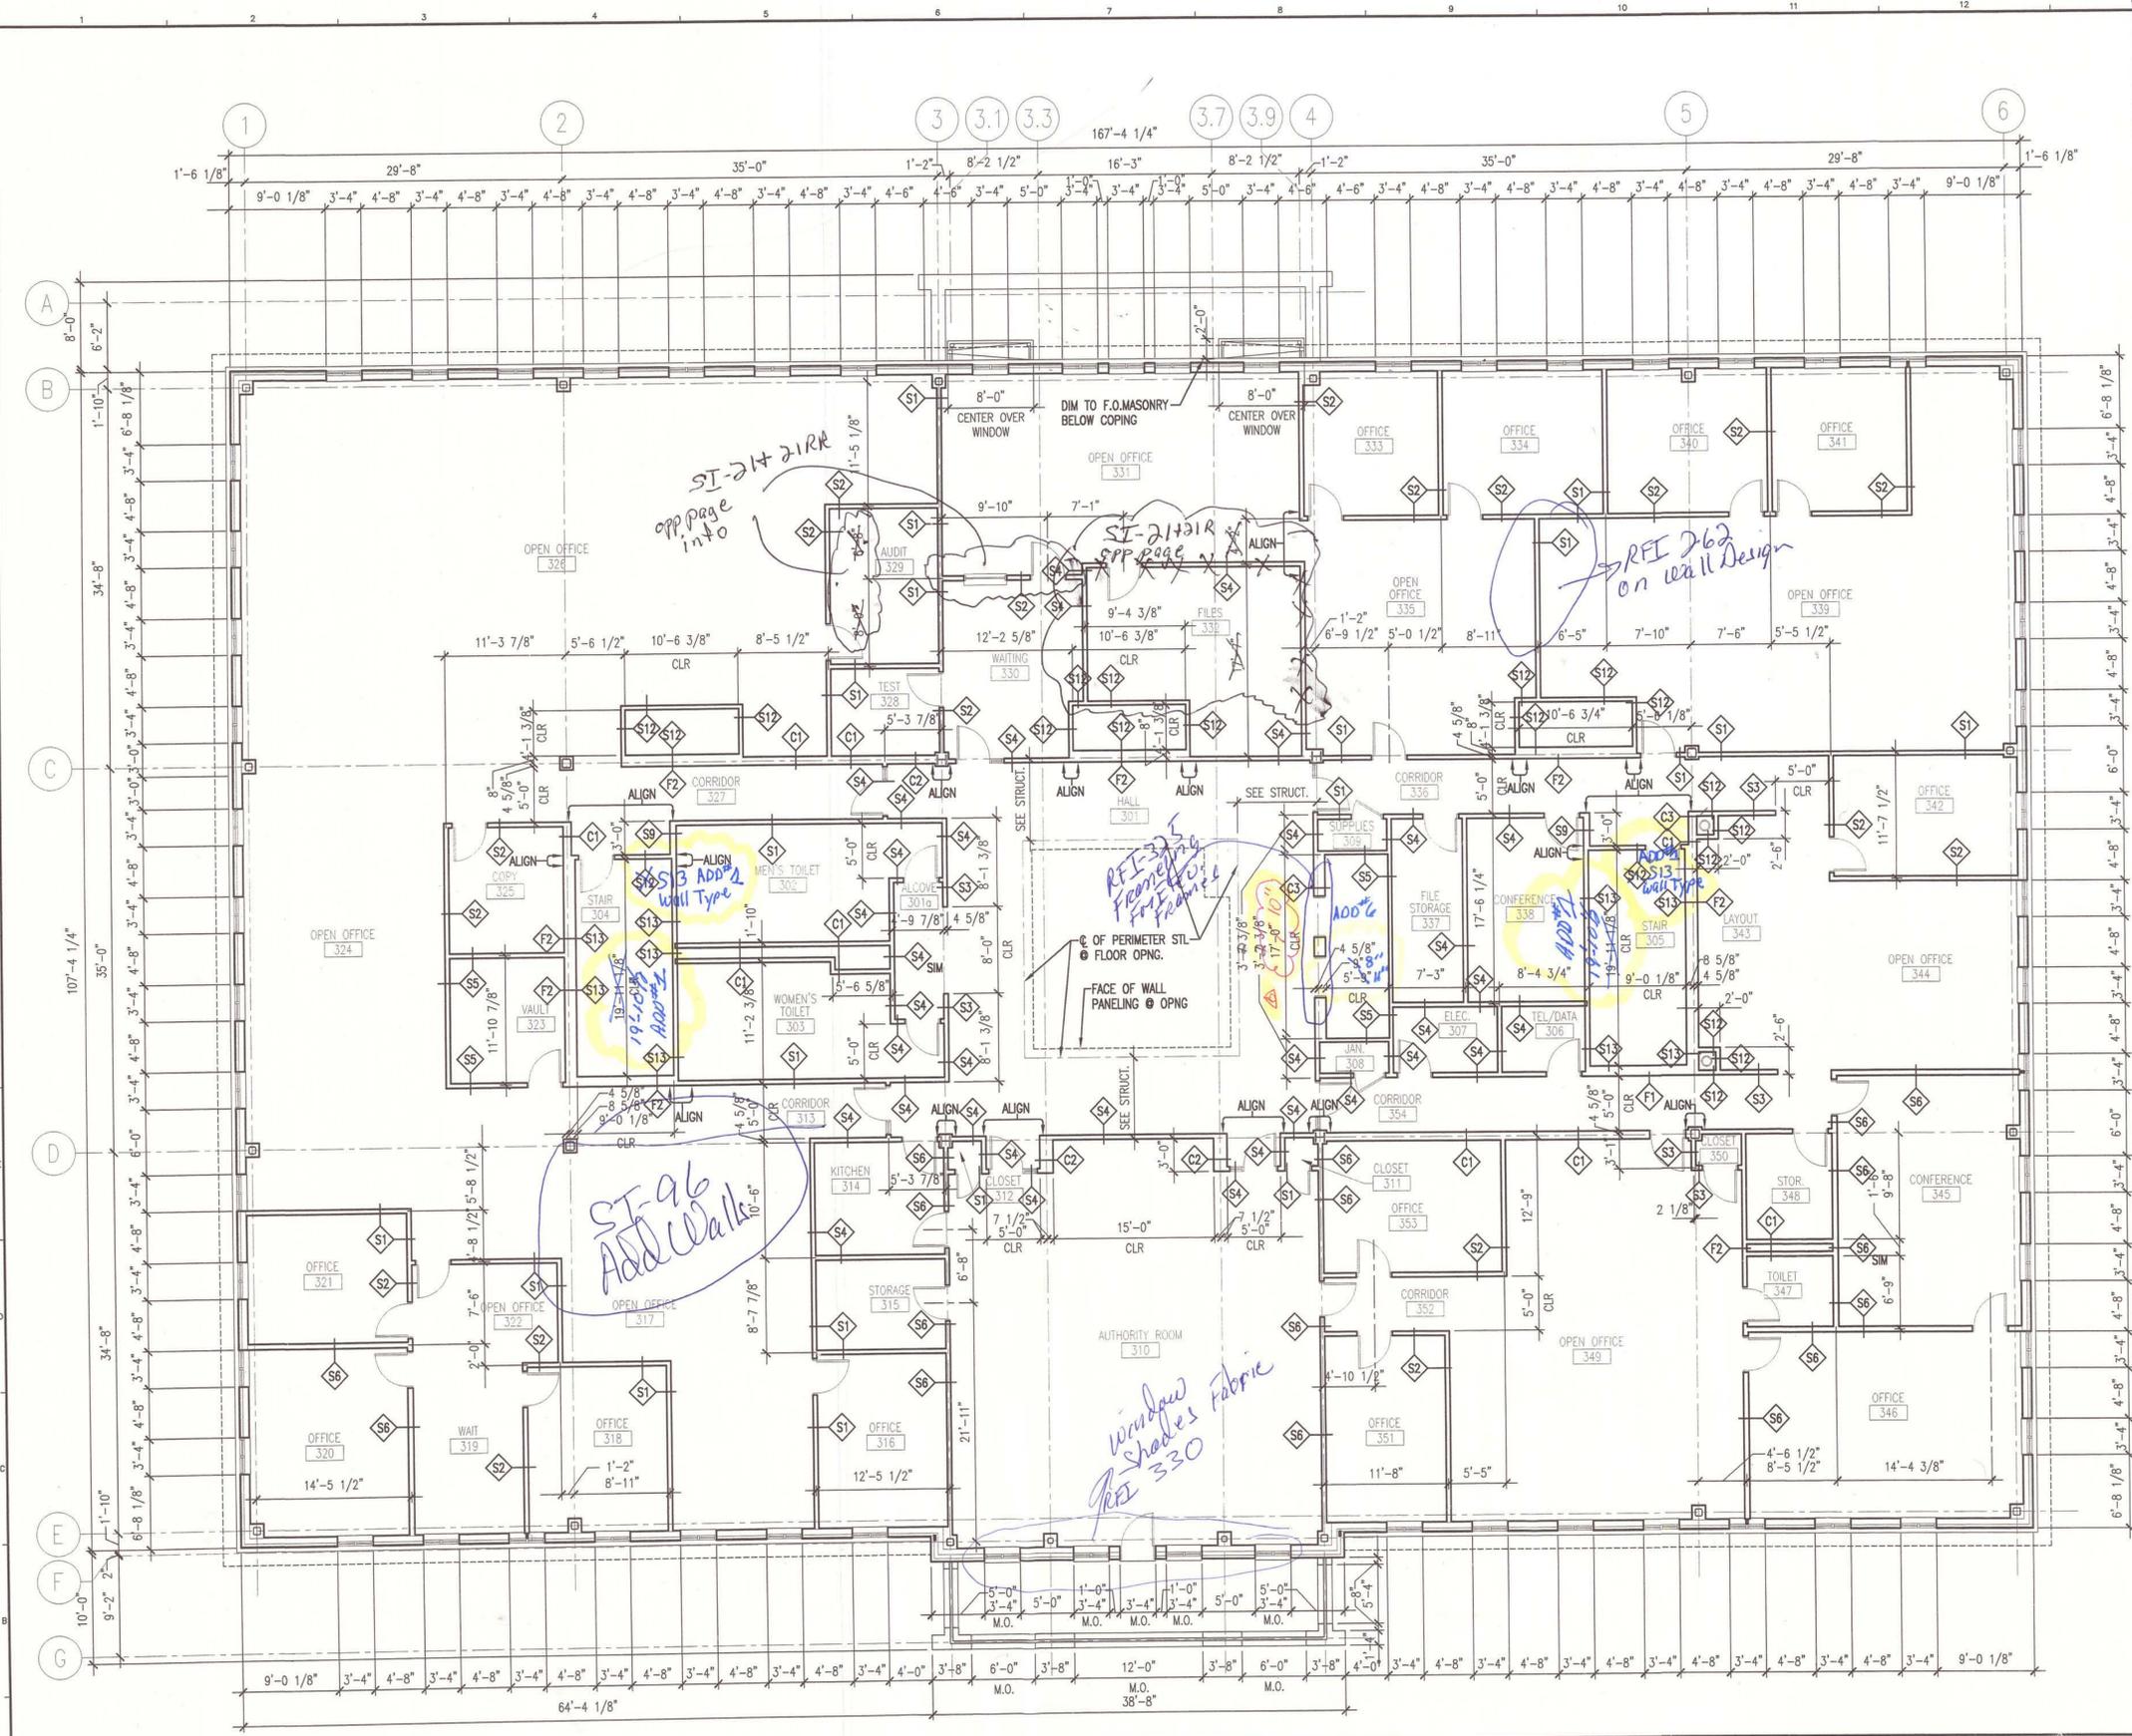

GENERAL NOTES:

1. SEE G101 FOR PROJECT GENERAL NOTES.


LAYOUT PLAN NOTES:

- CHASE DIMENSIONS ARE FROM FACE OF SUBSTRATE BOARD
- CLEAR DIMENSIONS ARE FROM FACE OF SUBSTRATE BOARD
- MASONRY OPENINGS ARE INDICATED AS NOMINAL AND SHALL BE CONSTRUCTED TO MODULE (I.E. IF 3'-4", M.O. = 3'-4 3/8")
- DIMENSIONS FOR SPACES WITHIN ENLARGED PLAN AREAS ARE SHOWN ON THE ENLARGED PLANS (A/E400 SERIES) RE: FLOOR PLANS FOR THESE AREAS

Handwritten note:
 2nd Floor Control St
 Layouts See
 opposite Page
 ST # 76
 RFI 338



ARCHITECTURE ENGINEERING PLANNING
 SMRT
 144 Fore Street/P.O. Box 618
 Portland, Maine 04104
 tel. (207) 773-3846
 fax. (207) 773-1070

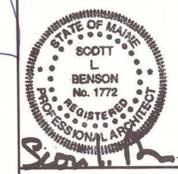

PROJECT TITLE:
**MAINE TURNPIKE AUTHORITY
 ADMINISTRATION BUILDING**
 PORTLAND, MAINE

CURRENT ISSUE STATUS:
**ISSUED FOR BIDDING/CONSTRUCTION
 7-9-07**

REV	DESCRIPTION	DATE
0	BIDDING/CONSTRUCTION	7-9-07

GRAPHIC SCALE:
 0" = 1"

SCALE: AS NOTED

PROJECT MANAGER: SLB
 JC/DRAWN BY: TCM/TCM
 A/E OF RECORD: SLB
 CAD FILE: AE113-06F
 PROJECT NO: 06016
 DATE: 7-9-07


SHEET TITLE:
**THIRD FLOOR
 LAYOUT PLAN**

SHEET No. **AE113**

AS BUILT
 Owner Copy

A1 THIRD FLOOR LAYOUT PLAN

1/8" = 1'-0"

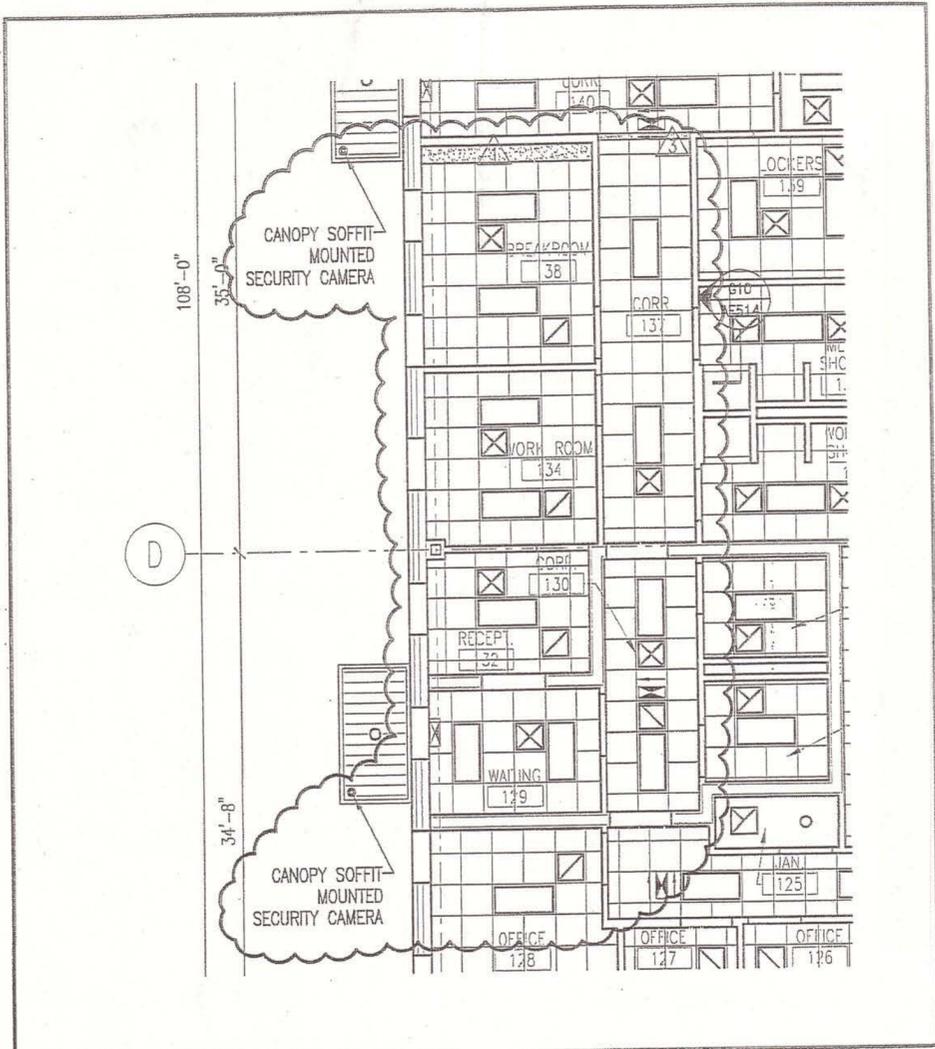


SM RT ARCHITECTURE ENGINEERING PLANNING
 SMRT
 144 Fore Street/P.O. Box 618 PORTLAND, MAINE 04104
 tel. (207) 772-3846 / fax. (207) 772-1070

PROJECT: MAINE TURNPIKE AUTHORITY ADMINISTRATION BUILDING
 SUBJECT: FIRST FLOOR REFLECTED CEILING PLAN
 DATE: 8-10-07

SCALE: 1/8"=1'-0"
 CAD FILE: AE121-06016
 PROJECT No. 06016
 REF. SHEET: AE121
 PM: SLB
 A/E: SLB
 DATE: 8-10-07

ADDENDUM No. **ADD-4**
 SHEET No. **A-3**

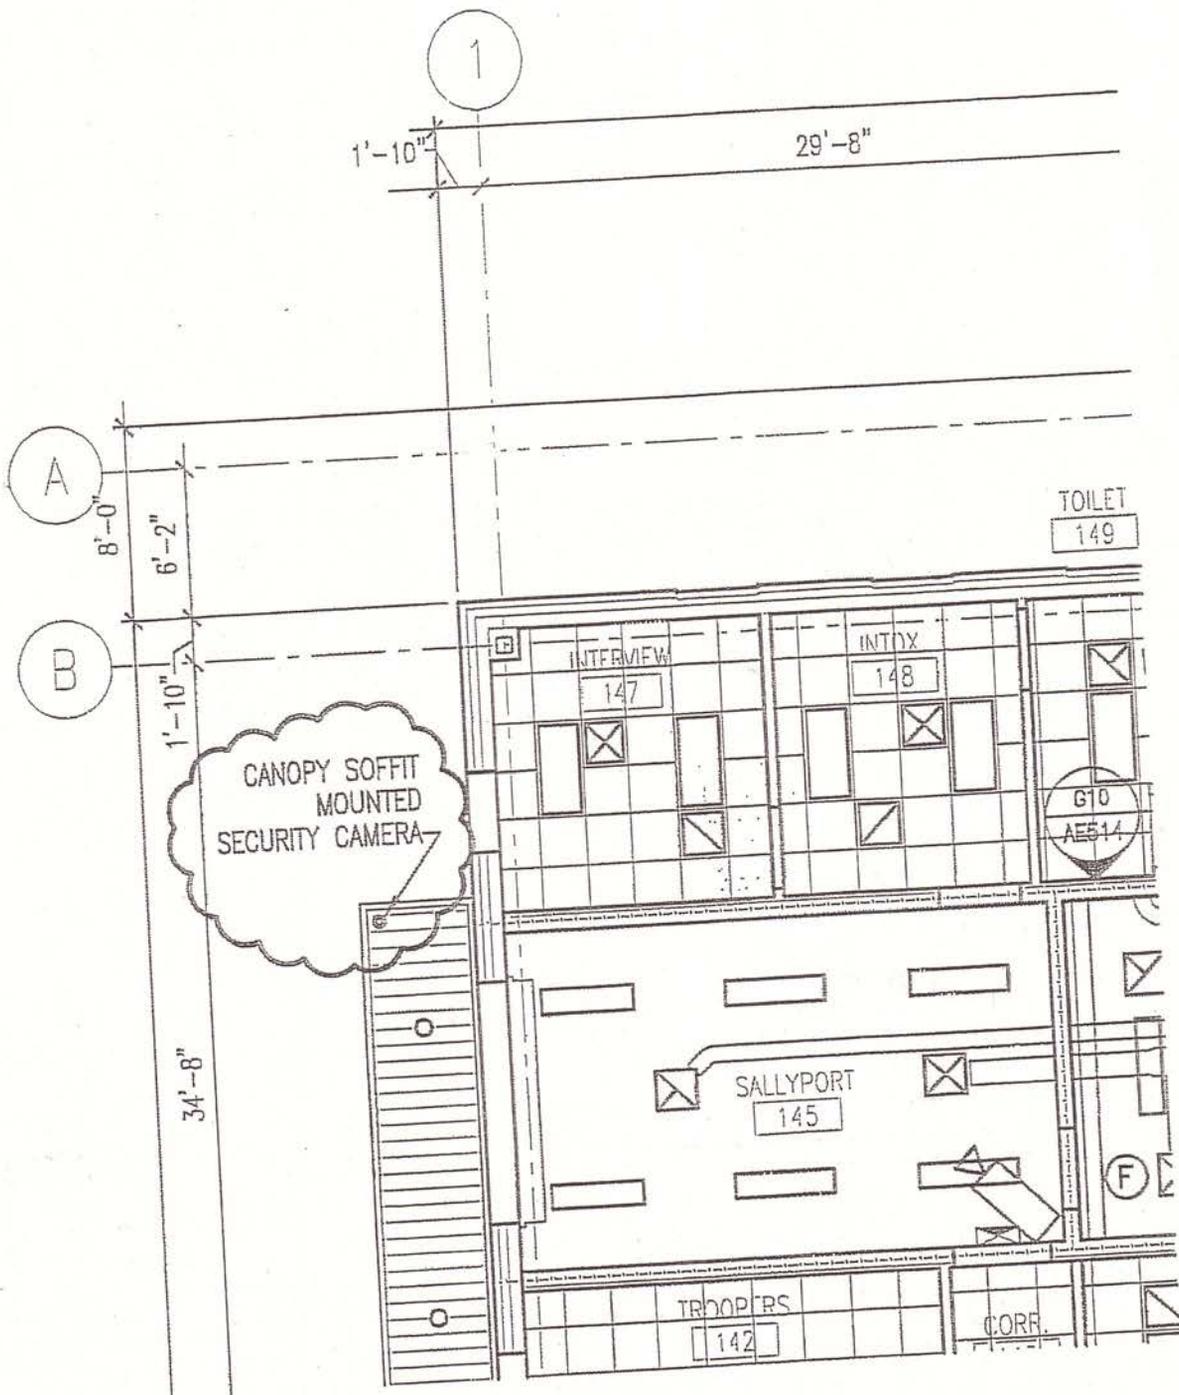

**SM
RT**

ARCHITECTURE ENGINEERING PLANNING
 SMRT
 144 Fore Street/P.O.Box 618 PORTLAND, MAINE 04104
 tel. (207) 772-3846 / fax. (207) 772-1070


PROJECT:

MAINE TURNPIKE AUTHORITY
 ADMINISTRATION BUILDING


FIRST FLOOR REFLECTED CEILING PLAN

SCALE: 1/8"=1'-0"
 CAD FILE: AE121-06016
 PROJECT No. 06016
 REF. SHEET: AE121
 PM: SLB
 A/E: SLB
 DATE: 8-10-07

ADDENDUM No. **ADD-4**
 SKETCH No. **A-4**
© COPYRIGHT 2007 SMRT INC.

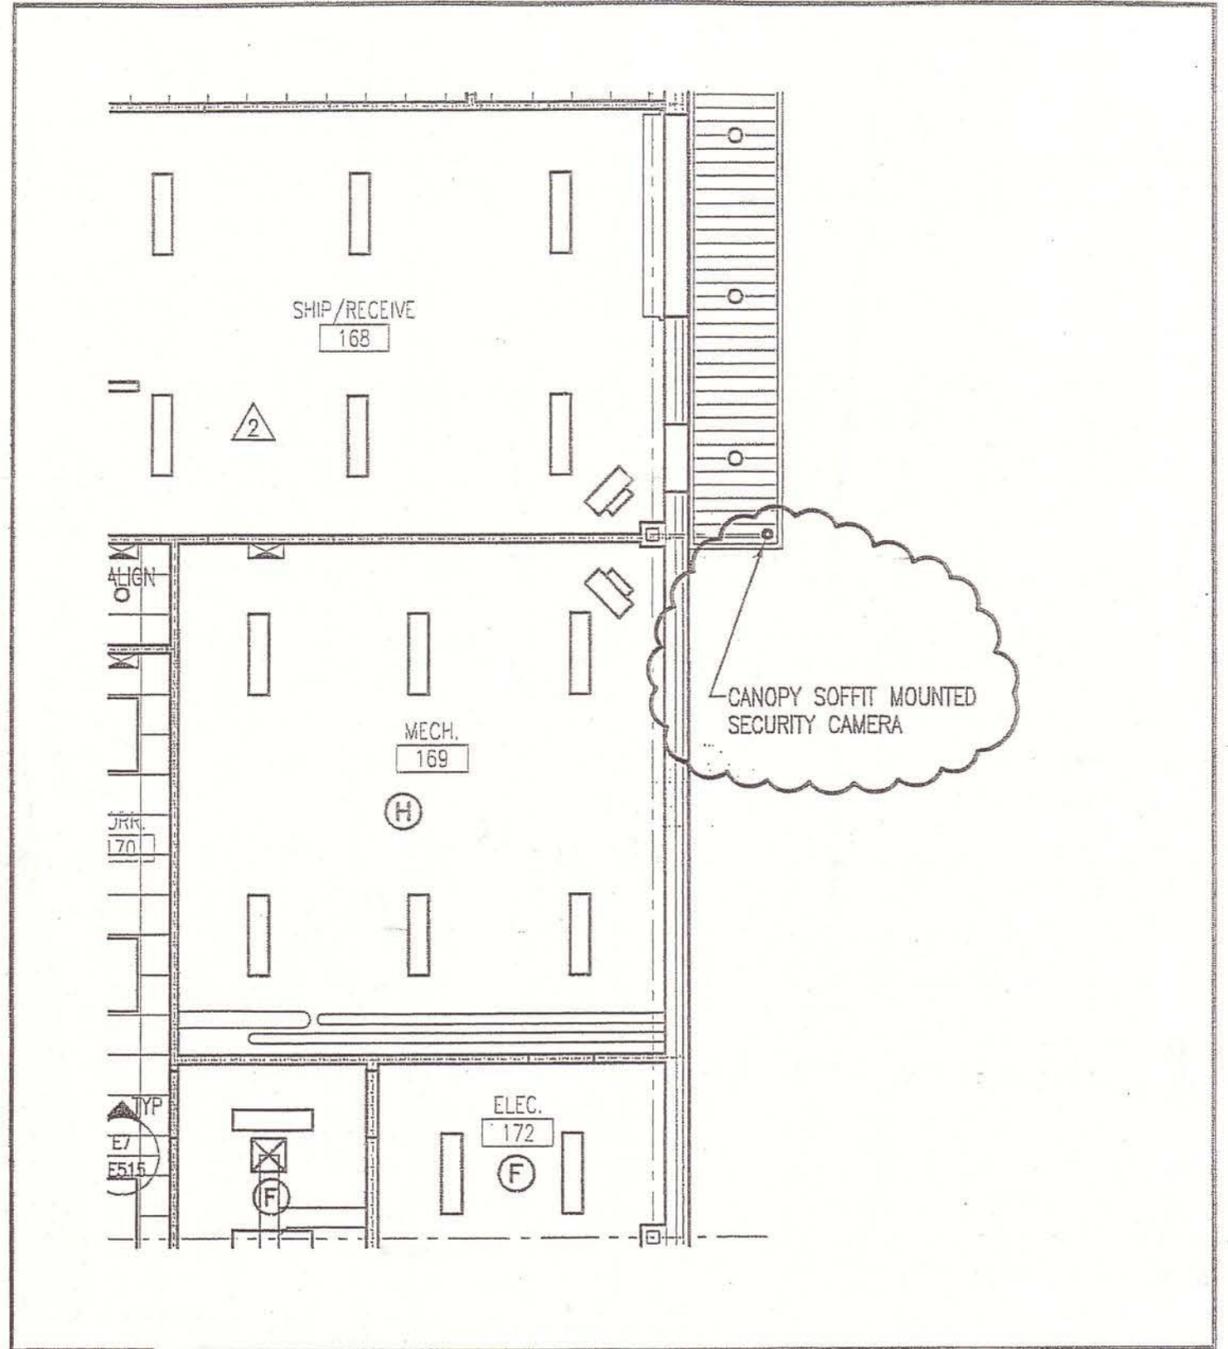

	ARCHITECTURE ENGINEERING PLANNING SMRT 144 Fore Street/P.O.Box 618 PORTLAND, MAINE 04104 tel. (207) 772-3846 / fax. (207) 772-1070	SCALE: 1/8"=1'-0" CAD FILE: AE121-06016
	PROJECT: MAINE TURNPIKE AUTHORITY ADMINISTRATION BUILDING	PROJECT No. 06016 REF. SHEET: AE121
SUBJECT: FIRST FLOOR REFLECTED CEILING PLAN	PM: SLB A/E: SLB DATE: 8-10-07	ADDENDUM No. ADD-4 SKETCH No. A-5

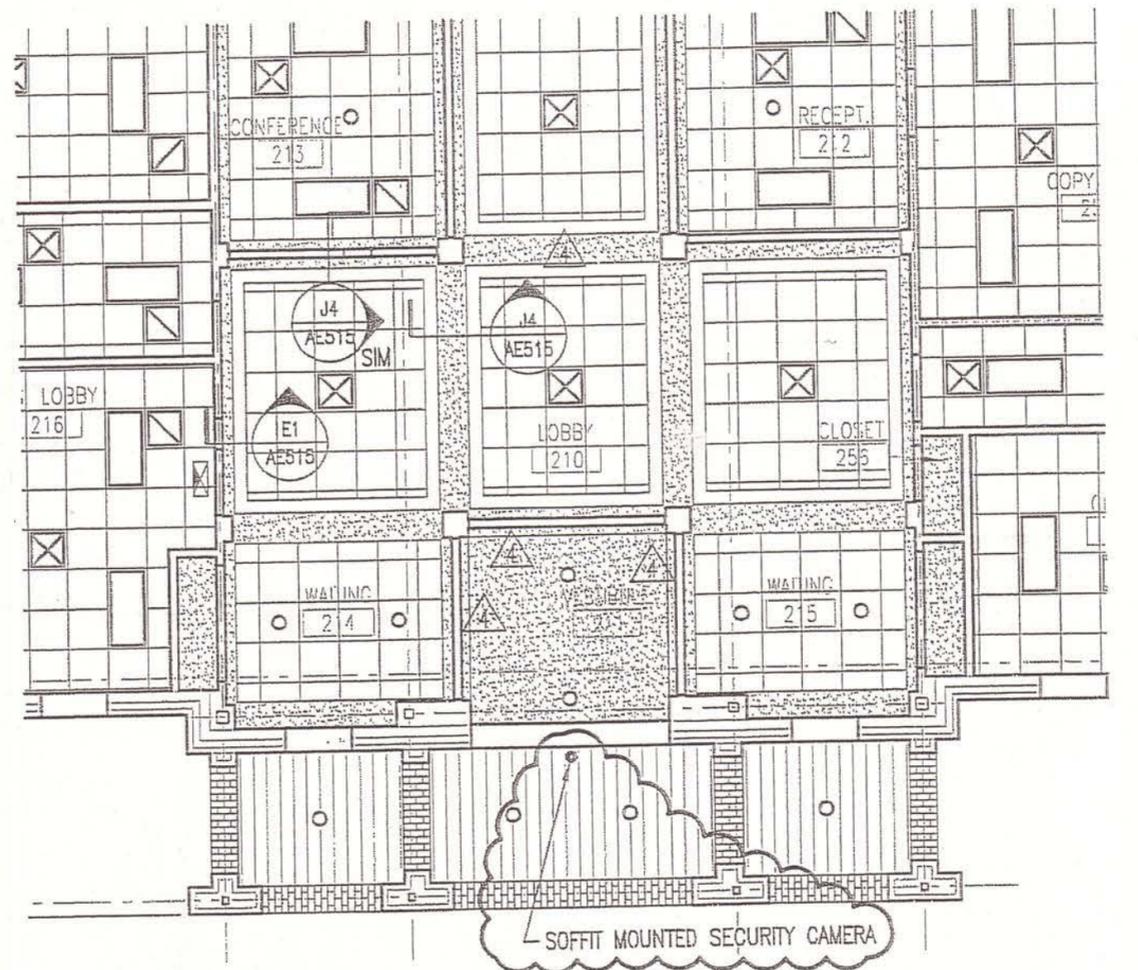


ARCHITECTURE ENGINEERING PLANNING
 SMRT
 144 Fore Street/P.O. Box 618 PORTLAND, MAINE 04104
 tel. (207) 772-3846 / fax. (207) 772-1070

PROJECT: MAINE TURNPIKE AUTHORITY
 ADMINISTRATION BUILDING
 SUBJECT: SECOND FLOOR REFLECTED CEILING PLAN

SCALE: 1/8"=1'-0"
 CAD FILE: AE122-06016
 PROJECT No. 06016
 REF. SHEET: AE122
 PM: SLB
 A/E: SLB
 DATE: 8-10-07

ADDITUM No. ADD-4
 SKETCH No. A-6

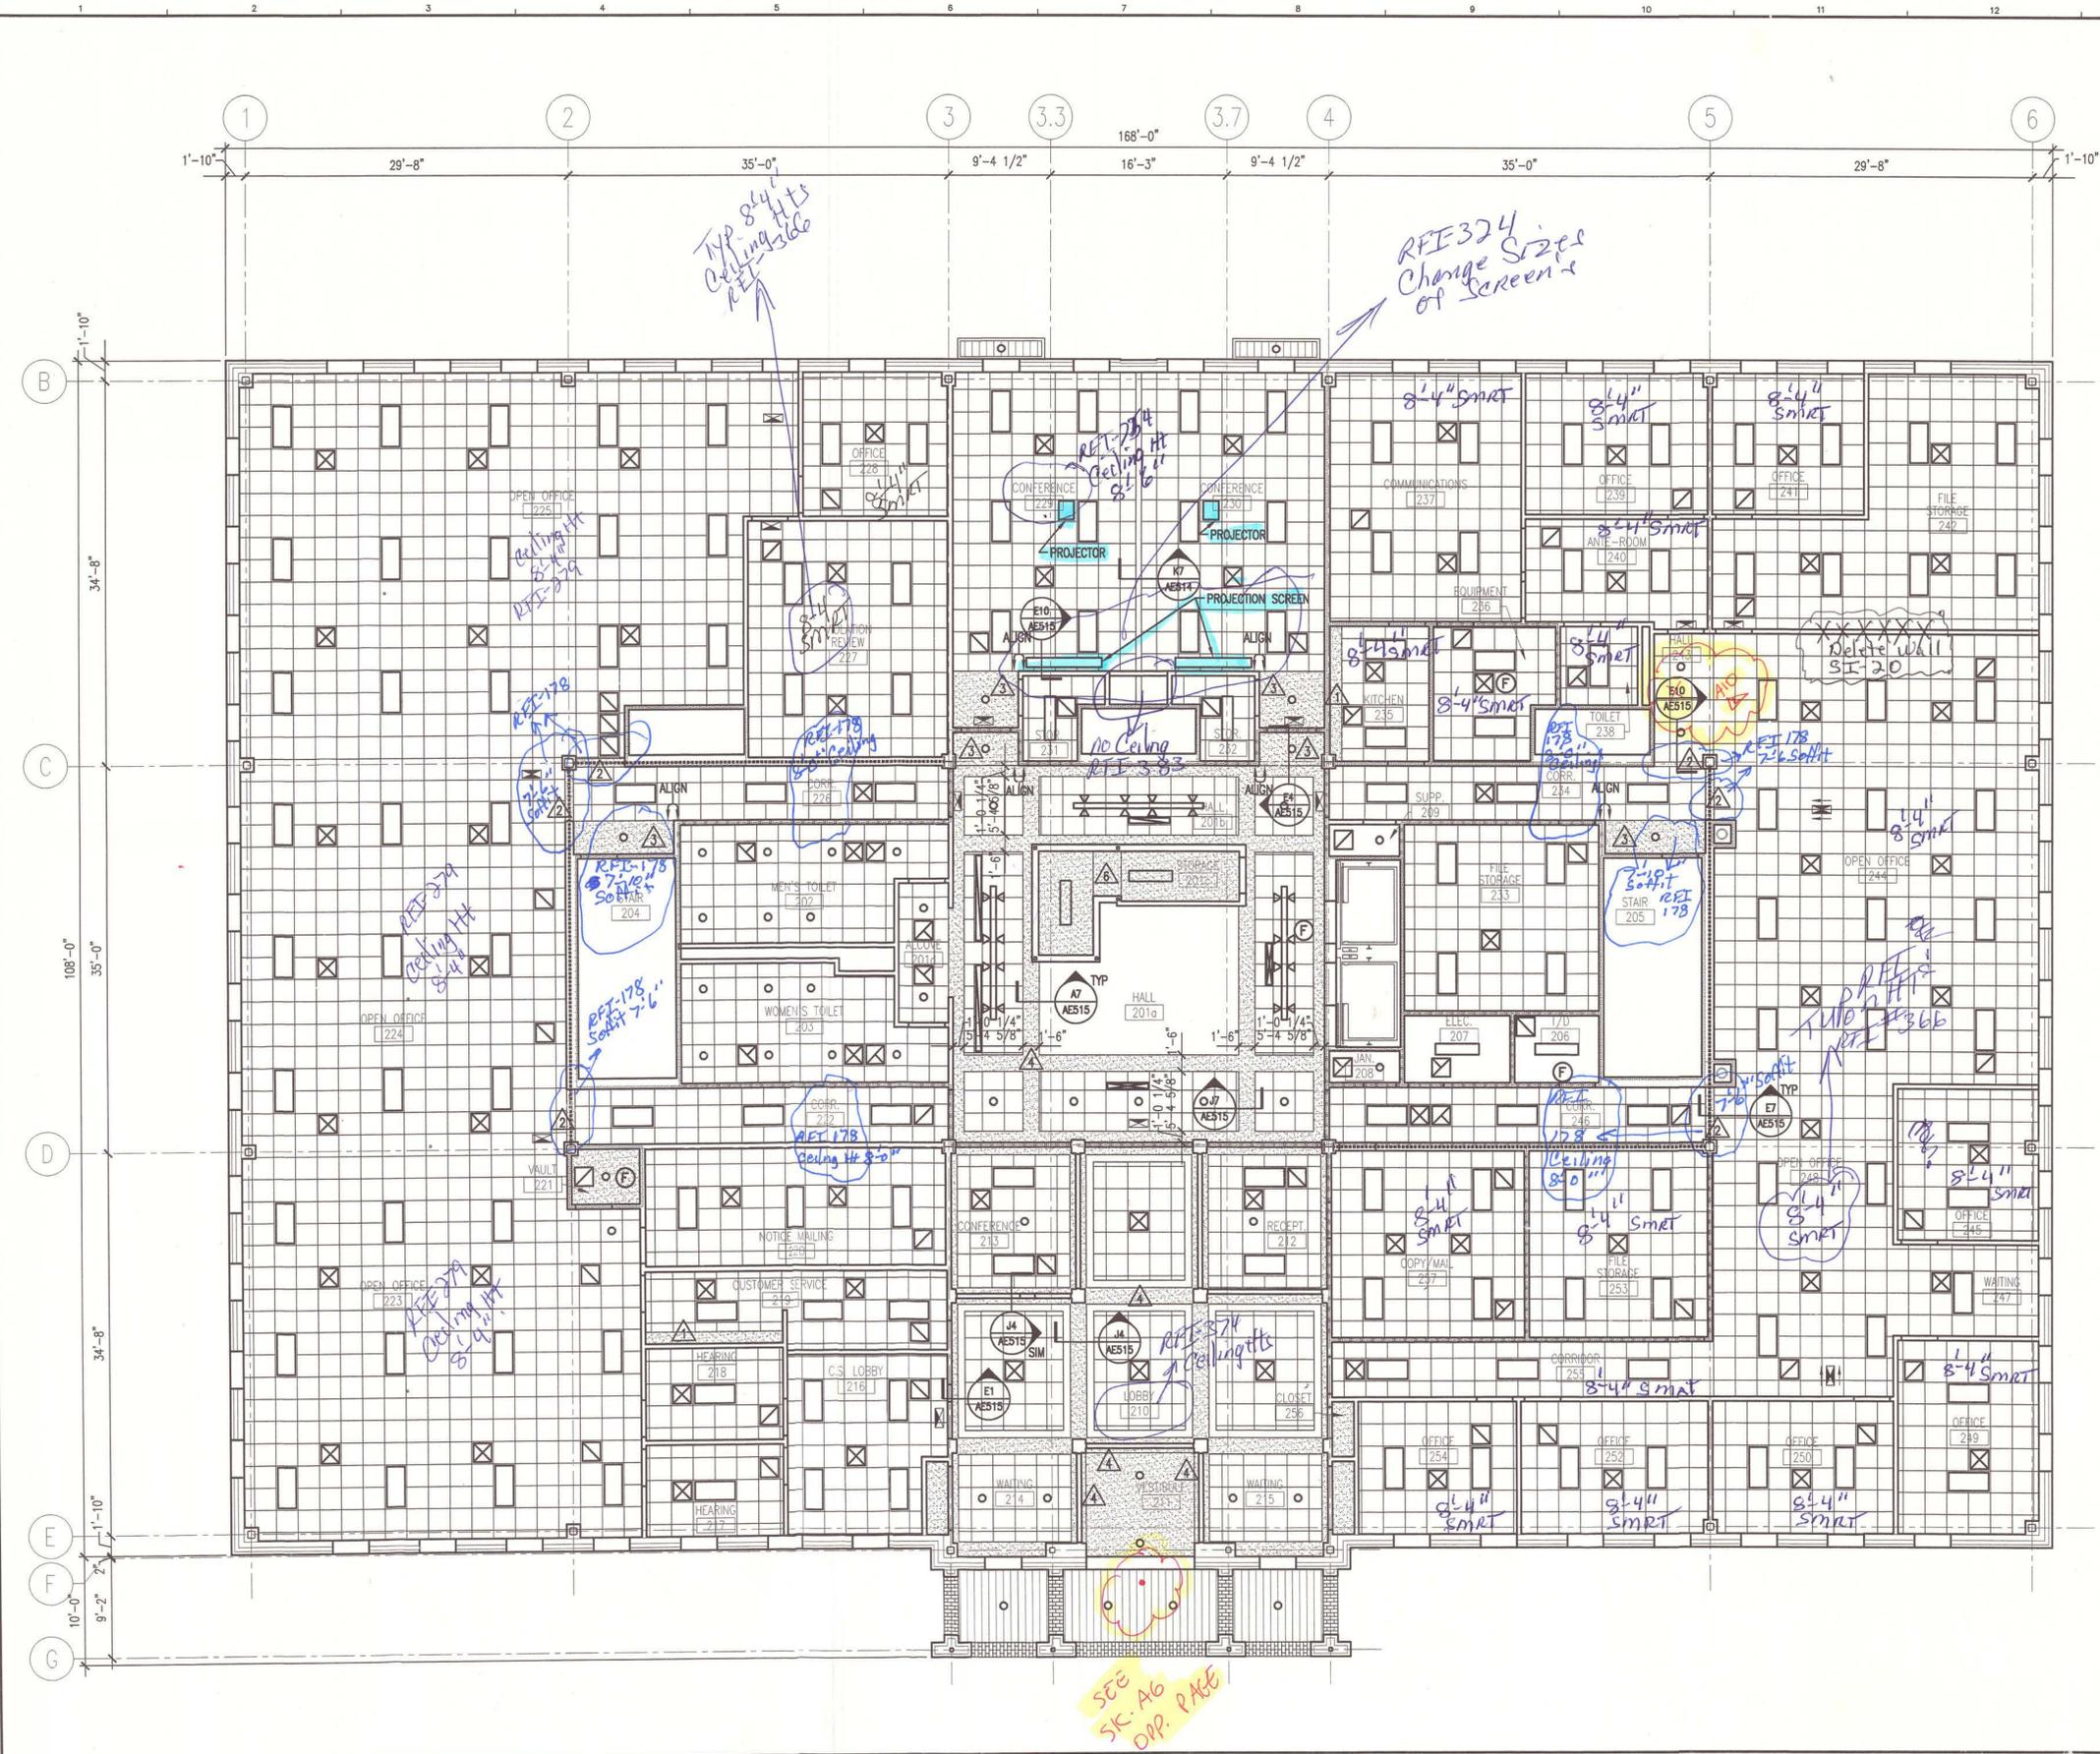

GENERAL NOTES:

1. SEE G1001 FOR PROJECT GENERAL NOTES.

REFLECTED CEILING PLAN NOTES:

1. REFERENCE ROOM FINISH SCHEDULE FOR CEILING HEIGHTS AND TYPES
2. FIRE SPRINKLERS SHALL BE LOCATED IN ALIGNMENT WITH OTHER CEILING ITEMS, TYPICALLY
3. FIRE SPRINKLERS SHALL BE CENTERED IN CEILING TILE
4. FIRE SPRINKLERS SHALL BE PLACED TO COORDINATE WITH LIGHT FIXTURE. POSITIONS INDICATED.
5. ALIGN CEILING ITEMS AS SHOWN, WITH COMMON CENTERLINES, TYPICALLY. CENTER ITEMS IN CEILINGS, OR IN AREA U.N.O
6. PROVIDE ACCESS PANELS AS REQUIRED IN GWB CEILINGS FOR ACCESS TO MECHANICAL VALVES/ CONTROLS. RE: MECHANICAL DRAWINGS

SOFFIT HEIGHT SCHEDULE

- 1 7'-0" A.F.F.
- 2 7'-6" A.F.F.
- 3 8'-0" A.F.F.
- 4 8'-6" A.F.F.
- 5 11'-6" A.F.F.
- 6 6'-10" A.F.F.



AS BUILT
Owner Copy

SYMBOL LEGEND

- AREA INDICATING LIMITS OF HORIZONTAL SHAFT ASSEMBLY ABOVE CEILING
- HANGING BRICK SOFFIT
- ALUMINUM SOFFIT/ CEILING SYSTEM
- 2x4 SUSPENDED CEILING PANEL AND GRID ASSEMBLY.
- 2x2 SUSPENDED CEILING PANEL AND GRID ASSEMBLY.
- GWB CEILING.
- 2x4 LAY-IN LIGHT FIXTURE.
- 1x4 PENDANT LIGHT FIXTURE.
- DOWN LIGHT.
- CEILING MOUNTED EXIT LIGHT.
- RETURN AIR GRILLE.
- SUPPLY AIR GRILLE.
- EXHAUST AIR GRILLE.
- SPRINKLER HEAD.
- CEILING MOUNTED SPEAKER.
- CEILING MOUNTED SMOKE DETECTOR.
- SLOT DIFFUSER.
- CEILING MOUNTED CAMERA (N.A.C.) DELETE
- CEILING MOUNTED HEAT DETECTOR
- CEILING MOUNTED OCCUPANCY SENSOR



ARCHITECTURE ENGINEERING PLANNING
SMRT
144 Fore Street P.O. Box 618
Portland, Maine 04104
tel. (207) 772-3846
fax. (207) 772-1070

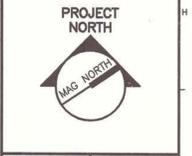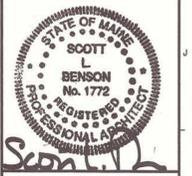

MAINE TURNPIKE AUTHORITY
ADMINISTRATION BUILDING
PORTLAND, MAINE
ISSUED FOR BIDDING/CONSTRUCTION
7-9-07

REV	DATE	DESCRIPTION
0	7-9-07	BIDDING/CONSTRUCTION

GRAPHIC SCALE:
0" 1"
SCALE: AS NOTED
PROJECT MANAGER: SLB
JC/DRAWN BY: TCM/TCM
A/E OF RECORD: SLB
PROJECT NO: AE122-08016
PROJECT NO: 06016
DATE: 7-9-07
SHEET TITLE:
SECOND FLOOR REFLECTED CEILING PLAN
SHEET No. AE122

A1 SECOND FLOOR REFLECTED CEILING PLAN

1/8" = 1'-0"



Rick Paulison

From: Charles Myers [CMYERS@HNTB.com]
Sent: Thursday, December 18, 2008 6:10 AM
To: Rick Paulison
Cc: Craig Hill
Subject: FW: clg. ht.

Rick, as verbally requested yesterday afternoon, ceiling height changes for 325 / 323 are approved
-----Original Message-----

From: Scott Benson [mailto:SBenson@SMRTInc.com]
Sent: Wednesday, December 17, 2008 5:17 PM
To: Charles Myers
Cc: Mark Estabrook
Subject: clg. ht.

hi charlie: 8'-6" +/- shouldn't be a problem in 323 or 325. regards, scott

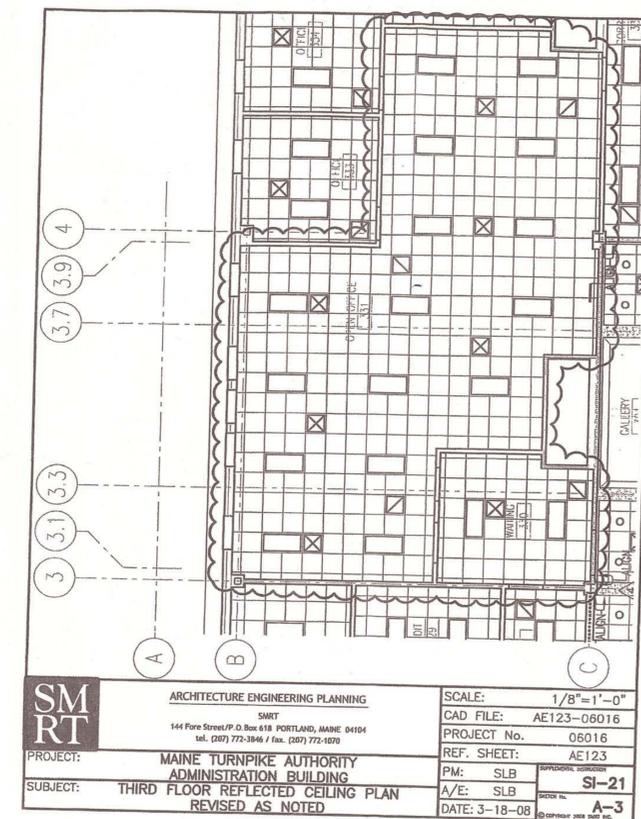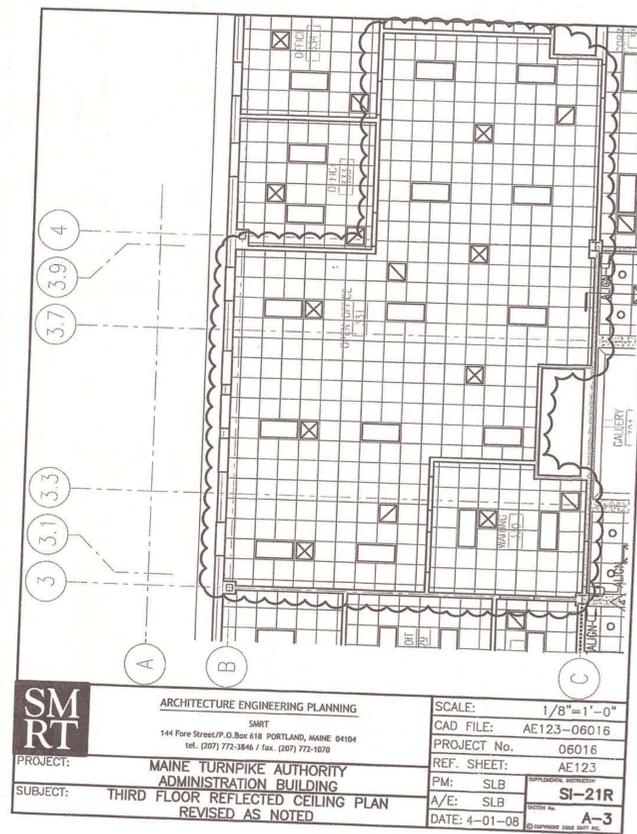

**Submittal
Review Memo**

Project Name: MTA Admin HQ - CA & Proj Rep Job #: 0601608
 Architect: Derek Converse Wright-Ryan Construction 10 Danforth Street
 Portland, ME 04101 Submittal #: 210-076100
 Submittal Title: Sheet Metal Roofing Sample of "Slate Gray"

ACTION: Please take action below:
 The review was performed for the limited purpose of determining general conformance with the design concept of the project and general compliance with the information given in the Contract Documents. Modifications or comments made on the submittal during this review do not relieve the contractor from compliance with the requirements of the drawings and specifications. Approval of a specific item does not include approval of the assembly of which the item is a component. The Contractor is responsible for quantities and dimensions to be confirmed and correlated at the job site; information that pertains solely to the fabrication processes or to the means, methods, techniques sequences and procedures of construction; coordination of the work of all trades; and for performing all work in a safe and satisfactory manner.

APPROVED
 PROVIDE AS NOTED
 REVISE AND RESUBMIT
 RESUBMIT SPECIFIC ITEM
 REJECTED:
 Not a specified product
 Incomplete
 Other
 INFORMATIONAL SUBMITTAL FOR RECORD ONLY
 NOT A REQUIRED SUBMITTAL - NOT REVIEWED

SMRT, Inc.
 REVIEW DATE: 5.11.08
 BY: S.R.


Remarks: *Roofing Color*

Provide sheet metal roofing in Slate Gray to match the color of sample provided.


This sample shall also serve as the "Architect's sample" for color matching all exterior metalwork with the exception of stainless steel, and items whose color is specifically noted otherwise in writing. Items this color shall include, but not necessarily be limited to: window frames, hollow metal doors and frames, storefront framing, composite metal panels, roof coping, overhead doors and soffits.

ROOFTOP EQUIPMENT SCREEN


06016-08 #210

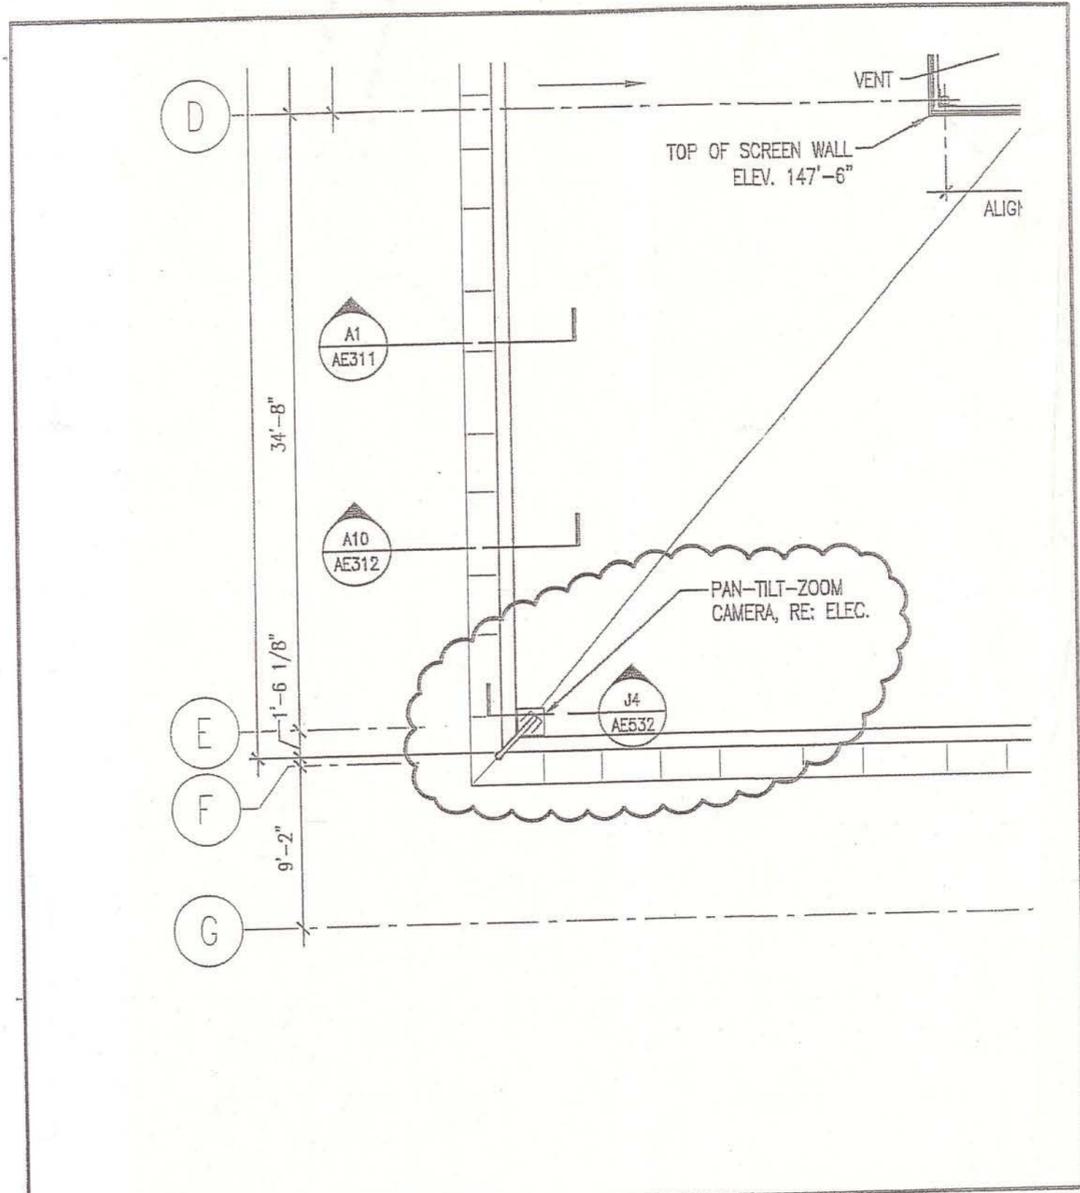


SM RT	ARCHITECTURE ENGINEERING PLANNING	SCALE: 1/8"=1'-0"
	SMRT 144 Fore Street/P.O.Box 618 PORTLAND, MAINE 04104 tel. (207) 772-3846 / fax. (207) 772-1070	CAD FILE: AE131-06016
PROJECT: MAINE TURNPIKE AUTHORITY ADMINISTRATION BUILDING	PROJECT No. 06016	REF. SHEET: AE131
SUBJECT: ROOF PLAN	PM: SLB	ADD-4
	A/E: SLB	SKETCH No. A-7
	DATE: 8-10-07	

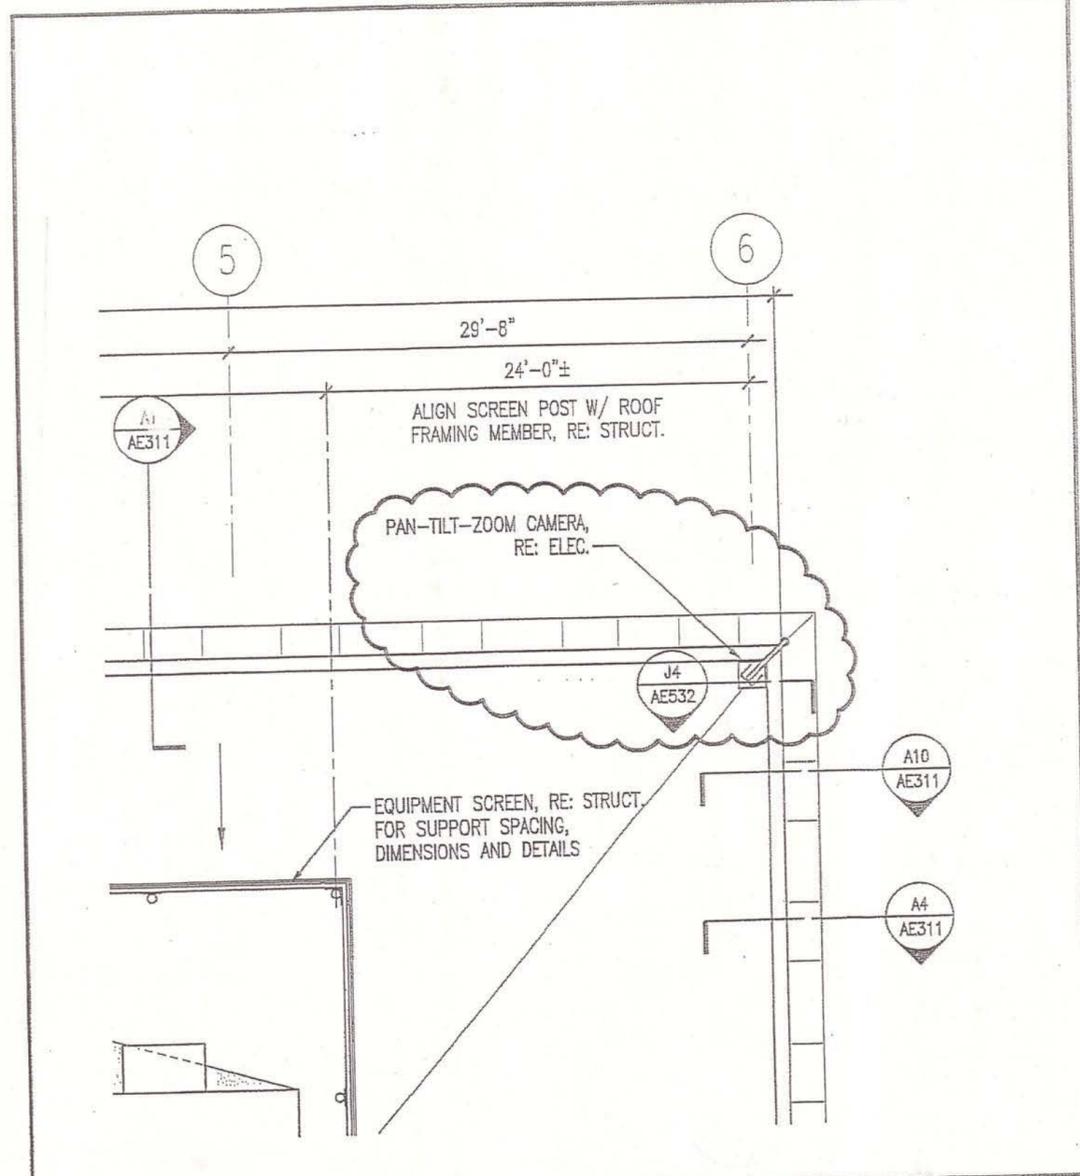


SM RT	ARCHITECTURE ENGINEERING PLANNING	SCALE: 1/8"=1'-0"
	SMRT 144 Fore Street/P.O.Box 618 PORTLAND, MAINE 04104 tel. (207) 772-3846 / fax. (207) 772-1070	CAD FILE: AE131-06016
PROJECT: MAINE TURNPIKE AUTHORITY ADMINISTRATION BUILDING	PROJECT No. 06016	REF. SHEET: AE131
SUBJECT: ROOF PLAN	PM: SLB	ADD-4
	A/E: SLB	SKETCH No. A-8
	DATE: 8-10-07	

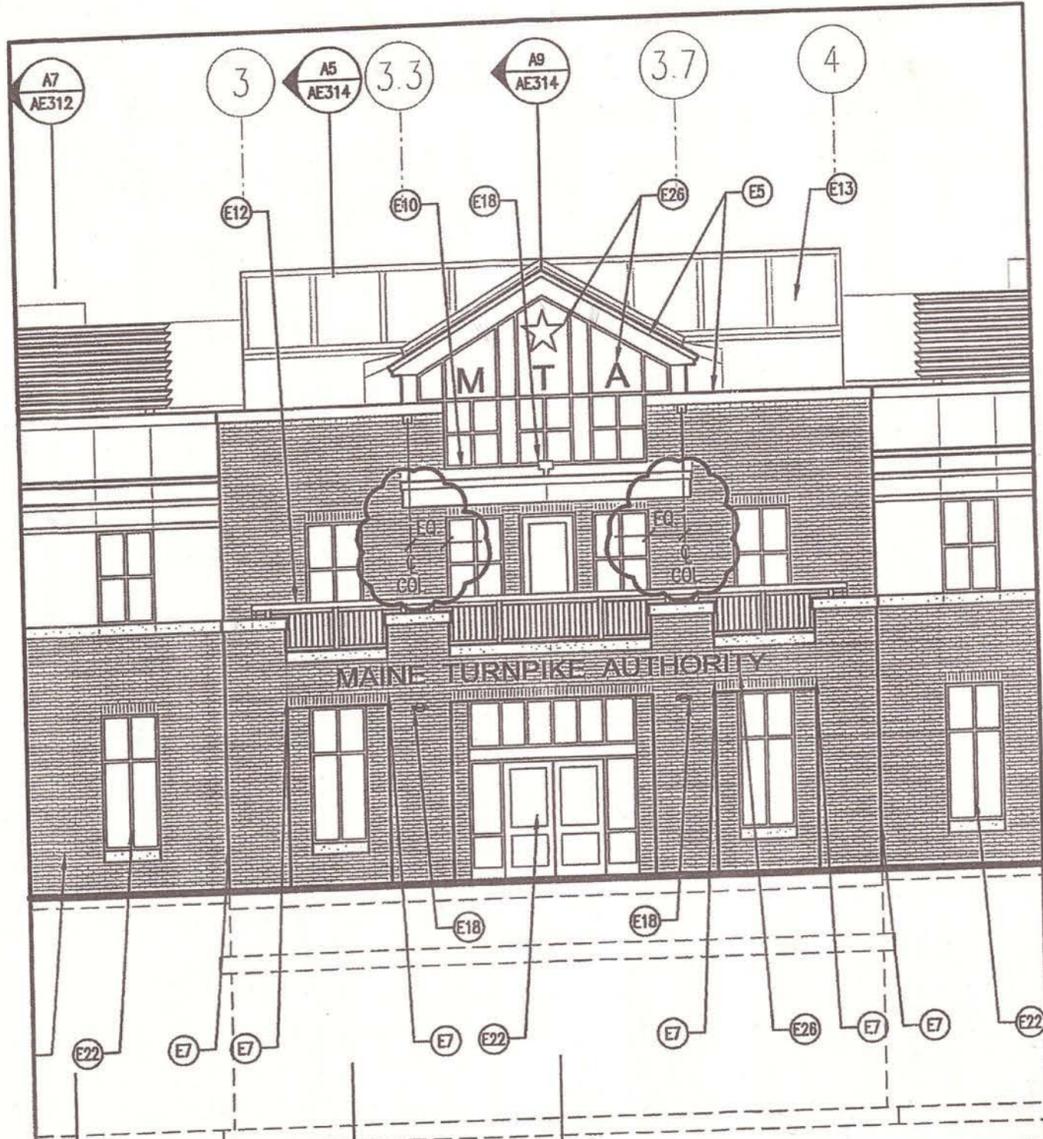


SM RT	ARCHITECTURE ENGINEERING PLANNING	SCALE: 1/8" = 1'-0"
	SMRT 144 Fore Street/P.O. Box 618 PORTLAND, MAINE 04104 tel. (207) 772-3846 / fax. (207) 772-1070	CAD FILE: AE201-06016
PROJECT:	MAINE TURNPIKE AUTHORITY ADMINISTRATION BUILDING	PROJECT No. 06016
SUBJECT:	ADDED DIMENSIONS @ CANOPIES EXTERIOR ELEVATIONS	REF. SHEET: AE201
	PM: SLB	PM: SLB
	A/E: SLB	A/E: SLB
	DATE: 3-11-08	DATE: 3-11-08
	SI-19	SI-19
	A-5	A-4

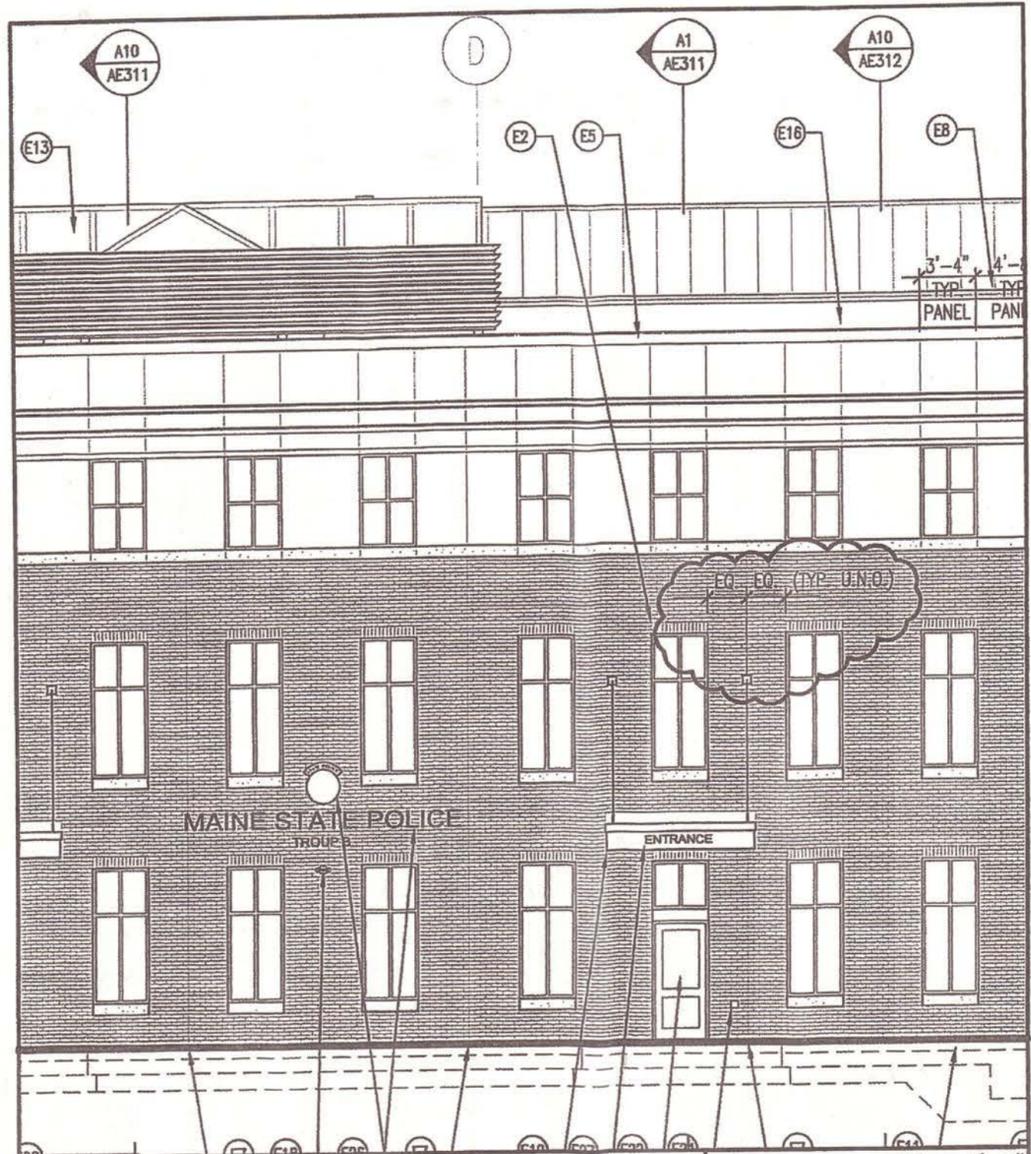

SM RT	ARCHITECTURE ENGINEERING PLANNING	SCALE: 1/8" = 1'-0"
	SMRT 144 Fore Street/P.O. Box 618 PORTLAND, MAINE 04104 tel. (207) 772-3846 / fax. (207) 772-1070	CAD FILE: AE201-06016
PROJECT:	MAINE TURNPIKE AUTHORITY ADMINISTRATION BUILDING	PROJECT No. 06016
SUBJECT:	ADDED DIMENSIONS @ CANOPIES EXTERIOR ELEVATIONS	REF. SHEET: AE201
	PM: SLB	PM: SLB
	A/E: SLB	A/E: SLB
	DATE: 3-11-08	DATE: 3-11-08
	SI-19	SI-19
	A-4	A-4

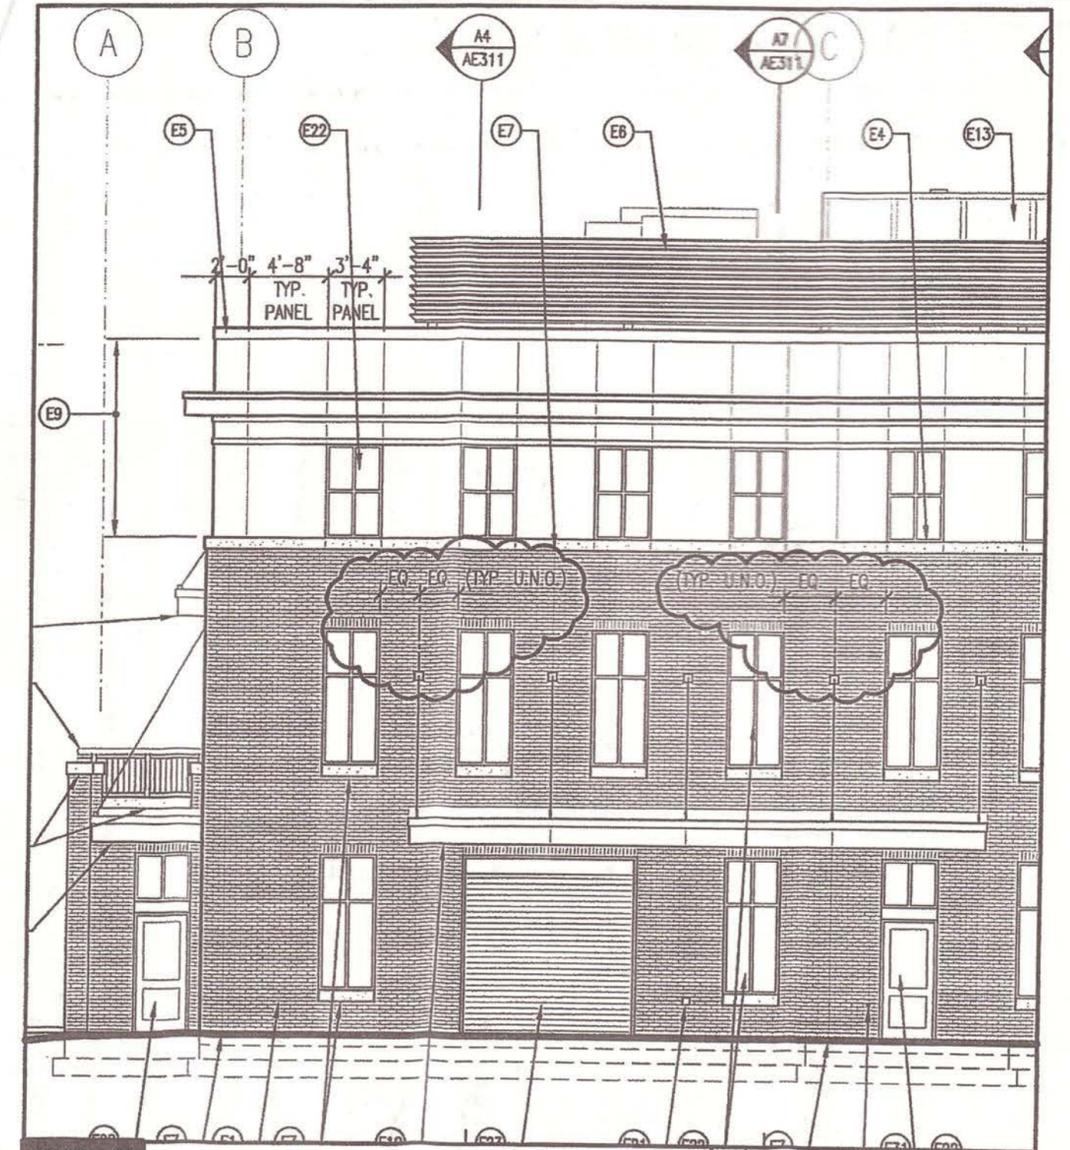

SM RT	ARCHITECTURE ENGINEERING PLANNING	SCALE: 1/8" = 1'-0"
	SMRT 144 Fore Street/P.O. Box 618 PORTLAND, MAINE 04104 tel. (207) 772-3846 / fax. (207) 772-1070	CAD FILE: AE201-06016
PROJECT:	MAINE TURNPIKE AUTHORITY ADMINISTRATION BUILDING	PROJECT No. 06016
SUBJECT:	ADDED DIMENSIONS @ CANOPIES EXTERIOR ELEVATIONS	REF. SHEET: AE201
	PM: SLB	PM: SLB
	A/E: SLB	A/E: SLB
	DATE: 3-11-08	DATE: 3-11-08
	SI-19	SI-19
	A-3	A-3

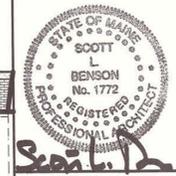

PROJECT TITLE:
**MAINE TURNPIKE AUTHORITY
ADMINISTRATION BUILDING**
PORTLAND, MAINE

CURRENT ISSUE STATUS:
ISSUED FOR BIDDING/CONSTRUCTION
7-9-07


REV	DESCRIPTION	DATE
0	BIDDING/CONSTRUCTION	7-9-07

GRAPHIC SCALE:
0" = 1"

SCALE: AS NOTED
PROJECT MANAGER: SLB
JC/DRAWN BY: TCM/TCM
A/E OF RECORD: SLB
CAD FILE: AE201-06016
PROJECT NO: 06016
DATE: 7-9-07

SHEET TITLE:
EXTERIOR ELEVATIONS

SHEET No:
AE201

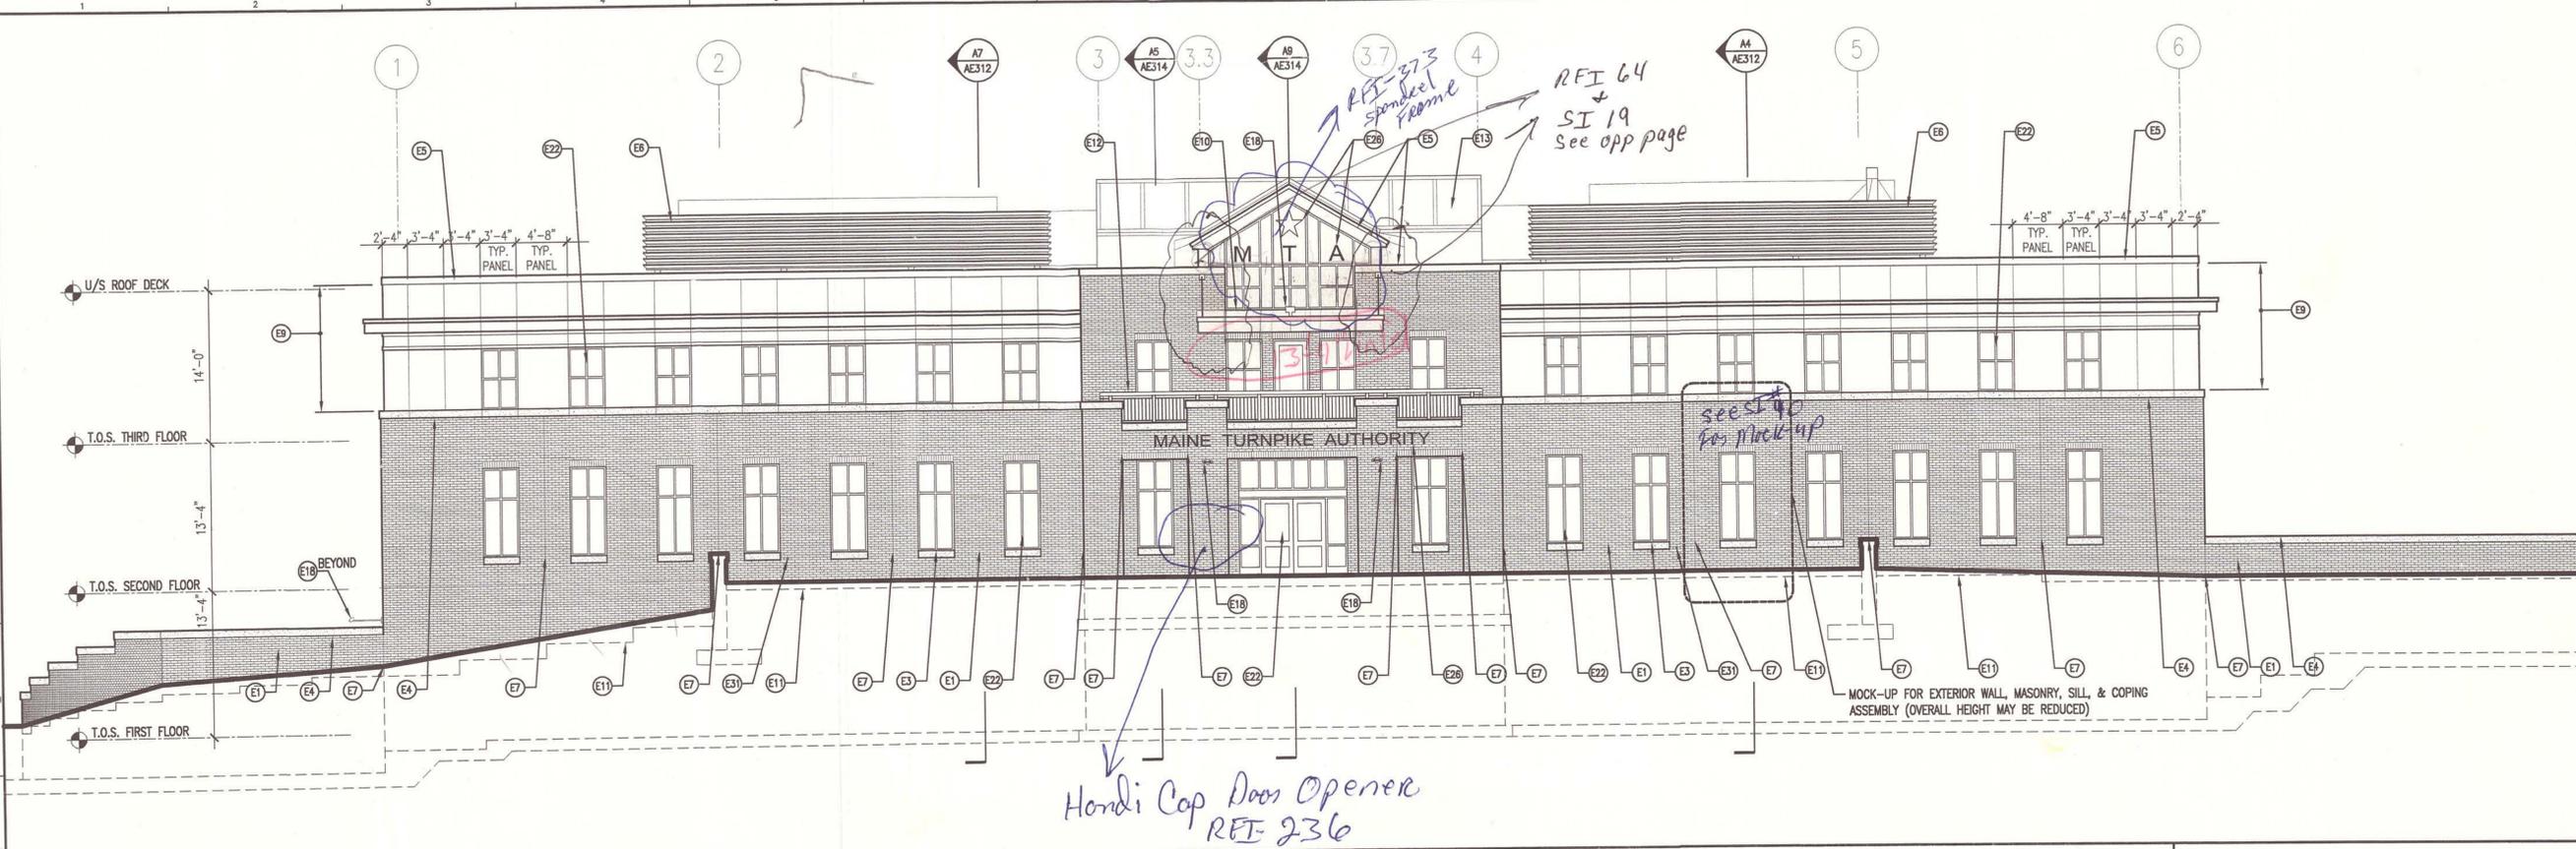

G1 EXTERIOR ELEVATION - SOUTH



A1 EXTERIOR ELEVATION - WEST


GENERAL NOTES:

1. SEE G101 FOR PROJECT GENERAL NOTES.

ELEVATION KEY NOTES:

- E1 FACE BRICK MASONRY
- E2 FACE BRICK SOLDIER COURSE
- E3 GRANITE SILL, RE: A7/AE332 FOR PROFILES
- E4 GRANITE COPING, RE: A7/AE332 FOR PROFILES
- E5 METAL FASCIA
- E6 MECHANICAL EQUIPMENT SCREEN
- E7 MASONRY EXPANSION JOINT
- E8 STANDING SEAM METAL ROOF
- E9 METAL-FACED COMPOSITE WALL PANEL ASSEMBLY
- E10 METAL-FACED COMPOSITE FASCIA
- E11 BRICK SHELF
- E12 METAL GUARDRAIL (HANDRAIL @ SITE STAIR), RE: A1/AE544 FOR BALCONY RAIL ELEVATIONS
- E13 FIBERGLASS SANDWICH PANEL SKYLIGHT ASSEMBLY
- E14 RECESSED FACE BRICK AT MASONRY OPENING
- E15 METAL FLASHING
- E16 METAL-FACED COMPOSITE WALL PANEL KNEEWALL
- E17 EQUIPMENT PAD
- E18 SURFACE-MOUNTED UPLIGHT FIXTURE
- E19 SANITARY DRAIN PENETRATION
- E20 STORM DRAIN PENETRATION
- E21 ELECTRICAL OUTLET
- E22 ALUMINUM-FRAMED STOREFRONT/ENTRANCE SYSTEM
- E23 OVERHEAD COILING DOOR
- E24 SUPPLY WATER PENETRATION
- E25 ELECTRICAL DUCT BANK
- E26 RAISED METAL SIGNAGE
- E27 APPLIED SIGNAGE
- E28 GAS METER
- E29 MECHANICAL CONNECTION
- E30 HOLLOW METAL DOOR & FRAME WITH ALUMINUM-FRAME TRANSOM ABOVE
- E31 WALL HYDRANT
- E32 FIRE DEPARTMENT CONNECTION & BELL
- E33 SITE IRRIGATION PENETRATION
- E34 FIRE PROTECTION PENETRATION
- E35 MECHANICAL AIR INTAKES
- E36 FIRE PROTECTION DRAIN
- E37 BRICK VENT
- E38 DOCK BUMPERS




**AS BUILT
Owner Copy**

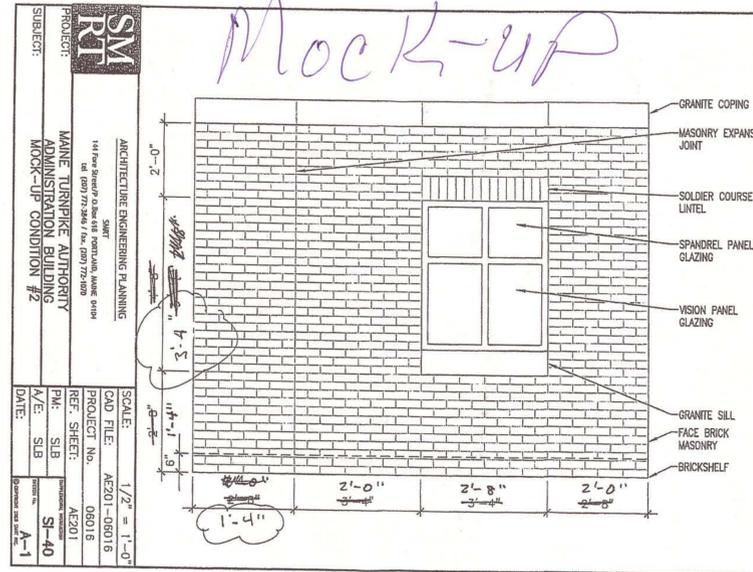


SM RT
ARCHITECTURE ENGINEERING PLANNING
144 Fore Street/P.O. Box 618 PORTLAND, MAINE 04104
tel. (207) 772-3846 / fax. (207) 772-1870

PROJECT: MAINE TURNPIKE AUTHORITY ADMINISTRATION BUILDING
SUBJECT: MOCK-UP CONDITION #2


SCALE: 1/2" = 1'-0"
CAD FILE: AE201-08016
PROJECT No.: 08016
REF. SHEET: AE201
PM: SLB
A/E: SLB
DATE: 3-11-08

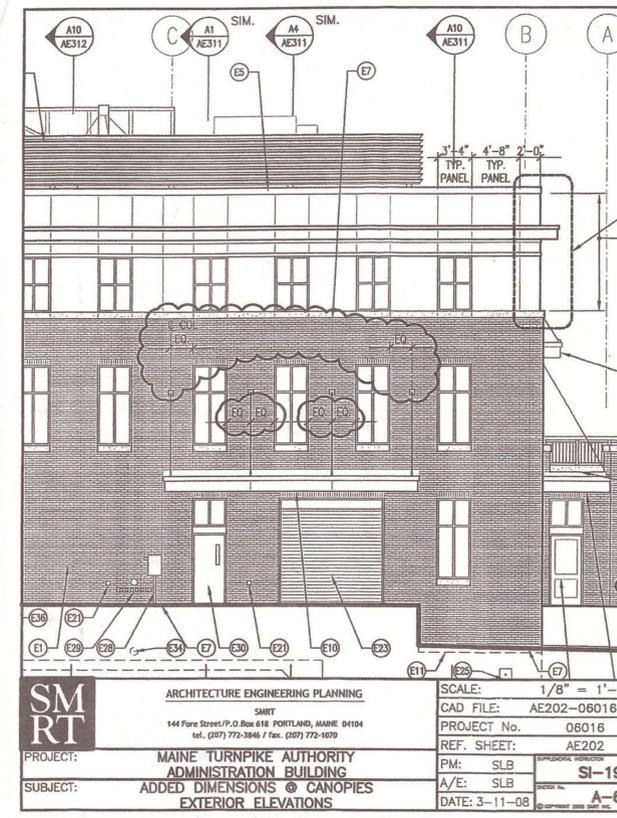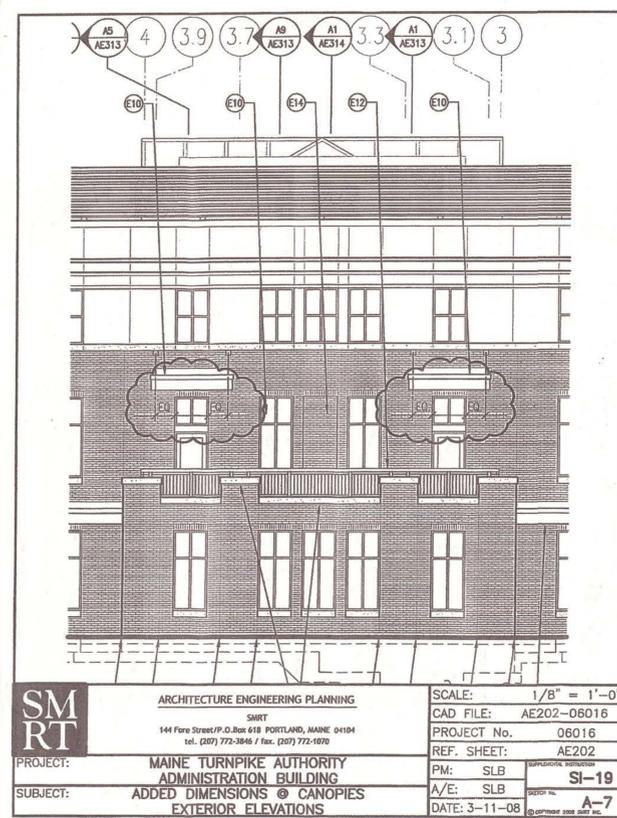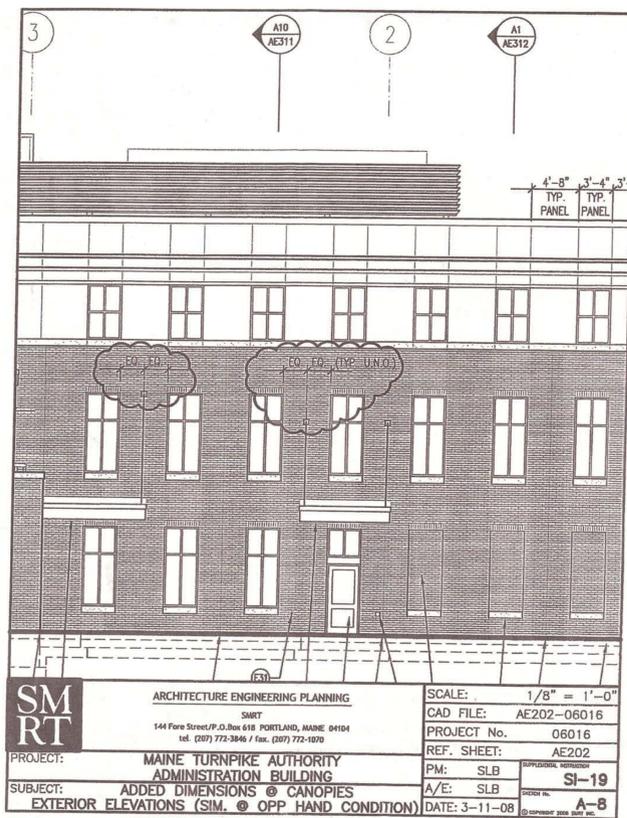

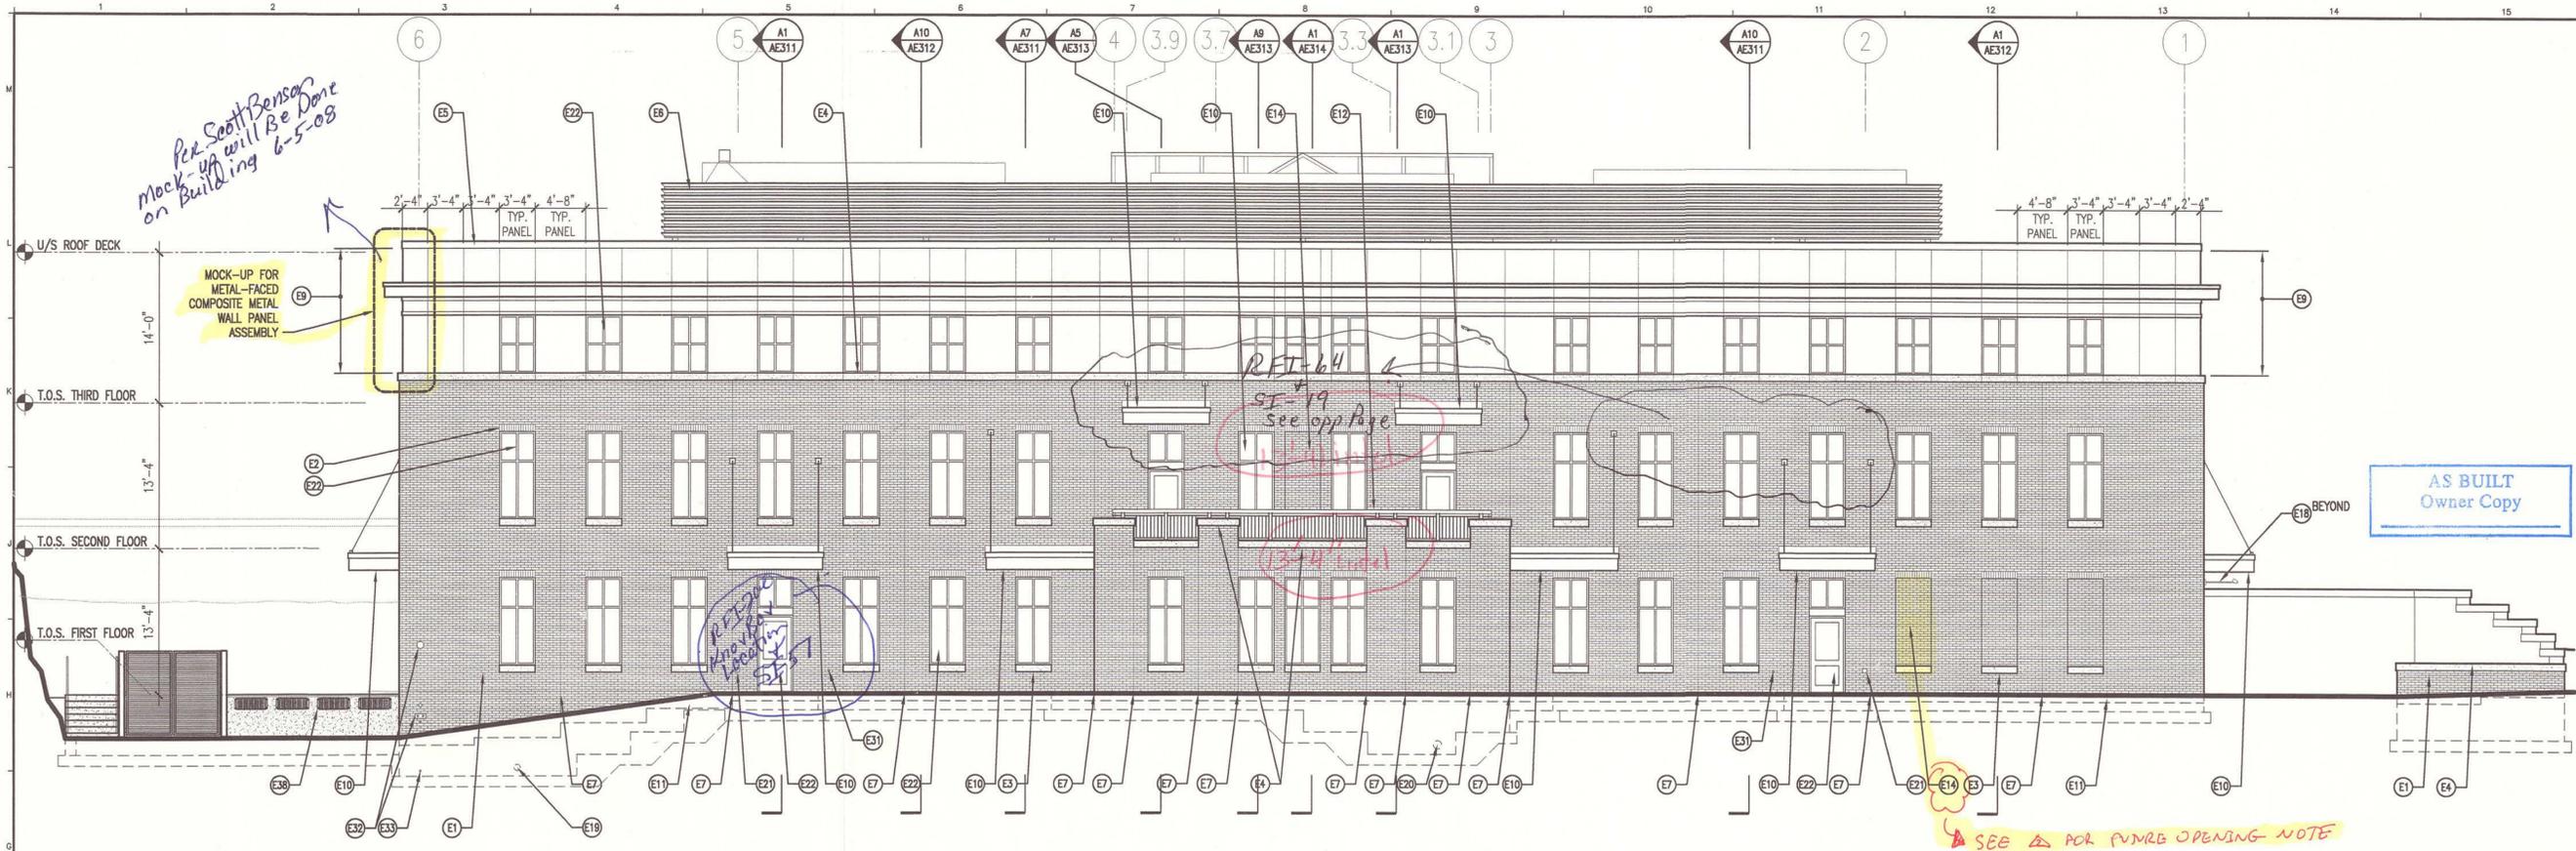

G1 EXTERIOR ELEVATION - NORTH

1/8" = 1'-0"

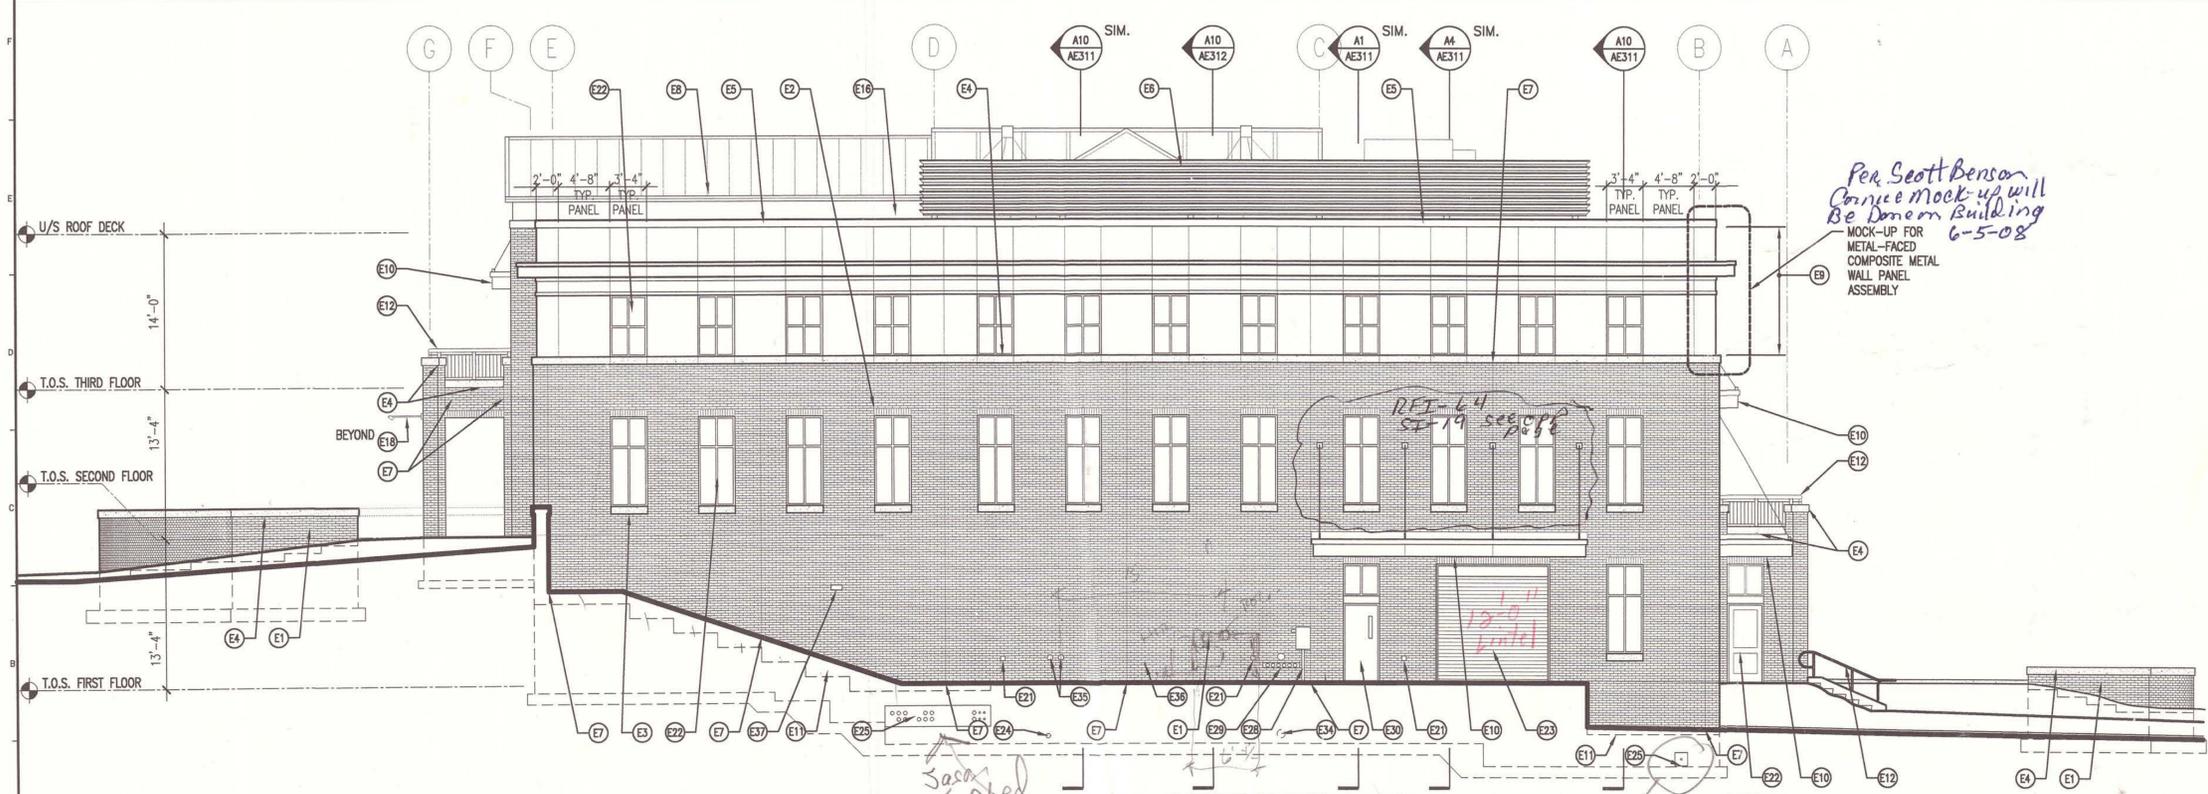

A1 EXTERIOR ELEVATION - EAST

1/8" = 1'-0"

GENERAL NOTES:

1. SEE G101 FOR PROJECT GENERAL NOTES.

ELEVATION KEY NOTES:

- E1 FACE BRICK MASONRY
- E2 FACE BRICK SOLDIER COURSE
- E3 GRANITE SILL, RE: A7/AE32 FOR PROFILES
- E4 GRANITE COPING, RE: A7/AE32 FOR PROFILES
- E5 METAL FASCIA
- E6 MECHANICAL EQUIPMENT SCREEN
- E7 MASONRY EXPANSION JOINT
- E8 STANDING SEAM METAL ROOF
- E9 METAL-FACED COMPOSITE WALL PANEL ASSEMBLY
- E10 METAL-FACED COMPOSITE FASCIA
- E11 BRICK SHELFF
- E12 METAL GUARDRAIL (HANDRAIL @ SITE STAIR), RE: A1/AE344 FOR BALCONY RAIL ELEVATIONS
- E13 FIBERGLASS SANDWICH PANEL SKYLIGHT ASSEMBLY
- E14 RECESSED FACE BRICK AT MASONRY OPENING
- E15 METAL FLASHING
- E16 METAL-FACED COMPOSITE WALL PANEL KNEEWALL
- E17 EQUIPMENT PAD
- E18 SURFACE-MOUNTED UPLIGHT FIXTURE
- E19 SANITARY DRAIN PENETRATION
- E20 STORM DRAIN PENETRATION
- E21 ELECTRICAL OUTLET
- E22 ALUMINUM-FRAMED STOREFRONT/ENTRANCE SYSTEM
- E23 OVERHEAD COILING DOOR
- E24 SUPPLY WATER PENETRATION
- E25 ELECTRICAL DUCT BANK
- E26 RAISED METAL SIGNAGE
- E27 APPLIED SIGNAGE
- E28 GAS METER
- E29 MECHANICAL CONNECTION
- E30 HOLLOW METAL DOOR & FRAME WITH ALUMINUM-FRAME TRANSOM ABOVE
- E31 WALL HYDRANT
- E32 FIRE DEPARTMENT CONNECTION & BELL
- E33 SITE IRRIGATION PENETRATION
- E34 FIRE PROTECTION PENETRATION
- E35 MECHANICAL AIR INTAKES
- E36 FIRE PROTECTION DRAIN
- E37 BRICK VENT
- E38 DOCK BUMPERS



ARCHITECTURE ENGINEERING PLANNING
 SMRT
 144 Fore Street P.O. Box 618
 Portland, Maine 04104
 tel. (207) 772-3846
 fax. (207) 772-1070



PROJECT TITLE:
**MAINE TURNPIKE AUTHORITY
 ADMINISTRATION BUILDING**
 PORTLAND, MAINE

CURRENT ISSUE STATUS:
ISSUED FOR BIDDING/CONSTRUCTION
 7-9-07


REV	DESCRIPTION	DATE
0	BIDDING/CONSTRUCTION	7-9-07

GRAPHIC SCALE:
 0" = 1'

SCALE: AS NOTED
 PROJECT MANAGER: SLB
 JC/DRAWN BY: TCM/TCM
 A/E OF RECORD: SLB
 CAD FILE: AE202-06016
 PROJECT NO: 06016
 DATE: 7-9-07

SHEET TITLE:
**EXTERIOR
 ELEVATIONS**

SHEET No. **AE202**

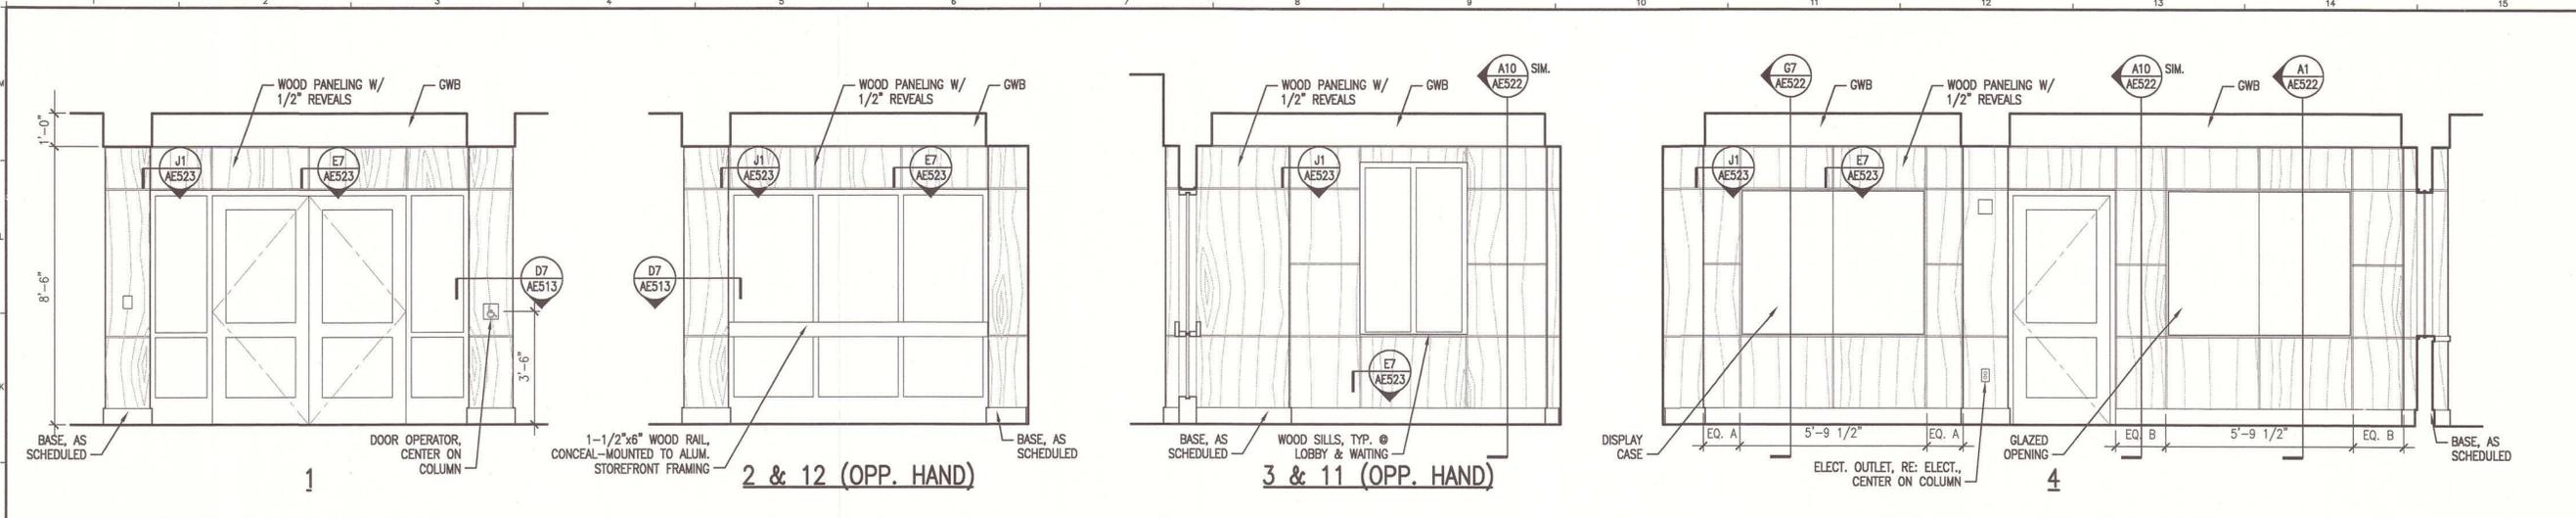


J1 INTERIOR ELEVATION - LOBBY 210 & WAITING 214/215

3/8" = 1'-0"

GENERAL NOTES:


1. SEE G101 FOR PROJECT GENERAL NOTES.

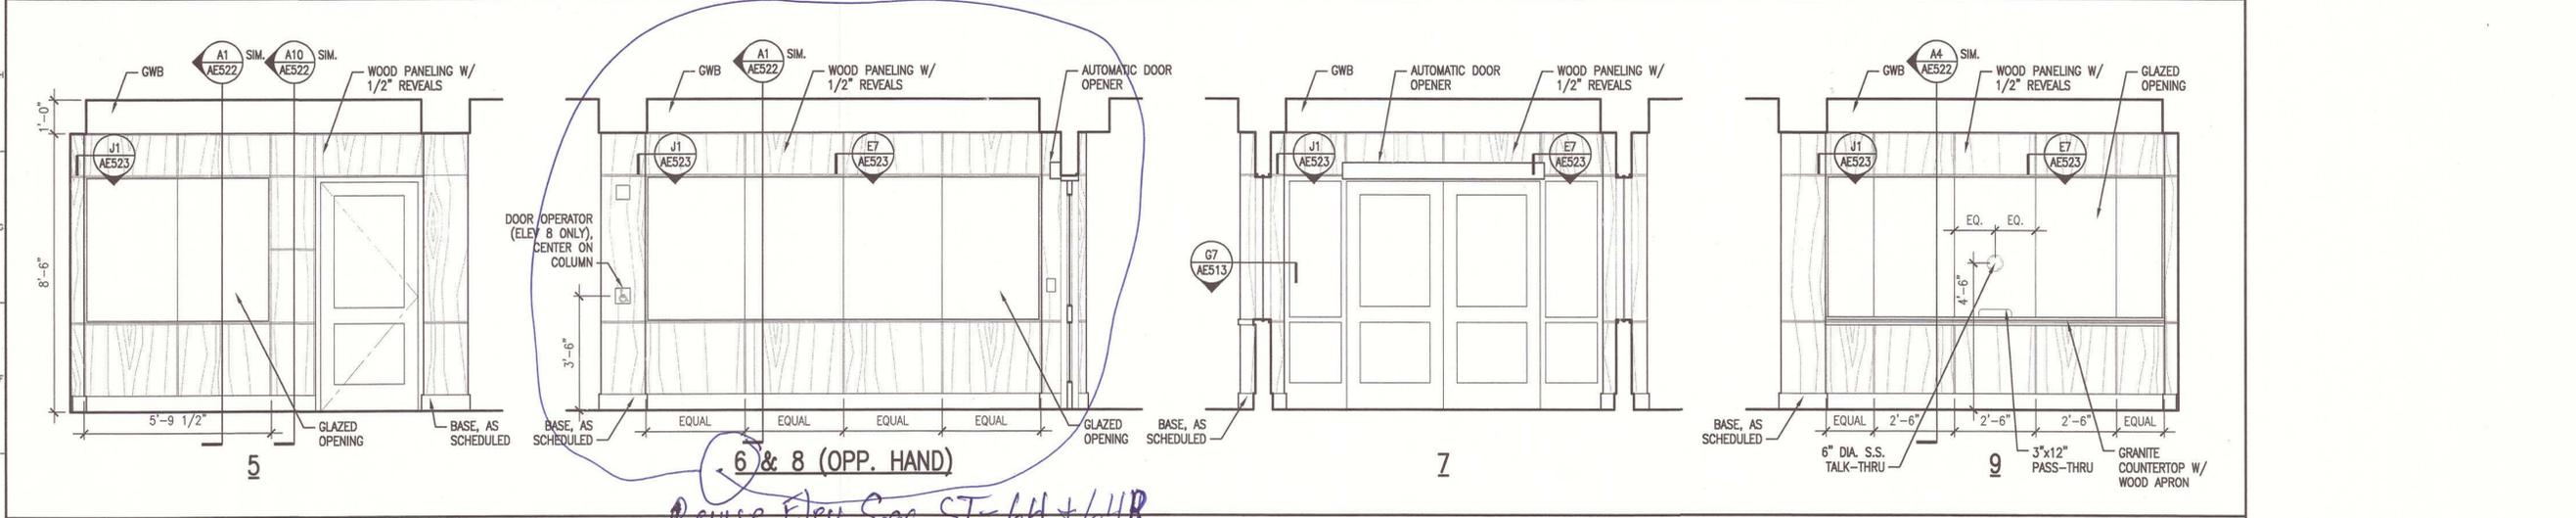

E1 INTERIOR ELEVATION - LOBBY 210


3/8" = 1'-0"

Revise Elev. See SI-64 + 64R

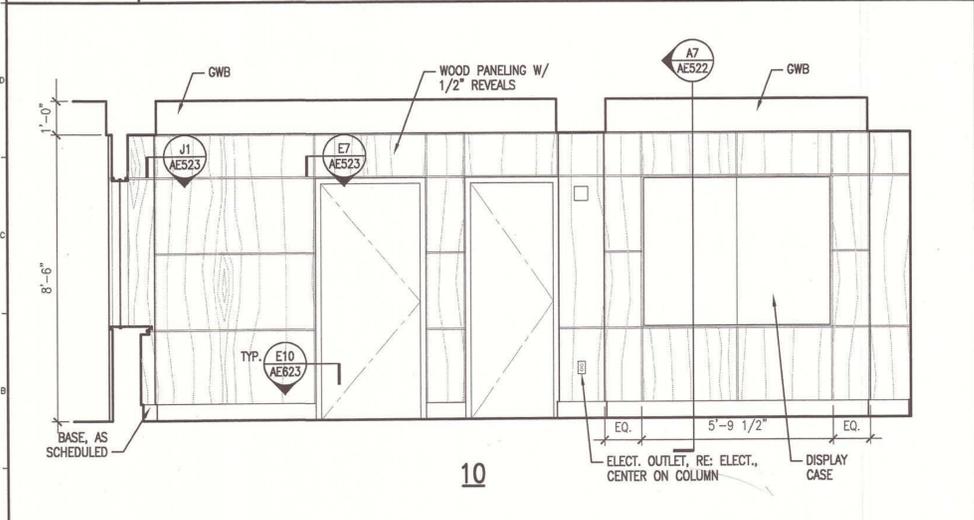

A1 INTERIOR ELEVATION - LOBBY 210 & WAITING 214

3/8" = 1'-0"

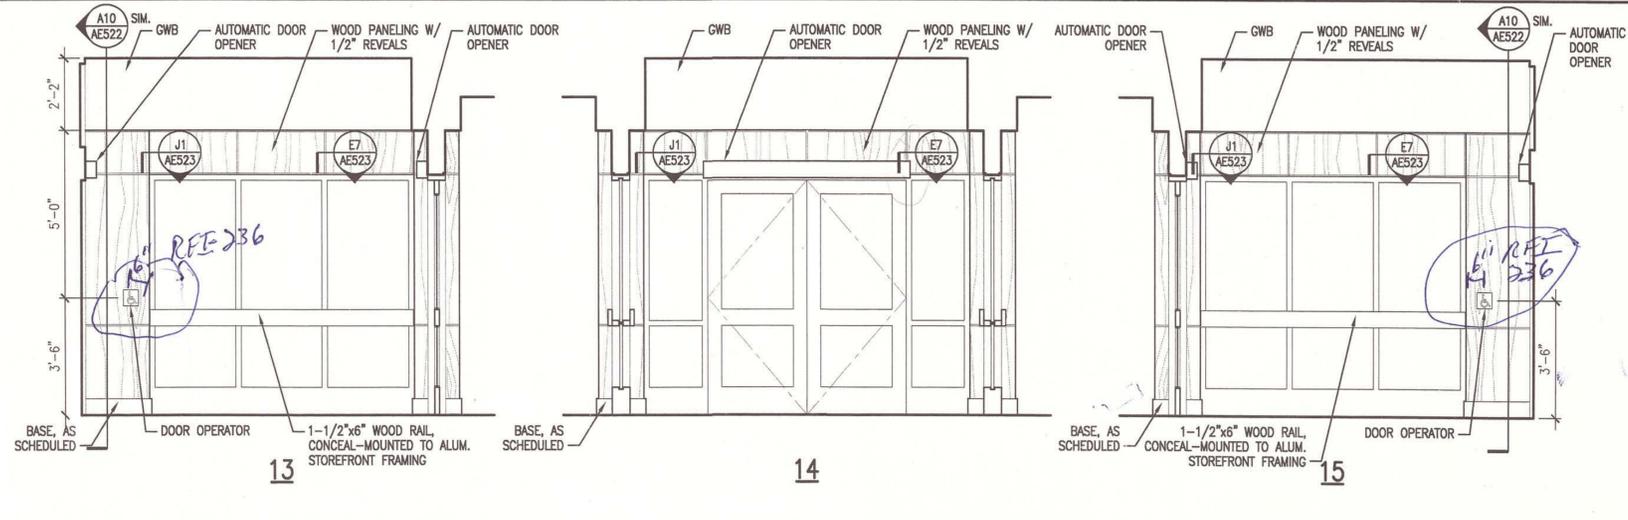


A6 INTERIOR ELEVATION - VESTIBULE 211

3/8" = 1'-0"



ARCHITECTURE ENGINEERING PLANNING
SWRT
144 Fore Street/P.O. Box 618
Portland, Maine 04104
tel. (207) 772-3846
fax. (207) 772-1070

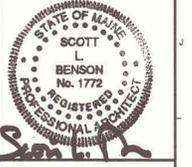

AS BUILT
Owner Copy

MAINE TURNPIKE AUTHORITY
ADMINISTRATION BUILDING
PORTLAND, MAINE
ISSUED FOR BIDDING/CONSTRUCTION
7-9-07


PROJECT TITLE:	MAINE TURNPIKE AUTHORITY ADMINISTRATION BUILDING
CURRENT ISSUE STATUS:	ISSUED FOR BIDDING/CONSTRUCTION
DATE:	7-9-07
DESCRIPTION:	
REV:	
GRAPHIC SCALE:	0" = 1"
SCALE:	AS NOTED
PROJECT MANAGER:	SLB
JC/DRAWN BY:	TCM/DC
A/E OF RECORD:	SLB
CAD FILE:	AE211-06016
PROJECT NO.:	06016
DATE:	7-9-07
SHEET TITLE:	INTERIOR ELEVATIONS
SHEET No.:	AE211

GENERAL NOTES:

1. SEE G101 FOR PROJECT GENERAL NOTES.

**SM
RT**

ARCHITECTURE ENGINEERING PLANNING
SMRT
144 Fore Street/P.O. Box 618
Portland, Maine 04104
tel. (207) 772-3846
fax. (207) 772-1070

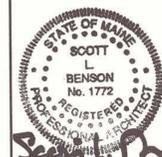

AS BUILT
Owner Copy

PROJECT TITLE:
**MAINE TURNPIKE AUTHORITY
ADMINISTRATION BUILDING**
PORTLAND, MAINE

CURRENT ISSUE STATUS:
ISSUED FOR BIDDING/CONSTRUCTION
7-9-07


REV	DESCRIPTION	DATE
0	BIDDING/CONSTRUCTION	7-9-07

GRAPHIC SCALE:
0" = 1"


SCALE: AS NOTED
PROJECT MANAGER: SLB
JC/DRAWN BY: TCM/DG
A/E OF RECORD: SLB
CAD FILE: AE212-06016
PROJECT NO: 06016
DATE: 7-9-07

SHEET TITLE:
INTERIOR ELEVATIONS


SHEET No.
AE212

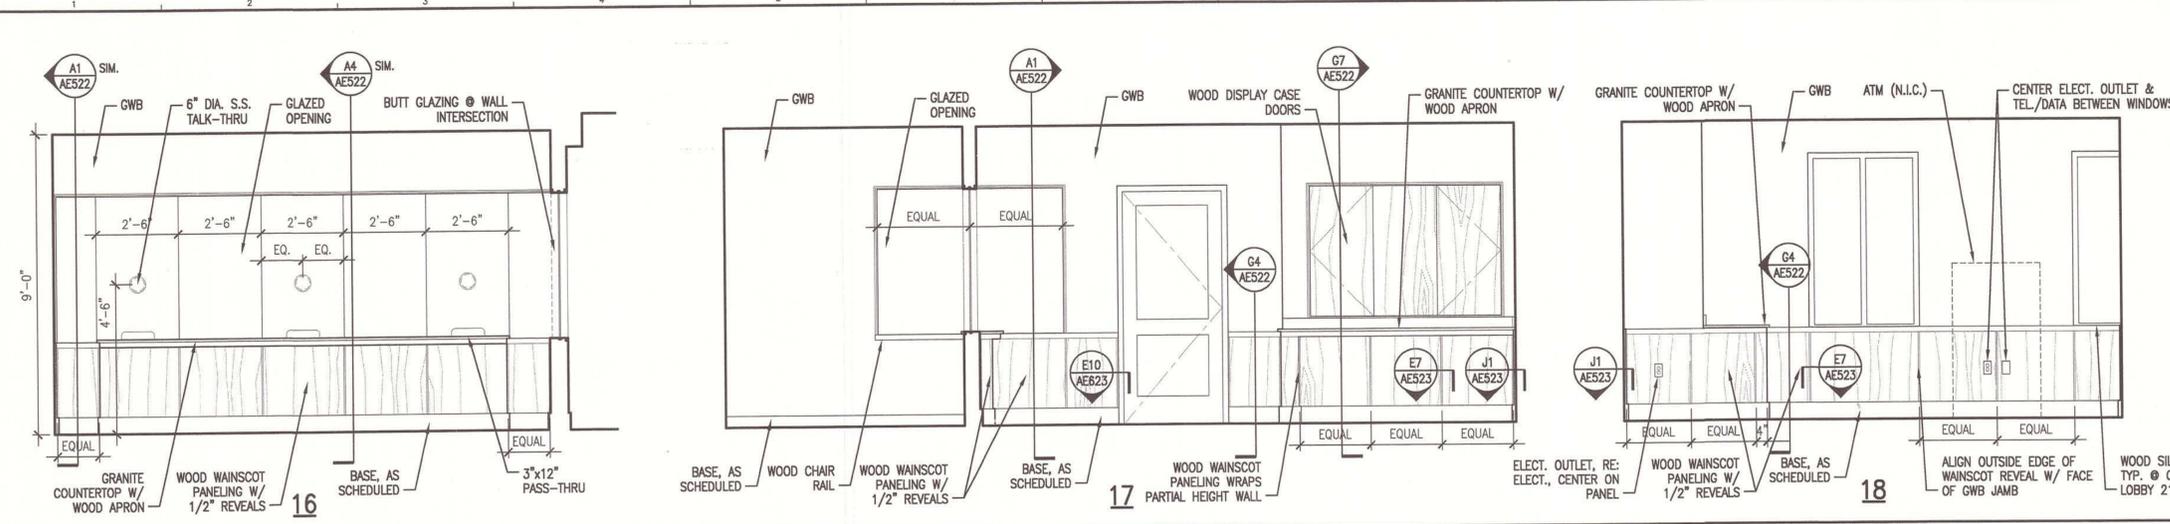


J1 INTERIOR ELEVATION - C.S. LOBBY 216
3/8" = 1'-0"

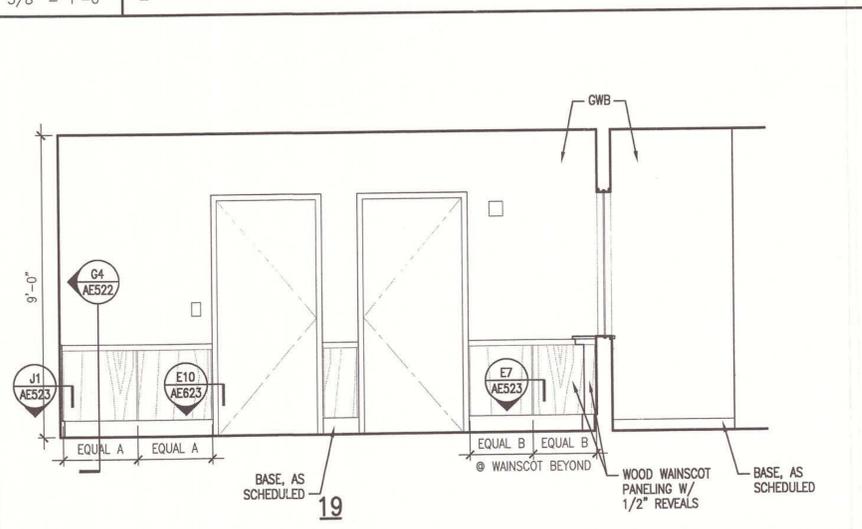


E1 INTERIOR ELEVATION - C.S. LOBBY 216
3/8" = 1'-0"

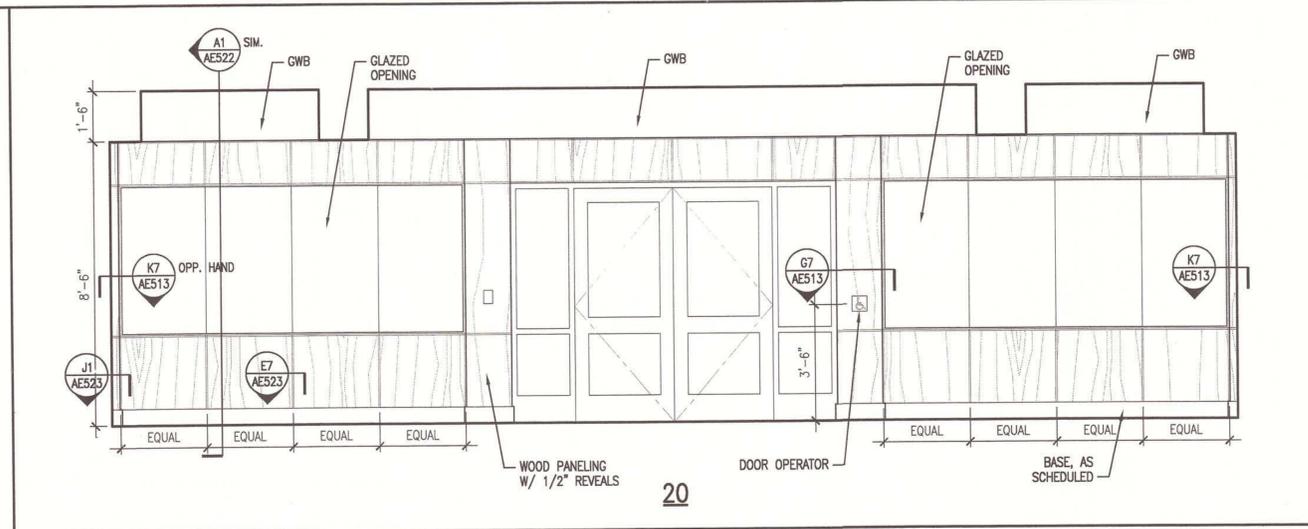


E6 INTERIOR ELEVATION - HALL 201a
3/8" = 1'-0"

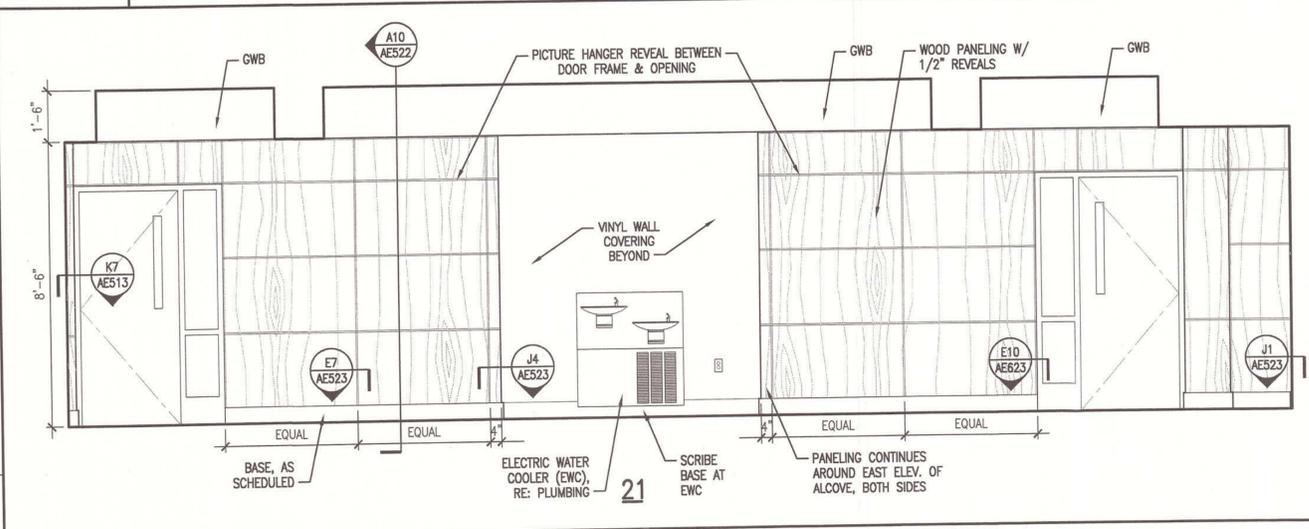

A1 INTERIOR ELEVATION - HALL 201a
3/8" = 1'-0"

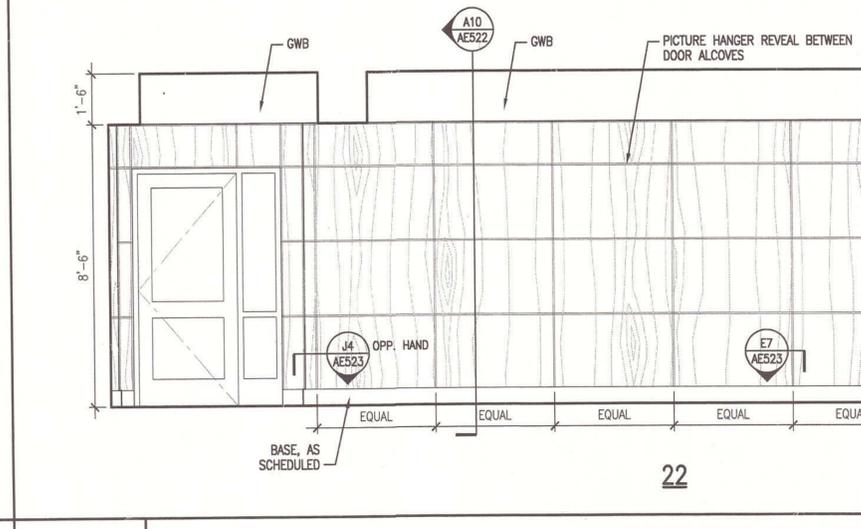

A8 INTERIOR ELEVATION - HALL 201b
3/8" = 1'-0"

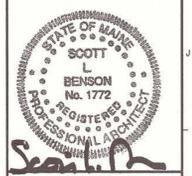

AS BUILT
Owner Copy

PROJECT TITLE:
**MAINE TURNPIKE AUTHORITY
ADMINISTRATION BUILDING**
PORTLAND, MAINE


ISSUED FOR BIDDING/CONSTRUCTION
7-9-07

REV	DESCRIPTION	DATE
0	BIDDING/CONSTRUCTION	7-9-07


GRAPHIC SCALE:
0" 1"

SCALE: AS NOTED
PROJECT MANAGER: SLB
JC/DRAWN BY: TCM/DG
A/E OF RECORD: SLB
CAD FILE: AE214-06016
PROJECT NO: 06016
DATE: 7-9-07

SHEET TITLE:
INTERIOR ELEVATIONS
SHEET No.
AE214

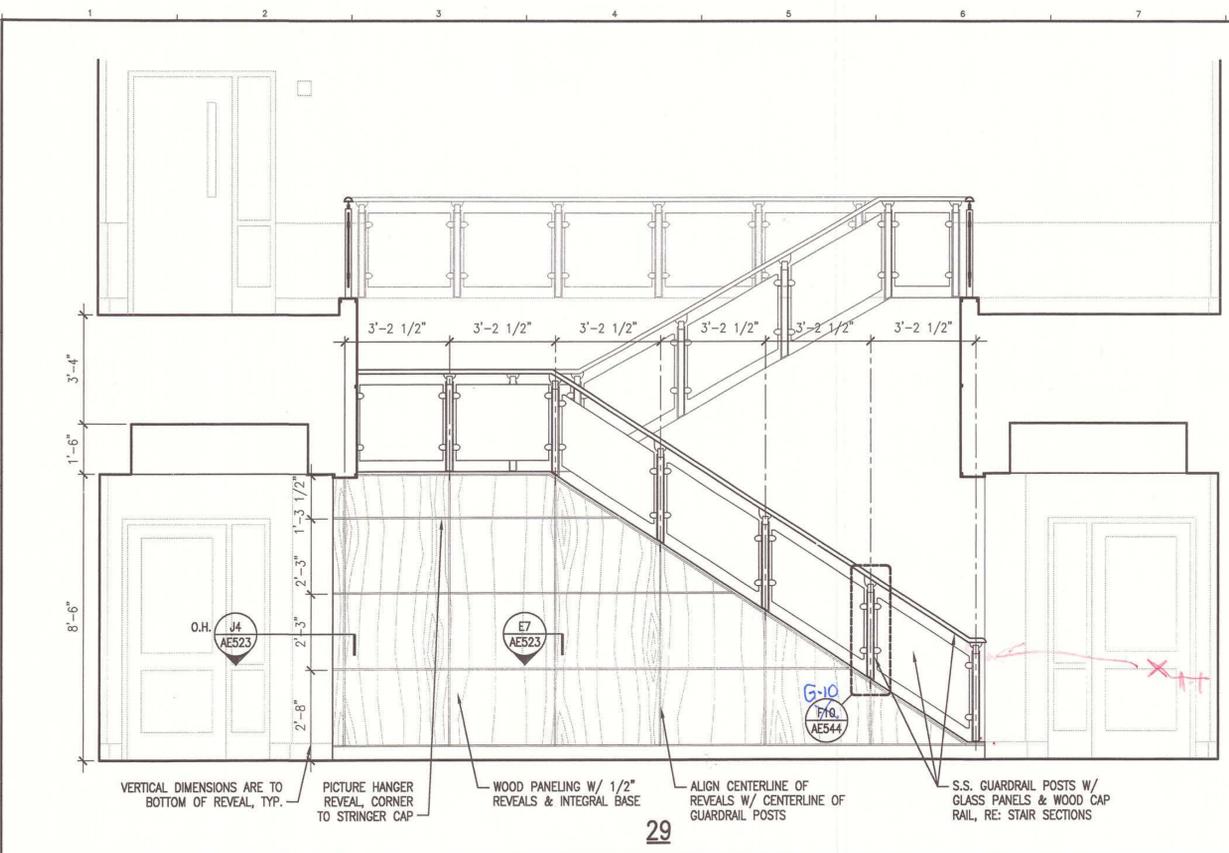


29

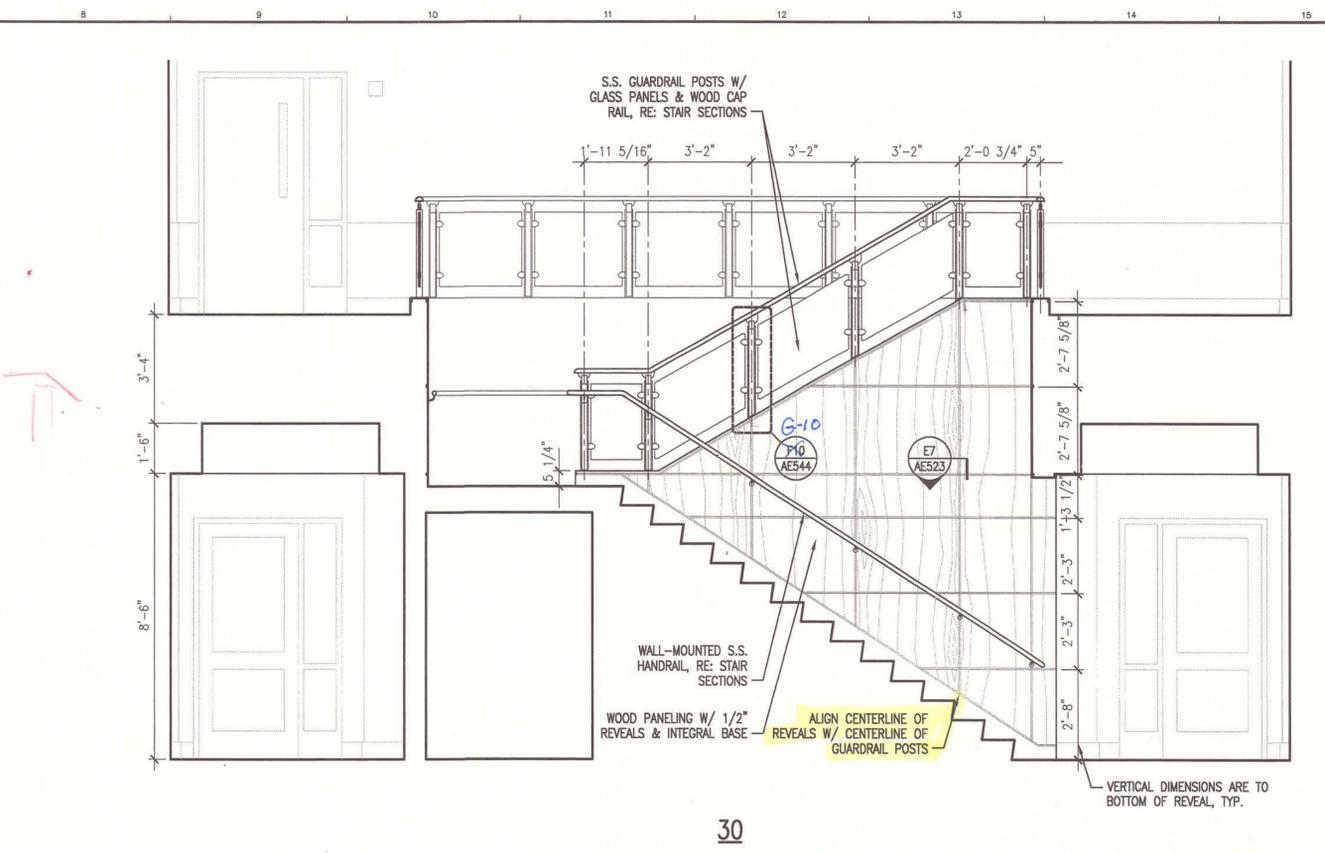


30

J1 INTERIOR ELEVATION - HALL 201a
3/8" = 1'-0"

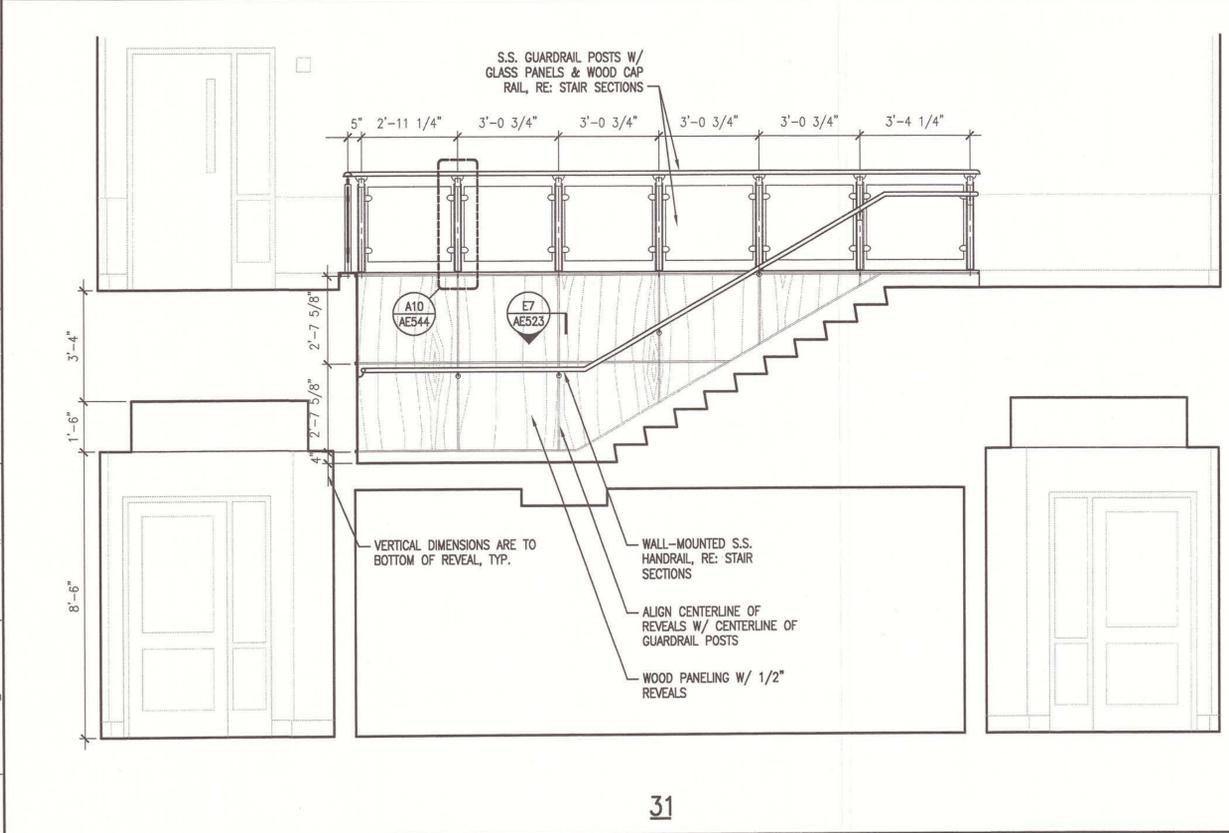


31

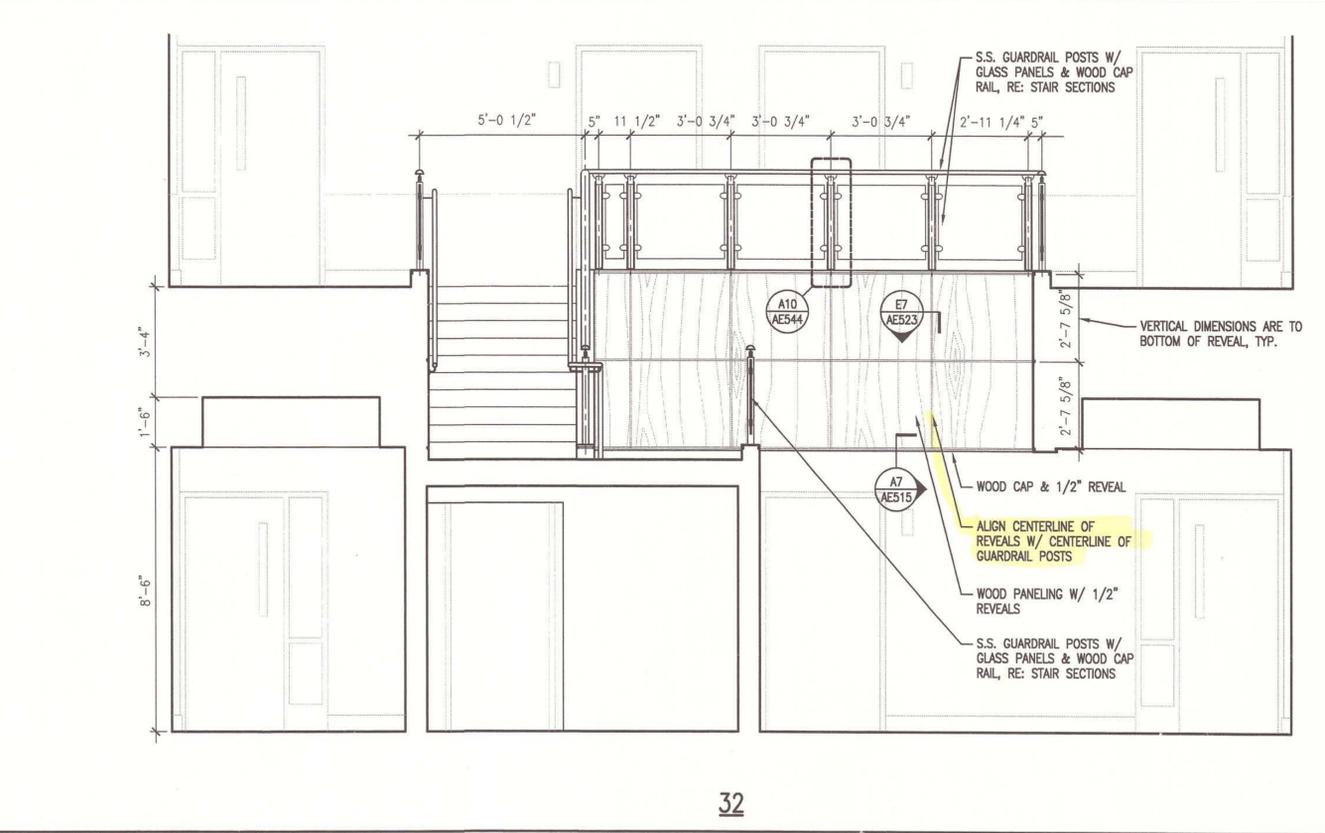


32

A1 INTERIOR ELEVATION - GALLERY 301
3/8" = 1'-0"

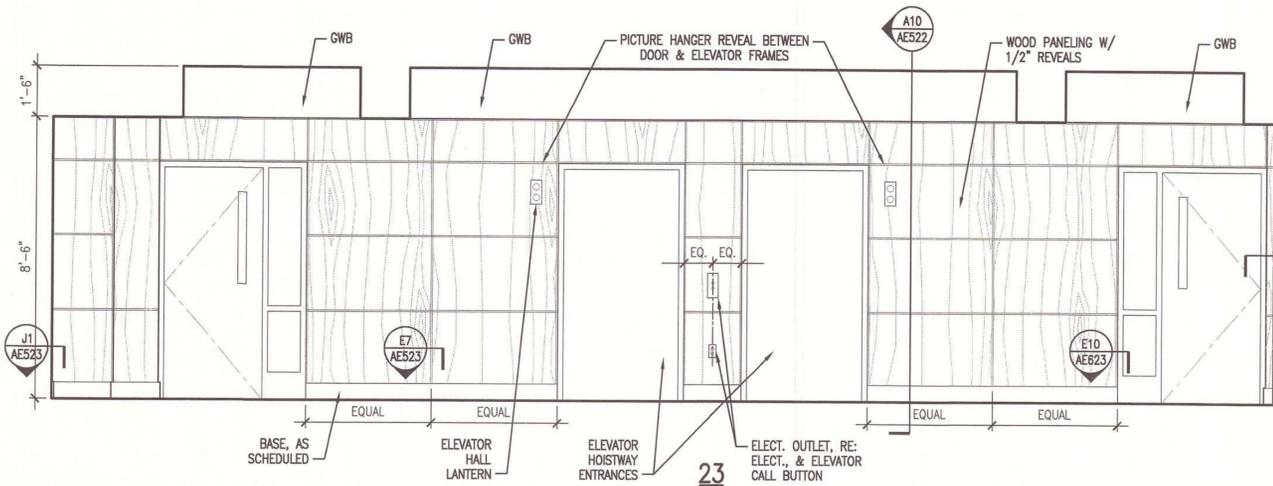


J1 INTERIOR ELEVATION - HALL 201a

3/8" = 1'-0"

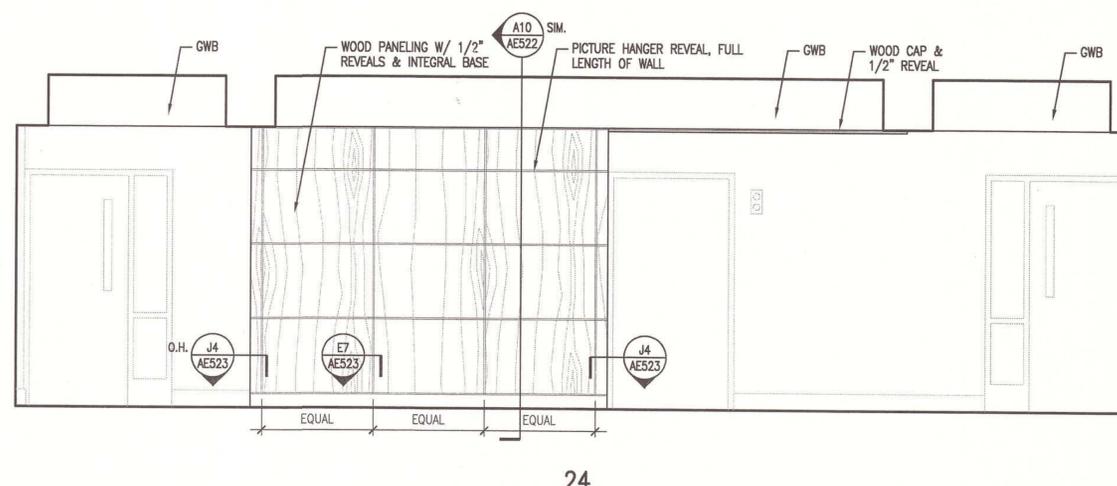


24

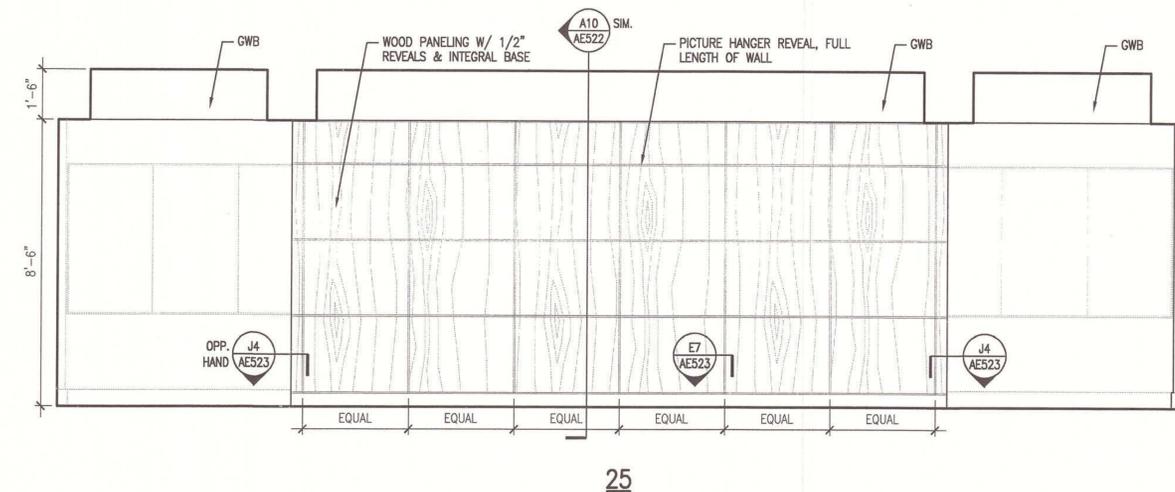

E1 INTERIOR ELEVATION - HALL 201b

3/8" = 1'-0"

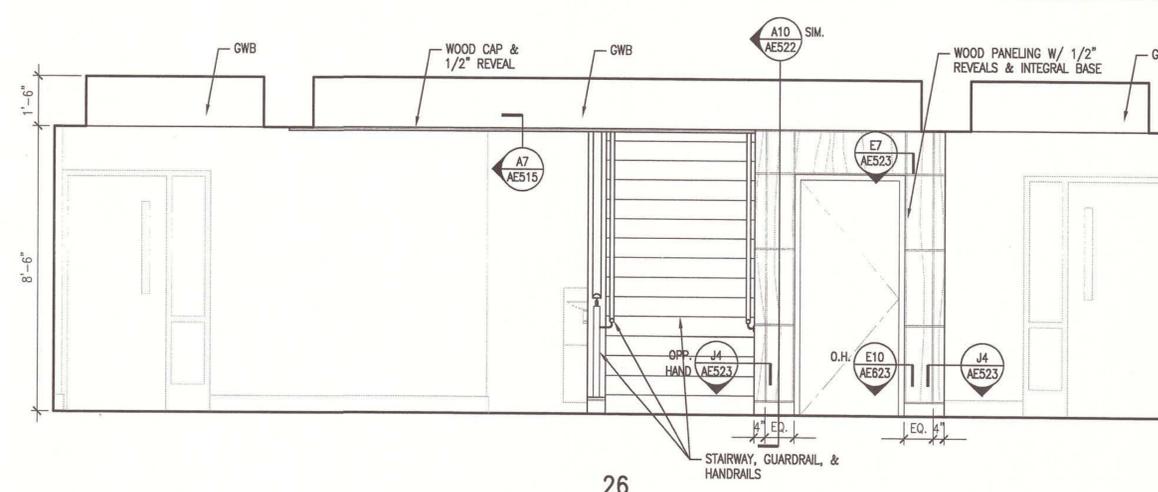

E8 INTERIOR ELEVATION - HALL 201a

3/8" = 1'-0"

For Elevator Wood Panels
see SI-29

GENERAL NOTES:

- SEE G101 FOR PROJECT GENERAL NOTES.
- PANELS ARE DIMENSIONED TO BOTTOM OF JOINT. TYPICAL PANEL JOINT DIM. IS 1/2"

AS BUILT
Owner Copy


A1 INTERIOR ELEVATION - ELEVATOR

3/8" = 1'-0"

SM
RT

ARCHITECTURE ENGINEERING PLANNING

SMRT
144 Fore Street P.O. Box 618
Portland, Maine 04104
tel. (207) 772-3846
fax. (207) 772-1070

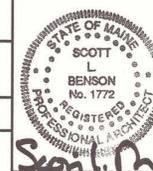

MAINE TURNPIKE AUTHORITY
ADMINISTRATION BUILDING
PORTLAND, MAINE

ISSUED FOR BIDDING/CONSTRUCTION
7-9-07

PROJECT TITLE

CURRENT ISSUE STATUS:

REV	DESCRIPTION	DATE
0	BIDDING/CONSTRUCTION	7-9-07

GRAPHIC SCALE:



SCALE: AS NOTED
PROJECT MANAGER: SLB
JC/DRAWN BY: TCM/DG
A/E OF RECORD: SLB
CAD FILE: AE213-06016
PROJECT NO: 06016
DATE: 7-9-07

SHEET TITLE:
INTERIOR
ELEVATIONS


SHEET No. AE213

GENERAL NOTES:

1. SEE G1001 FOR PROJECT GENERAL NOTES.



ARCHITECTURE ENGINEERING PLANNING
 SMRT
 144 Fore Street, P.O. Box 418
 Portland, Maine 04104
 Tel. (207) 772-3846
 Fax. (207) 772-1070

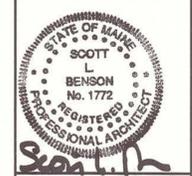

PROJECT TITLE:
**MAINE TURNPIKE AUTHORITY
 ADMINISTRATION BUILDING**
 PORTLAND, MAINE

CURRENT ISSUE STATUS:
**ISSUED FOR BIDDING/CONSTRUCTION
 7-9-07**


REV	DESCRIPTION	DATE
0	BIDDING/CONSTRUCTION	7-9-07

GRAPHIC SCALE:
 0" 1"

SCALE: AS NOTED
 PROJECT MANAGER: SLB
 JC/DRAWN BY: TCM/DG
 A/E OF RECORD: SLB
 CAD FILE: AE215-06016
 PROJECT NO: 06016
 DATE: 7-9-07

SHEET TITLE:
INTERIOR ELEVATIONS


SHEET No. **AE215**

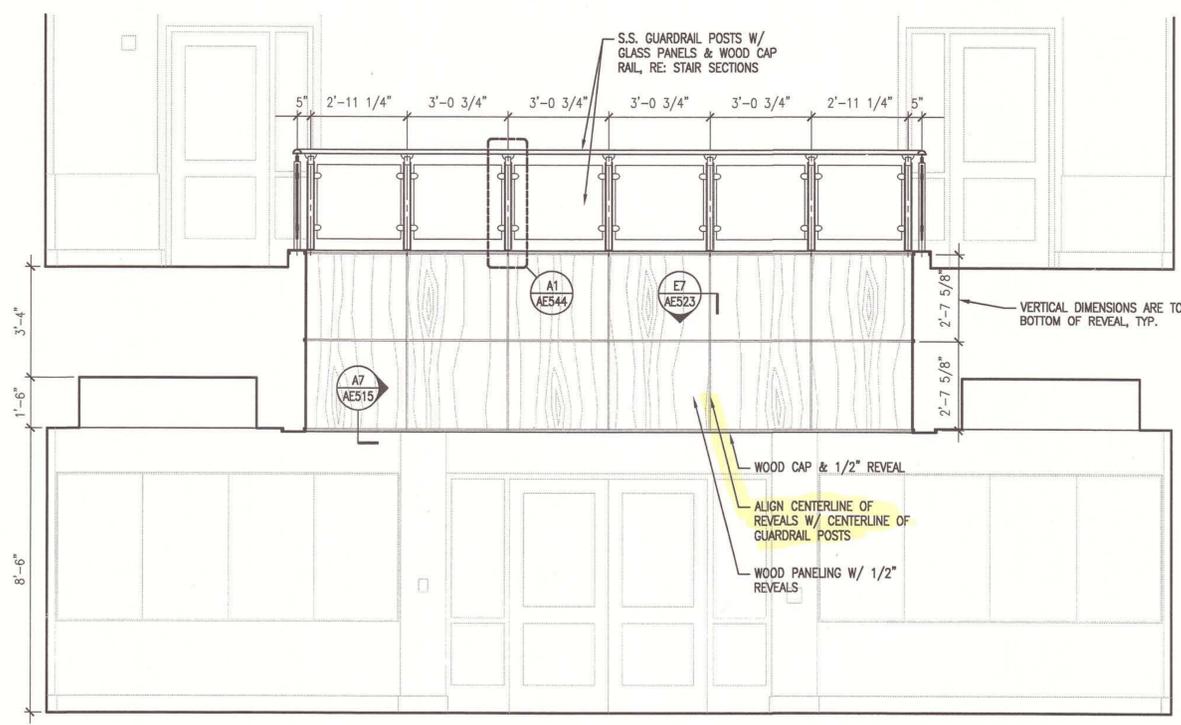

33

J6 INTERIOR ELEVATION - GALLERY 301

3/8" = 1'-0"

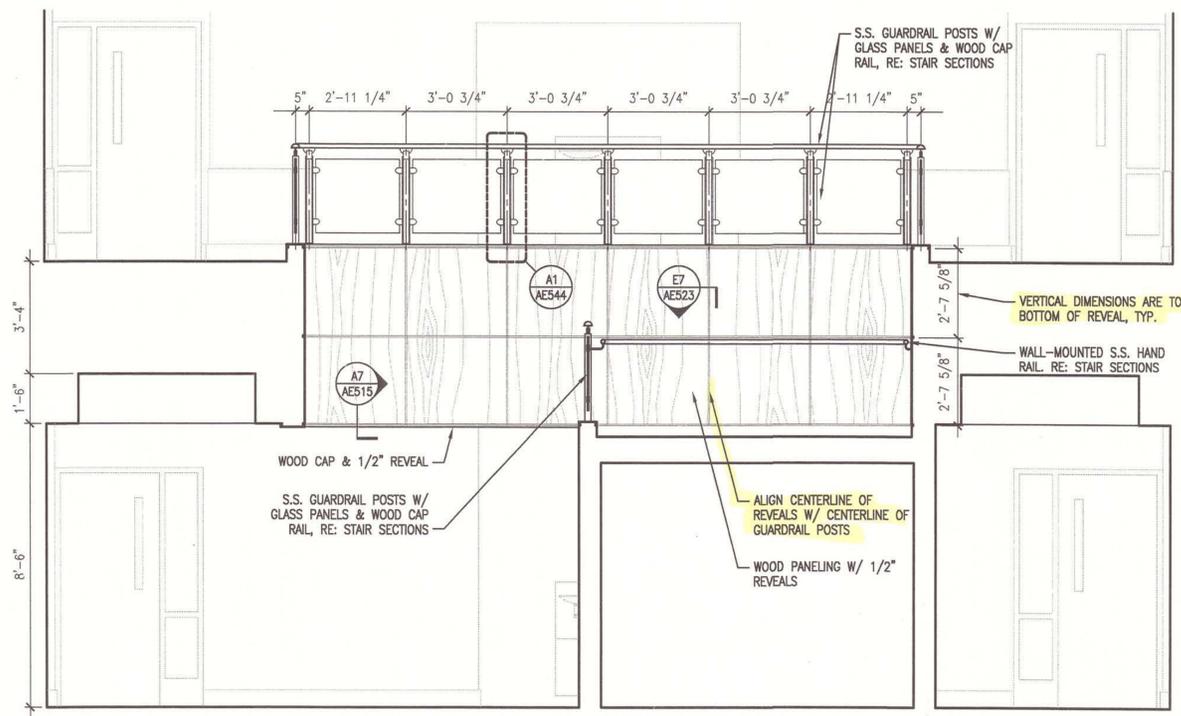

34

A6 INTERIOR ELEVATION - GALLERY 301


3/8" = 1'-0"

AS BUILT
 Owner Copy

J1 -

E1 -

A1 -

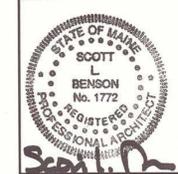



AS BUILT
 Owner Copy

PROJECT TITLE:
**MAINE TURNPIKE AUTHORITY
 ADMINISTRATION BUILDING**
 PORTLAND, MAINE
 CURRENT ISSUE STATUS:
ISSUED FOR BIDDING/CONSTRUCTION
7-9-07

REV	DESCRIPTION	DATE
0	BIDDING/CONSTRUCTION	7-9-07

GRAPHIC SCALE:
 0" 1"
 SCALE: AS NOTED
 PROJECT MANAGER: SLB
 JC/DRAWN BY: TCM/DG
 A/E OF RECORD: SLB
 CAD FILE: AE216-06016
 PROJECT NO: 06016
 DATE: 7-9-07



SHEET TITLE:
INTERIOR ELEVATIONS
 SHEET No. **AE216**

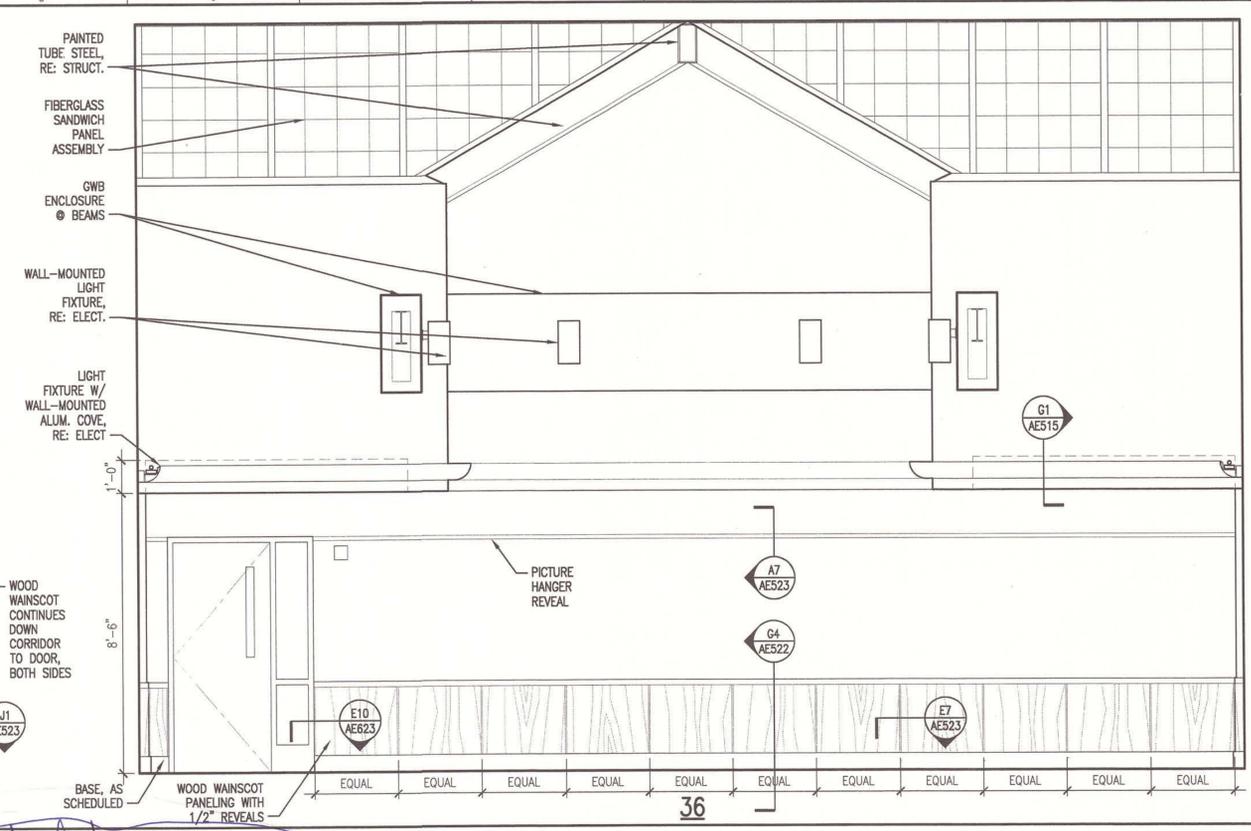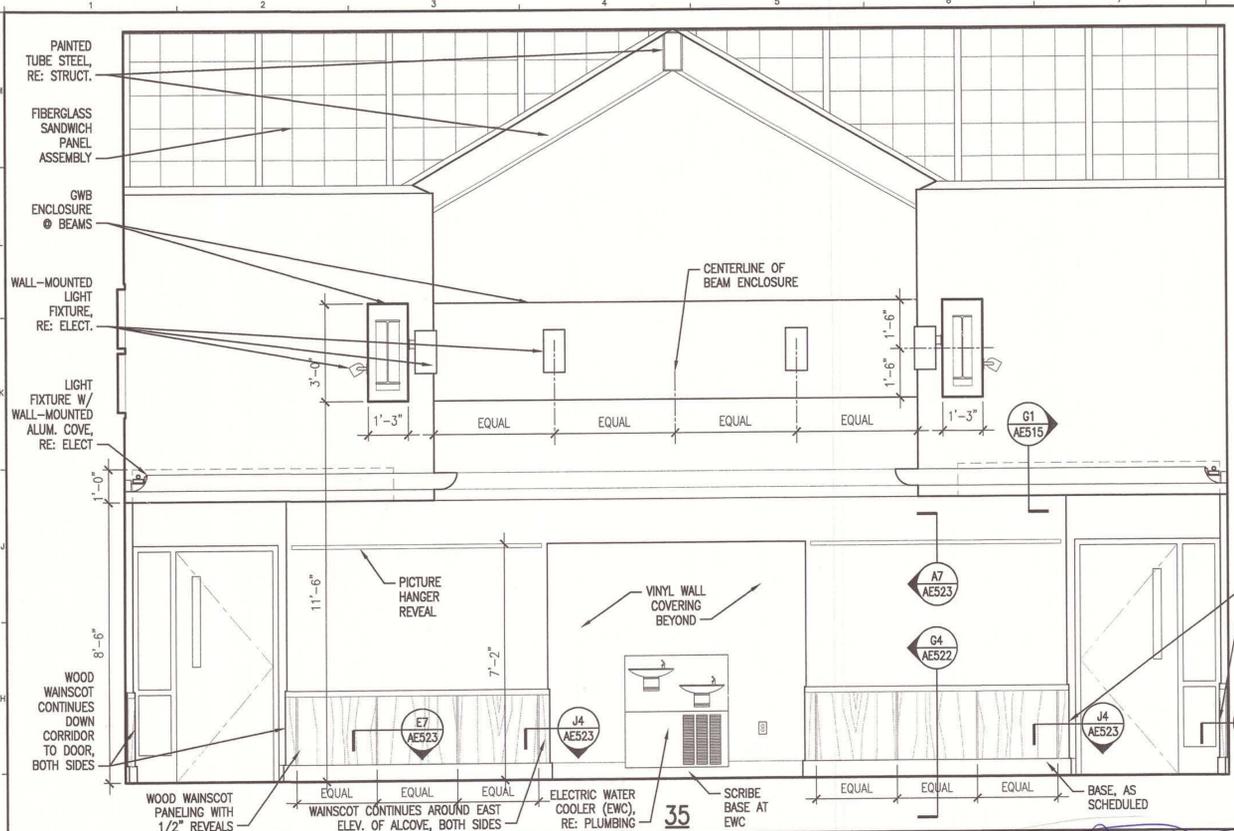

J1 INTERIOR ELEVATIONS - GALLERY 301
 3/8" = 1'-0"


36

*Paint schedule
 see SI# 60*

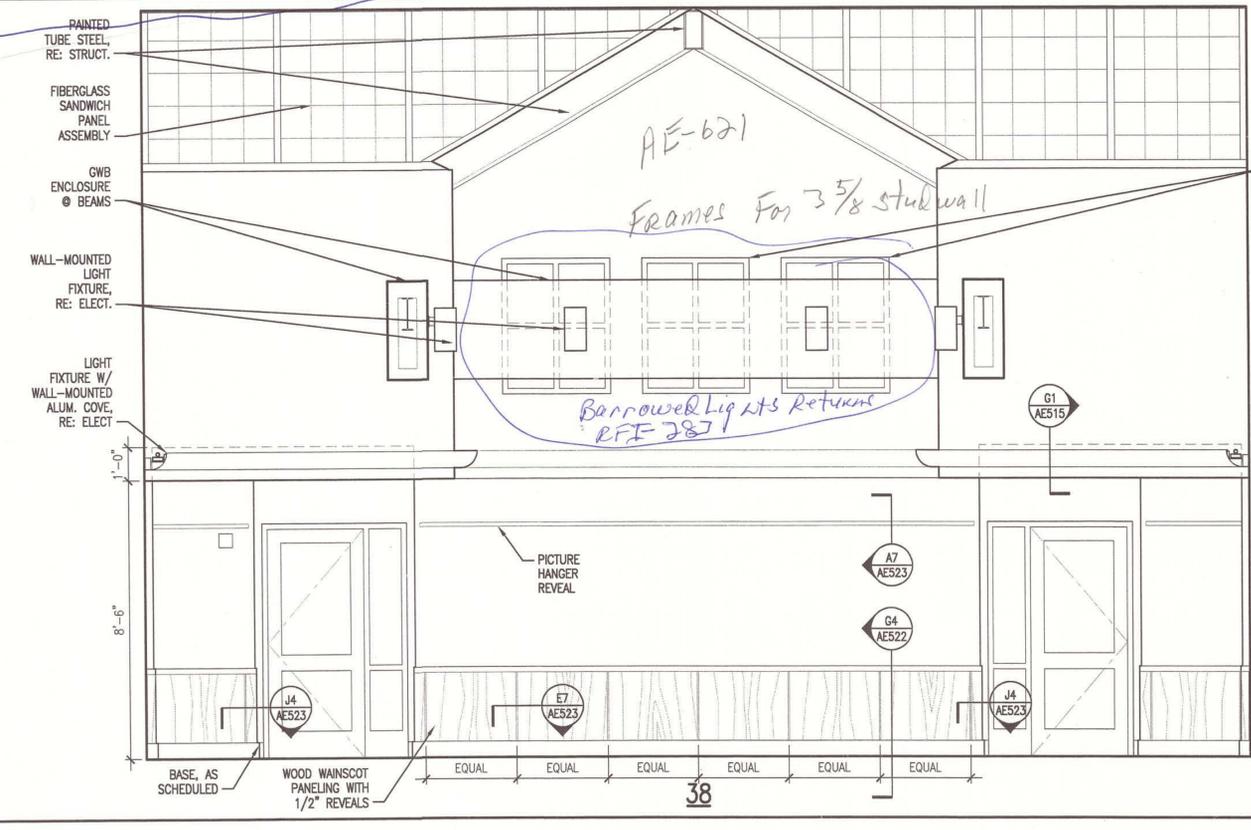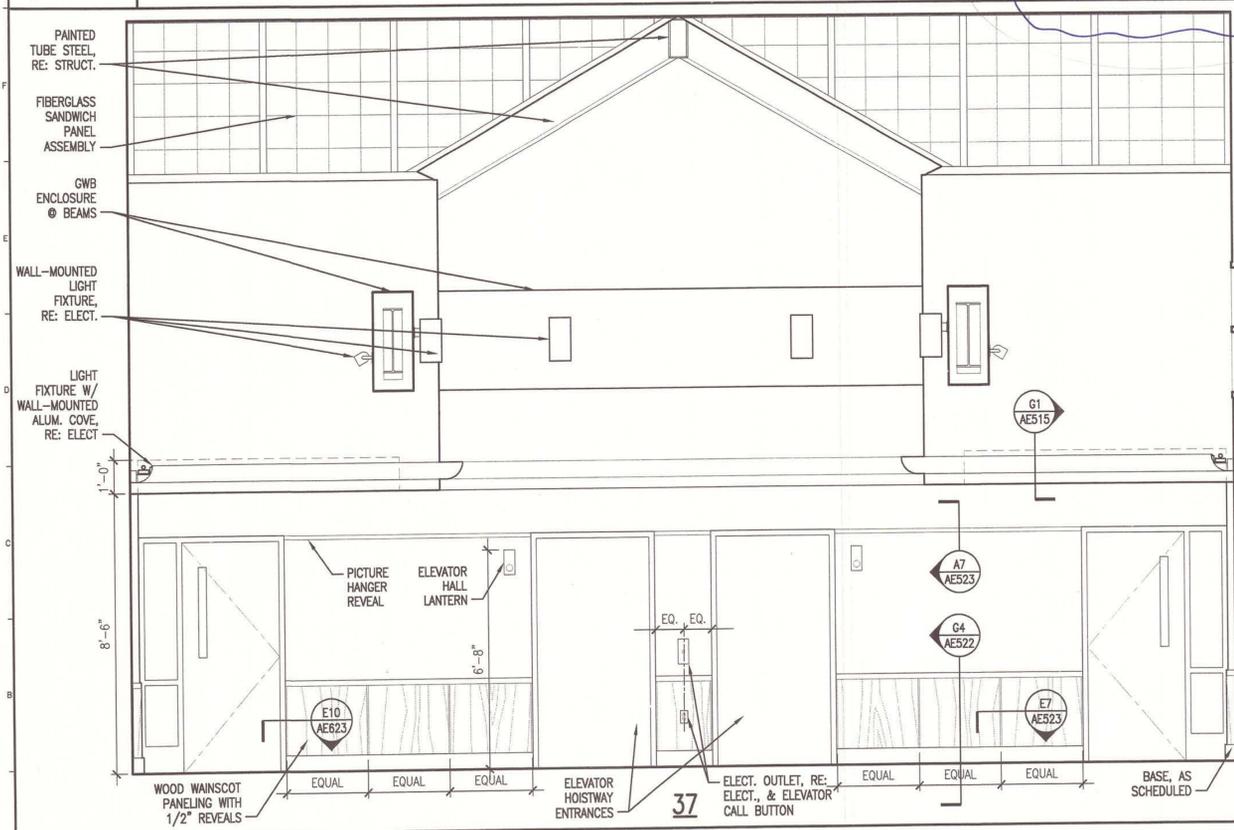


A1 INTERIOR ELEVATIONS - GALLERY 301
 3/8" = 1'-0"

37

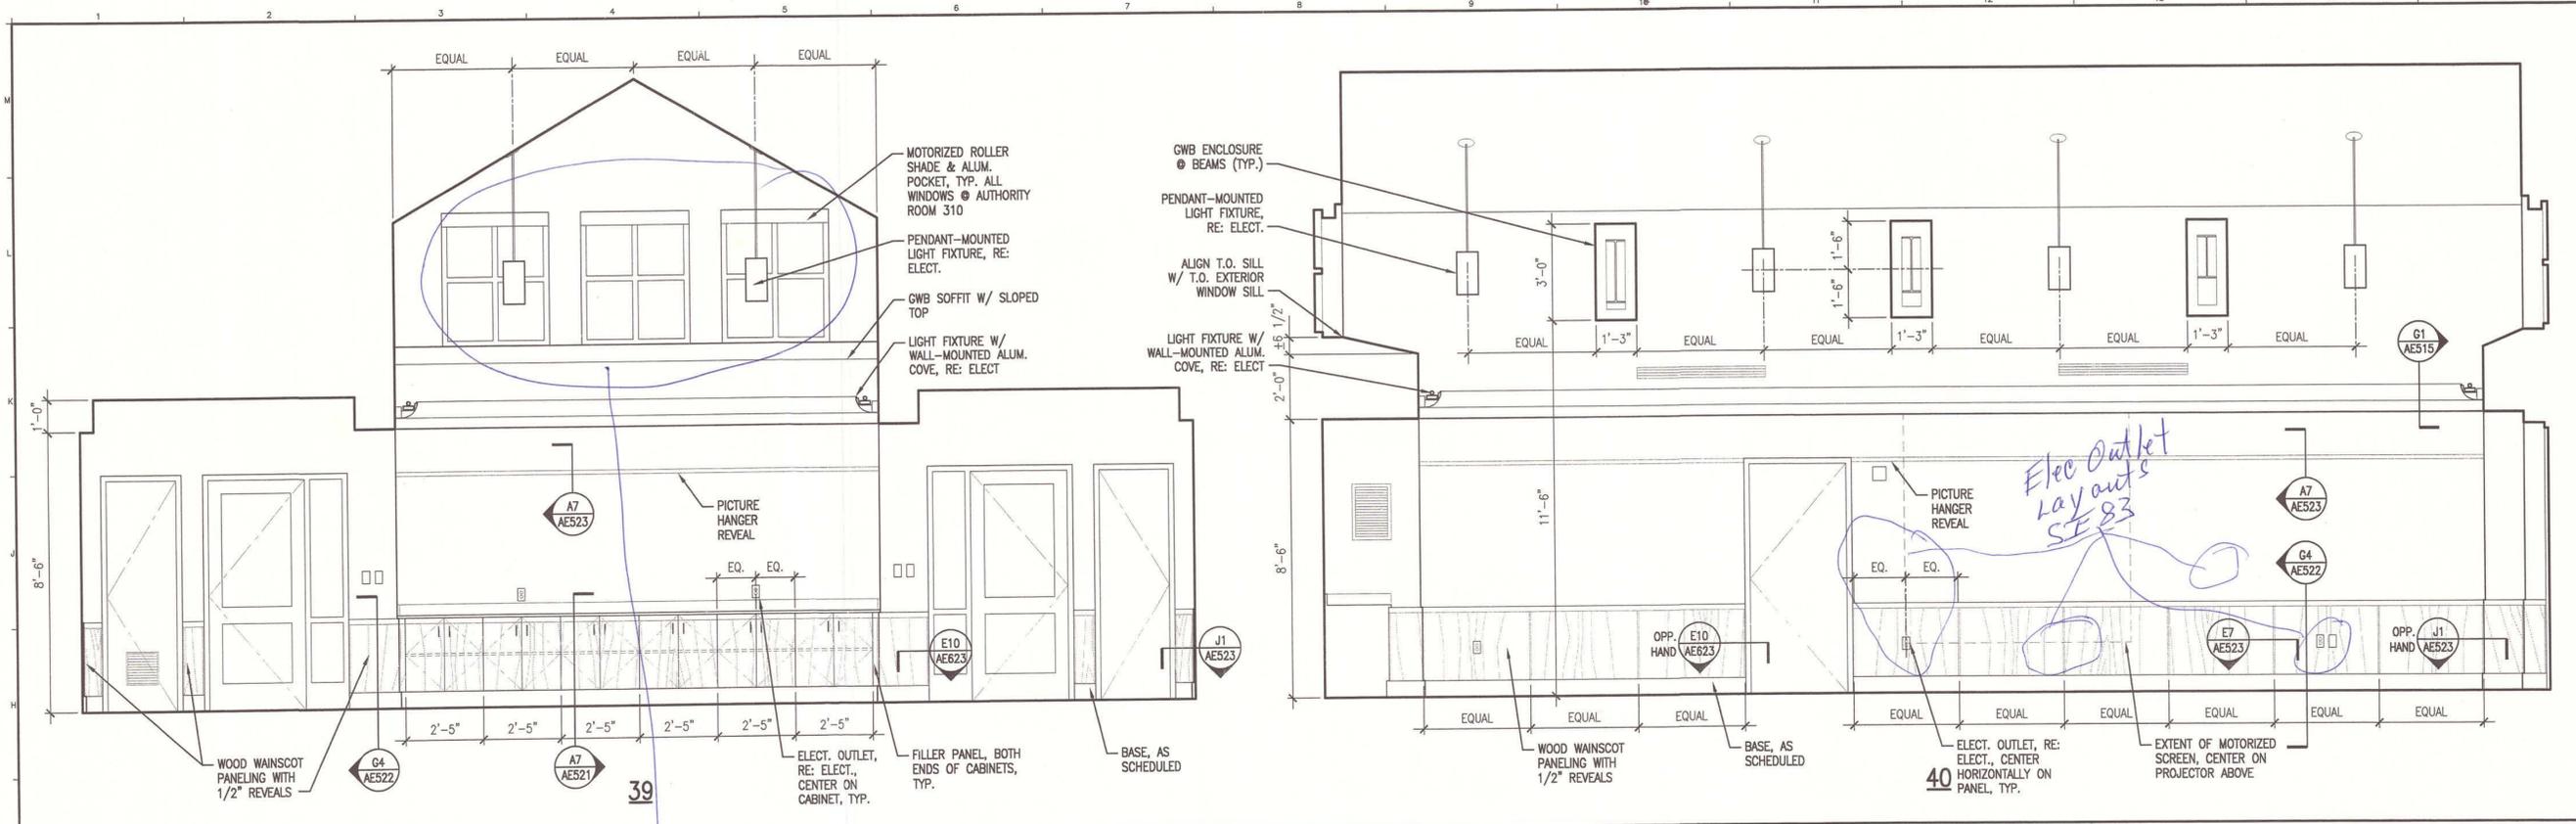


J1 INTERIOR ELEVATIONS - AUTHORITY ROOM 310
 3/8" = 1'-0"

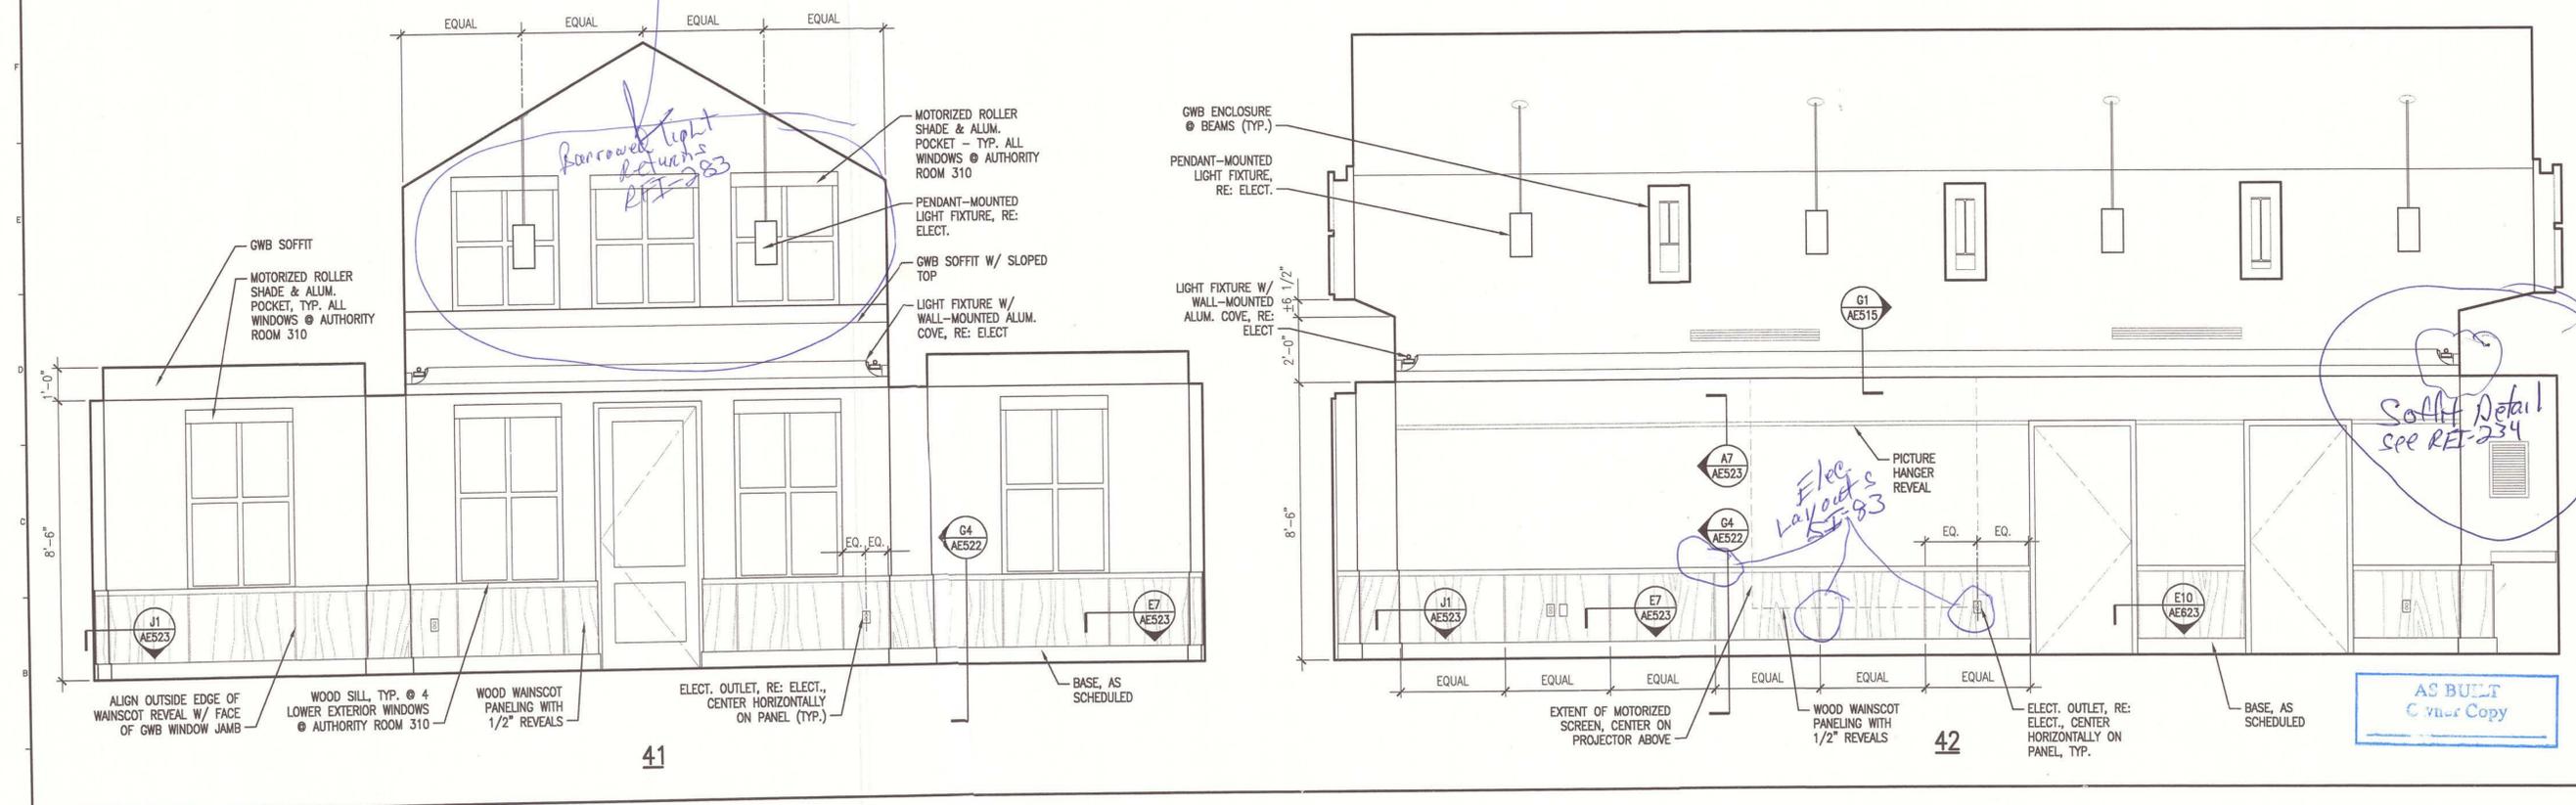

A1 INTERIOR ELEVATIONS - AUTHORITY ROOM 310
 3/8" = 1'-0"

SM RT
 ARCHITECTURE ENGINEERING PLANNING
 144 Fore Street P.O. Box 618
 Portland, Maine 04104
 tel. (207) 772-3846
 fax. (207) 772-1070

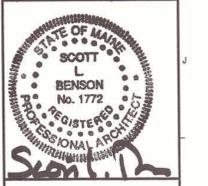

PROJECT TITLE:
**MAINE TURNPIKE AUTHORITY
 ADMINISTRATION BUILDING**
 PORTLAND, MAINE
 CURRENT ISSUE STATUS:
**ISSUED FOR BIDDING/CONSTRUCTION
 7-9-07**

REV	DESCRIPTION	DATE
0	BIDDING/CONSTRUCTION	7-9-07

GRAPHIC SCALE:
 0" = 1"
 SCALE: AS NOTED
 PROJECT MANAGER: SLB
 JC/DRAWN BY: TCM/DG
 A/E OF RECORD: SLB
 CAD FILE: AE217-06016
 PROJECT NO: 06016
 DATE: 7-9-07
 SHEET TITLE:

INTERIOR ELEVATIONS
 SHEET No. **AE217**


AS BUILT
 Color Copy

*Elec Outlet
 Layouts
 SEE 83*

*Narrowed light
 returns
 SEE 83*


*Elec
 Layouts
 SEE 83*

*Soffit Detail
 see REF-234*

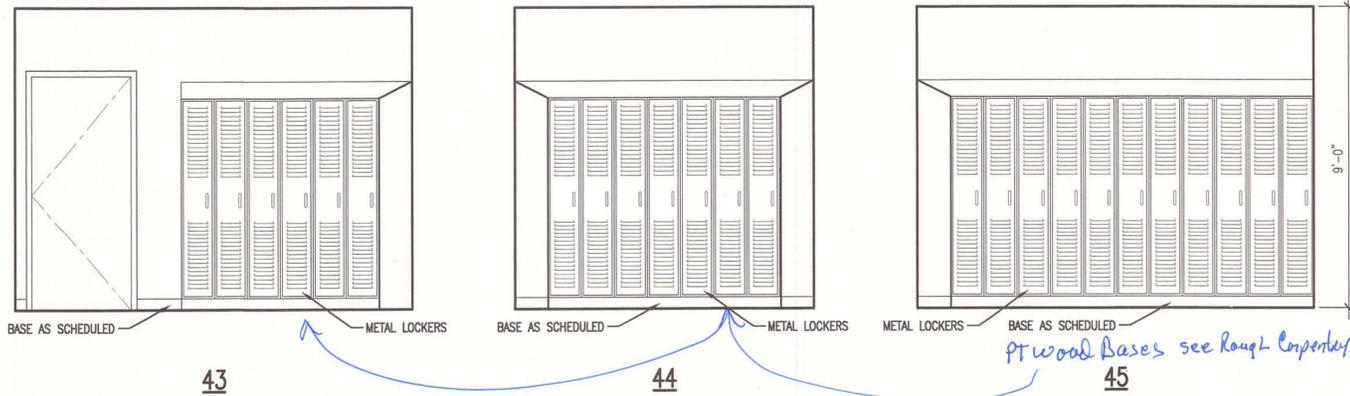


J1 INTERIOR ELEVATION - LOCKERS 139

3/8" = 1'-0"

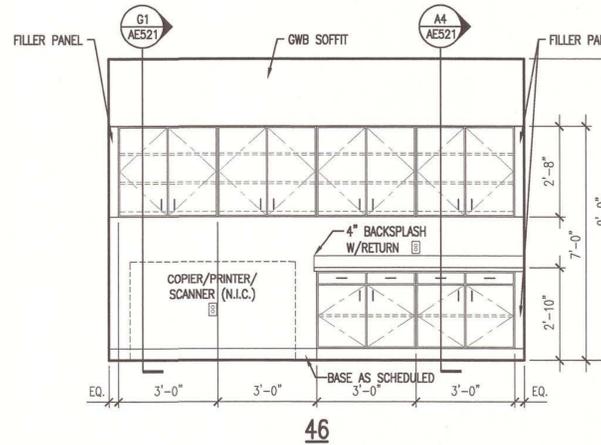


J9 INTERIOR ELEVATION - C.S. 219

3/8" = 1'-0"

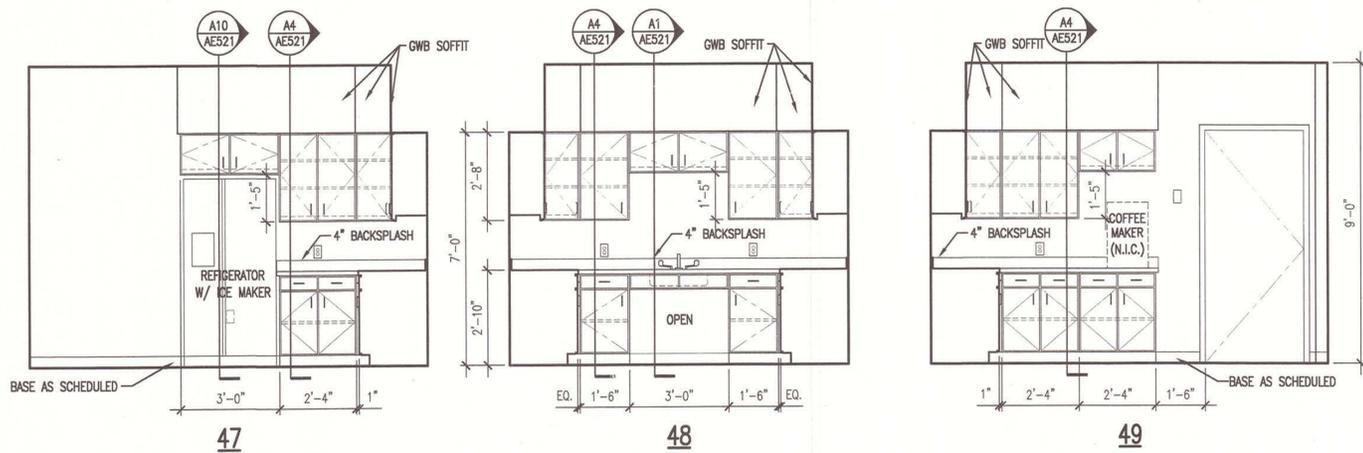


E1 INTERIOR ELEVATION - KITCHEN 314

3/8" = 1'-0"

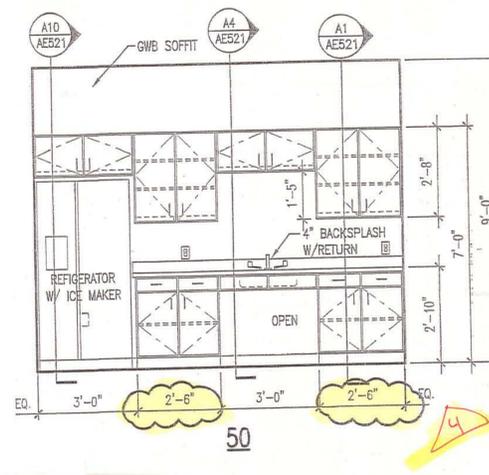


E9 INTERIOR ELEVATION - BREAK ROOM 138

3/8" = 1'-0"

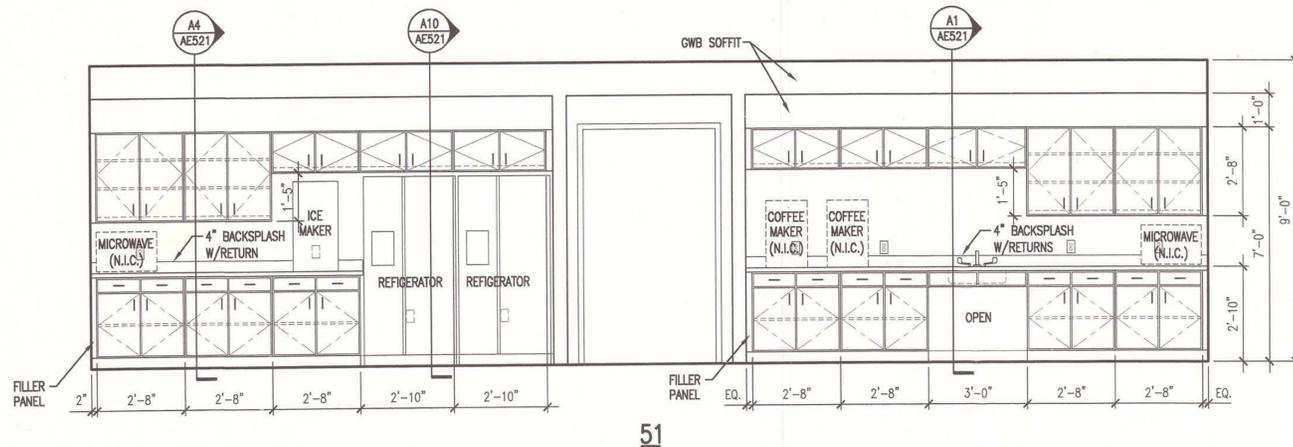

A1 INTERIOR ELEVATION - BREAK ROOM 154

3/8" = 1'-0"

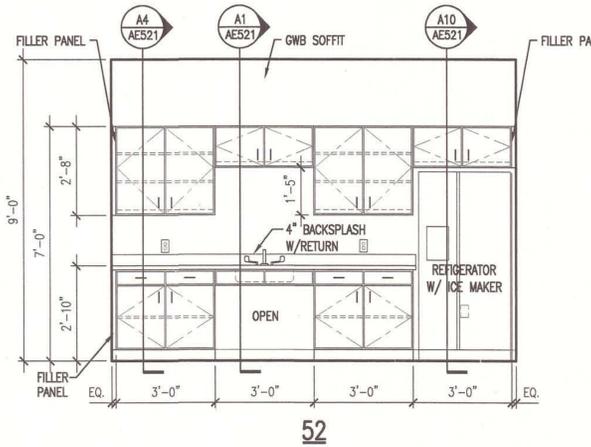

A9 INTERIOR ELEVATION - KITCHEN 235

3/8" = 1'-0"

GENERAL NOTES:

1. SEE G101 FOR PROJECT GENERAL NOTES.

SM
RT

ARCHITECTURE ENGINEERING PLANNING
SMRT
144 Fore Street/P.O. Box 618
Portland, Maine 04104
tel. (207) 772-3846
fax. (207) 772-1070



PROJECT TITLE:
**MAINE TURNPIKE AUTHORITY
ADMINISTRATION BUILDING**
PORTLAND, MAINE

CURRENT ISSUE STATUS:

**ISSUED FOR BIDDING/CONSTRUCTION
7-9-07**

REV	DESCRIPTION	DATE
0	BIDDING/CONSTRUCTION	7-9-07


GRAPHIC SCALE:
0" = 1"

SCALE: AS NOTED
PROJECT MANAGER: SLB
JC/DRAWN BY: TCM/TCM
A/E OF RECORD: SLB
CAD FILE: AE218-06016
PROJECT NO: 06016
DATE: 7-9-07

SHEET TITLE:
**INTERIOR
ELEVATIONS**

SHEET No.
AE218

AS BUILT
Owner Copy

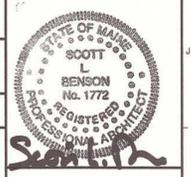

PROJECT TITLE:
**MAINE TURNPIKE AUTHORITY
 ADMINISTRATION BUILDING**
 PORTLAND, MAINE

CURRENT ISSUE STATUS:
**ISSUED FOR BIDDING/CONSTRUCTION
 7-9-07**



REV	DESCRIPTION	DATE
0	BIDDING/CONSTRUCTION	7-9-07

GRAPHIC SCALE:
 0" = 1"




SCALE: AS NOTED
 PROJECT MANAGER: SLB
 JC/DRAWN BY: TCM/DG
 A/E OF RECORD: SLB
 CAD FILE: AE219-06016
 PROJECT NO: 06016
 DATE: 7-9-07

SHEET TITLE:
INTERIOR ELEVATIONS

SHEET No. **AE219**

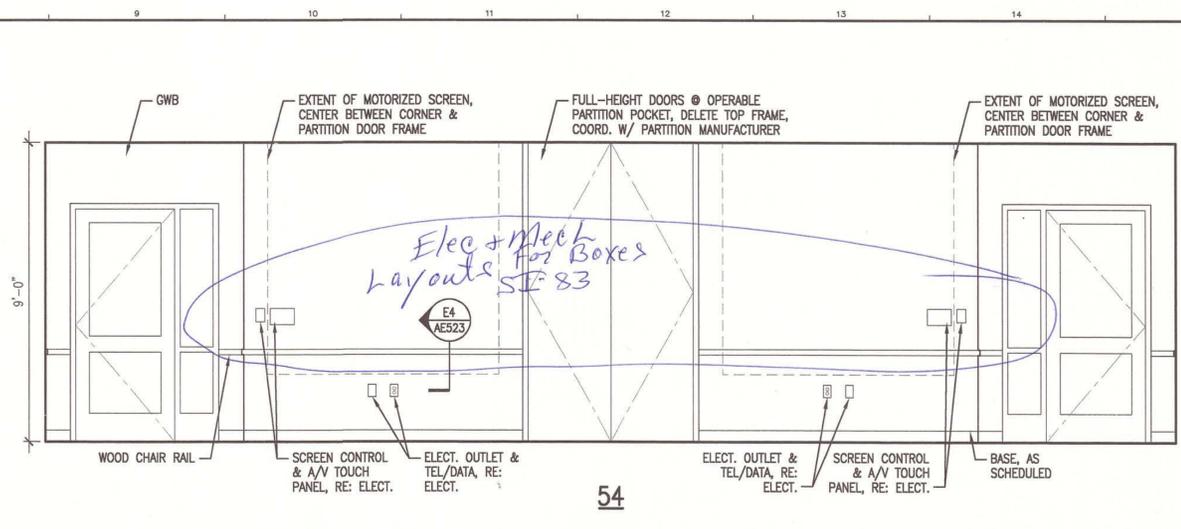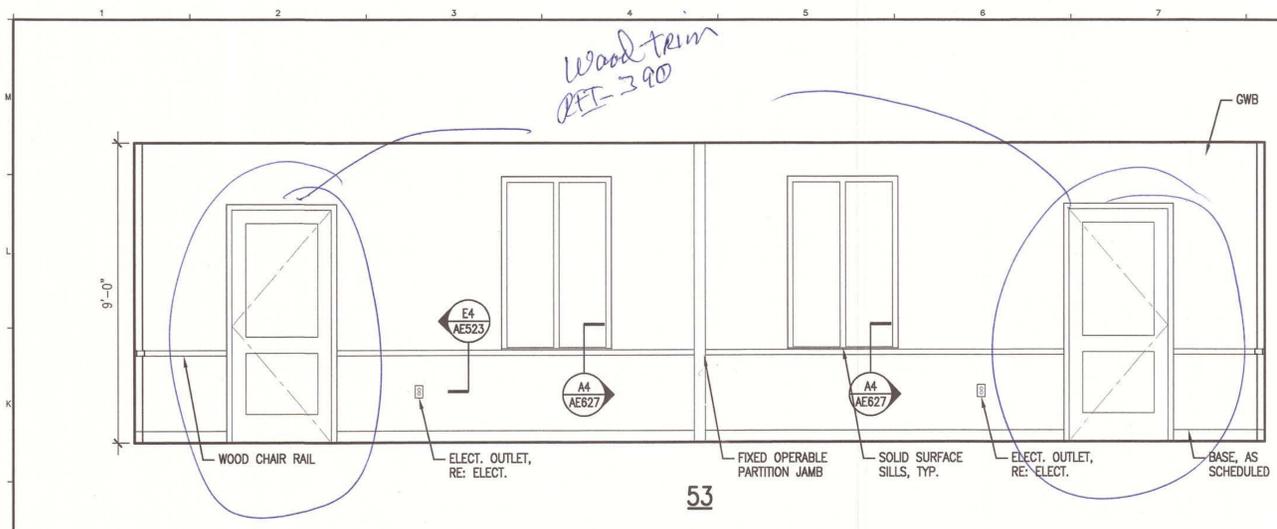

J1 INTERIOR ELEVATION - CONFERENCE 229 & 230
 3/8" = 1'-0"

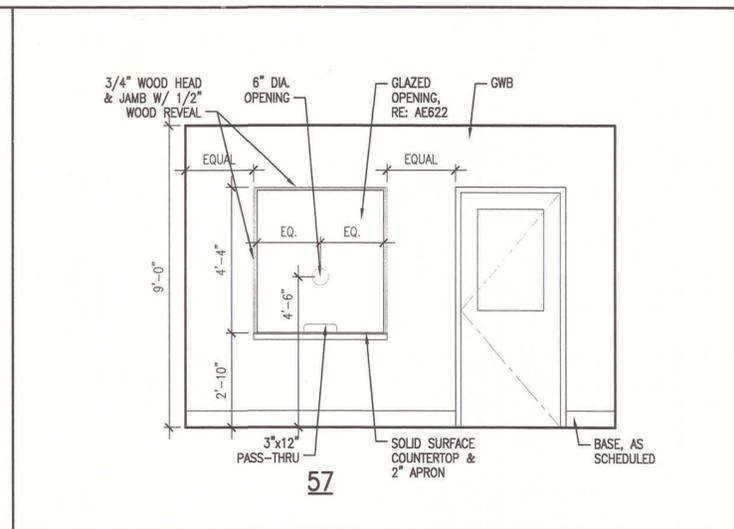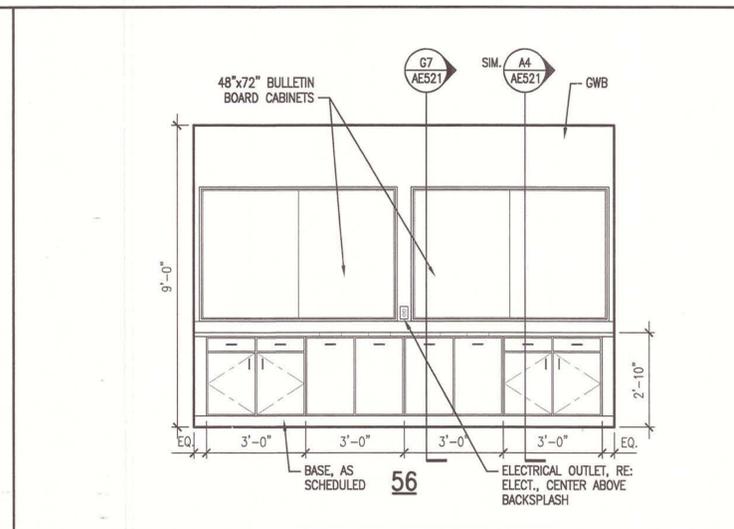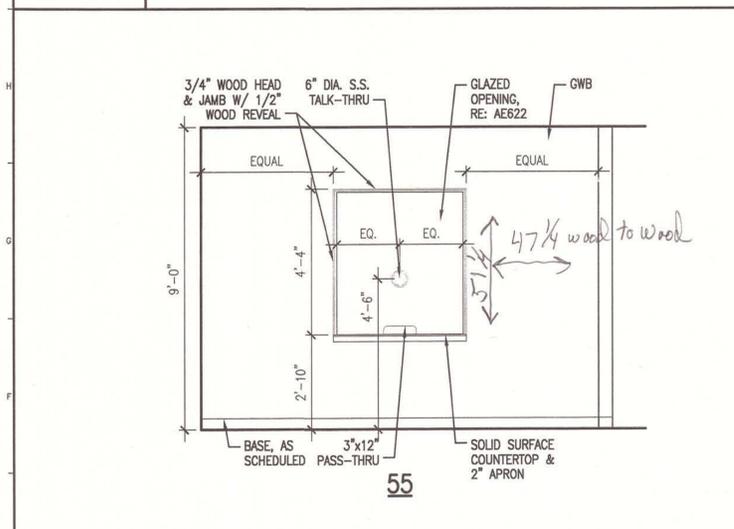

GENERAL NOTES:
 1. SEE 61001 FOR PROJECT GENERAL NOTES.


E1 INTERIOR ELEVATION - WAITING 129
 3/8" = 1'-0"

E5 INTERIOR ELEVATION - VENDING 155
 3/8" = 1'-0"


E9 INTERIOR ELEVATION - WAITING 330
 3/8" = 1'-0"

A1 -


AS BUILT
 Owner Copy

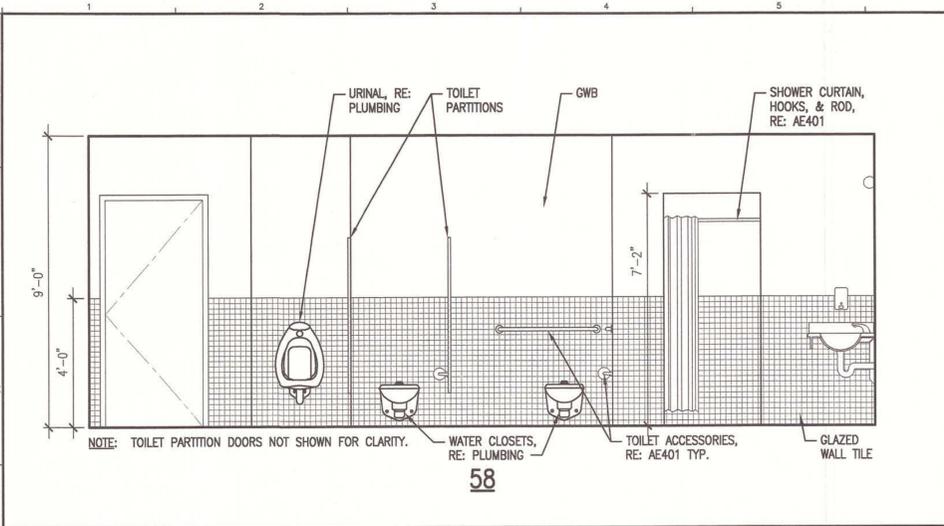


J1 INTERIOR ELEVATION
MEN'S TOILET 102
3/8" = 1'-0"

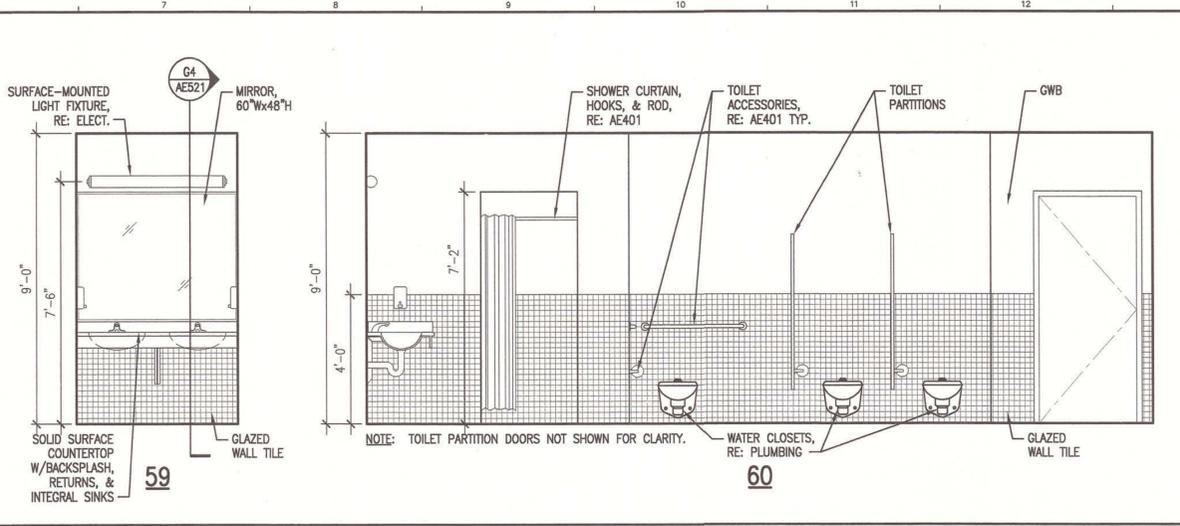


J6 INTERIOR ELEVATION
WOMEN'S TOILET 103
3/8" = 1'-0"

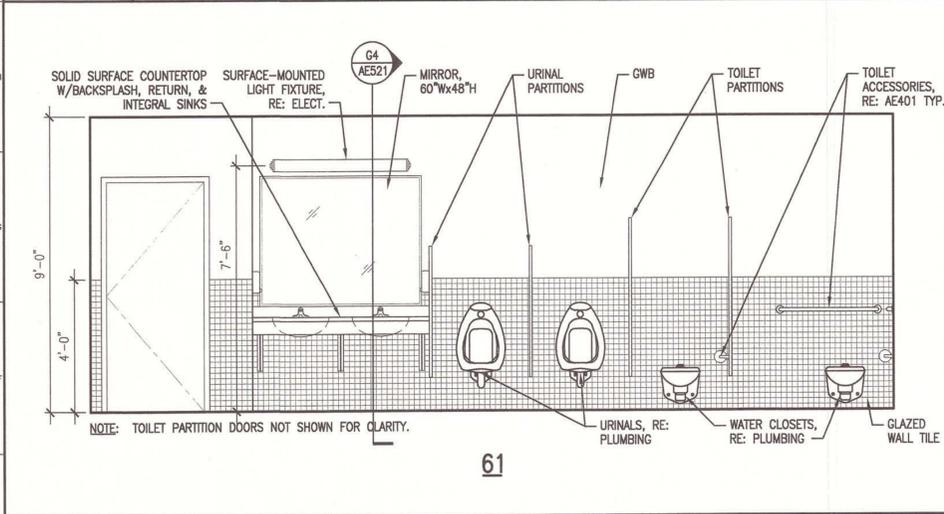

E1 INTERIOR ELEVATION
MEN'S TOILET 202 & 302
3/8" = 1'-0"

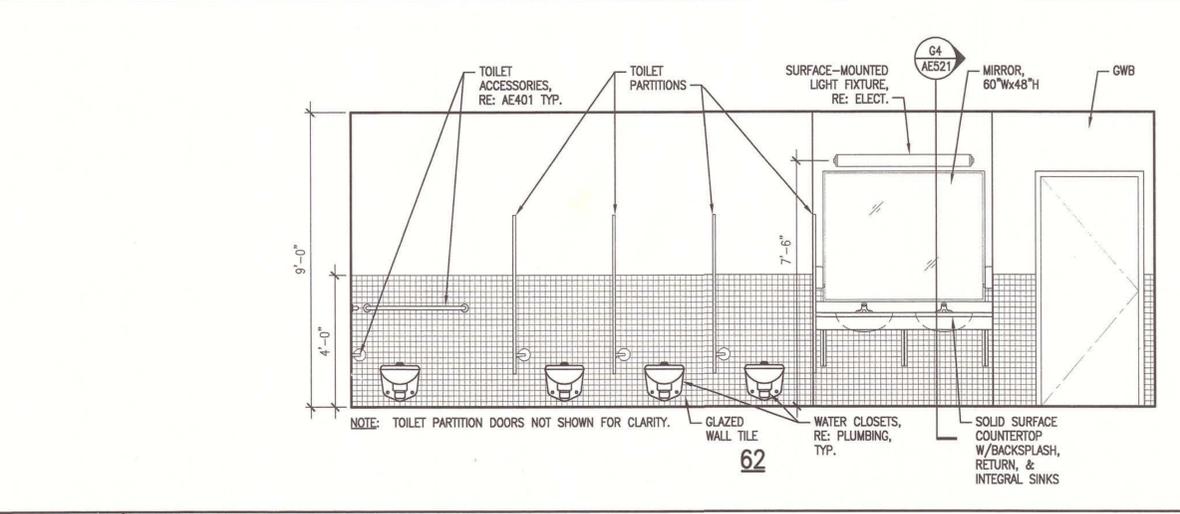

E6 INTERIOR ELEVATION
WOMEN'S TOILET 203 & 303
3/8" = 1'-0"

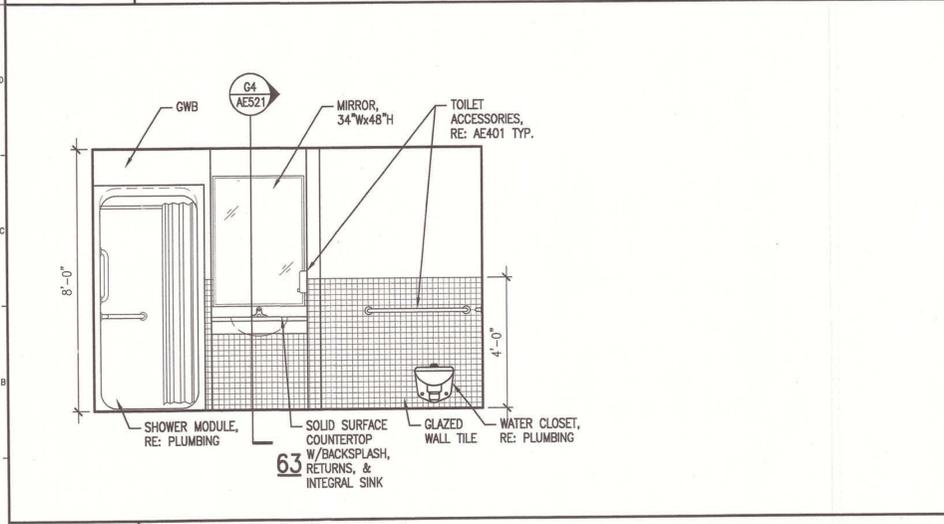


A1 INTERIOR ELEVATION
WOMEN'S & MEN'S SHOWER 135 & 136
3/8" = 1'-0"

GENERAL NOTES:
1. REFER TO G1001 FOR PROJECT GENERAL NOTES.
2. REFER TO AE401 FOR ENLARGED TOILET ROOM PLANS & ACCESSORIES.
3. ALL WALLS IN ALL TOILET & SHOWER ROOMS TO RECEIVE 4'-0" H GLAZED TILE WAINSCOT, TYPICAL FOR BUILDING.



ARCHITECTURE ENGINEERING PLANNING
SMT
144 Fore Street P.O. Box 618
Portland, Maine 04104
tel. (207) 772-3846
fax. (207) 772-1070

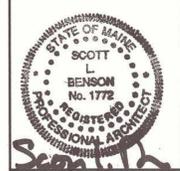

PROJECT TITLE:
MAINE TURNPIKE AUTHORITY
ADMINISTRATION BUILDING
PORTLAND, MAINE

CURRENT ISSUE STATUS:
ISSUED FOR BIDDING/CONSTRUCTION
7-9-07

REV	DESCRIPTION	DATE
0	BIDDING/CONSTRUCTION	7-9-07



GRAPHIC SCALE:
0" 1"
SCALE: AS NOTED
PROJECT MANAGER: SLB
JC/DRAWN BY: TCM/TCM
A/E OF RECORD: SLB
CAD FILE: AE220-06016
PROJECT NO: 06016
DATE: 7-9-07
SHEET TITLE:
INTERIOR ELEVATIONS
SHEET No. **AE220**

AS BUILT
Owner Copy


GENERAL NOTES:
 1. SEE G101 FOR PROJECT GENERAL NOTES.



ARCHITECTURE ENGINEERING PLANNING
 SKIRT
 144 Fore Street/P.O. Box 618
 Portland, Maine 04104
 tel. (207) 772-3846
 fax. (207) 772-1070

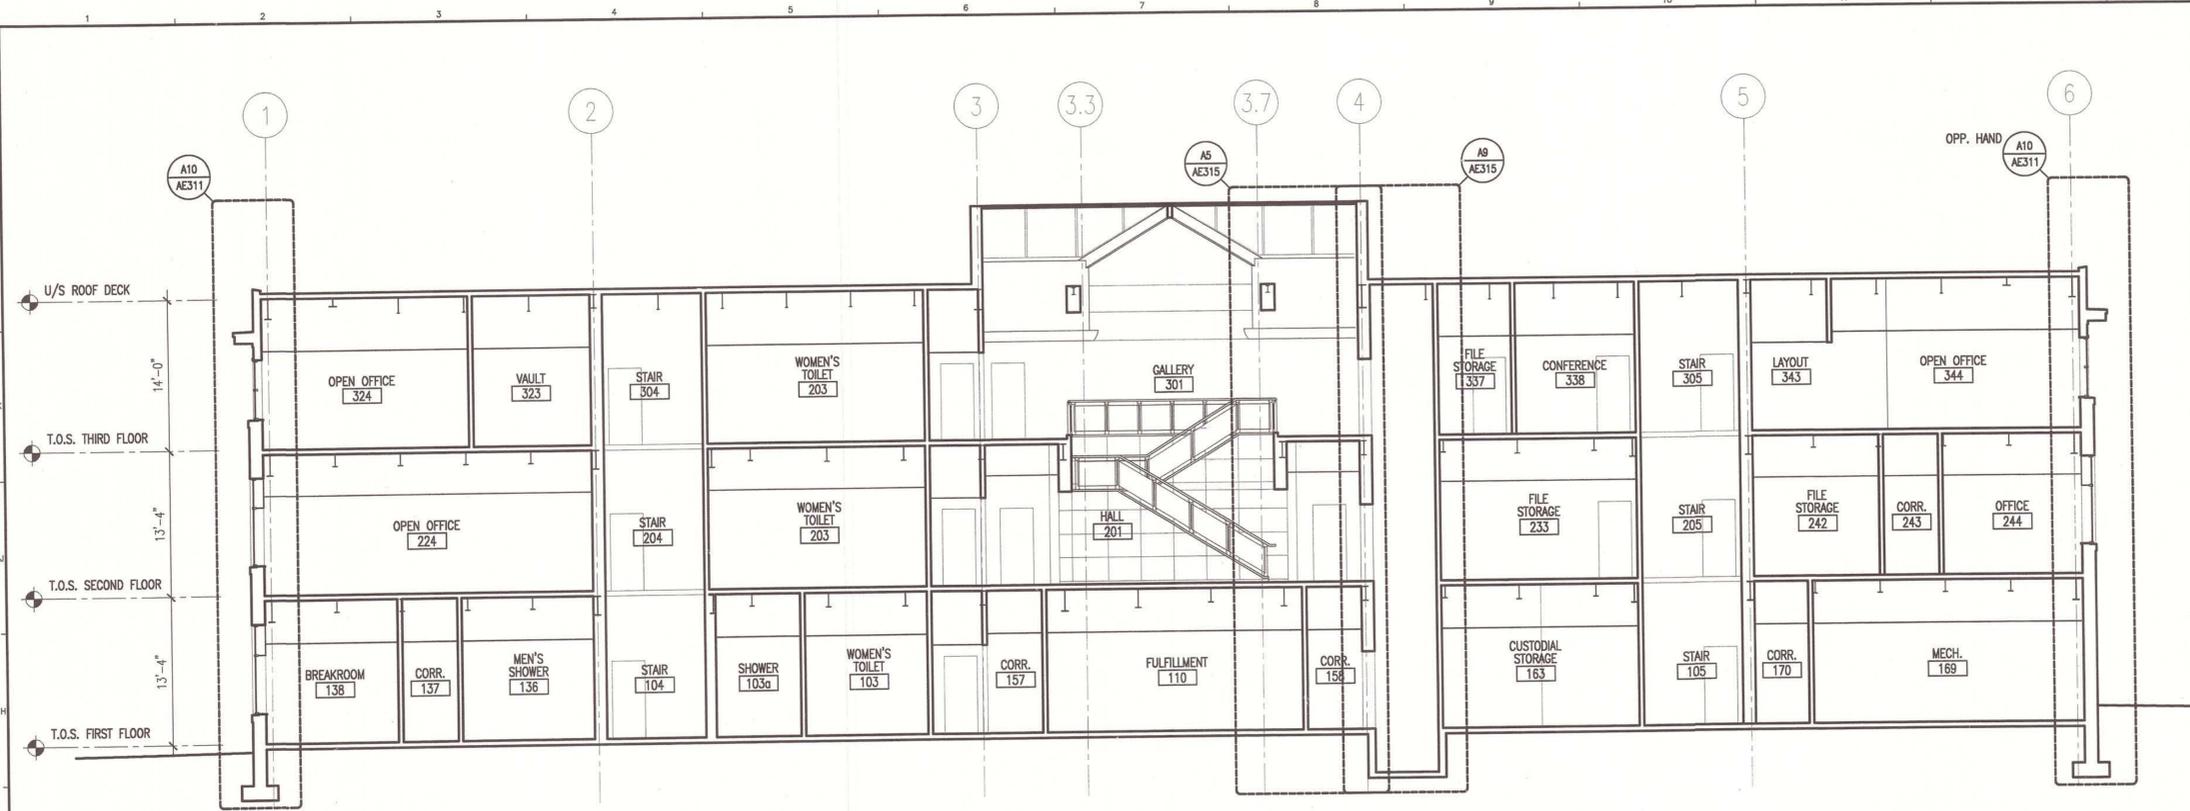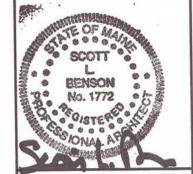

G1 BUILDING SECTION
 1/8" = 1'-0"

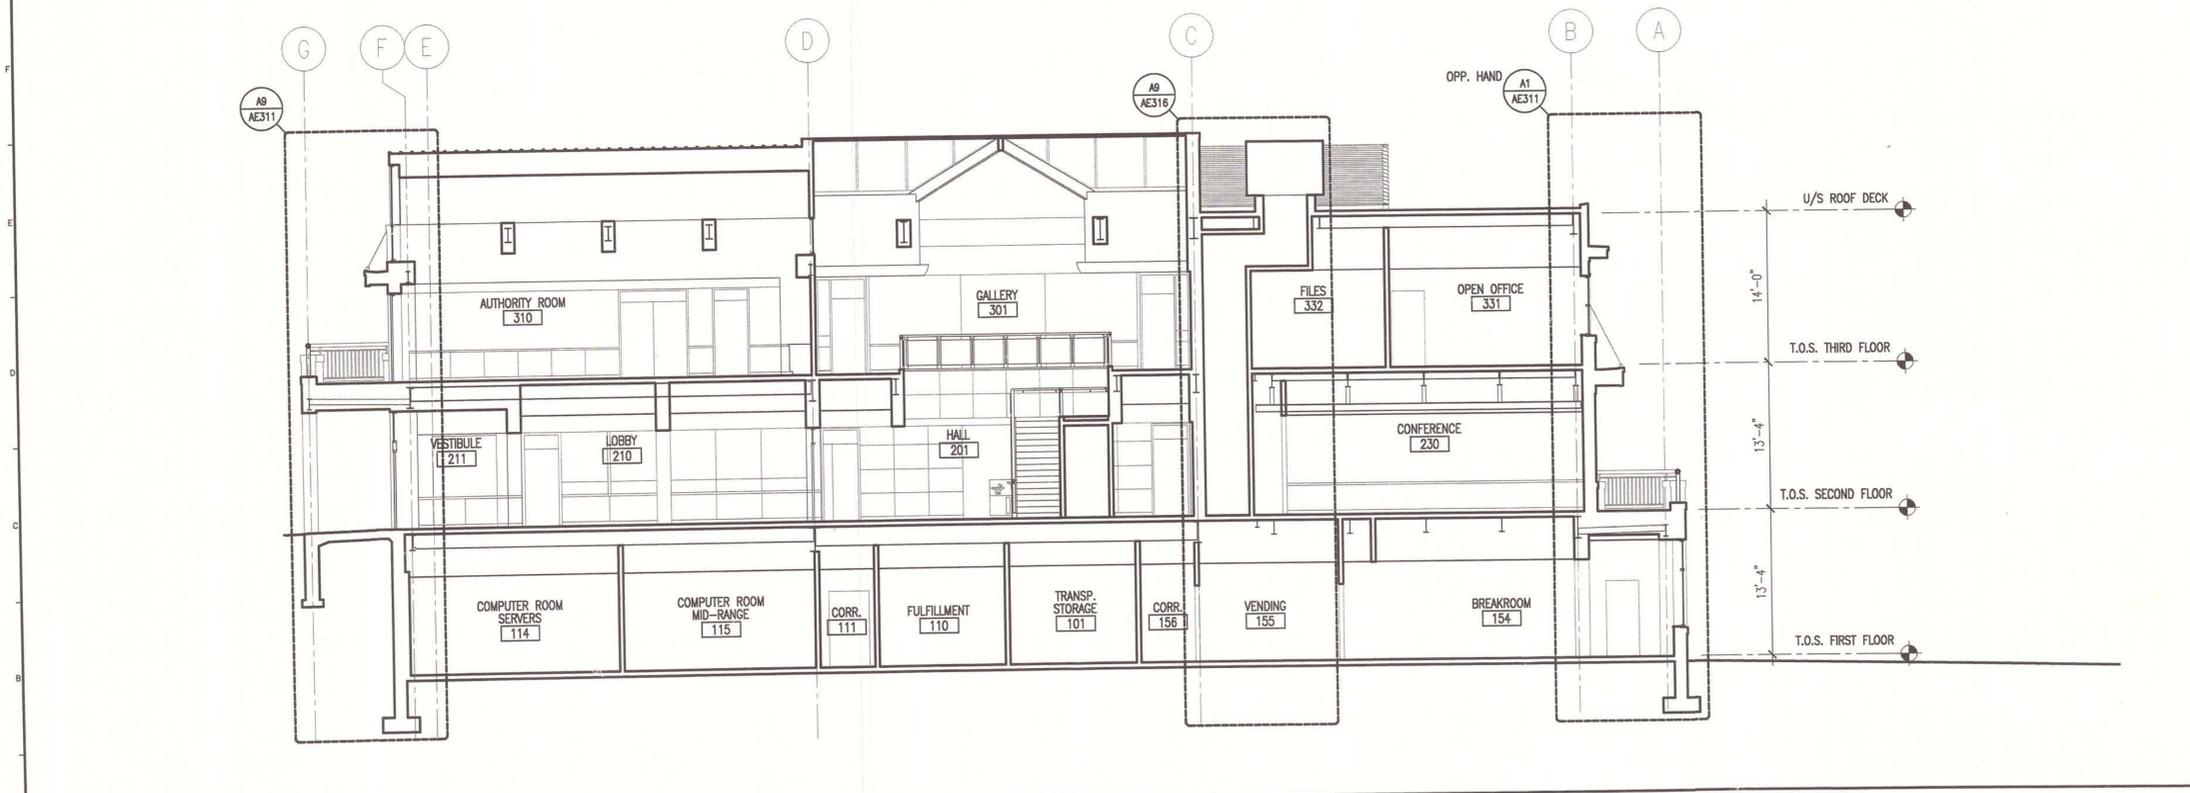

A1 BUILDING SECTION
 1/8" = 1'-0"

AS BUILT
 Owner Copy

PROJECT TITLE:
**MAINE TURNPIKE AUTHORITY
 ADMINISTRATION BUILDING**
 PORTLAND, MAINE

CURRENT ISSUE STATUS:
ISSUED FOR BIDDING/CONSTRUCTION
7-9-07

REV	DESCRIPTION	DATE
0	BIDDING/CONSTRUCTION	7-9-07

GRAPHIC SCALE:
 0" 1"


SCALE: AS NOTED
 PROJECT MANAGER: SLB
 JC/DRAWN BY: TCM/DG
 A/E OF RECORD: SLB
 CAD FILE: AE301-06016
 PROJECT NO: 06016
 DATE: 7-9-07
 SHEET TITLE:

BUILDING SECTIONS
 SHEET No. **AE301**

GENERAL NOTES:
 1. SEE 0101 FOR PROJECT GENERAL NOTES.

**SM
RT**

ARCHITECTURE ENGINEERING PLANNING
 SWRT
 144 Fore Street, P.O. Box 418
 Portland, Maine 04104
 Tel. (207) 772-3846
 Fax. (207) 772-1070

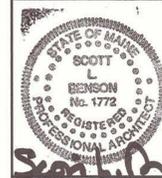

PROJECT TITLE:
**MAINE TURNPIKE AUTHORITY
 ADMINISTRATION BUILDING**
 PORTLAND, MAINE

CURRENT ISSUE STATUS:

ISSUED FOR BIDDING/CONSTRUCTION
 7-9-07

REV	DESCRIPTION	DATE
0	BIDDING/CONSTRUCTION	7-9-07





GRAPHIC SCALE:



SCALE: AS NOTED
 PROJECT MANAGER: SLB
 JC/DRAWN BY: TCM/TCM
 A/E OF RECORD: SLB
 CAD FILE: AE311-06016
 PROJECT NO: 06016
 DATE: 7-9-07

SHEET TITLE:
WALL SECTIONS

SHEET No.
AE311

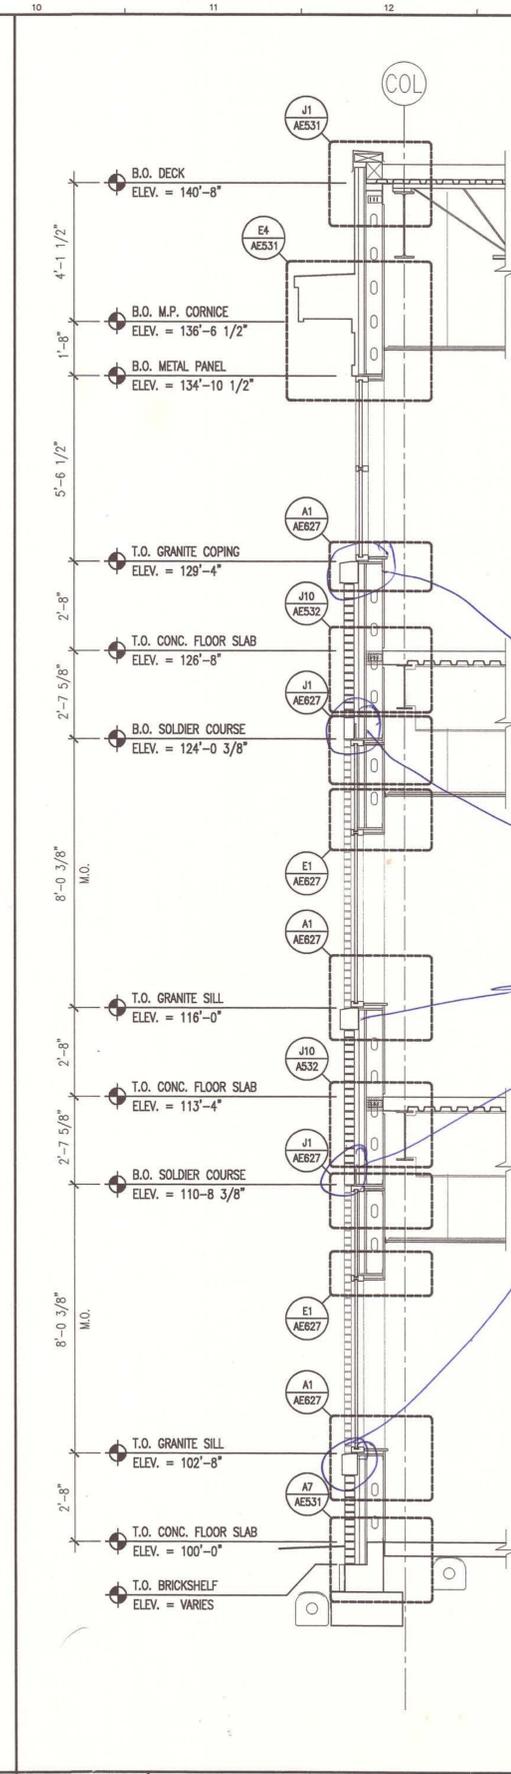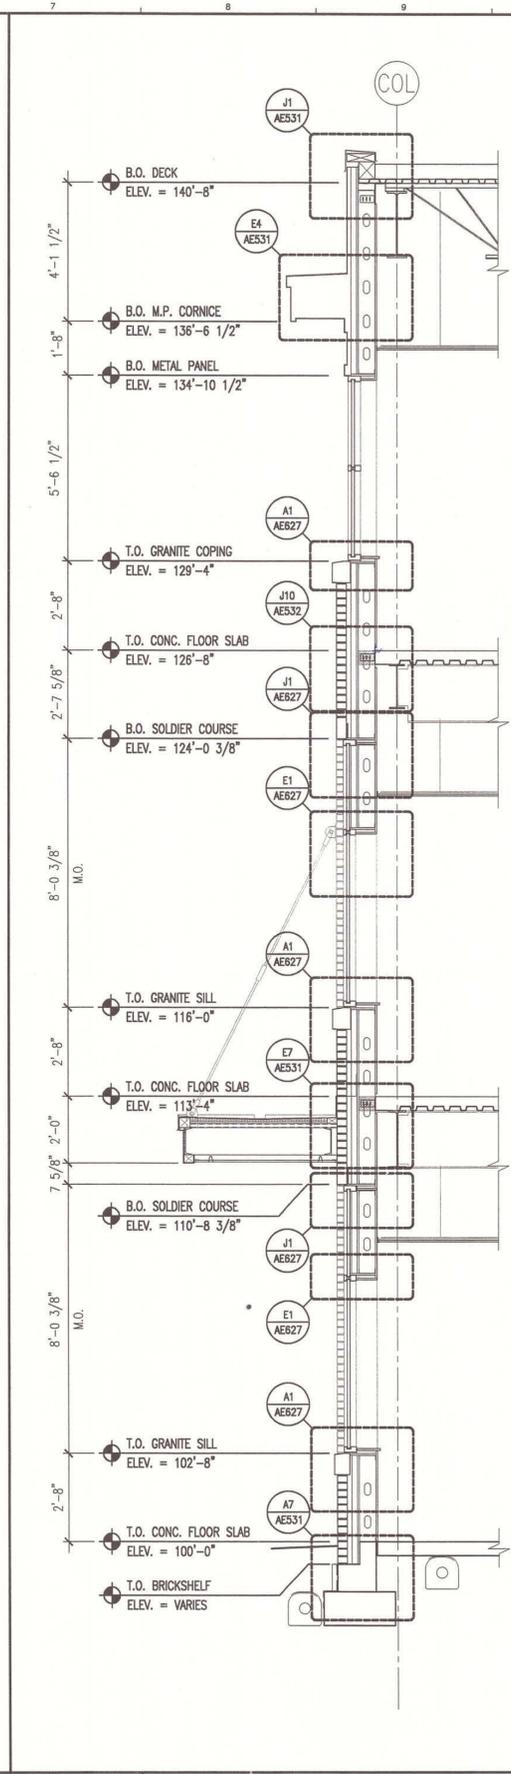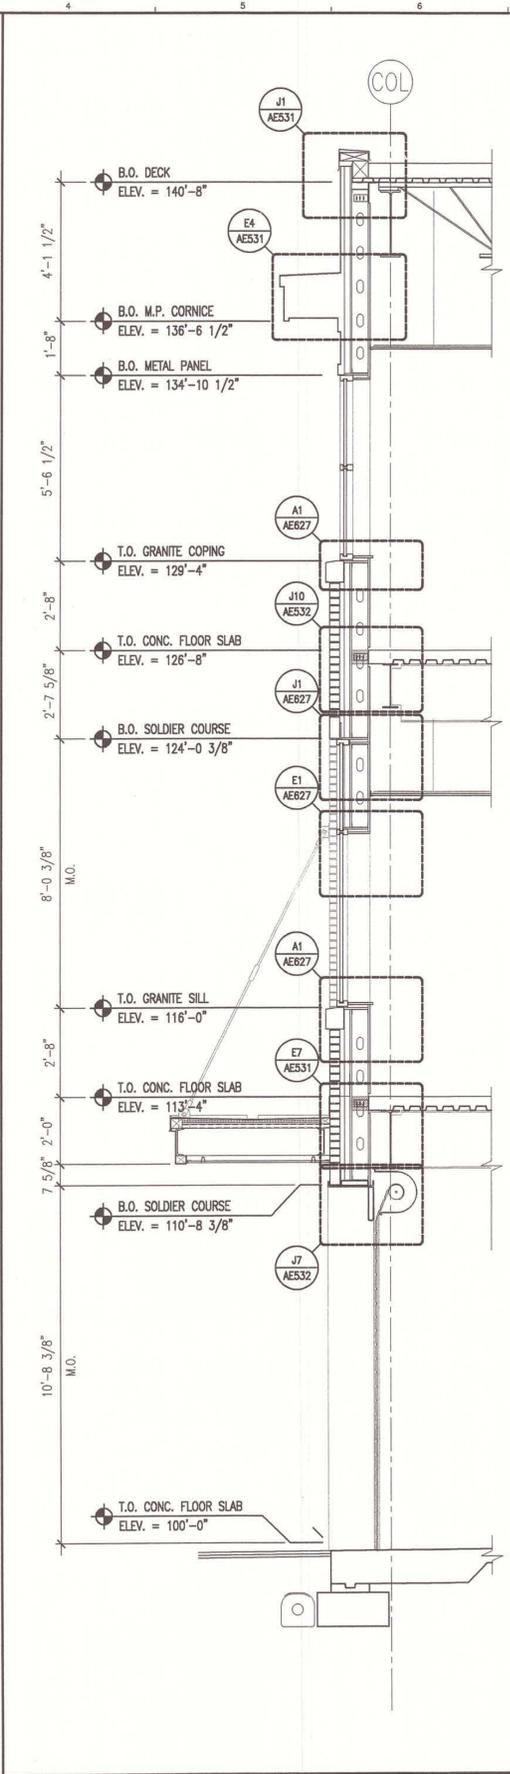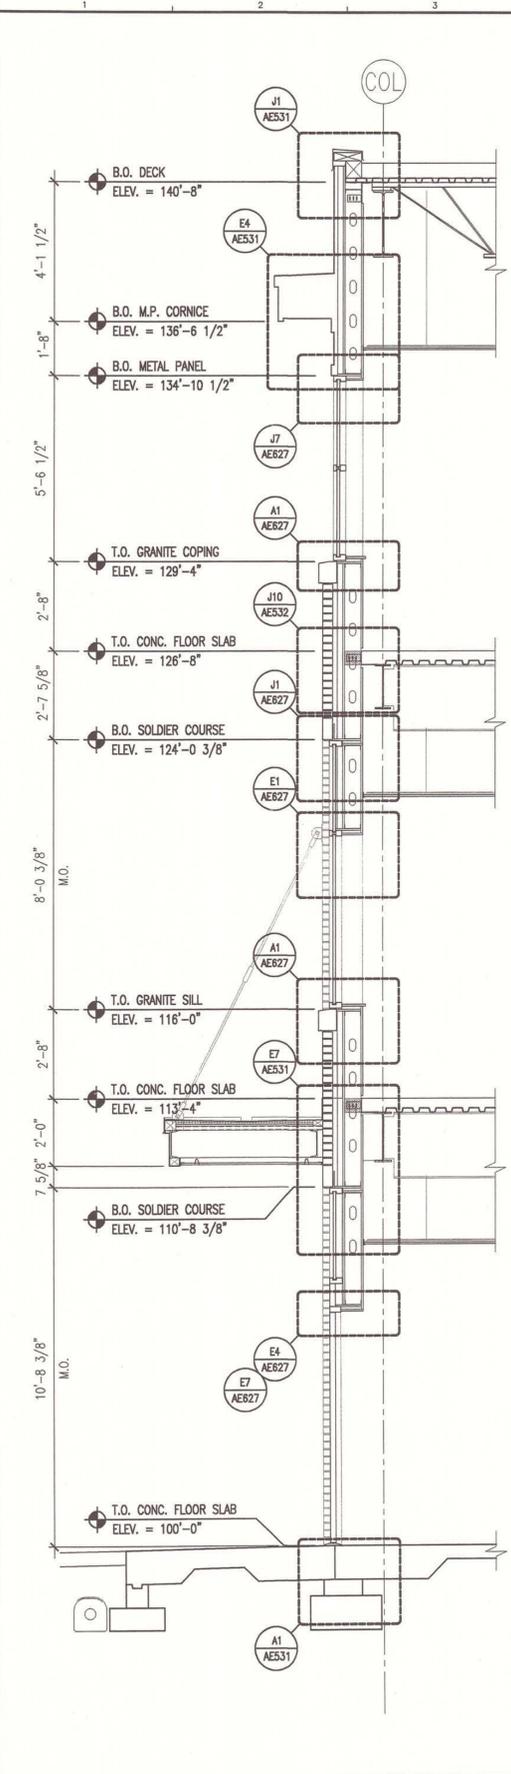

A1 WALL SECTION
 3/8" = 1'-0"





A4 WALL SECTION
 3/8" = 1'-0"

A7 WALL SECTION
 3/8" = 1'-0"

A10 WALL SECTION
 3/8" = 1'-0"

AS BUILT
 Owner Copy

GENERAL NOTES:
 1. SEE G1001 FOR PROJECT GENERAL NOTES.

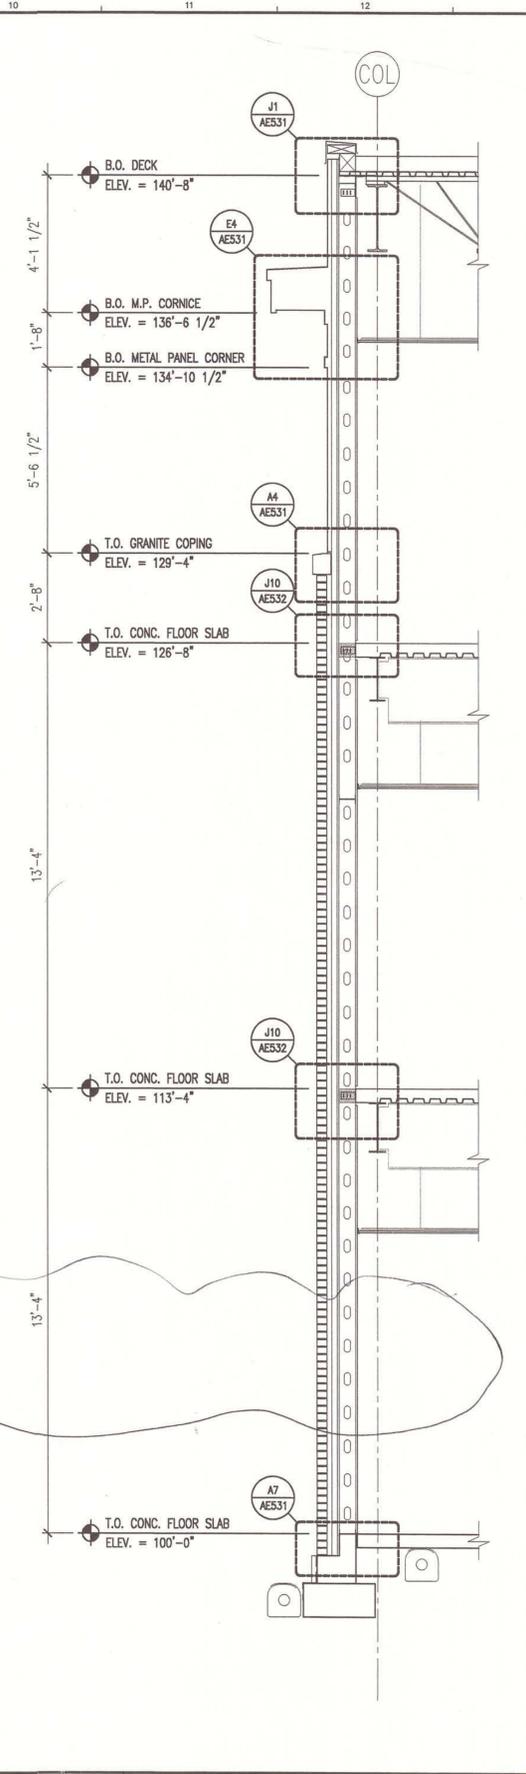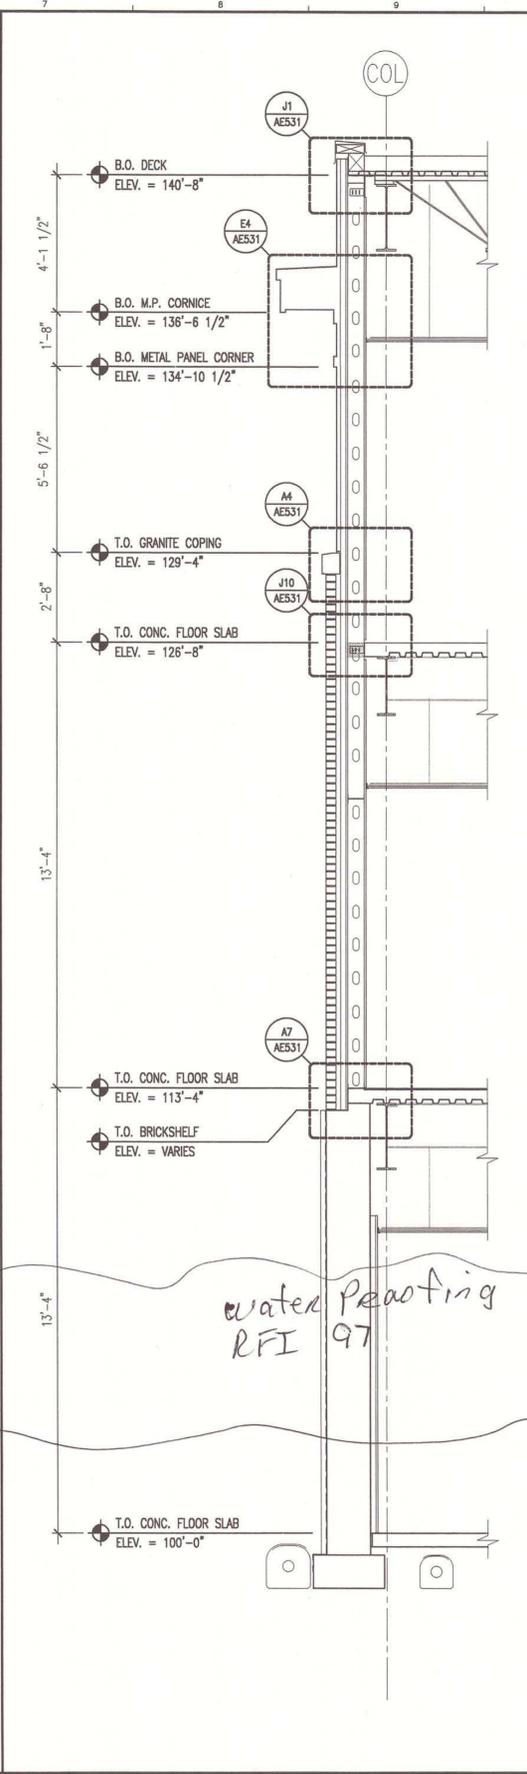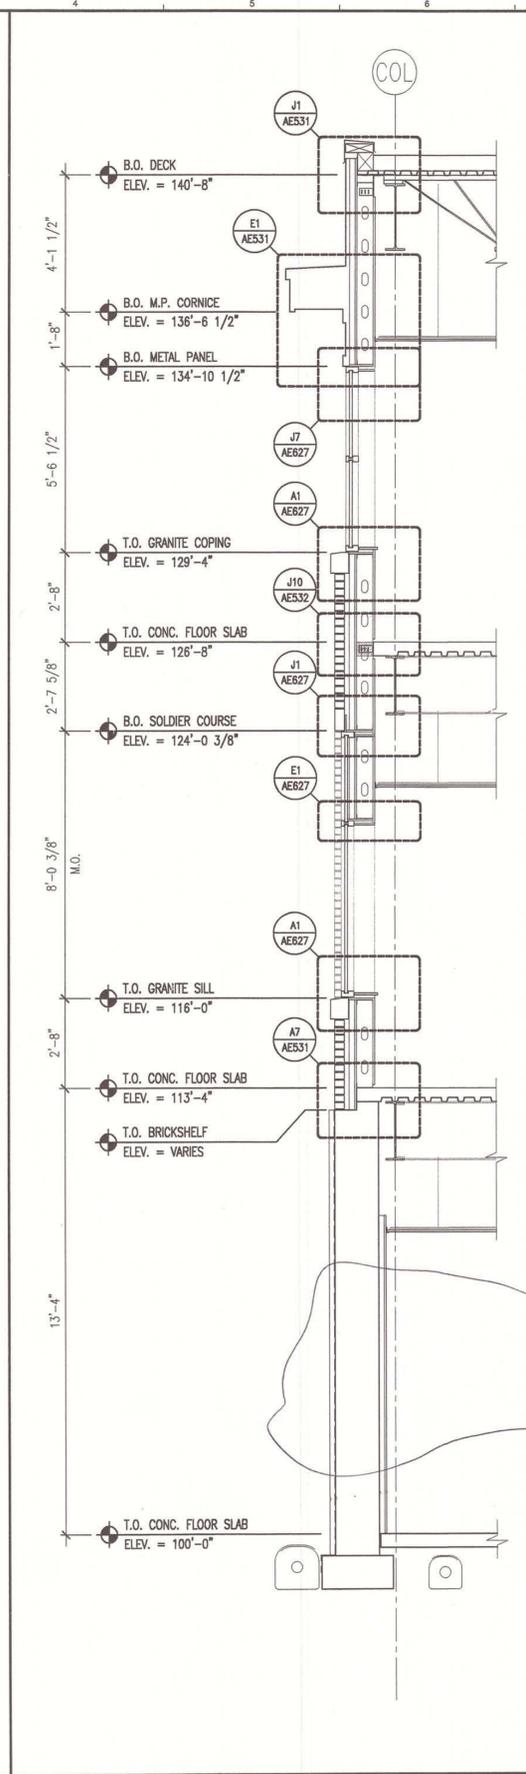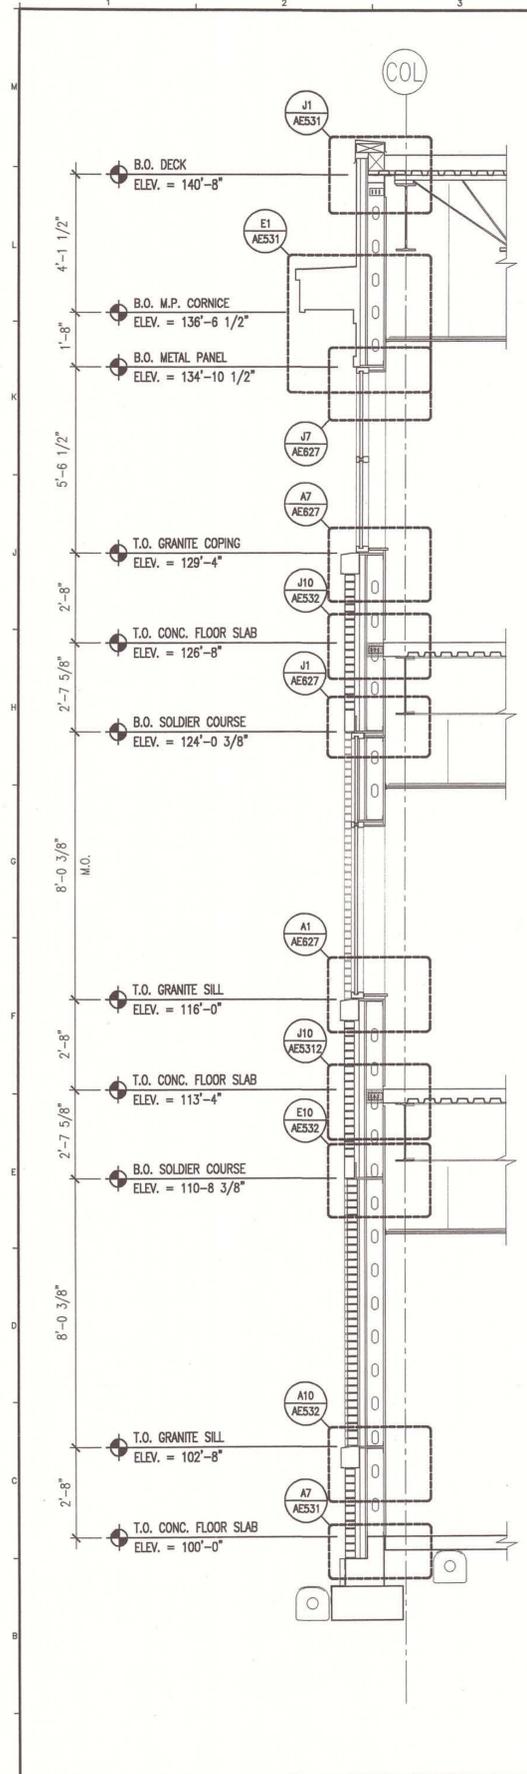

water proofing RFI 97

A1 WALL SECTION
 3/8" = 1'-0"

A4 WALL SECTION
 3/8" = 1'-0"

A7 WALL SECTION
 3/8" = 1'-0"

A10 WALL SECTION
 3/8" = 1'-0"

AS BUILT
 Owner Copy



ARCHITECTURE ENGINEERING PLANNING
 SKIRT
 144 Fore Street/P.O. Box 618
 Portland, Maine 04104
 tel. (207) 772-3846
 fax. (207) 772-1070



PROJECT TITLE:
**MAINE TURNPIKE AUTHORITY
 ADMINISTRATION BUILDING**
 PORTLAND, MAINE

CURRENT ISSUE STATUS:
ISSUED FOR BIDDING/CONSTRUCTION
7-9-07


REV	DESCRIPTION	DATE
0	BIDDING/CONSTRUCTION	7-9-07

GRAPHIC SCALE:
 0" = 1"

SCALE: AS NOTED
 PROJECT MANAGER: SLB
 JC/DRAWN BY: TCM/TCM
 A/E OF RECORD: SLB
 CAD FILE: AE312-06016
 PROJECT NO: 06016
 DATE: 7-9-07

SHEET TITLE:
WALL SECTIONS

SHEET No. **AE312**

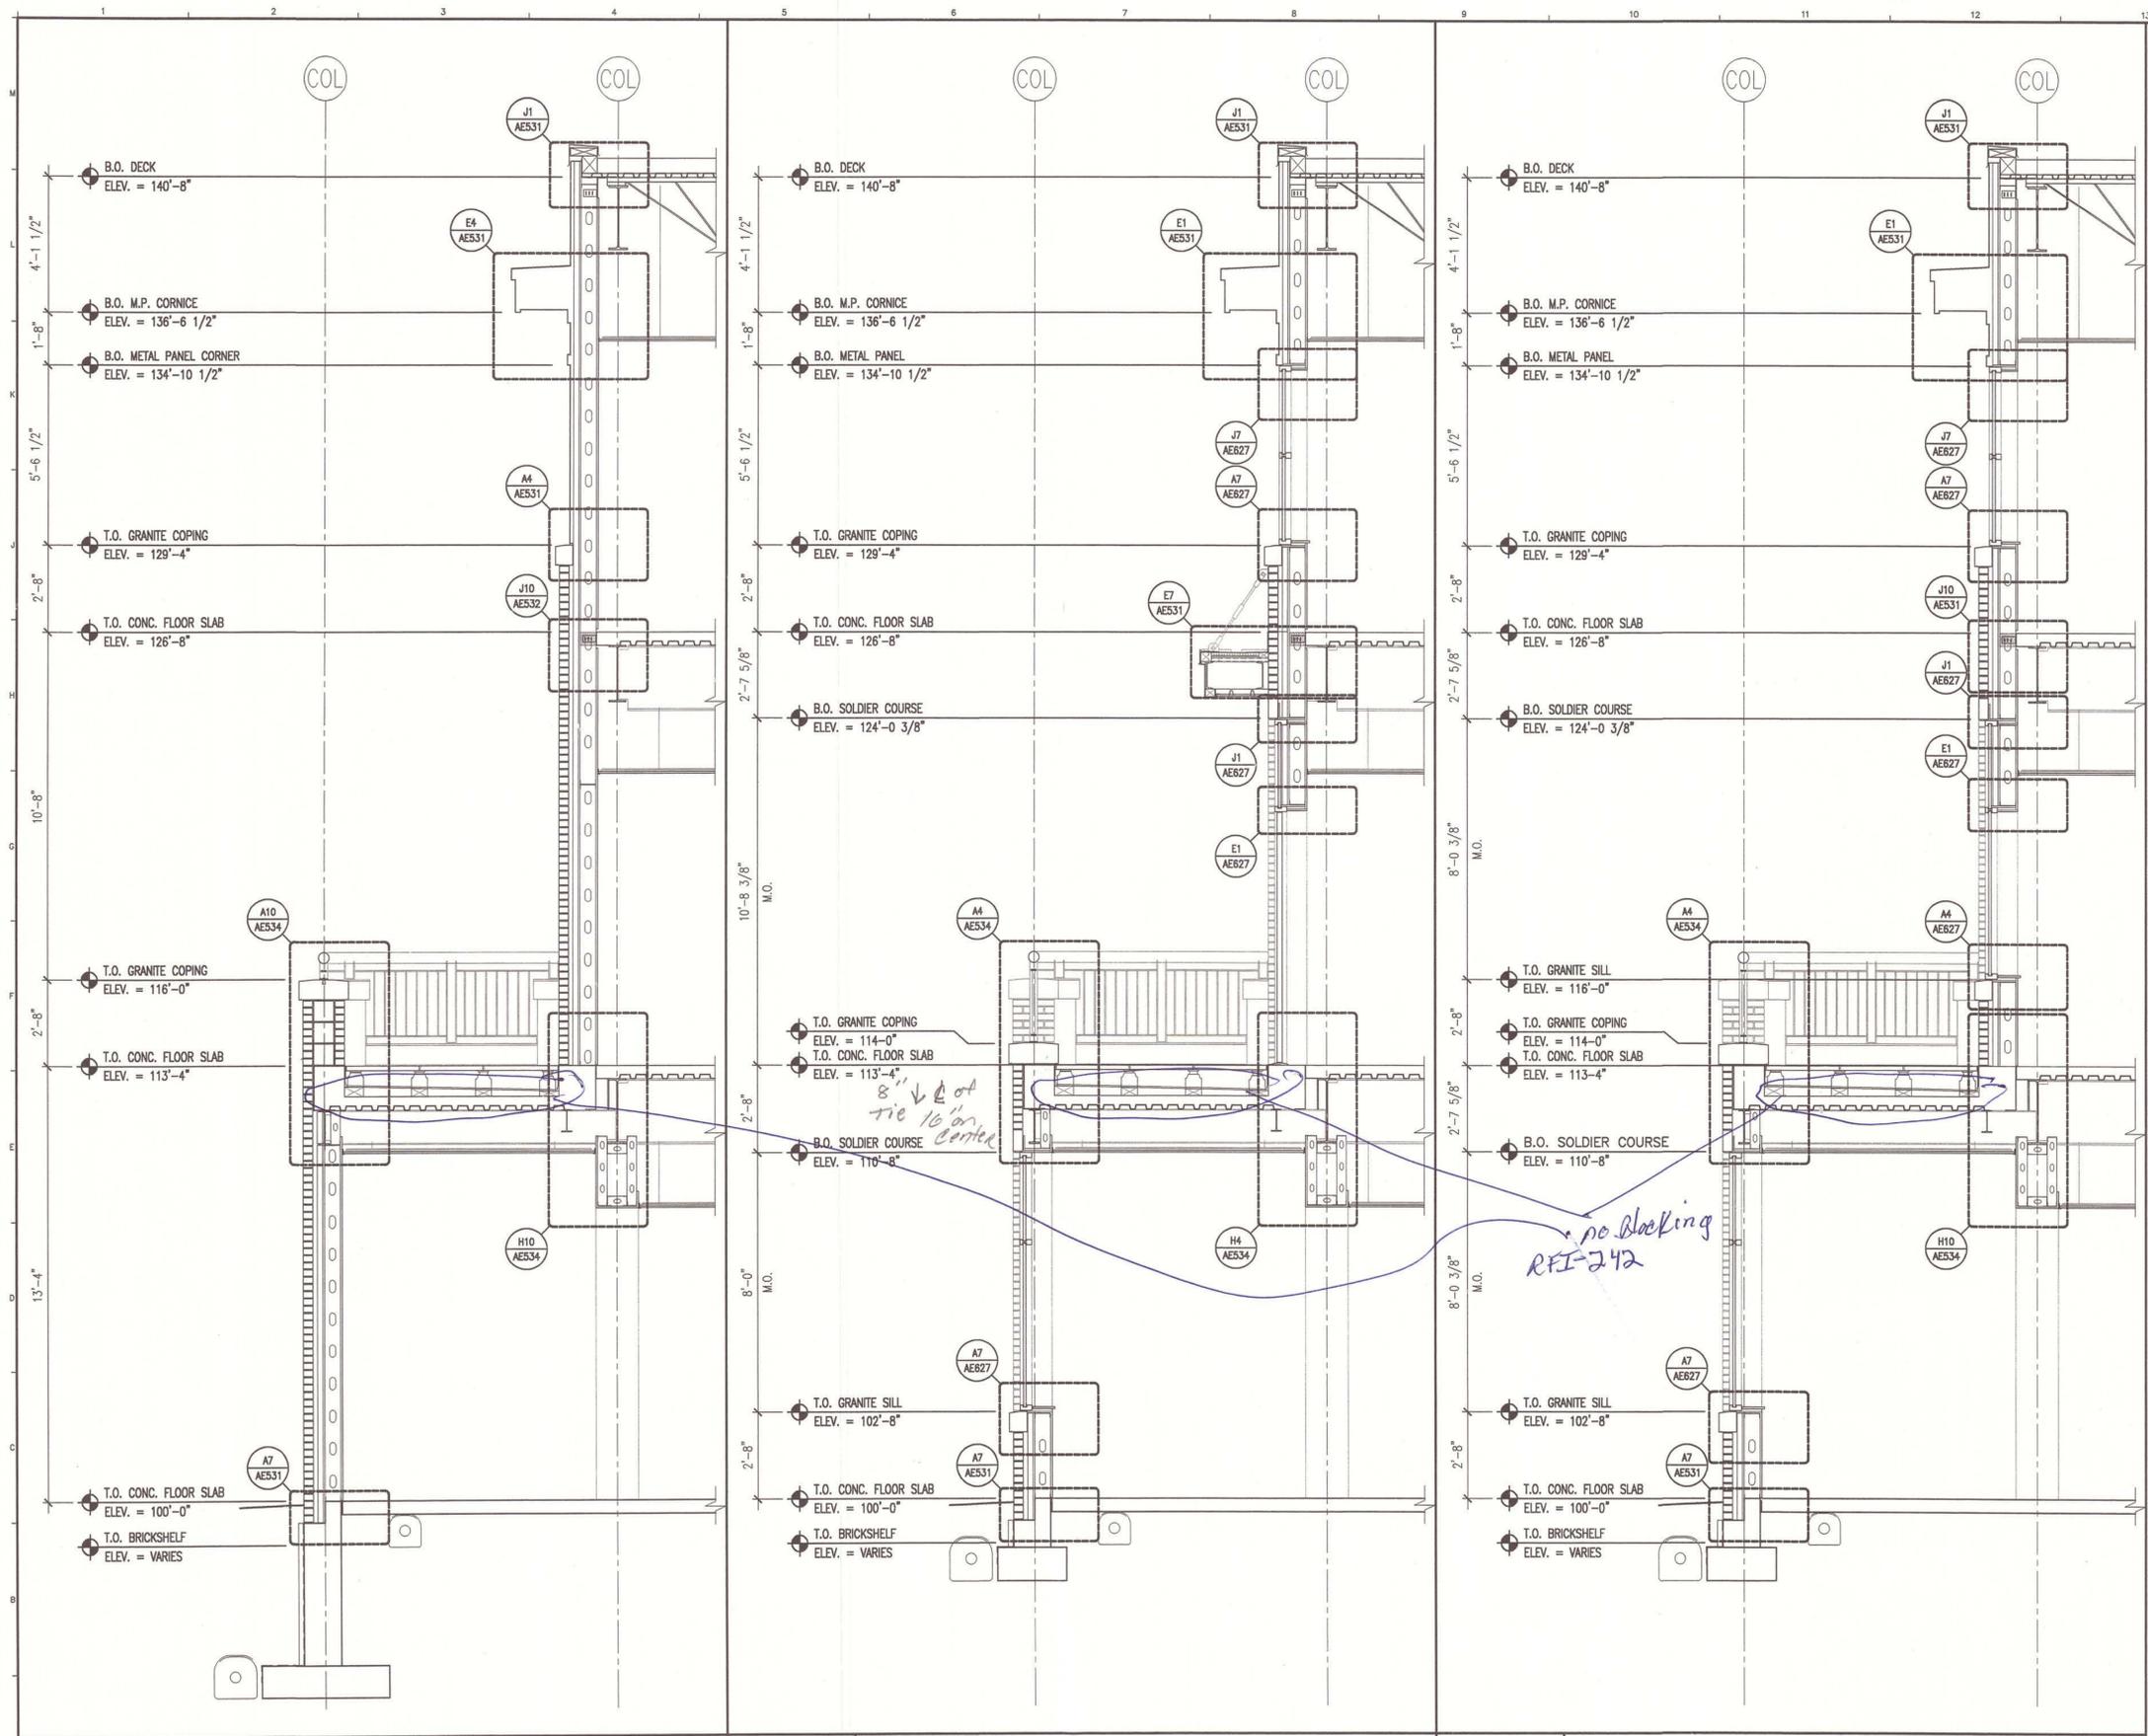

GENERAL NOTES:
 1. SEE 6101 FOR PROJECT GENERAL NOTES.



ARCHITECTURE ENGINEERING PLANNING
 SMT SRT
 144 Fore Street/P.O. Box 618
 Portland, Maine 04104
 tel. (207) 772-3946
 fax. (207) 772-1070



PROJECT TITLE: MAINE TURNPIKE AUTHORITY ADMINISTRATION BUILDING PORTLAND, MAINE
 CURRENT ISSUE STATUS: ISSUED FOR BIDDING/CONSTRUCTION 7-9-07


REV	DESCRIPTION	DATE
0	BIDDING/CONSTRUCTION	7-9-07

GRAPHIC SCALE: 0" = 1"
 SCALE: AS NOTED
 PROJECT MANAGER: SLB
 JC/DRAWN BY: TCM/TCM
 A/E OF RECORD: SLB
 CAD FILE: AE313-06016
 PROJECT NO: 06016
 DATE: 7-9-07
 SHEET TITLE:

AS BUILT
 Copy Copy

A1	WALL SECTION	A5	WALL SECTION	A9	WALL SECTION
3/8" = 1'-0"	-	3/8" = 1'-0"	-	3/8" = 1'-0"	-


WALL SECTIONS
 SHEET No. AE313

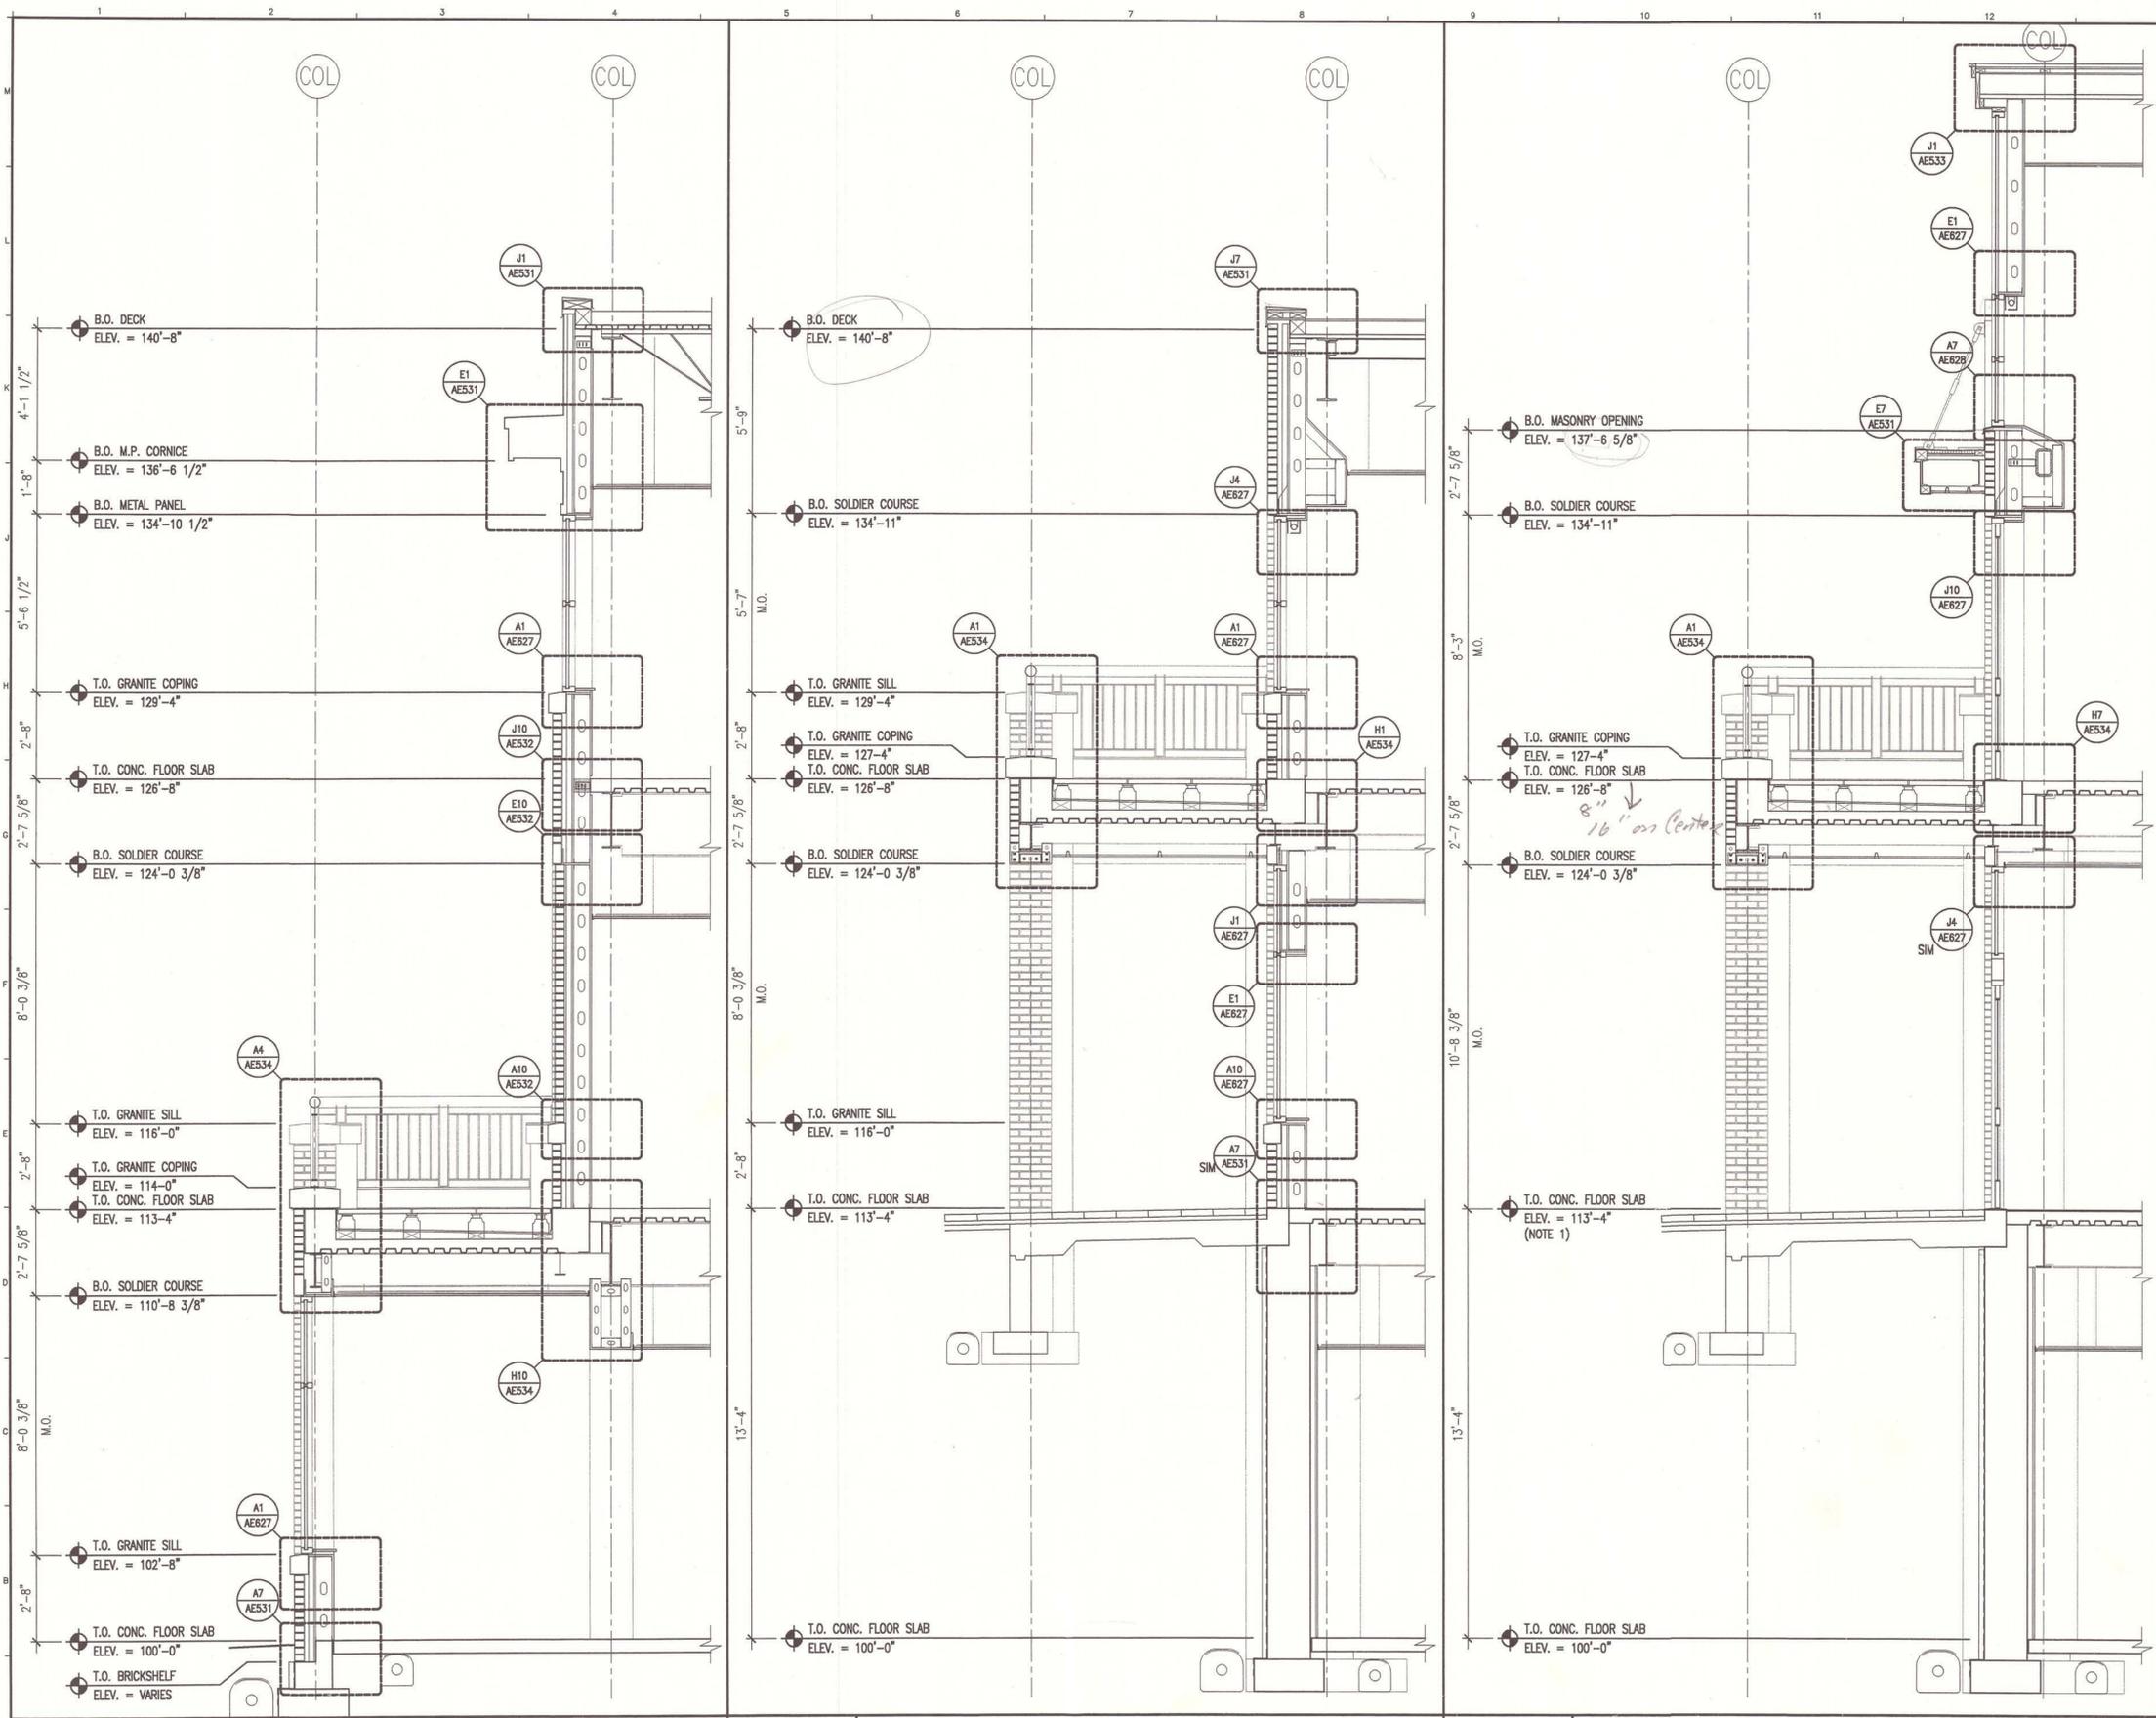

GENERAL NOTES:
 1. SEE G101 FOR PROJECT GENERAL NOTES.



ARCHITECTURE ENGINEERING PLANNING
 SMRT
 144 Fore Street P.O. Box 618
 Portland, Maine 04104
 tel. (207) 772-3846
 fax. (207) 772-1070

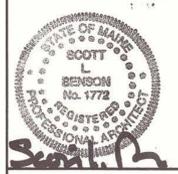

PROJECT TITLE:
**MAINE TURNPIKE AUTHORITY
 ADMINISTRATION BUILDING**
 PORTLAND, MAINE

CURRENT ISSUE STATUS:
**ISSUED FOR BIDDING/CONSTRUCTION
 7-9-07**


REV	DESCRIPTION	DATE
0	BIDDING/CONSTRUCTION	7-9-07

GRAPHIC SCALE:
 0" = 1"
 SCALE: AS NOTED
 PROJECT MANAGER: SLB
 JC/DRAWN BY: TCM/TCM
 A/E OF RECORD: SLB
 CAD FILE: AE314-06016
 PROJECT NO: 06016
 DATE: 7-9-07
 SHEET TITLE:


WALL SECTIONS
 SHEET No. **AE314**

AS BUILT
 Owner Copy


A1	WALL SECTION	A5	WALL SECTION	A9	WALL SECTION
3/8" = 1'-0"	-	3/8" = 1'-0"	-	3/8" = 1'-0"	-

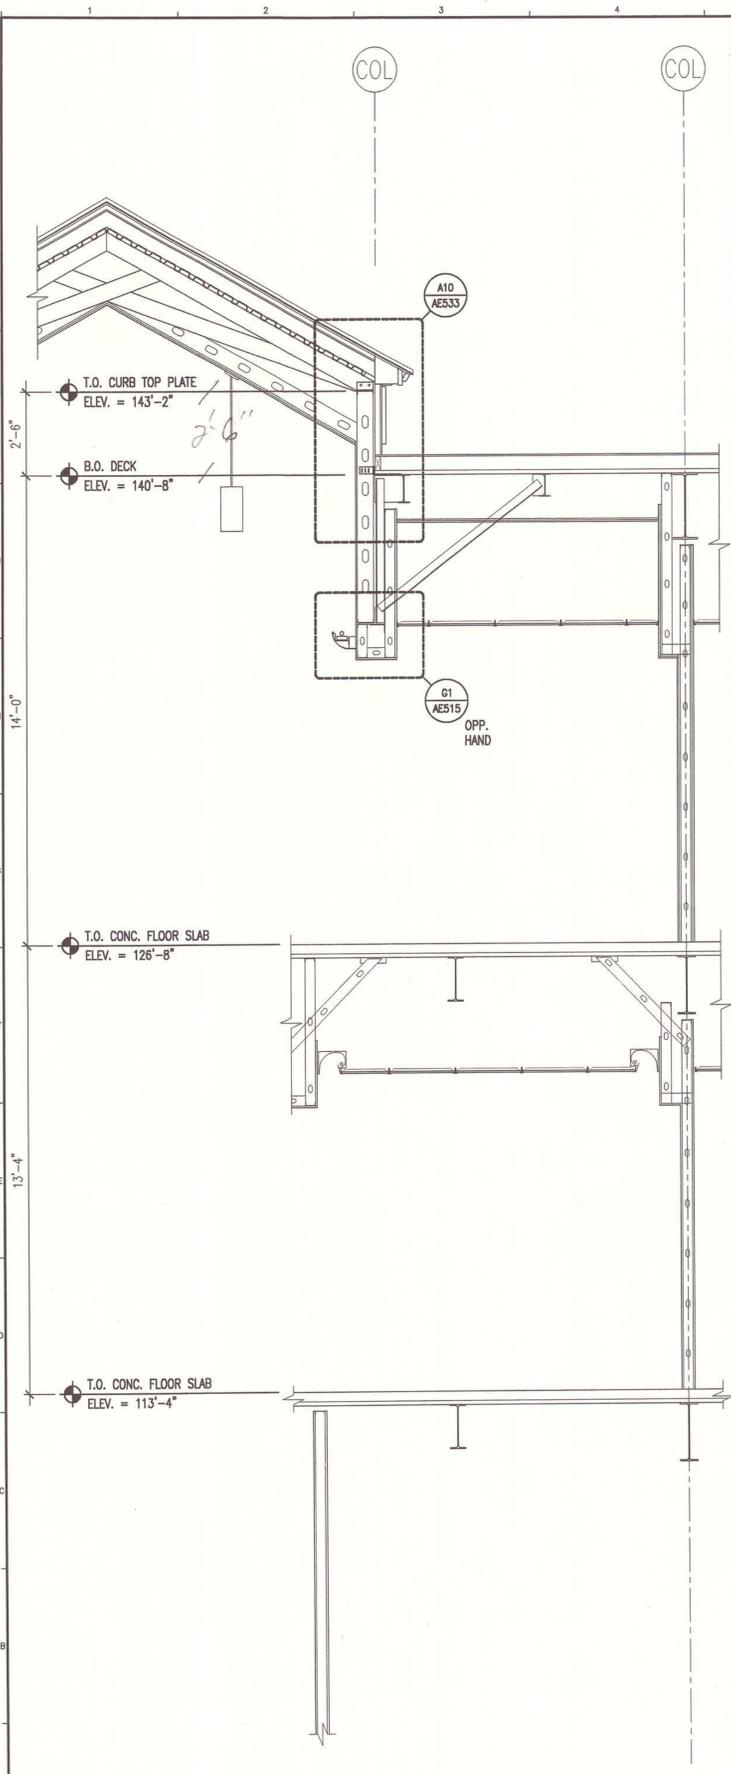

A1 WALL SECTION
3/8" = 1'-0"

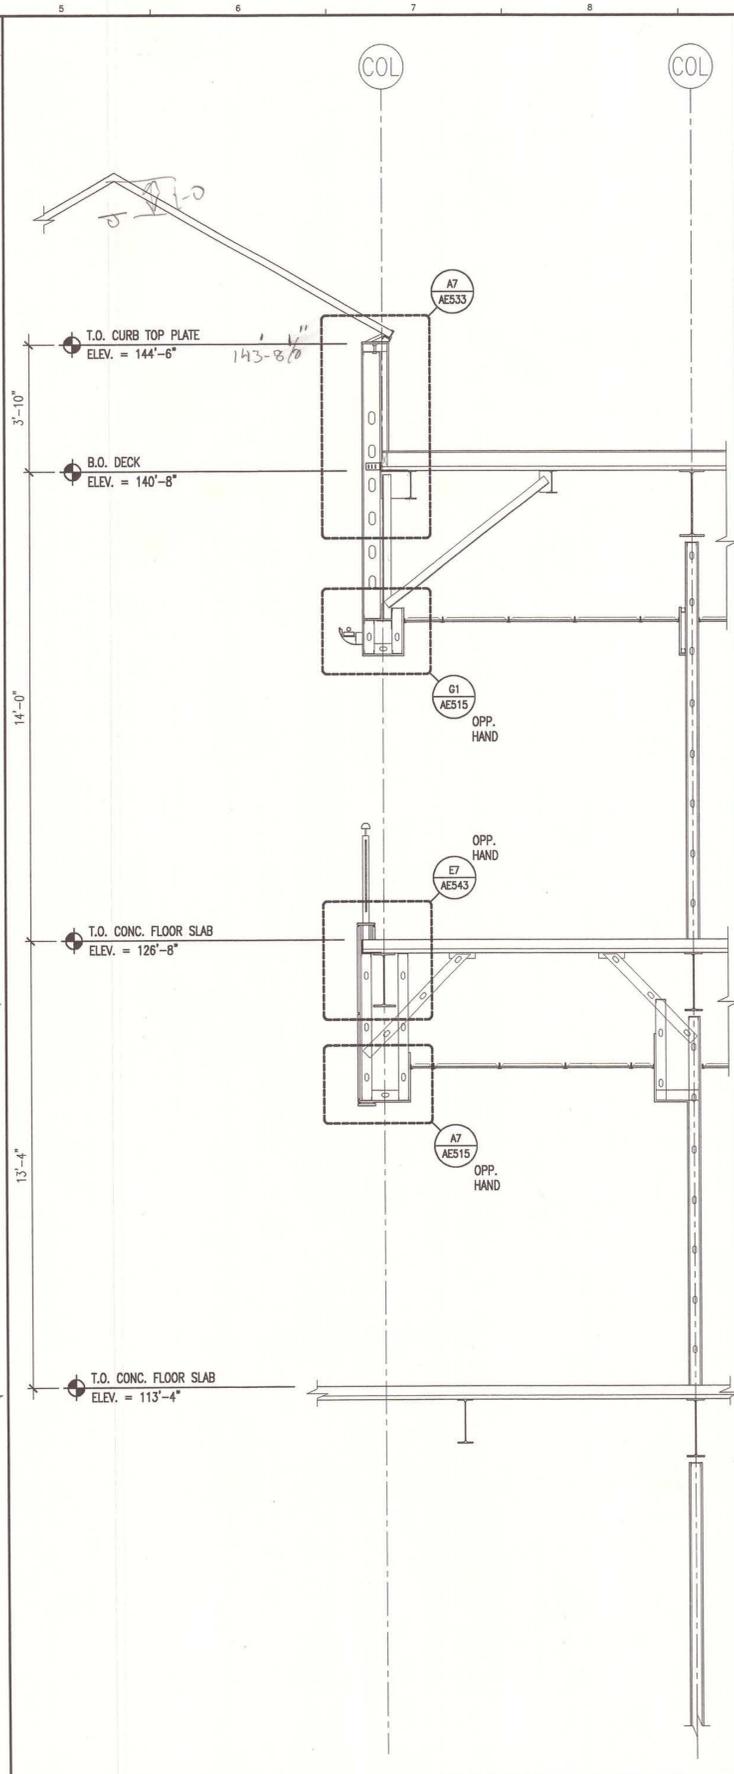

A5 WALL SECTION
3/8" = 1'-0"

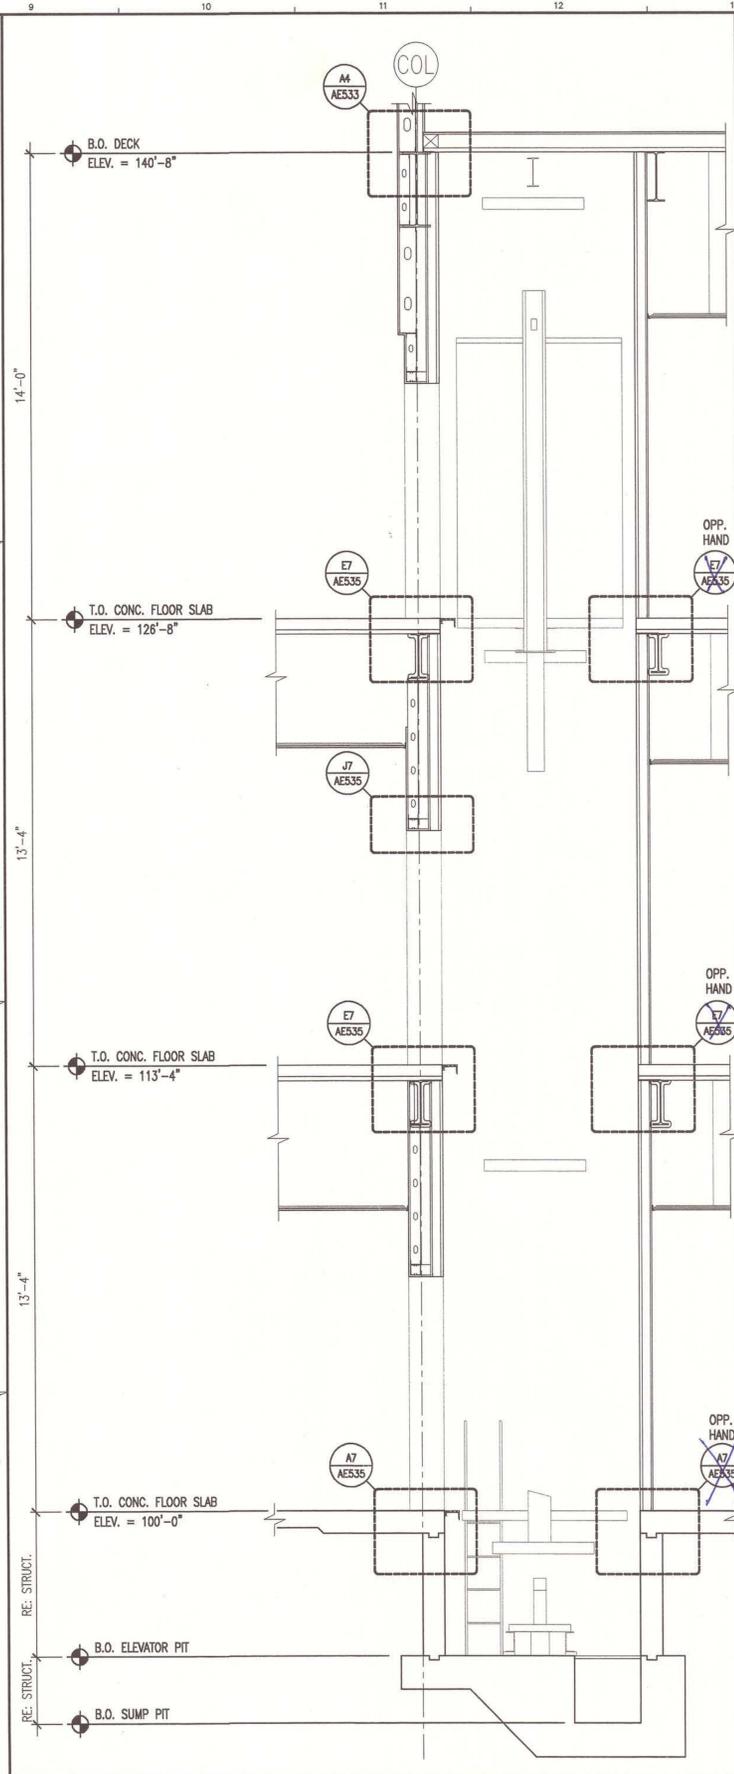

A9 WALL SECTION
3/8" = 1'-0"

GENERAL NOTES:
1. SEE G1001 FOR PROJECT GENERAL NOTES.

E-10
AE535 RFE-121


E-10
AE535 RFE-121

A-10
AE535 RFE-121

AS BUILT
Owner Copy



ARCHITECTURE ENGINEERING PLANNING
SMRT
144 Fore Street/P.O. Box 618
Portland, Maine 04104
tel. (207) 772-3846
fax. (207) 772-1070

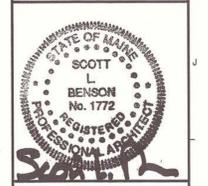

PROJECT TITLE:
**MAINE TURNPIKE AUTHORITY
ADMINISTRATION BUILDING
PORTLAND, MAINE**


CURRENT ISSUE STATUS:
**ISSUED FOR BIDDING/CONSTRUCTION
7-9-07**

REV	BIDDING/CONSTRUCTION DESCRIPTION	DATE
0		7-9-07

GRAPHIC SCALE:
0" = 1"

SCALE: AS NOTED
PROJECT MANAGER: SLB
JC/DRAWN BY: TCM/TCM
A/E OF RECORD: SLB
CAD FILE: AE315-06016
PROJECT NO: 06016
DATE: 7-9-07
SHEET TITLE:

WALL SECTIONS
SHEET No. **AE315**

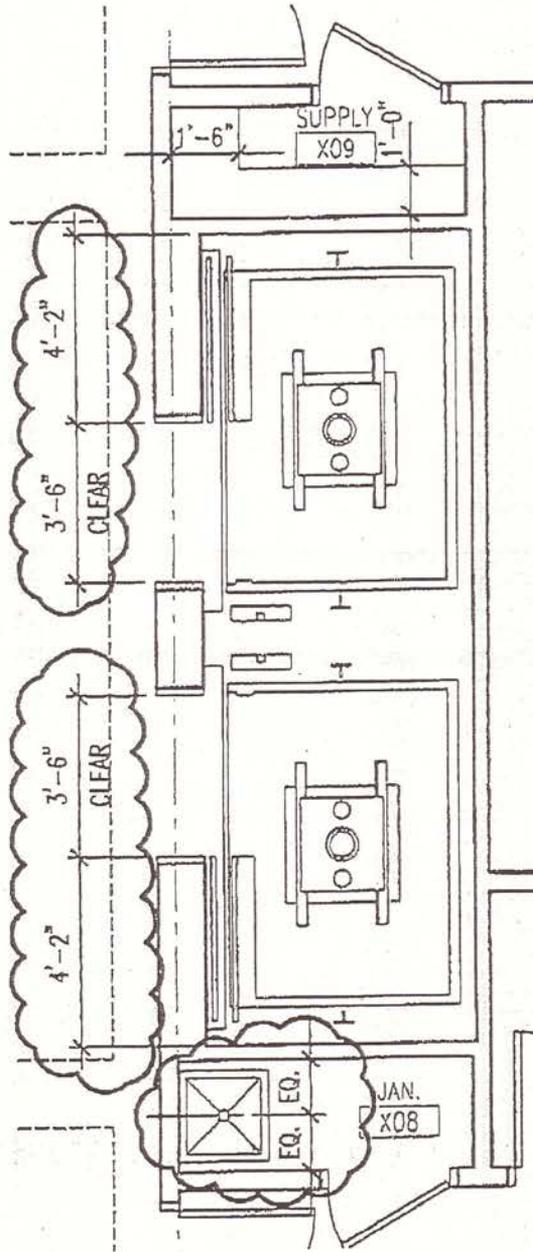

ARCHITECTURE ENGINEERING PLANNING

SMRT

144 Fore Street/P.O.Box 618 PORTLAND, MAINE 04104
tel. (207) 772-3846 / fax. (207) 772-1070

SCALE: 1/4" = 1'-0"

CAD FILE: AE401-06016

PROJECT No. 06016

REF. SHEET: AE401

PROJECT:

MAINE TURNPIKE AUTHORITY
ADMINISTRATION BUILDING

PM: SLB

ADDENDUM No.

ADD-6

SUBJECT:

REVISED A13/AE401
ENLARGED PLAN © ELEVATORS





A/E: SLB

SHEET No.

A-4

DATE: 8-23-07

© COPYRIGHT 2007 SMRT INC.

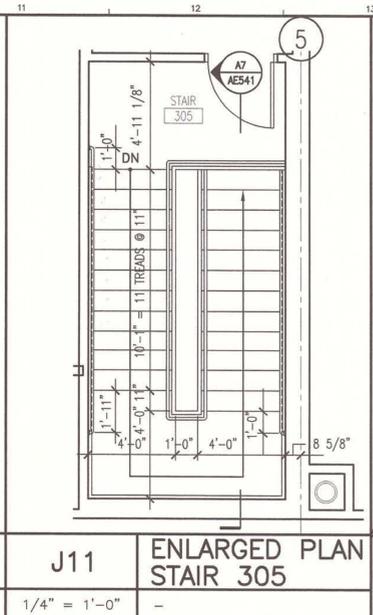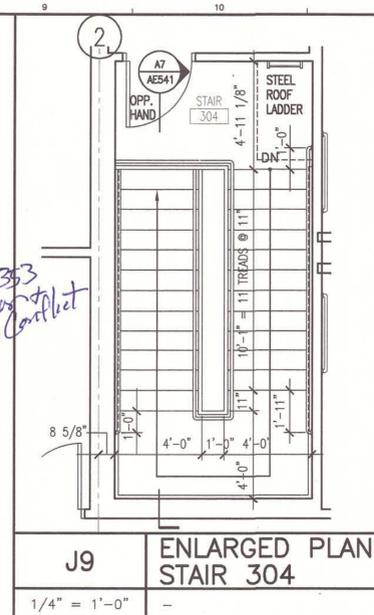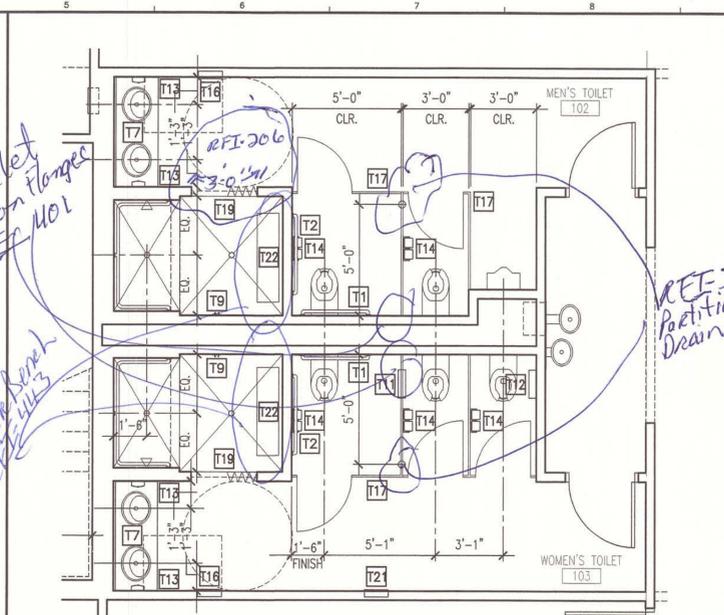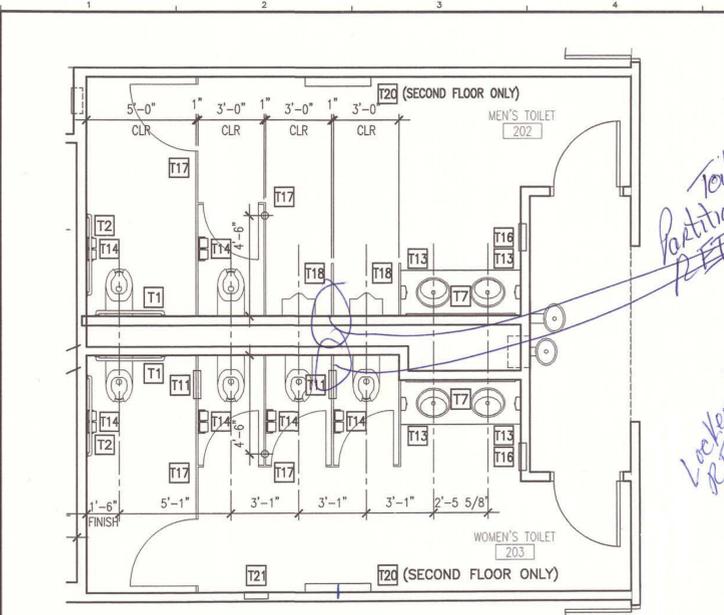

GENERAL NOTES:

- REFER TO G001 FOR PROJECT GENERAL NOTES.
- REFER TO AE220 FOR INTERIOR ELEVATIONS OF MAJOR TOILET ROOMS.
- PROVIDE BLOCKING AS REQUIRED TO ANCHOR TOILET ACCESSORIES.

AS BUILT
Owner Copy

TOILET ACCESSORIES KEY NOTES:







- T1 36" GRAB BARS
- T2 42" GRAB BARS
- T3 SMALLER PAPER TOWEL DISPENSER/ WASTE RECEPTACLE OS
- T4 36" GRAB BARS-DETENTION GRADE
- T5 42" GRAB BARS-DETENTION GRADE
- T6 PAPER TOWEL DISPENSER ?
- T7 MIRROR, 24"Wx48"H UNLESS OTHERWISE NOTED, RE: AE220
- T8 MIRROR-DETENTION GRADE, 24"Wx48"H
- T9 CLOTHES HOOKS, PAIR, MOUNTING HTS. 40" & 60" A.F.F.?
- T10 CLOTHES HOOKS-DETENTION GRADE, PAIR, MOUNTING HTS. 40" & 60" A.F.F.?
- T11 SANITARY NAPKIN DISPOSAL-PARTITION MOUNTED ?
- T12 SANITARY NAPKIN DISPOSAL-SURFACE MOUNTED ?
- T13 SOAP DISPENSER OS
- T14 TOILET TISSUE DISPENSER OI
- T15 TOILET TISSUE DISPENSER-DETENTION GRADE *use Has on site*
- T16 COMBINATION TOWEL DISPENSER/ WASTE RECEPTACLE-RECESSED OS
- T17 TOILET PARTITIONS
- T18 URINAL PARTITIONS, 48"H
- T19 SHOWER CURTAIN, HOOKS & ROD ?
- T20 DIAPER CHANGING STATION ?
- T21 SANITARY NAPKIN VENDOR ?
- T22 LOCKER BENCH

H1 ENLARGED PLAN - MEN'S TOILET 202/302 AND WOMEN'S TOILET 203/303
1/4" = 1'-0"

H5 ENLARGED PLAN - MEN'S TOILET 102 AND WOMEN'S TOILET 103
1/4" = 1'-0"

J9 ENLARGED PLAN STAIR 304
1/4" = 1'-0"

J11 ENLARGED PLAN STAIR 305
1/4" = 1'-0"

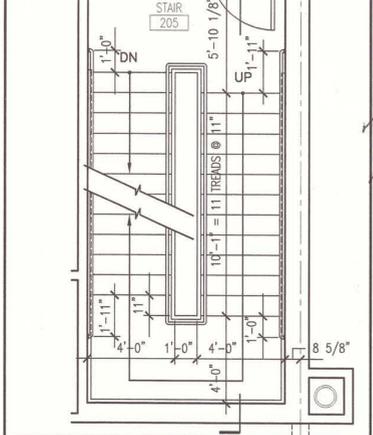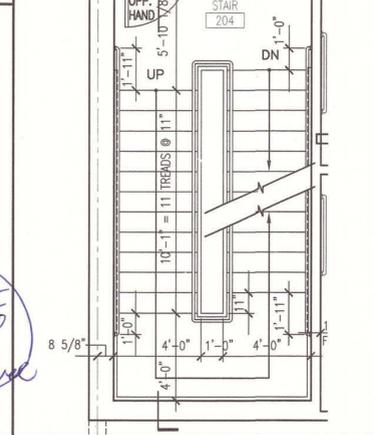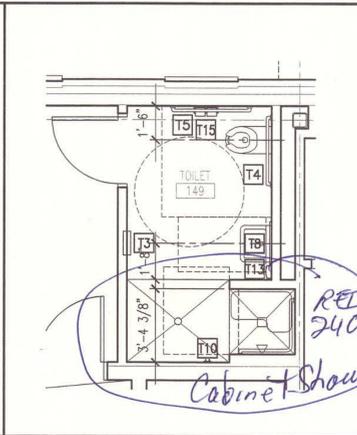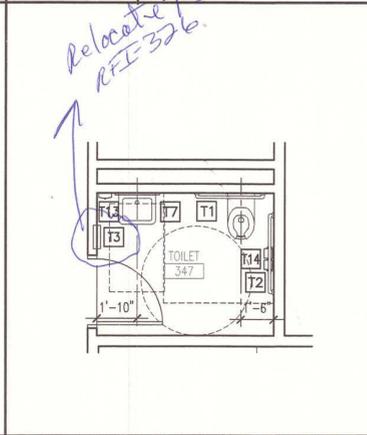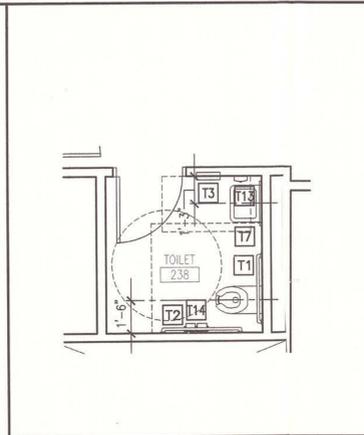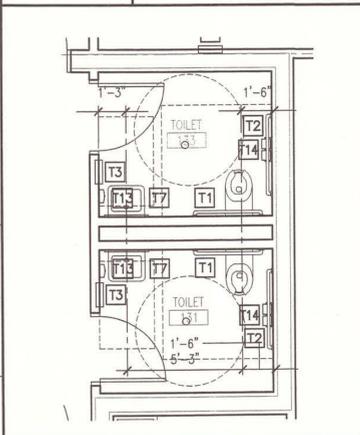

E1 ENLARGED PLAN TOILETS 133 & 131
1/4" = 1'-0"







E3 ENLARGED PLAN TOILET 238
1/4" = 1'-0"

E5 ENLARGED PLAN TOILET 347
1/4" = 1'-0"

E7 ENLARGED PLAN TOILET 149
1/4" = 1'-0"

E9 ENLARGED PLAN STAIR 204
1/4" = 1'-0"

E11 ENLARGED PLAN STAIR 205
1/4" = 1'-0"

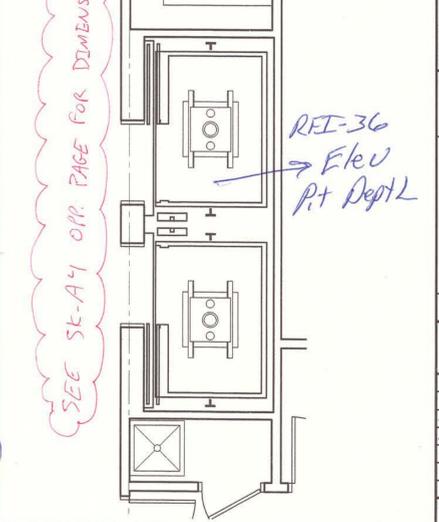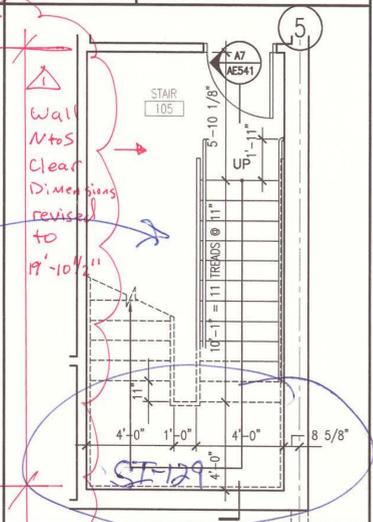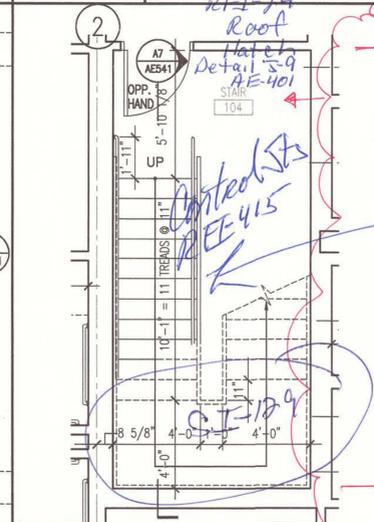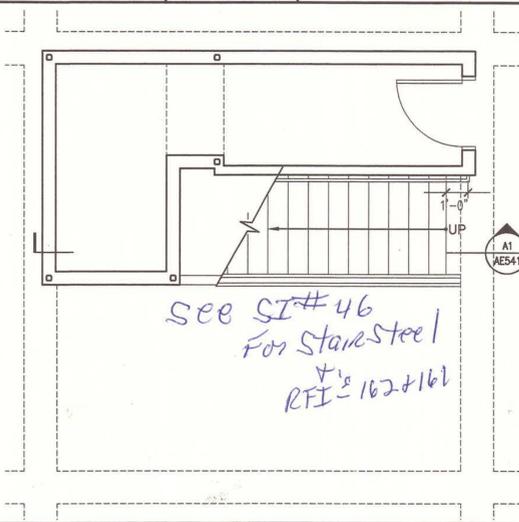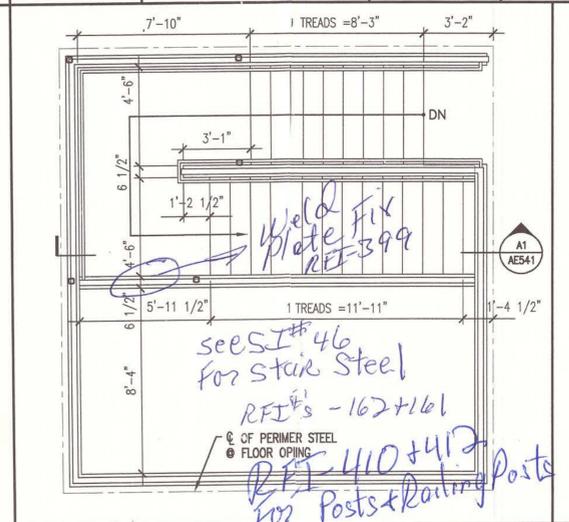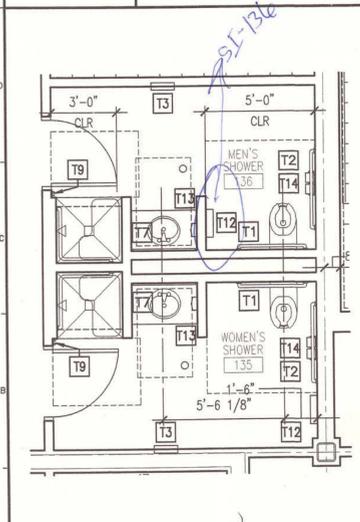

A1 ENLARGED PLAN SHOWERS 136 & 135
1/4" = 1'-0"

A3 ENLARGED PLAN STAIRS @ GALLERY 301
1/4" = 1'-0"

A6 ENLARGED PLAN STAIRS @ HALL 201
1/4" = 1'-0"

A9 ENLARGED PLAN STAIR 104
1/4" = 1'-0"

A11 ENLARGED PLAN STAIR 105
1/4" = 1'-0"

A13 ENLARGED PLAN @ ELEVATORS
1/4" = 1'-0"

SM RT

ARCHITECTURE ENGINEERING PLANNING
SWRT
144 Fore Street/P.O. Box 618
Portland, Maine 04104
tel. (207) 772-3846
fax. (207) 772-1070

STATE OF MAINE
SCOTT L. BENSON
No. 1772
REGISTERED PROFESSIONAL ARCHITECT

PROJECT NORTH
NORTH

MAINE TURNPIKE AUTHORITY
ADMINISTRATION BUILDING
PORTLAND, MAINE

ISSUED FOR BIDDING/CONSTRUCTION
7-9-07


REV	DESCRIPTION	DATE
0	BIDDING/CONSTRUCTION	7-9-07

GRAPHIC SCALE: 0" = 1"

SCALE: AS NOTED


PROJECT MANAGER: SLB
JC/DRAWN BY: TCM/TCM
A/E OF RECORD: SLB
CAD FILE: AE401-06016
PROJECT NO: 06016
DATE: 7-9-07

ENLARGED PARTIAL PLANS
SHEET No. **AE401**

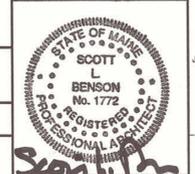


MAINE TURNPIKE AUTHORITY
ADMINISTRATION BUILDING
PORTLAND, MAINE
ISSUED FOR BIDDING/CONSTRUCTION
7-9-07

PROJECT TITLE:	MAINTENANCE BUILDING PLANS & ELEVATIONS
CURRENT ISSUE STATUS:	ISSUED FOR BIDDING/CONSTRUCTION
DATE:	7-9-07
DESCRIPTION:	
REV:	0
BIDDING/CONSTRUCTION:	
SCALE:	AS NOTED
PROJECT MANAGER:	SLB
JC/DRAWN BY:	TCM/TCM
A/E OF RECORD:	SLB
CAD FILE:	AE402-06016
PROJECT NO.:	06016
DATE:	7-9-07
SHEET TITLE:	MAINTENANCE BUILDING PLANS & ELEVATIONS
SHEET No.:	AE402

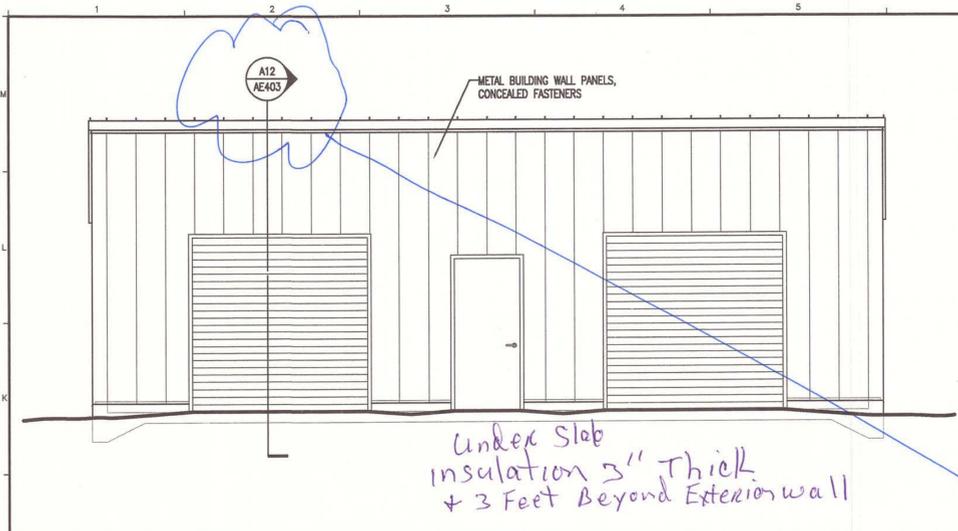


J1 FRONT ELEVATION
1/4" = 1'-0"


*Under Slab
insulation 3" Thick
+ 3 Feet Beyond Exterior wall*

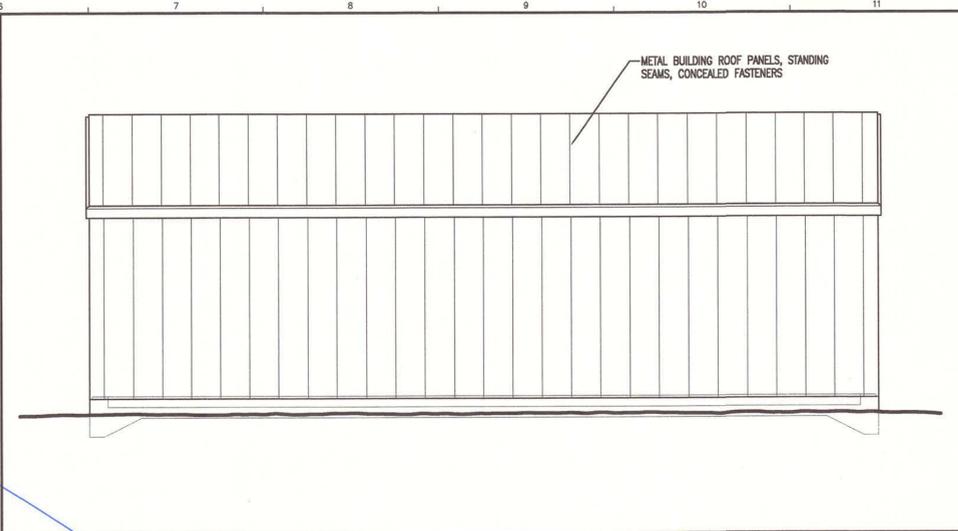


J6 REAR ELEVATION
1/4" = 1'-0"

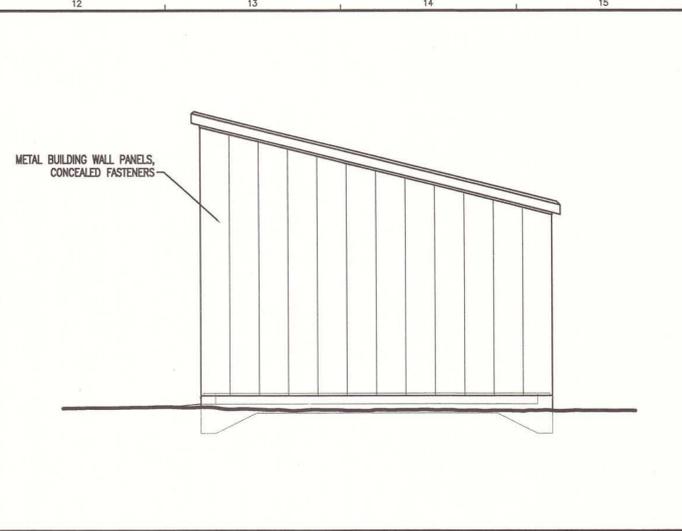


J12 SIDE ELEVATION
1/4" = 1'-0"

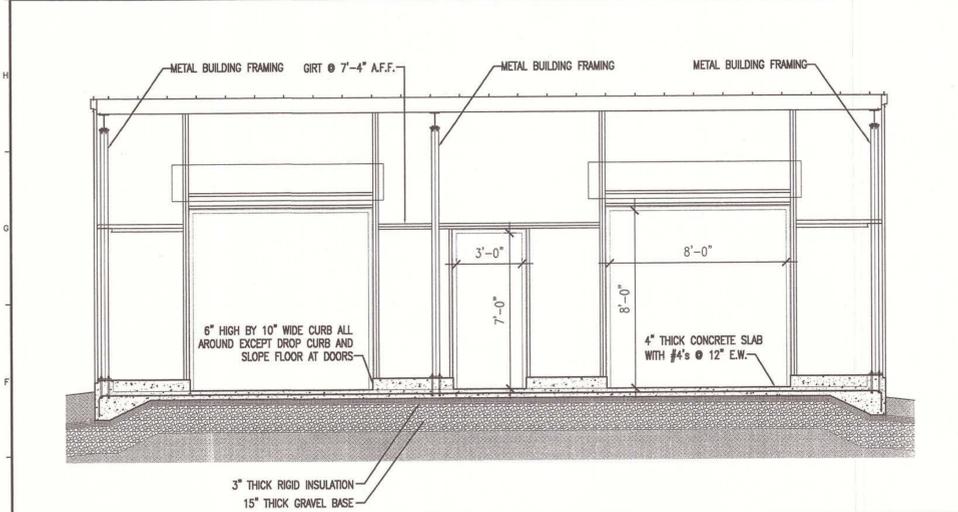

E1 FRONT WALL FRAMING ELEVATION
1/4" = 1'-0"

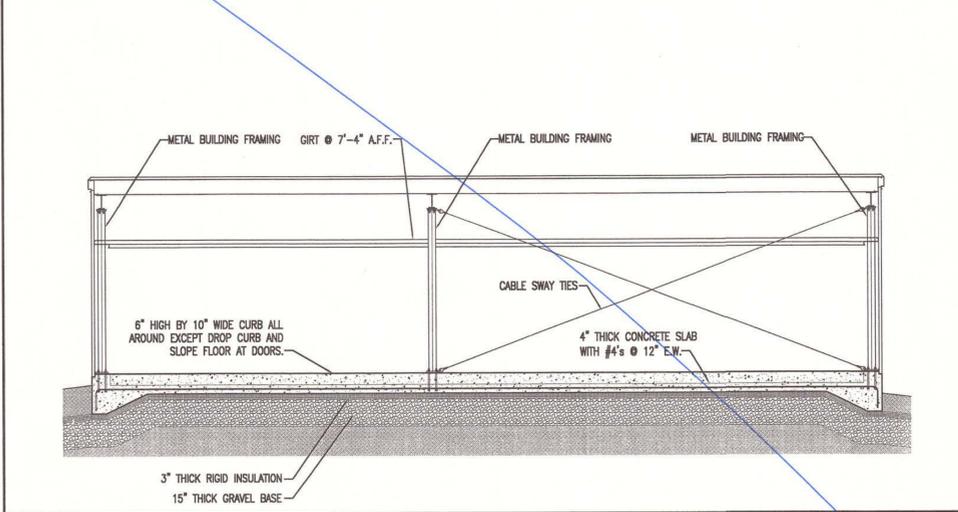


E6 REAR WALL FRAMING ELEVATION
1/4" = 1'-0"

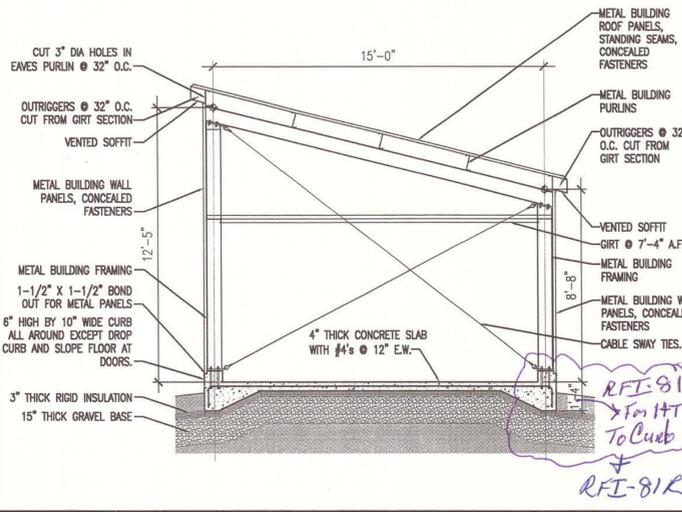

E12 SIDE WALL FRAMING ELEVATION
1/4" = 1'-0"


*RFI-81
*For HT
To Curb
+
RFI-81R*

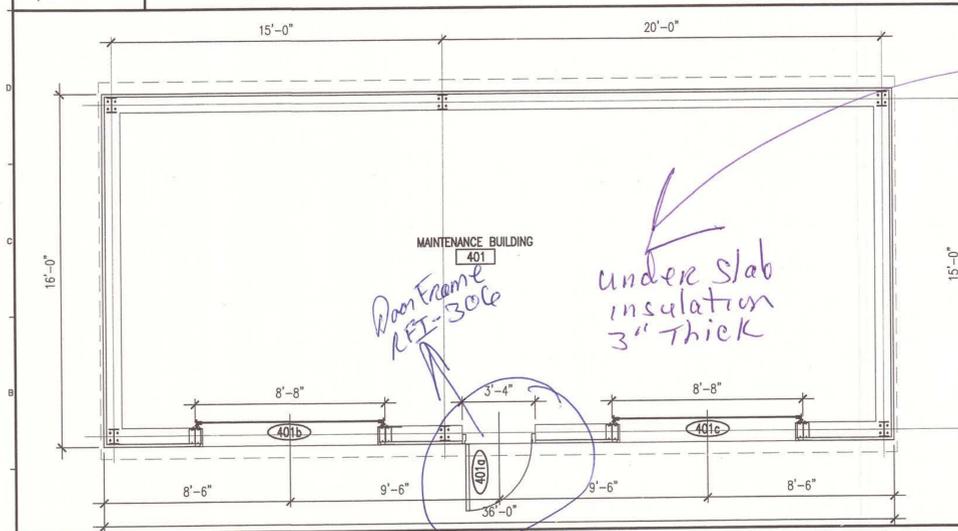


A1 FLOOR PLAN
1/4" = 1'-0"

*under slab
insulation
3" Thick*

*Door Frame
RFI-306*

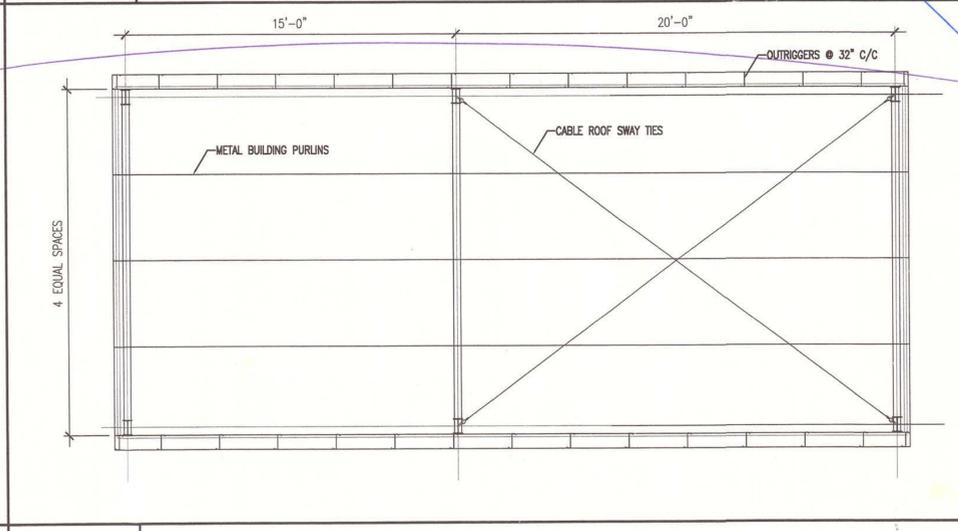

A6 ROOF FRAMING PLAN
1/4" = 1'-0"

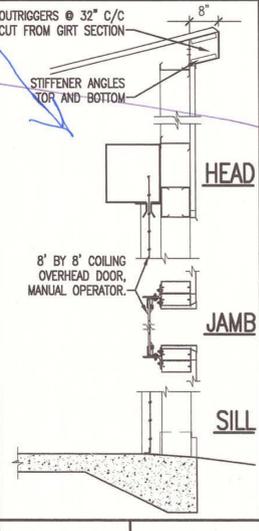


A12 SECTION
1/2" = 1'-0"

- GENERAL NOTES:**
- SEE 6101 FOR PROJECT GENERAL NOTES.
 - FOUNDATION: CLEAN GRAVEL COMPACTED TO 95% MIN DENSITY, EXTEND BEYOND FLOOR SLAB 36".
 - UNDER SLAB INSULATION: 3" THICK EXTRUDED POLY- STYRENE INSULATION, EXTEND 36" BEYOND FLOOR SLAB.
 - FLOOR SLAB: 3000 PSI 28 DAY COMPRESSIVE STRENGTH CONCRETE, 0.45 WATER CEMENT RATIO, STEEL TROWEL FINISH, CURE WITH CURING COMPOUND.
 - STRUCTURAL STEEL: PRE-ENGINEERED METAL BUILDING PACKAGE INCLUDING STRUCTURAL MEMBERS, COLD ROLLED GIRTS AND PURLINS, CABLE TIES, ANCHOR BOLTS, THREE COAT FLUOROPOLYMER FINISH ON METAL WALL PANELS, GALVALUME FINISH ON ROOF PANELS, CONCEALED FASTENERS, WALL AND ROOF TRIM AND ALL ACCESSORIES NECESSARY FOR A COMPLETE BUILDING ENCLOSURE. COLOR OF PANELS TO BE SELECTED FROM MANUFACTURER'S STANDARD COLORS. REFER TO SPECIFICATIONS FOR ADDITIONAL INFORMATION.

*3-coat
Fluoropolymer
Finish*

**AS BUILT
Owner Copy**

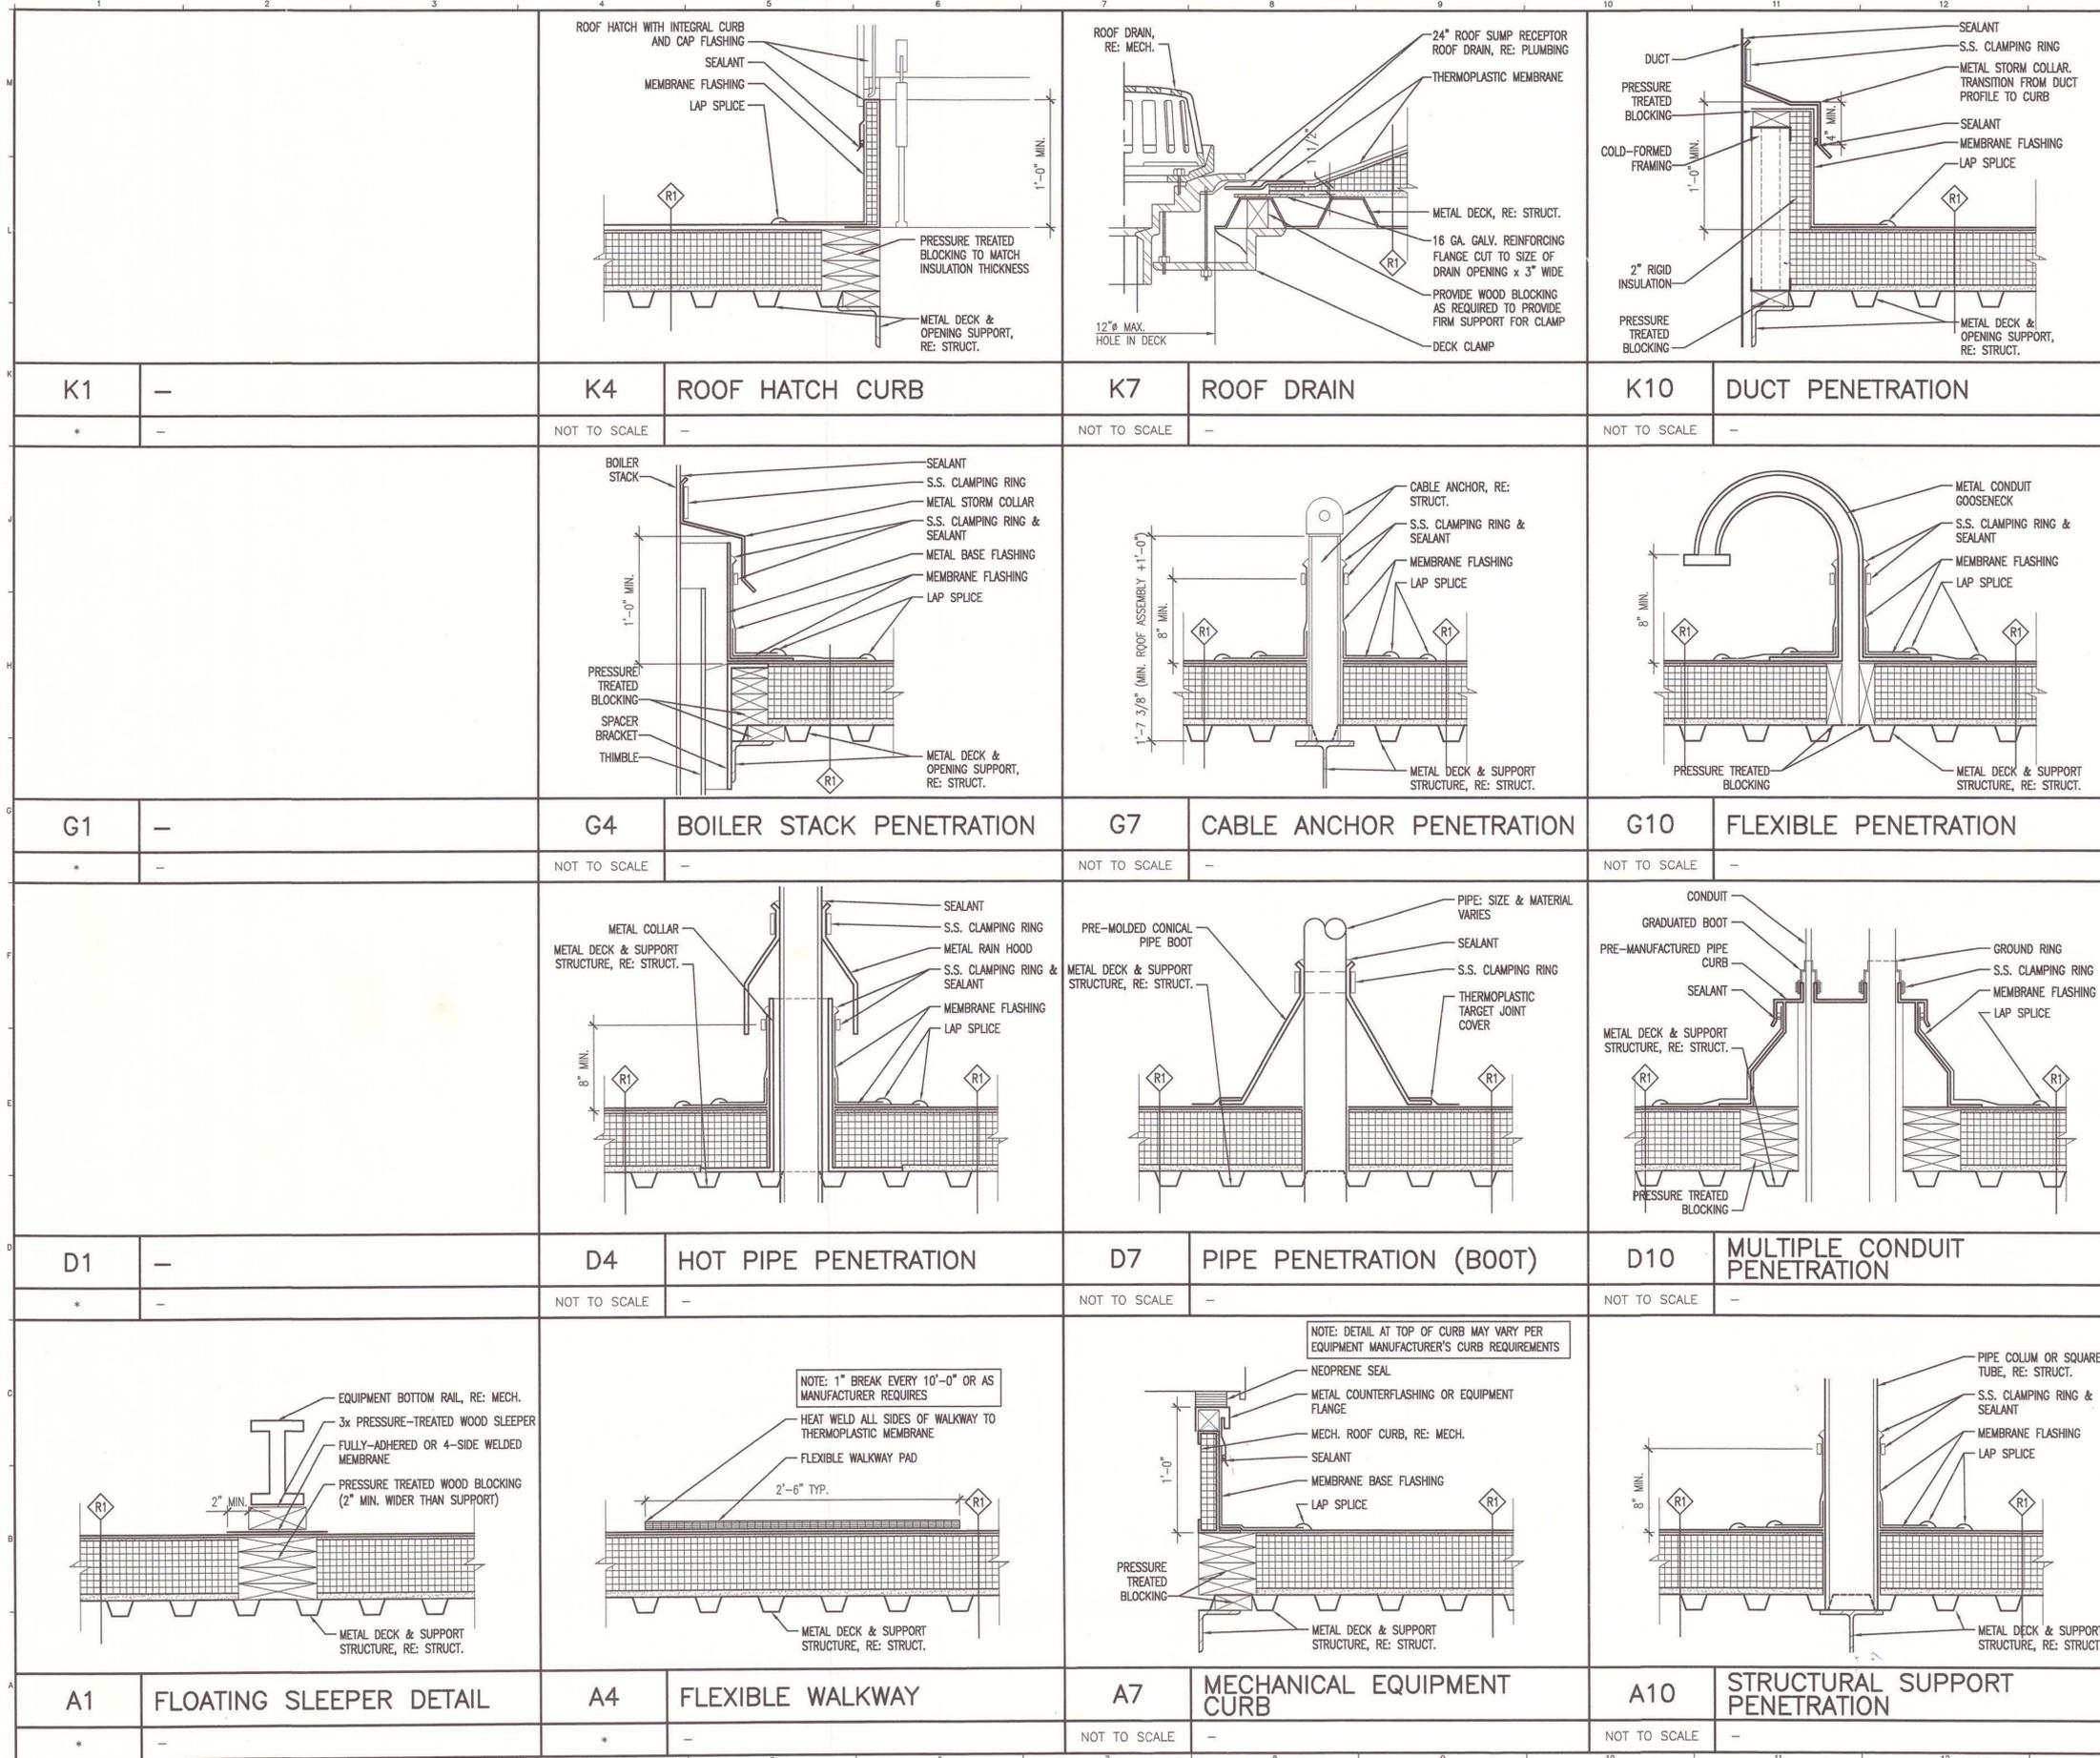

GENERAL NOTES:
 1. SEE G1001 FOR PROJECT GENERAL NOTES.



ARCHITECTURE ENGINEERING PLANNING
 SMART
 144 Fore Street/P.O. Box 618
 Portland, Maine 04104
 tel. (207) 772-3846
 fax. (207) 772-1070



PROJECT TITLE:
**MAINE TURNPIKE AUTHORITY
 ADMINISTRATION BUILDING**
 PORTLAND, MAINE
 CURRENT ISSUE STATUS:
ISSUED FOR BIDDING/CONSTRUCTION
 7-9-07

REV	DESCRIPTION	DATE
0	BIDDING/CONSTRUCTION	7-9-07

GRAPHIC SCALE:
 0" = 1"
 SCALE: AS NOTED
 PROJECT MANAGER: SLB
 JC/DRAWN BY: TCM/TCM
 A/E OF RECORD: SLB
 CAD FILE: AE501-06016
 PROJECT NO: 06016
 DATE: 7-9-07
 SHEET TITLE:
TYPICAL SECTIONS & DETAILS
 SHEET No. **AE501**

**AS BUILT
 Owner Copy**

GENERAL NOTES:
 1. SEE G101 FOR PROJECT GENERAL NOTES.

**SM
RT**

ARCHITECTURE ENGINEERING PLANNING
 SMRT
 144 Fore Street/P.O. Box 618
 Portland, Maine 04104
 Tel. (207) 772-3846
 Fax. (207) 772-1070



Scott L. Benson

PROJECT TITLE:
**MAINE TURNPIKE AUTHORITY
 ADMINISTRATION BUILDING**
 PORTLAND, MAINE

CURRENT ISSUE STATUS:
ISSUED FOR BIDDING/CONSTRUCTION
7-9-07

REV	DESCRIPTION	DATE
0	BIDDING/CONSTRUCTION	7-9-07

GRAPHIC SCALE:
 0" 1"

SCALE: AS NOTED
 PROJECT MANAGER: SLB
 JC/DRAWN BY: TCM/TCM
 A/E OF RECORD: SLB
 CAD FILE: AES11-06016
 PROJECT NO: 06016
 DATE: 7-9-07

SHEET TITLE:
**PLAN
 SECTIONS & DETAILS**

SHEET No.
AE511

J1	-	J4	-	J7	PLAN DETAIL	J10	PLAN DETAIL							
*	-	*	-	1 1/2" = 1'-0"	-	1 1/2" = 1'-0"	-							
E1	-	E4	PLAN DETAIL ③ CANOPY SUPPORT	E7	PLAN DETAIL	E10	PLAN DETAIL							
*	-	1 1/2" = 1'-0"	-	1 1/2" = 1'-0"	-	1 1/2" = 1'-0"	-							
A1	-	A4	PLAN DETAIL	A7	PLAN DETAIL	A10	PLAN DETAIL							
*	-	1 1/2" = 1'-0"	-	1 1/2" = 1'-0"	-	1 1/2" = 1'-0"	-							

**AS BUILT
 Owner Copy**



PROJECT TITLE:
**MAINE TURNPIKE AUTHORITY
ADMINISTRATION BUILDING**
PORTLAND, MAINE

CURRENT ISSUE STATUS:

ISSUED FOR BIDDING/CONSTRUCTION
7-9-07


REV	DESCRIPTION	DATE
0	BIDDING/CONSTRUCTION	7-9-07

GRAPHIC SCALE:
0" 1"


SCALE: AS NOTED
PROJECT MANAGER: SLB
JC/DRAWN BY: TCM/TCM
A/E OF RECORD: SLB
CAD FILE: AE512-06016
PROJECT NO: 06016
DATE: 7-9-07
SHEET TITLE:
**PLAN
SECTIONS & DETAILS**
SHEET No. **AE512**

GENERAL NOTES:


1. SEE G1001 FOR PROJECT GENERAL NOTES.

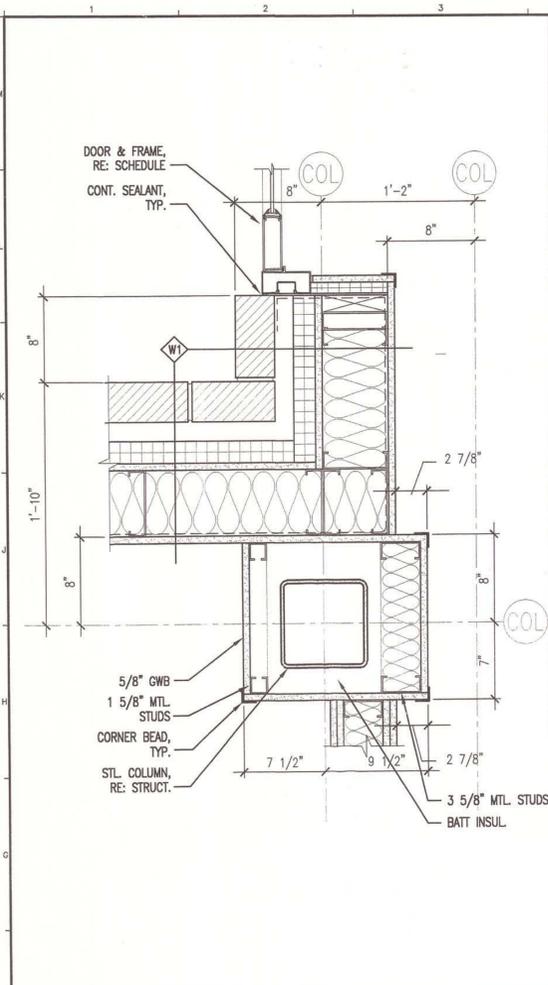


F1 PLAN DETAIL
1 1/2" = 1'-0"

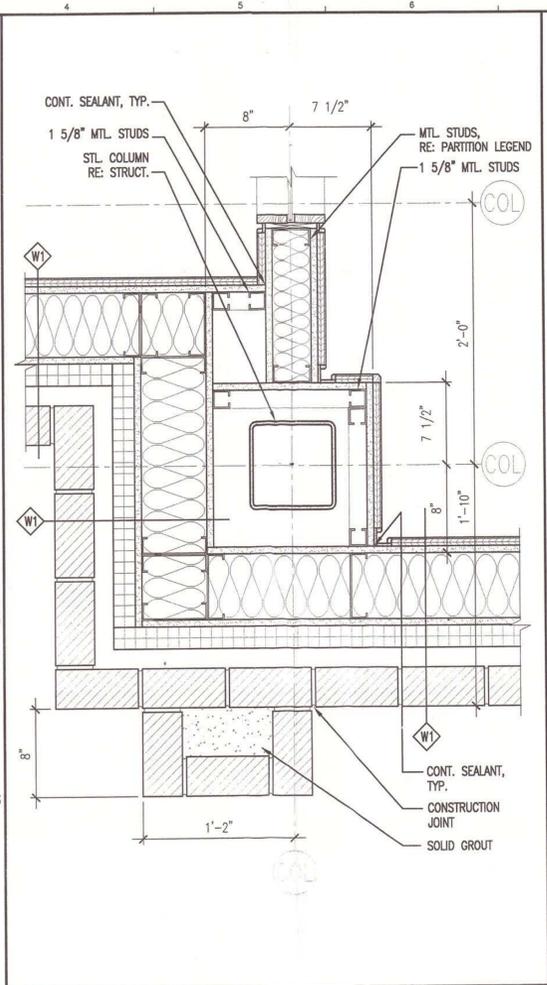


F4 PLAN DETAIL
1 1/2" = 1'-0"

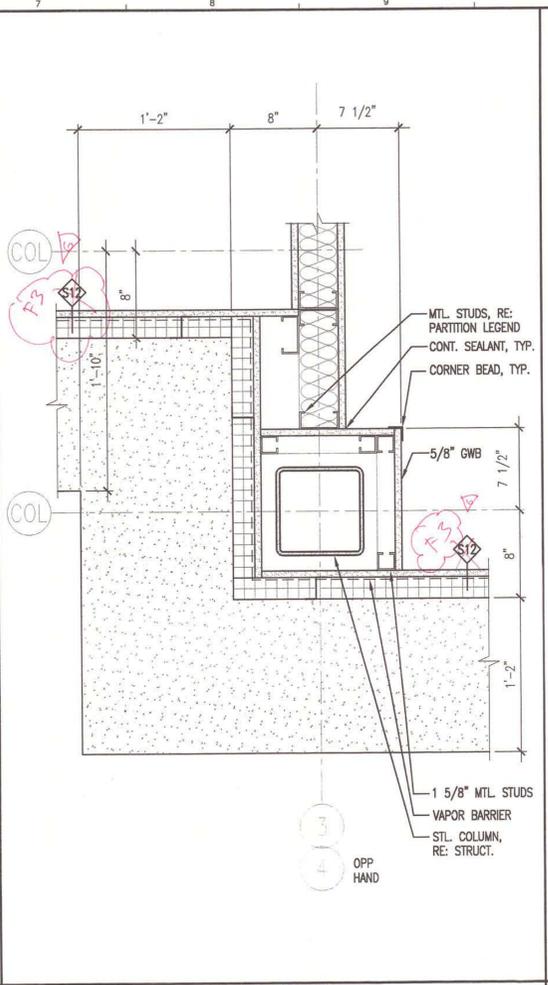


F7 PLAN DETAIL
1 1/2" = 1'-0"

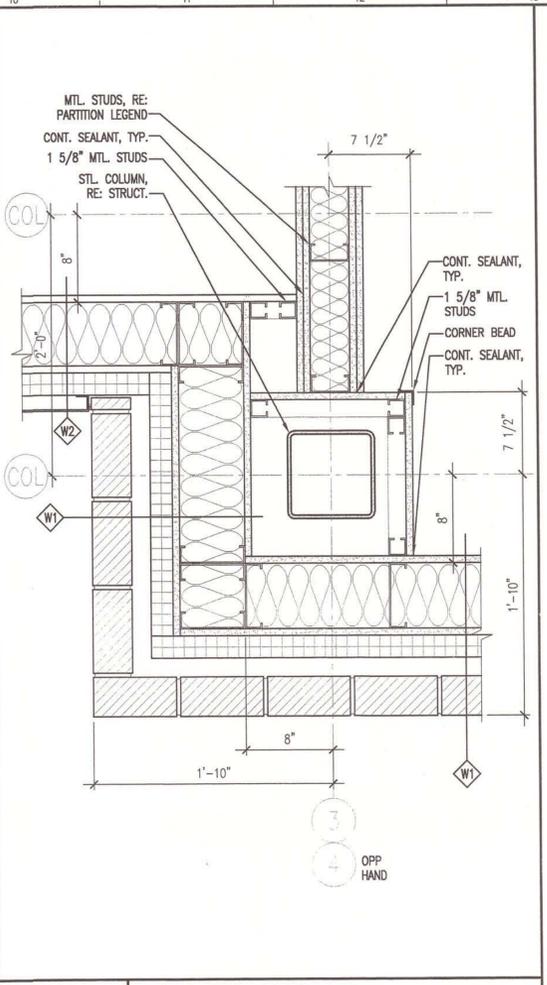

F10 PLAN DETAIL
1 1/2" = 1'-0"






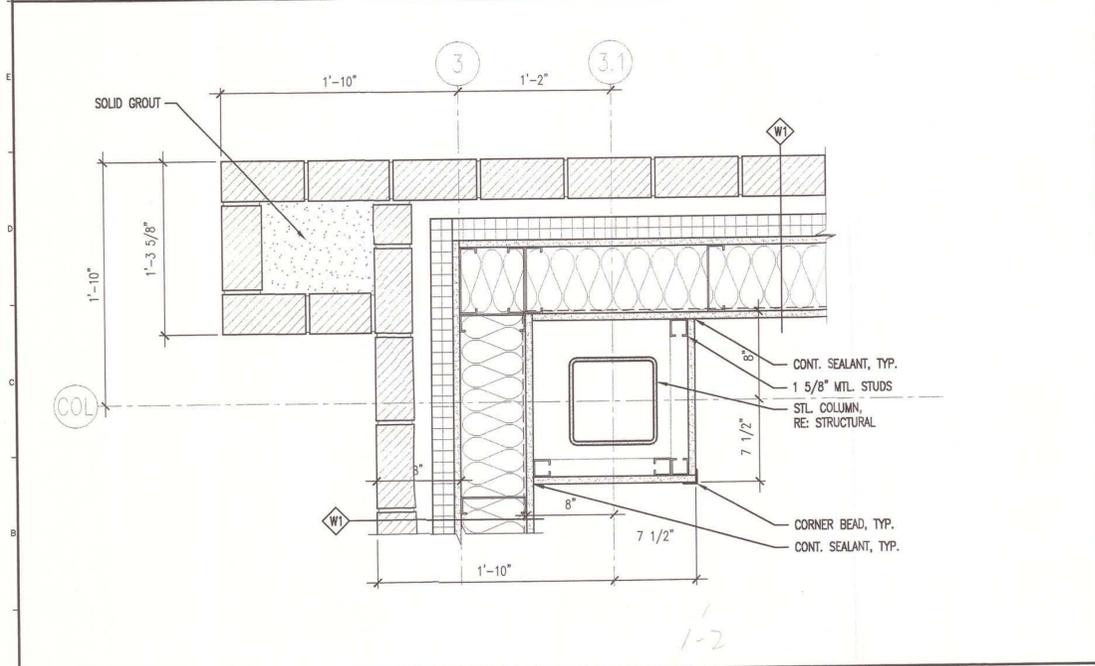


A1 PLAN DETAIL
1 1/2" = 1'-0"

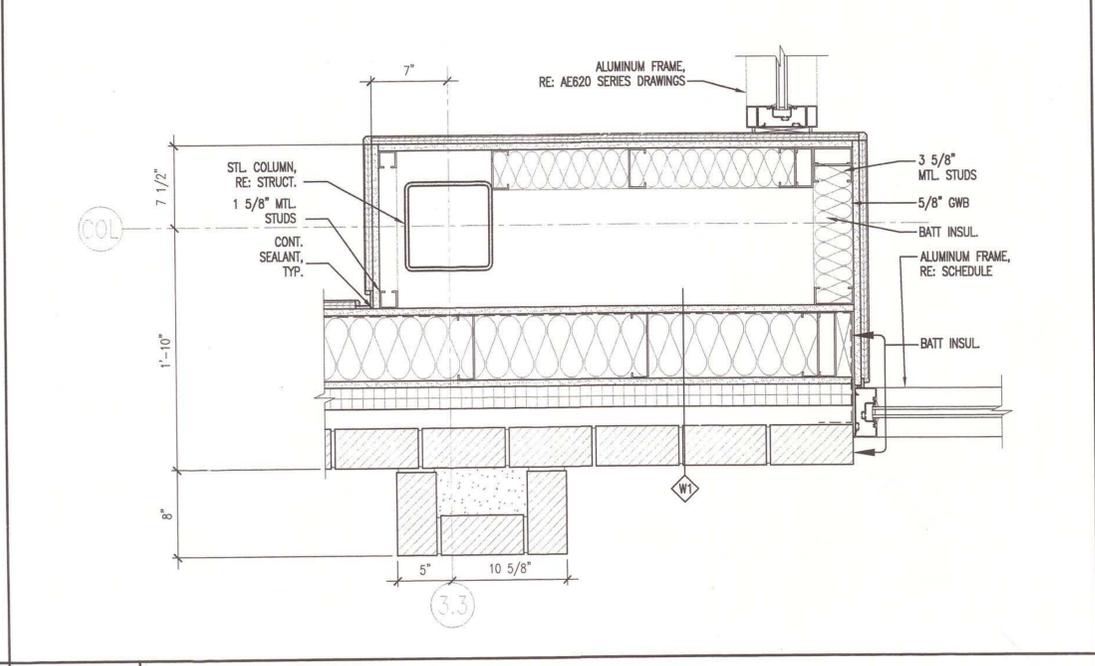

A7 PLAN DETAIL
1 1/2" = 1'-0"

**AS BUILT
Owner Copy**

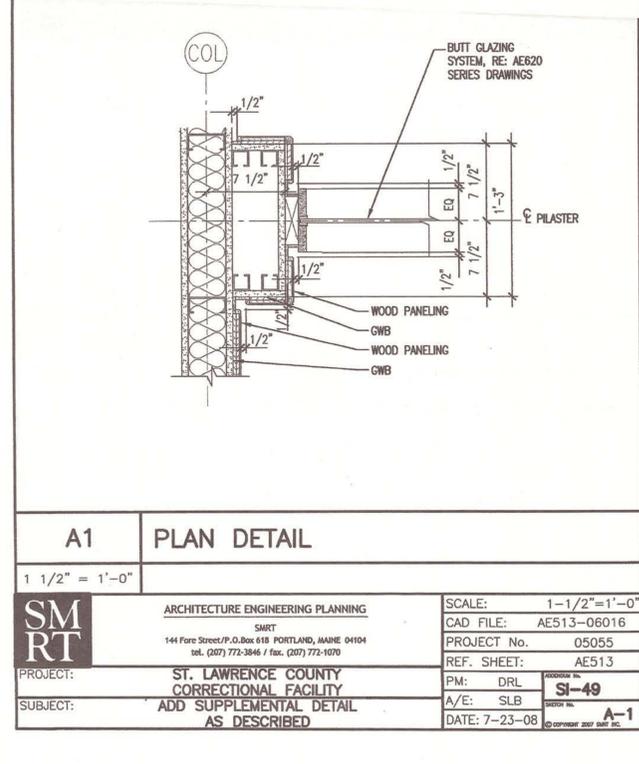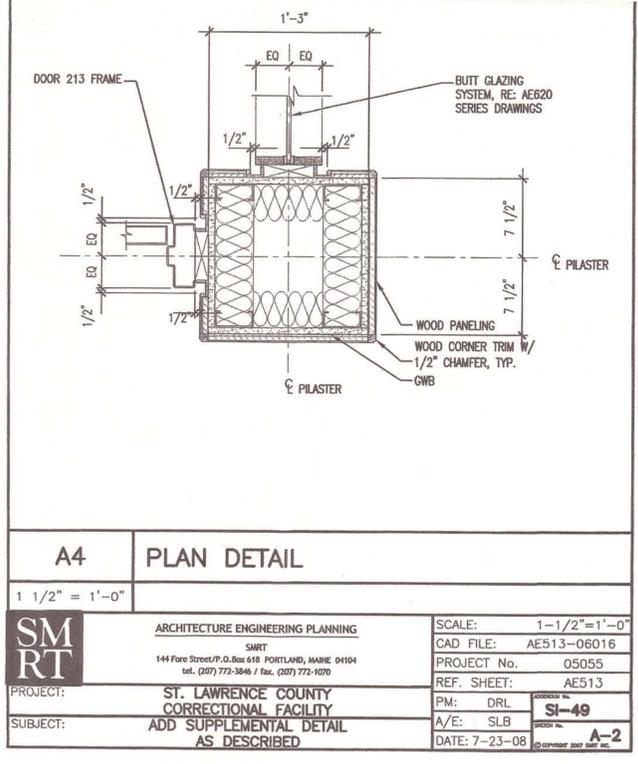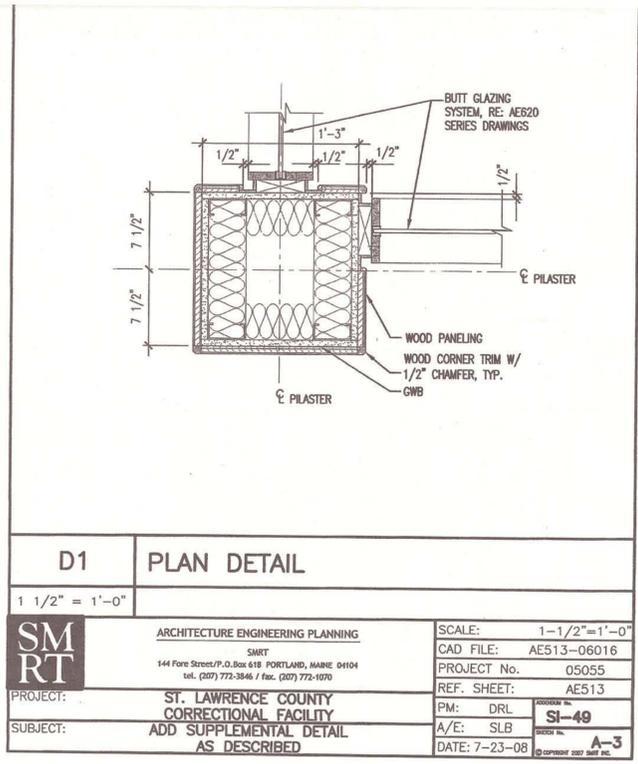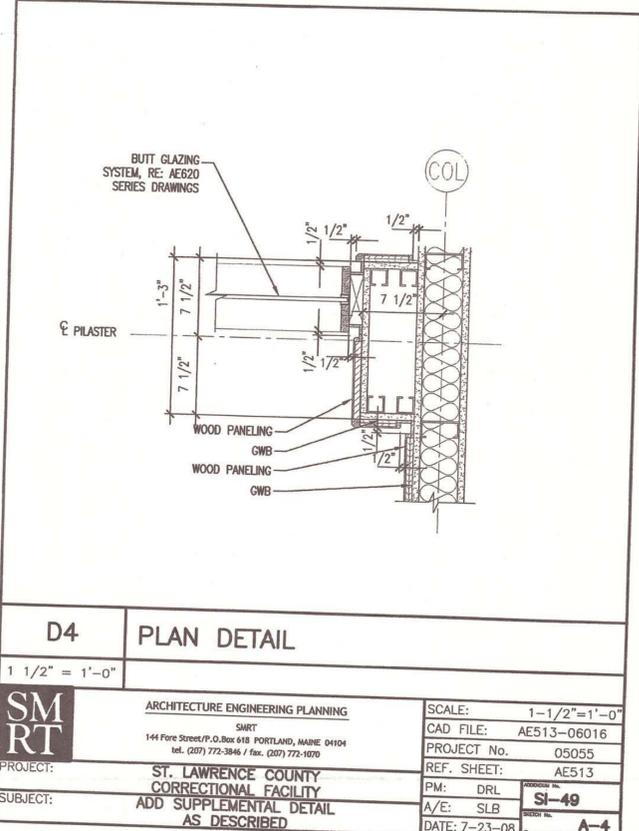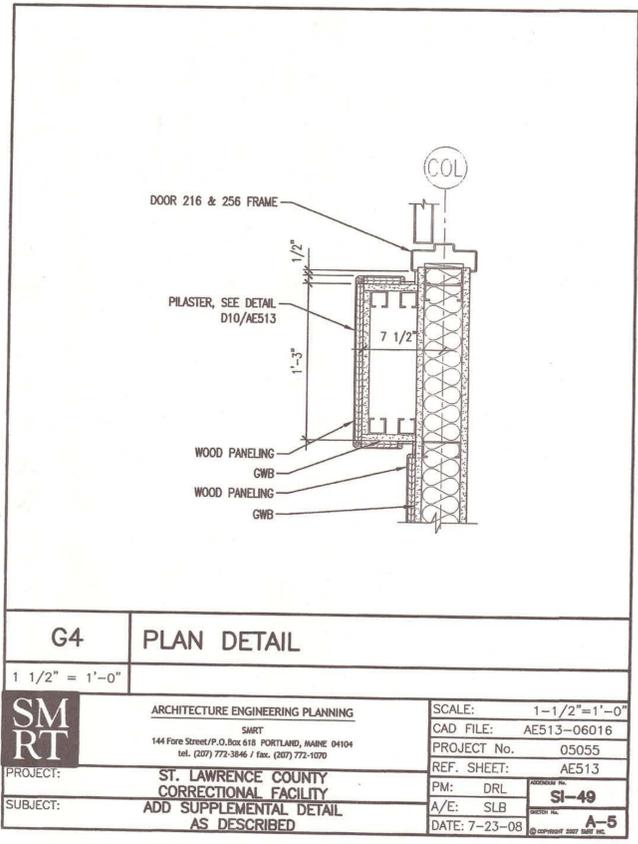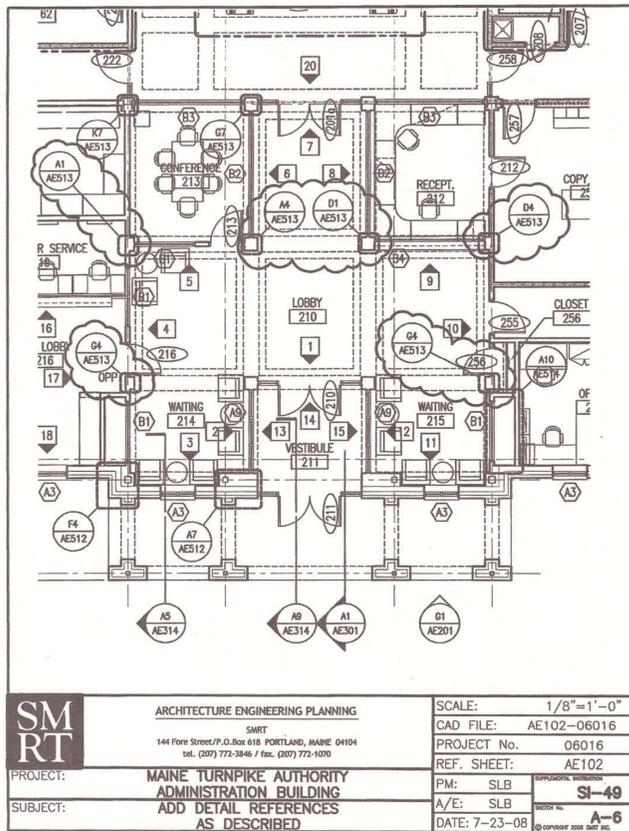

SM RT	ARCHITECTURE ENGINEERING PLANNING	SCALE: 1/8"=1'-0"
	SMRT 144 Fore Street/P.O. Box 618 PORTLAND, MAINE 04104 tel. (207) 772-3846 / fax. (207) 772-1070	CAD FILE: AE102-06016
PROJECT: MAINE TURNPIKE AUTHORITY ADMINISTRATION BUILDING	PROJECT No. 06016	REF. SHEET: AE102
SUBJECT: ADD DETAIL REFERENCES AS DESCRIBED	DATE: 7-23-08	SI-49 A-6

G4	PLAN DETAIL	SCALE: 1-1/2"=1'-0"
1 1/2" = 1'-0"		CAD FILE: AE513-06016
SM RT	ARCHITECTURE ENGINEERING PLANNING	PROJECT No. 05055
	SMRT 144 Fore Street/P.O. Box 618 PORTLAND, MAINE 04104 tel. (207) 772-3846 / fax. (207) 772-1070	REF. SHEET: AE513
PROJECT: ST. LAWRENCE COUNTY CORRECTIONAL FACILITY	PROJECT No. 05055	REF. SHEET: AE513
SUBJECT: ADD SUPPLEMENTAL DETAIL AS DESCRIBED	DATE: 7-23-08	SI-49 A-5









D4	PLAN DETAIL	SCALE: 1-1/2"=1'-0"
1 1/2" = 1'-0"		CAD FILE: AE513-06016
SM RT	ARCHITECTURE ENGINEERING PLANNING	PROJECT No. 05055
	SMRT 144 Fore Street/P.O. Box 618 PORTLAND, MAINE 04104 tel. (207) 772-3846 / fax. (207) 772-1070	REF. SHEET: AE513
PROJECT: ST. LAWRENCE COUNTY CORRECTIONAL FACILITY	PROJECT No. 05055	REF. SHEET: AE513
SUBJECT: ADD SUPPLEMENTAL DETAIL AS DESCRIBED	DATE: 7-23-08	SI-49 A-4

D1	PLAN DETAIL	SCALE: 1-1/2"=1'-0"
1 1/2" = 1'-0"		CAD FILE: AE513-06016
SM RT	ARCHITECTURE ENGINEERING PLANNING	PROJECT No. 05055
	SMRT 144 Fore Street/P.O. Box 618 PORTLAND, MAINE 04104 tel. (207) 772-3846 / fax. (207) 772-1070	REF. SHEET: AE513
PROJECT: ST. LAWRENCE COUNTY CORRECTIONAL FACILITY	PROJECT No. 05055	REF. SHEET: AE513
SUBJECT: ADD SUPPLEMENTAL DETAIL AS DESCRIBED	DATE: 7-23-08	SI-49 A-3

A4	PLAN DETAIL	SCALE: 1-1/2"=1'-0"
1 1/2" = 1'-0"		CAD FILE: AE513-06016
SM RT	ARCHITECTURE ENGINEERING PLANNING	PROJECT No. 05055
	SMRT 144 Fore Street/P.O. Box 618 PORTLAND, MAINE 04104 tel. (207) 772-3846 / fax. (207) 772-1070	REF. SHEET: AE513
PROJECT: ST. LAWRENCE COUNTY CORRECTIONAL FACILITY	PROJECT No. 05055	REF. SHEET: AE513
SUBJECT: ADD SUPPLEMENTAL DETAIL AS DESCRIBED	DATE: 7-23-08	SI-49 A-2

A1	PLAN DETAIL	SCALE: 1-1/2"=1'-0"
1 1/2" = 1'-0"		CAD FILE: AE513-06016
SM RT	ARCHITECTURE ENGINEERING PLANNING	PROJECT No. 05055
	SMRT 144 Fore Street/P.O. Box 618 PORTLAND, MAINE 04104 tel. (207) 772-3846 / fax. (207) 772-1070	REF. SHEET: AE513
PROJECT: ST. LAWRENCE COUNTY CORRECTIONAL FACILITY	PROJECT No. 05055	REF. SHEET: AE513
SUBJECT: ADD SUPPLEMENTAL DETAIL AS DESCRIBED	DATE: 7-23-08	SI-49 A-1

GENERAL NOTES:
 1. SEE 61001 FOR PROJECT GENERAL NOTES.

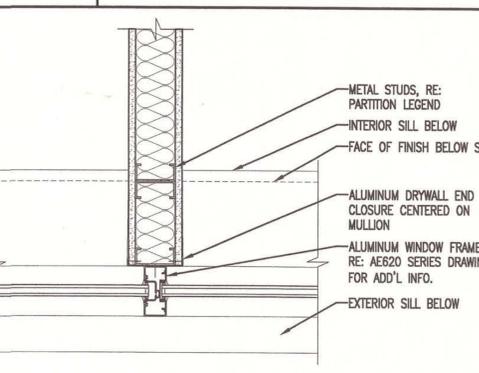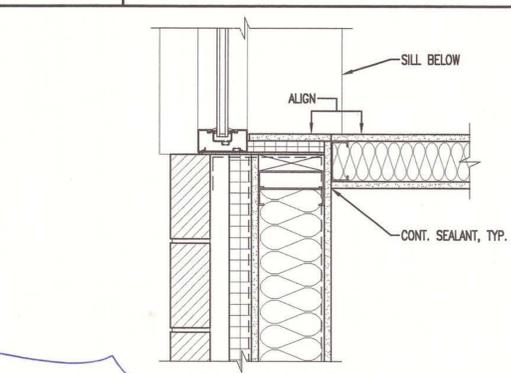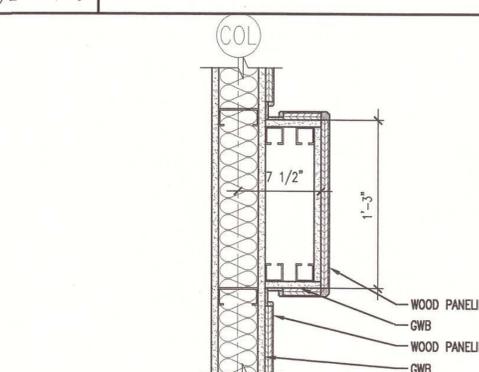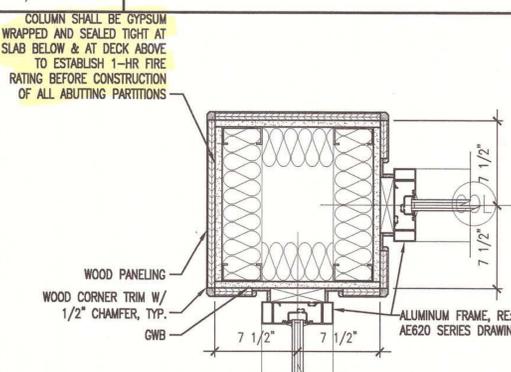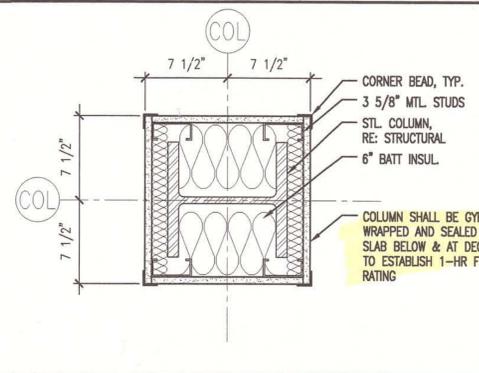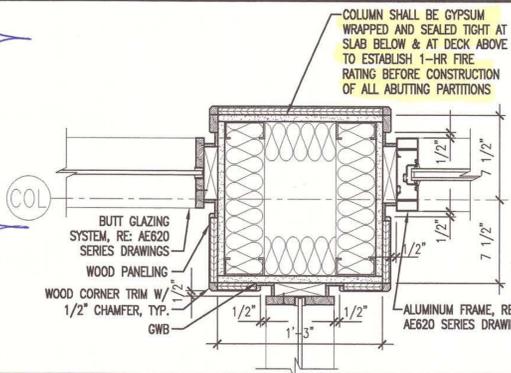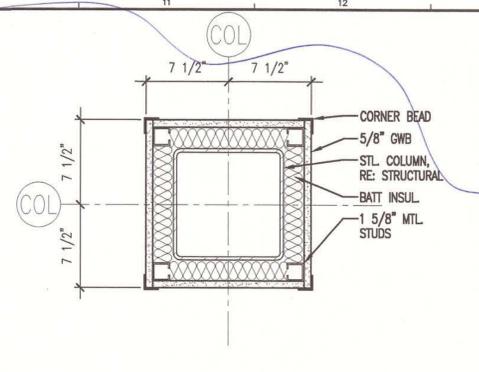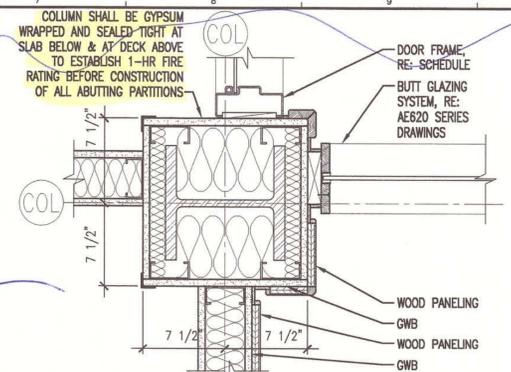

*See
opposite page
for details
SI# 49*

AS BUILT
 Owaer Copy

**SM
SMT
RT**

ARCHITECTURE ENGINEERING PLANNING
 SMRT
 144 Fore Street, P.O. Box 618
 Portland, Maine 04104
 tel. (207) 772-3846
 fax. (207) 772-1070

STATE OF MAINE
 SCOTT
 L
 BENSON
 No. 1772
 REGISTERED
 PROFESSIONAL ARCHITECT


MAINE TURNPIKE AUTHORITY
 ADMINISTRATION BUILDING
 PORTLAND, MAINE

ISSUED FOR BIDDING/CONSTRUCTION
 7-9-07

REV	DESCRIPTION	DATE
0	BIDDING/CONSTRUCTION	7-9-07

GRAPHIC SCALE:
 0" 1"

SCALE: AS NOTED
 PROJECT MANAGER: SLB
 JC/DRAWN BY: TCM/TCM
 A/E OF RECORD: SLB
 CAD FILE: AE513-06016
 PROJECT NO: 06016
 DATE: 7-9-07
 SHEET TITLE:
 PLAN
 SECTIONS & DETAILS
 SHEET No. **AE513**


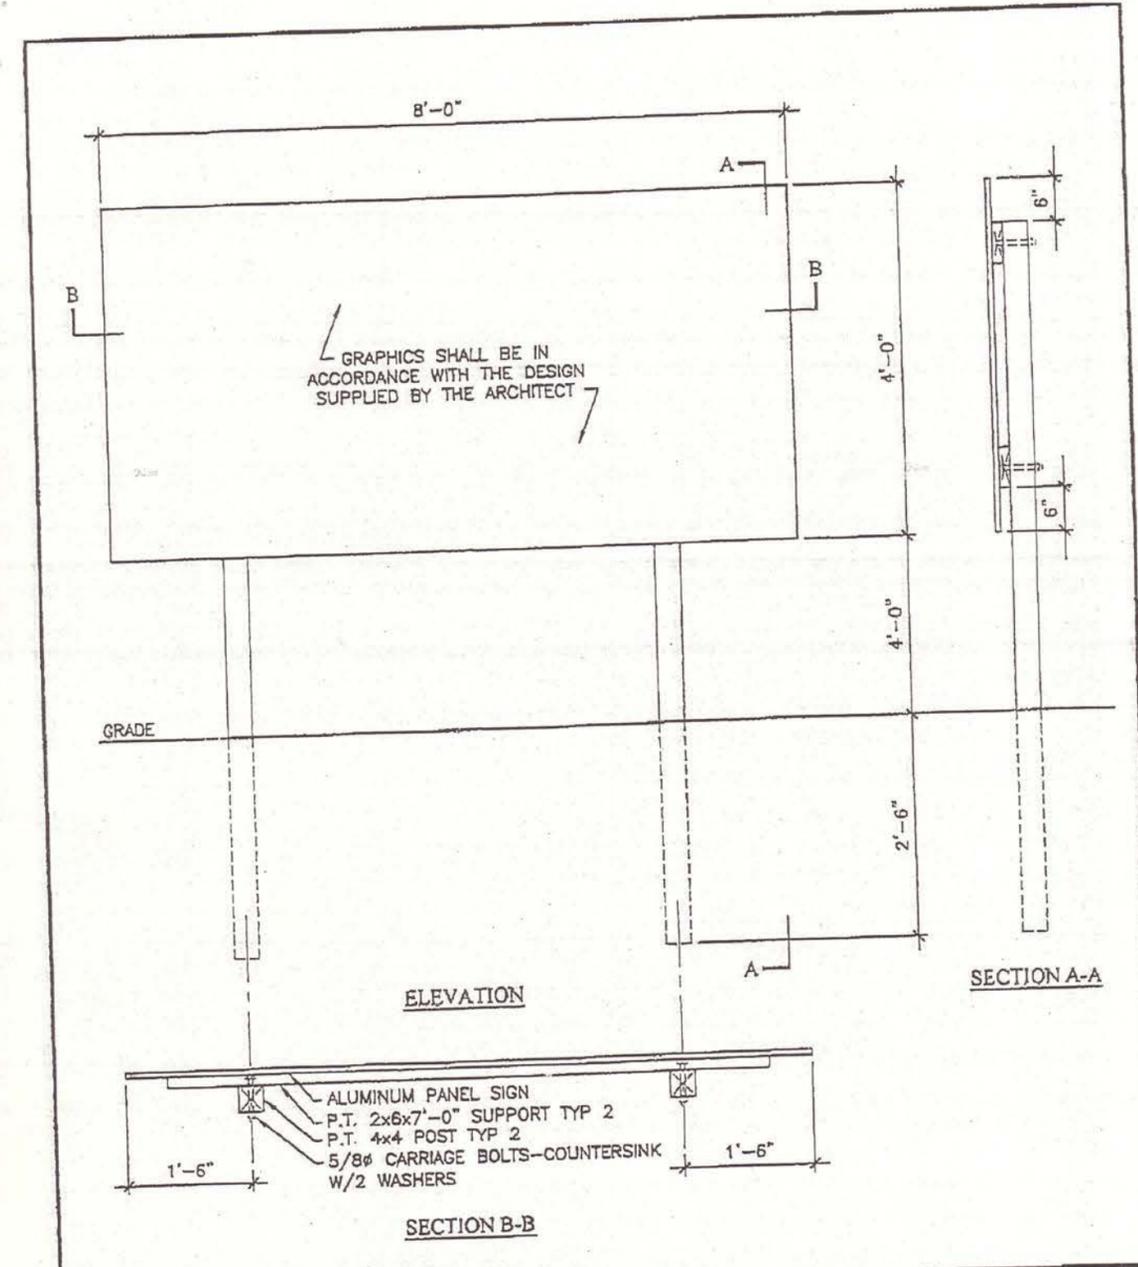


ARCHITECTURE ENGINEERING PLANNING
 SMRT
 144 Fore Street/P.O.Box 616 PORTLAND, MAINE 04104
 tel. (207) 772-3846 / fax. (207) 772-1070

PROJECT: MAINE TURNPIKE AUTHORITY
 ADMINISTRATION BUILDING
 SUBJECT: ADDED A1/AE514
 PROJECT IDENTIFICATION SIGN DETAILS

SCALE:	N.T.S.
CAD FILE:	AE514-06016
PROJECT No.:	06016
REF. SHEET:	AE514
PM:	SLB
A/E:	SLB
DATE:	8-23-07
ADDITIONAL No.	ADD-6
SECTION No.	A-5

RFI-150
SI-48R
+
see SI-47R

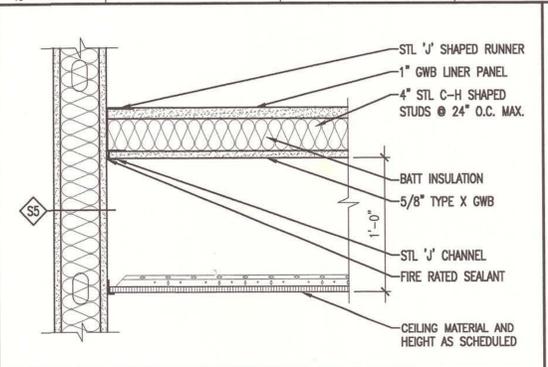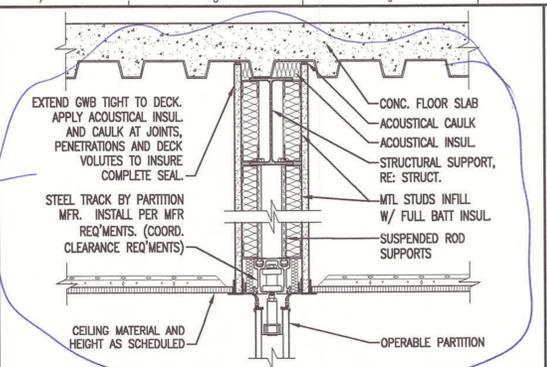



GENERAL NOTES:
1. SEE G1001 FOR PROJECT GENERAL NOTES.

K1 -

K4 -

K7 SECTION @ OPERABLE PARTITION
1 1/2" = 1'-0"

K10 SECTION @ HORIZONTAL SHAFT ABOVE CEILING
1 1/2" = 1'-0"

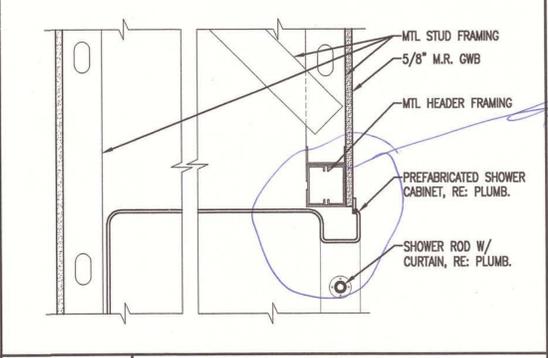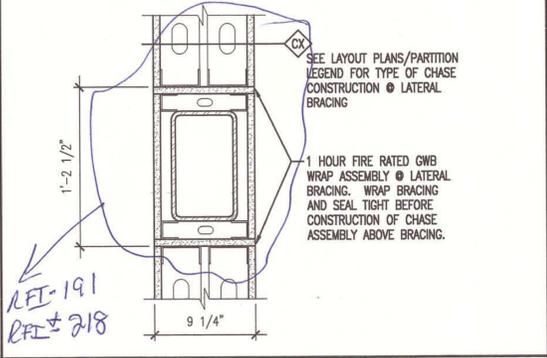


SI-81
Shower & tile
Details

G7 SECTION @ LATERAL BRACING
1 1/2" = 1'-0"

G10 SECTION @ SHOWER
1 1/2" = 1'-0"

D7 -

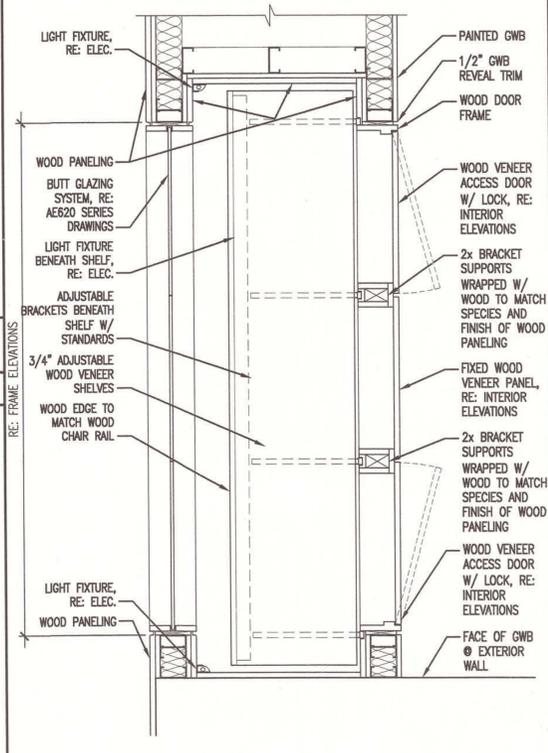

A7 -

A10 PLAN DETAIL @ DISPLAY
1" = 1'-0"

A1 -


PROJECT IDENTIFICATION SIGN DETAILS

SEE SK A-5
OPP. PAGE

AS BUILT
Owner Copy



ARCHITECTURE ENGINEERING PLANNING
SMT
144 Fore Street/P.O. Box 618
Portland, Maine 04104
tel. (207) 772-3846
fax. (207) 772-1070

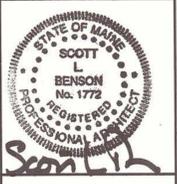

PROJECT TITLE:
MAINE TURNPIKE AUTHORITY
ADMINISTRATION BUILDING
PORTLAND, MAINE
CURRENT ISSUE STATUS:
ISSUED FOR BIDDING/CONSTRUCTION
7-9-07


REV	DESCRIPTION	DATE
0	BIDDING/CONSTRUCTION	7-9-07

GRAPHIC SCALE:
0" 1"
SCALE: AS NOTED
PROJECT MANAGER: SLB
JC/DRAWN BY: TCM/TCM
A/E OF RECORD: SLB
CAD FILE: AE514-06016
PROJECT NO: 06016
DATE: 7-9-07
SHEET TITLE:
PLAN SECTIONS & DETAILS
SHEET No. AE514

GENERAL NOTES:
 1. SEE 0101 FOR PROJECT GENERAL NOTES.

**SM
SRT**

ARCHITECTURE ENGINEERING PLANNING
 SRT
 144 Fore Street/P.O. Box 618
 Portland, Maine 04104
 tel. (207) 772-3846
 fax. (207) 772-1070

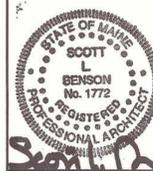

PROJECT TITLE:
**MAINE TURNPIKE AUTHORITY
 ADMINISTRATION BUILDING**
 PORTLAND, MAINE
 CURRENT ISSUE STATUS:
**ISSUED FOR BIDDING/CONSTRUCTION
 7-9-07**

REV	DESCRIPTION	DATE
0	BIDDING/CONSTRUCTION	7-9-07


GRAPHIC SCALE:

 SCALE: AS NOTED
 PROJECT MANAGER: SLB
 JC/DRAWN BY: TCM/DG
 A/E OF RECORD: SLB
 CAD FILE: AE515-06016
 PROJECT NO: 06016
 DATE: 7-9-07
 SHEET TITLE:


SECTIONS & DETAILS

SHEET No. **AE515**


**AS BUILT
 Owner Copy**

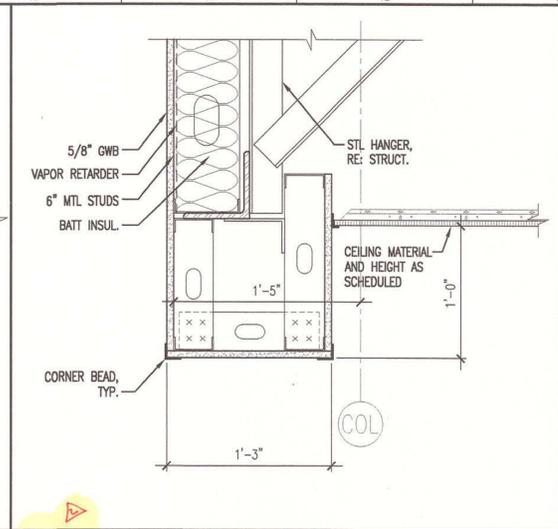


G10 SOFFIT SECTION @ CLEAR STORY/SKYLIGHT
 1 1/2" = 1'-0"

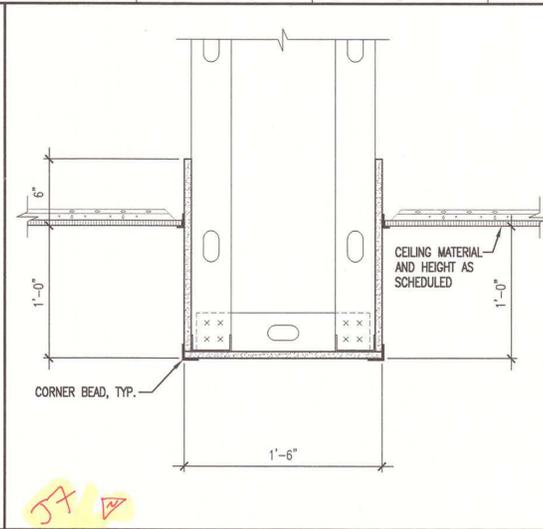


G4 SOFFIT SECTION
 1 1/2" = 1'-0"

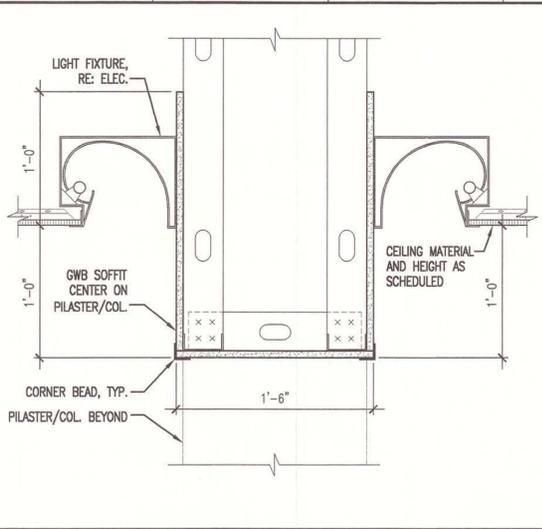


G4 SOFFIT SECTION @ RECESSED LIGHT COVE
 1 1/2" = 1'-0"

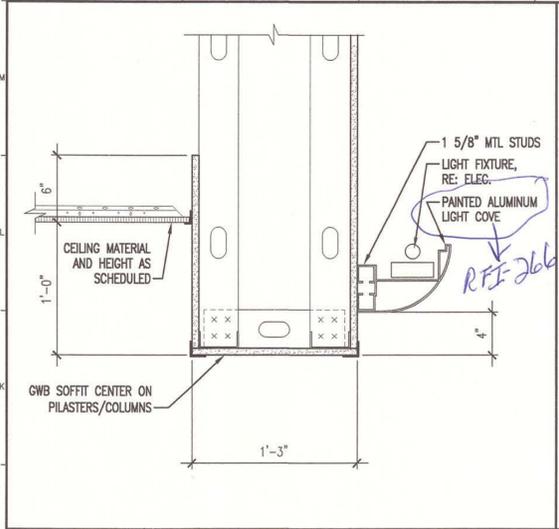


G1 SOFFIT SECTION @ LIGHT COVE
 1 1/2" = 1'-0"

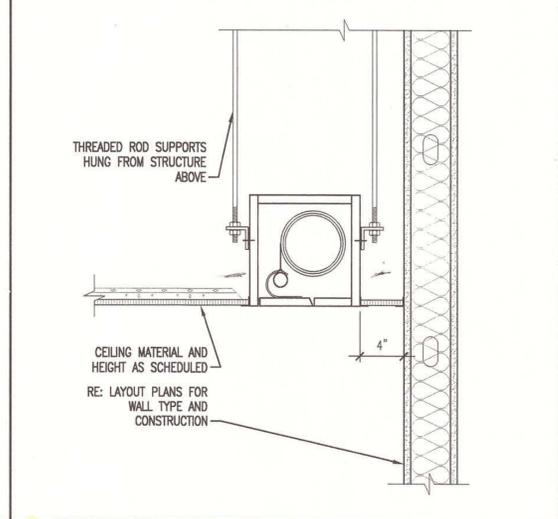


D10 SECTION @ RECESSED PROJECTION SCREEN
 1 1/2" = 1'-0"

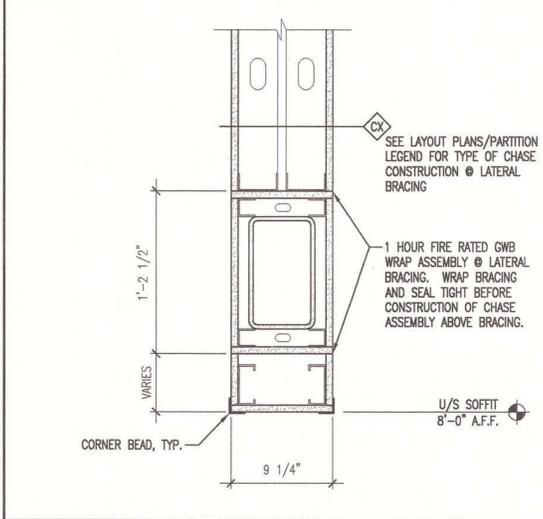


D7 SOFFIT SECTION @ BRACING
 1 1/2" = 1'-0"

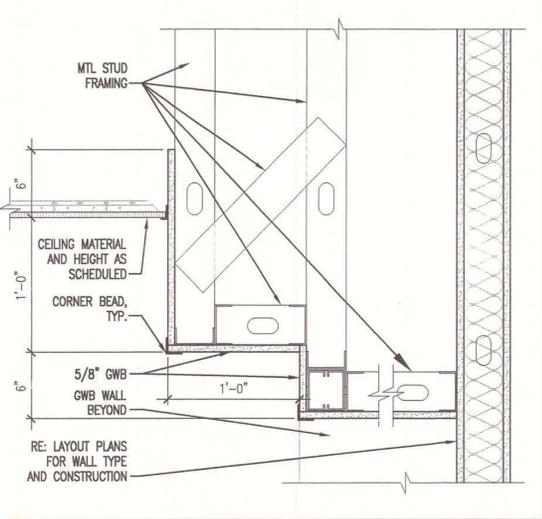


D4 SOFFIT SECTION
 1 1/2" = 1'-0"

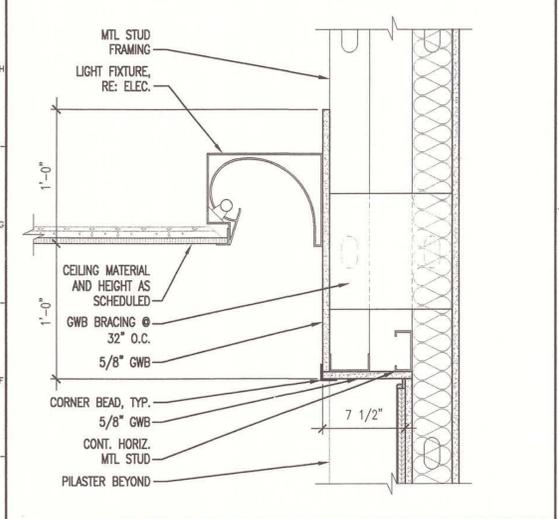


D1 SOFFIT SECTION @ RECESSED LIGHT COVE
 1 1/2" = 1'-0"

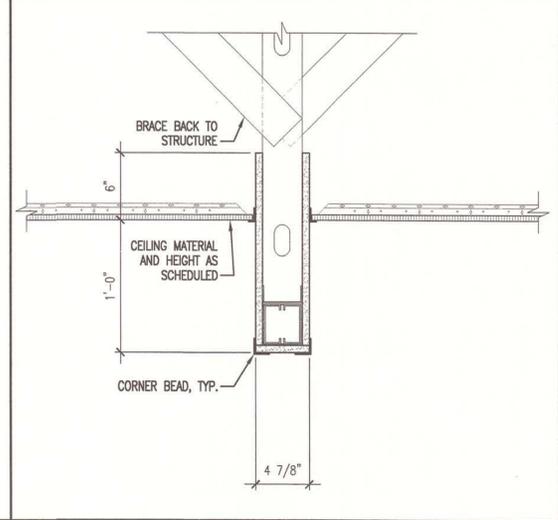


A10 SOFFIT SECTION
 1 1/2" = 1'-0"

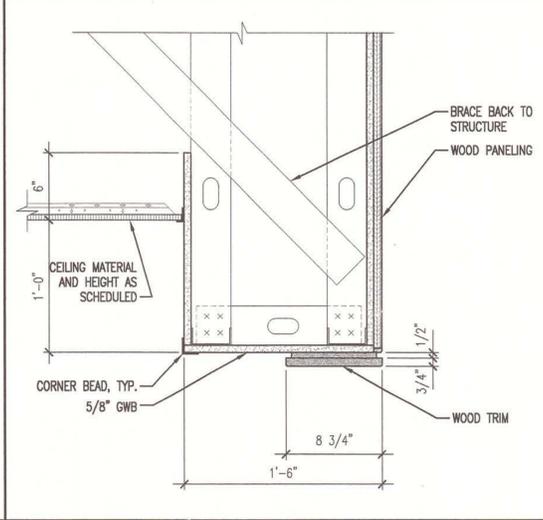

A7 SOFFIT SECTION
 1 1/2" = 1'-0"

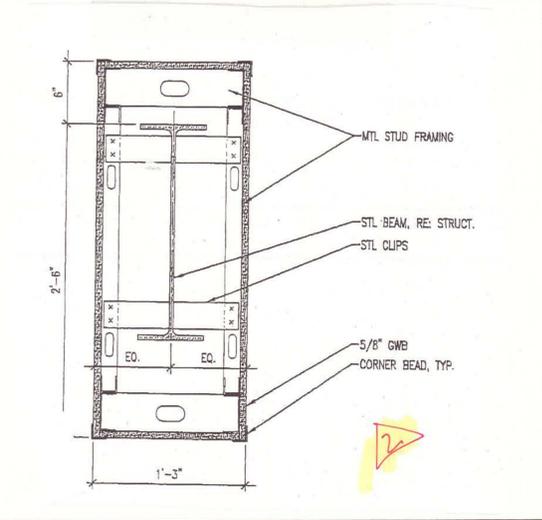

A4 SECTION @ OPERABLE PARTITION
 1 1/2" = 1'-0"





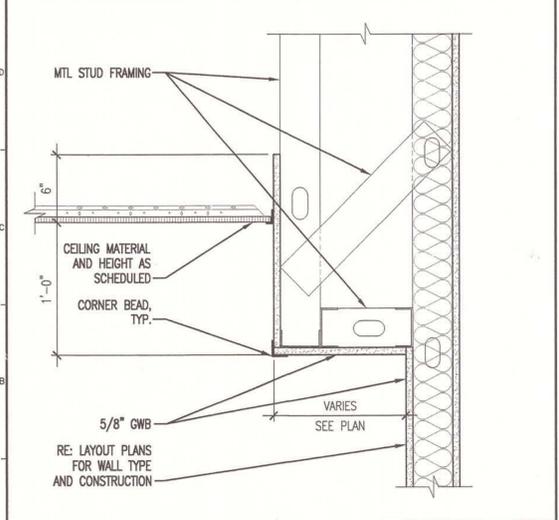


A1 SOFFIT SECTION
 1 1/2" = 1'-0"

GENERAL NOTES:
1. SEE G1001 FOR PROJECT GENERAL NOTES.



 ARCHITECTURE ENGINEERING PLANNING
SMRT
144 Fore Street/P.O. Box 618
Portland, Maine 04104
tel. (207) 772-3946
fax. (207) 772-1070

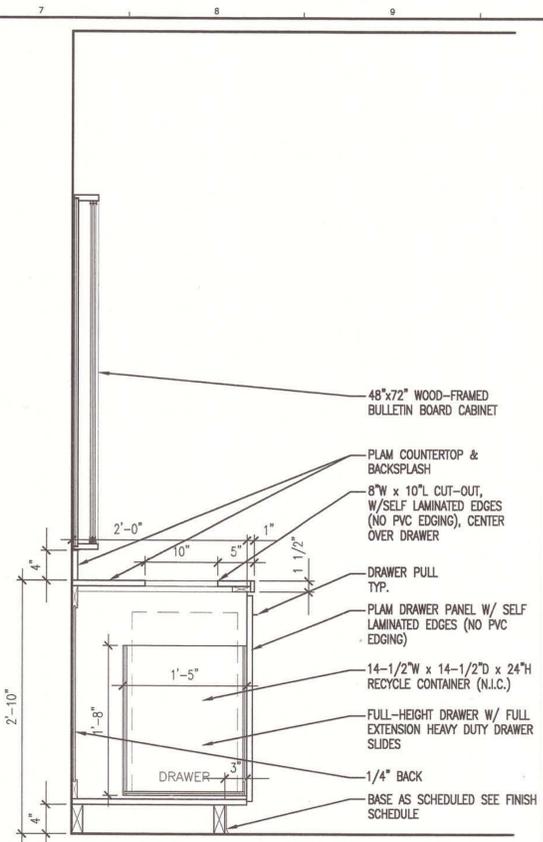
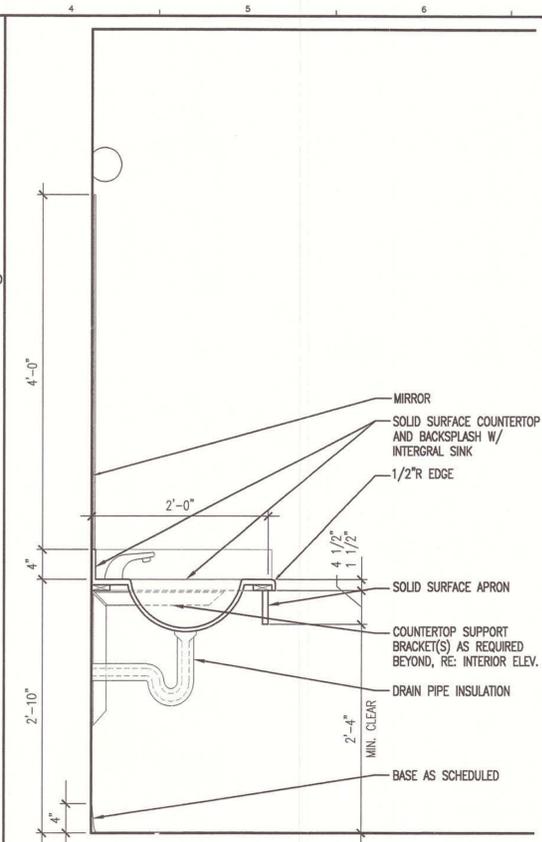
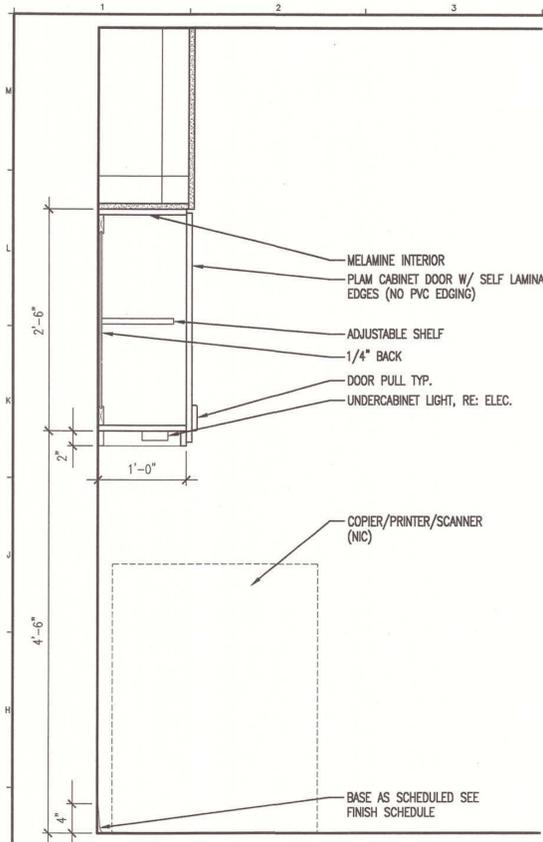
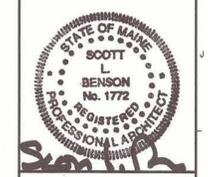


G1 SECTION @ CASEWORK
1" = 1'-0"

G4 SECTION @ COUNTER
1" = 1'-0"

G7 SECTION @ RECYCLE AREA
1" = 1'-0"

G10 SECTION @ CASEWORK
1" = 1'-0"

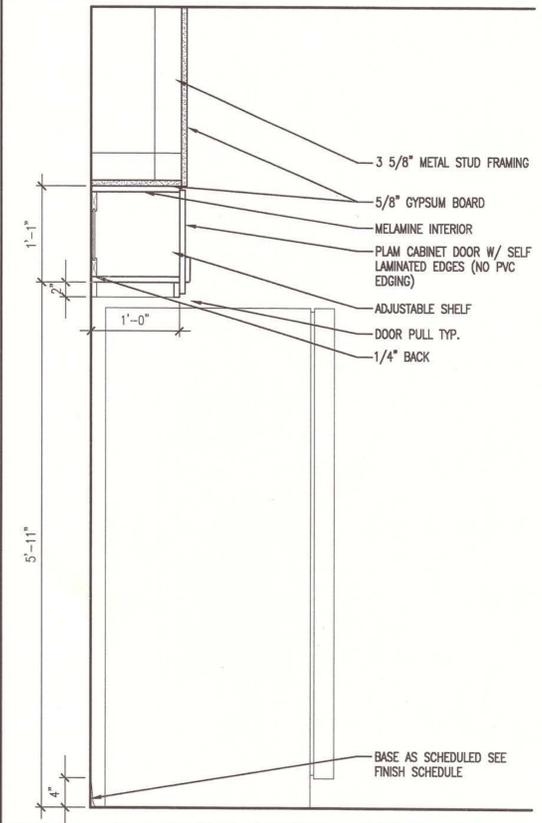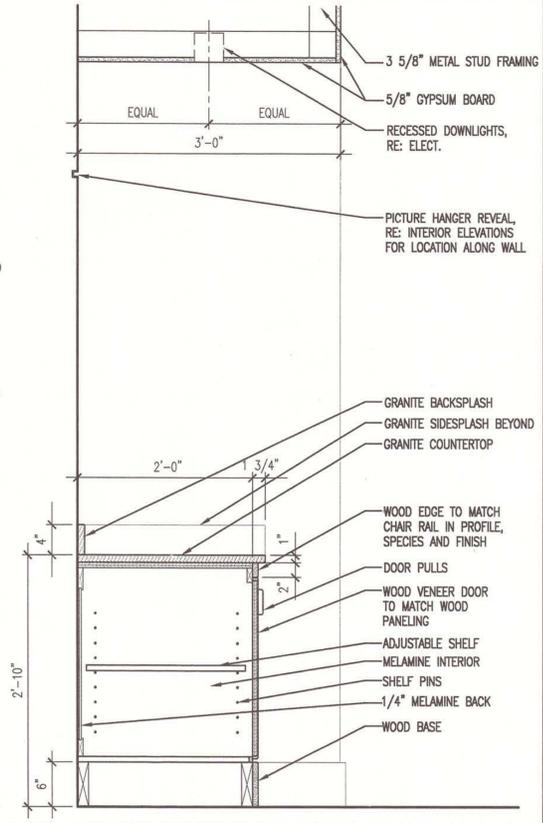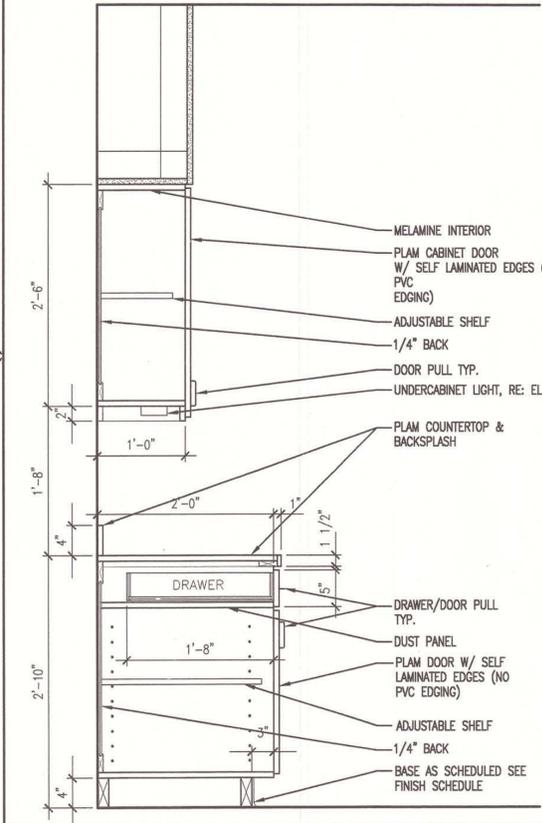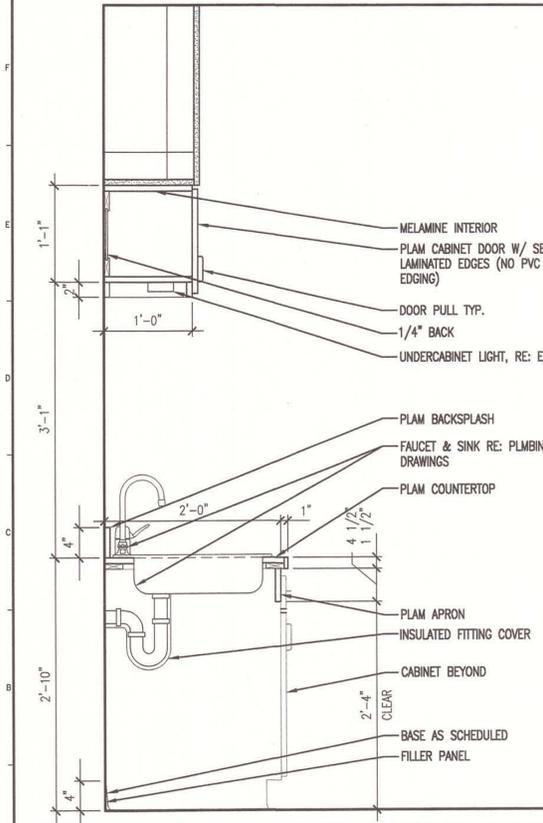

A1 SECTION @ CASEWORK
1" = 1'-0"

A4 SECTION @ CASEWORK
1" = 1'-0"

A7 SECTION @ CREDENZA
1" = 1'-0"

A10 SECTION @ CASEWORK
1" = 1'-0"

AS BUILT
Owner Copy

PROJECT TITLE: MAINE TURNPIKE AUTHORITY ADMINISTRATION BUILDING PORTLAND, MAINE
CURRENT ISSUE STATUS: ISSUED FOR BIDDING/CONSTRUCTION 7-9-07

REV	DESCRIPTION	DATE
0	BIDDING/CONSTRUCTION	7-9-07

GRAPHIC SCALE: 0" = 1"

SCALE: AS NOTED
PROJECT MANAGER: SLB
JC/DRAWN BY: TCM/TCM
A/E OF RECORD: SLB
CAD FILE: AE521-06016
PROJECT NO: 06016
DATE: 7-9-07

SHEET TITLE: INTERIOR ELEVATION SECTIONS & DETAILS
SHEET No. AE521



PROJECT TITLE:
**MAINE TURNPIKE AUTHORITY
 ADMINISTRATION BUILDING**
 PORTLAND, MAINE

ISSUED FOR BIDDING/CONSTRUCTION
 7-9-07

REV	DESCRIPTION	DATE
0	BIDDING/CONSTRUCTION	7-9-07

GRAPHIC SCALE:
 0" 1"

SCALE: 1"=1'-0"

PROJECT MANAGER: SLB
 JC/DRAWN BY: TCM/DLG
 A/E OF RECORD: SLB
 CAD FILE: AES22-08018
 PROJECT NO: 06018
 DATE: 7-9-07


SHEET TITLE:
**INTERIOR ELEVATION
 SECTIONS & DETAILS**

SHEET No. **AE522**


GENERAL NOTES:
 1. SEE 0001 FOR PROJECT GENERAL NOTES.




G1 SECTION @ WAINSCOT

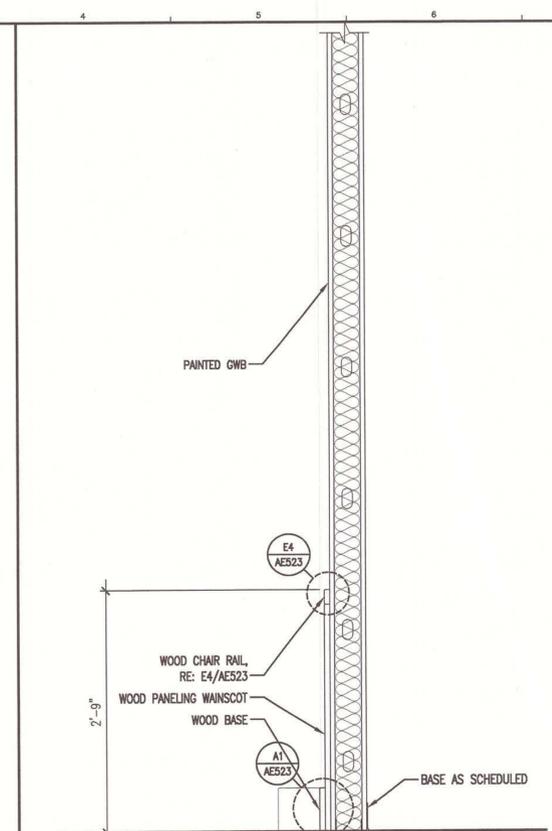


G4 SECTION @ WAINSCOT

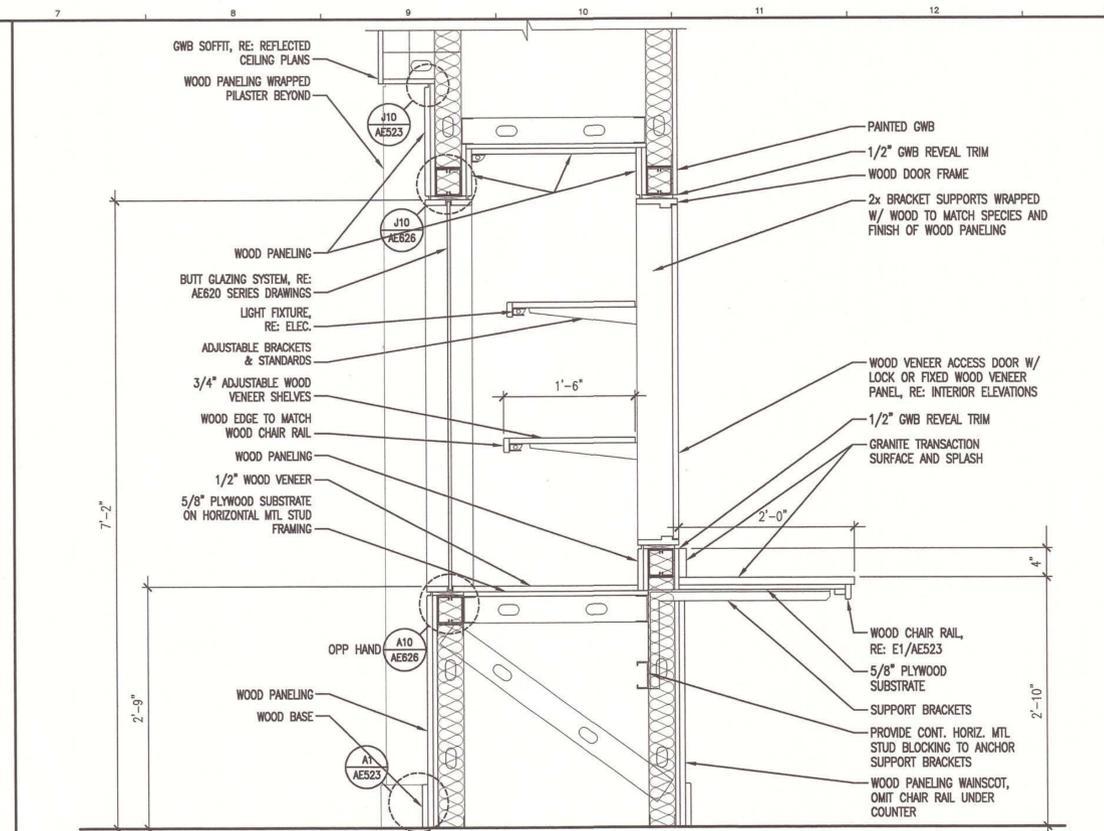


G7 SECTION @ DISPLAY CASE

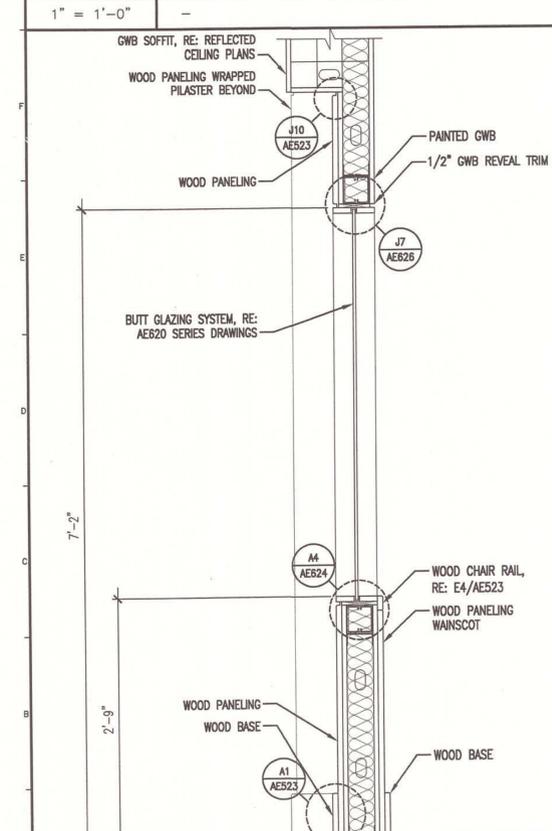


A1 SECTION @ BUTT GLAZING IN WOOD WALL PANEL

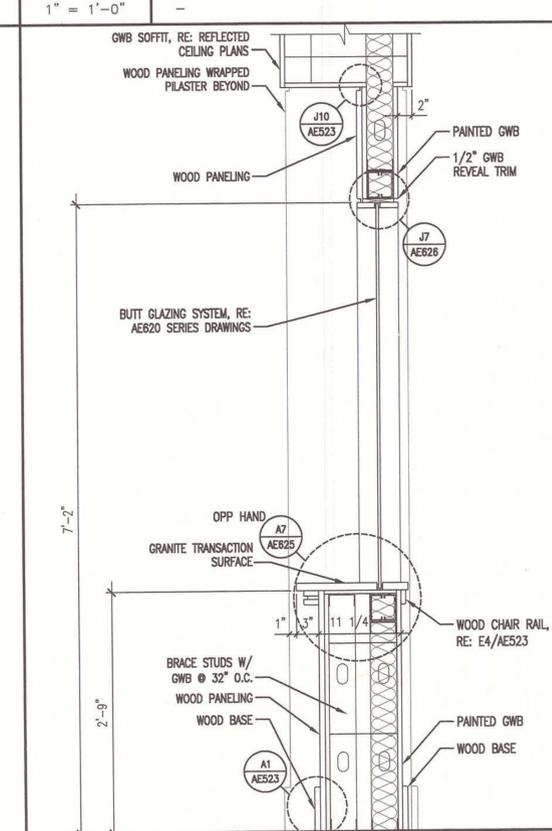

A4 SECTION @ RECEPTION

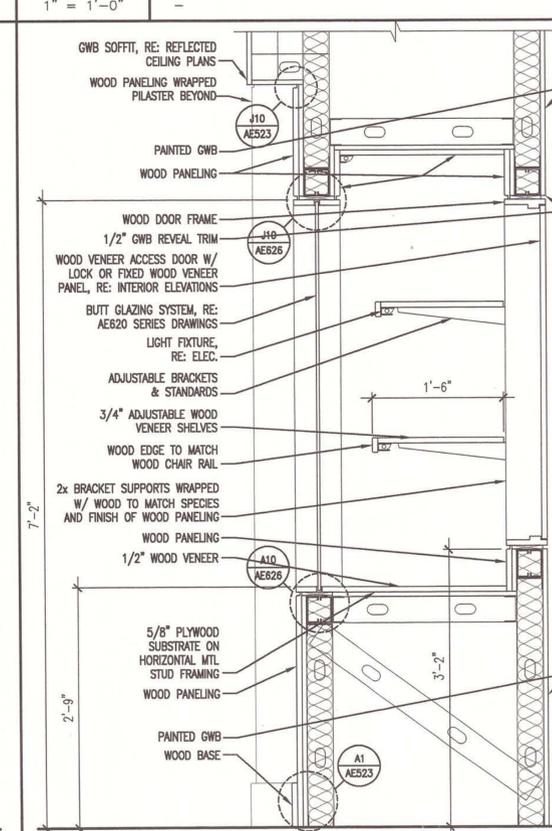


A7 SECTION @ DISPLAY CASE

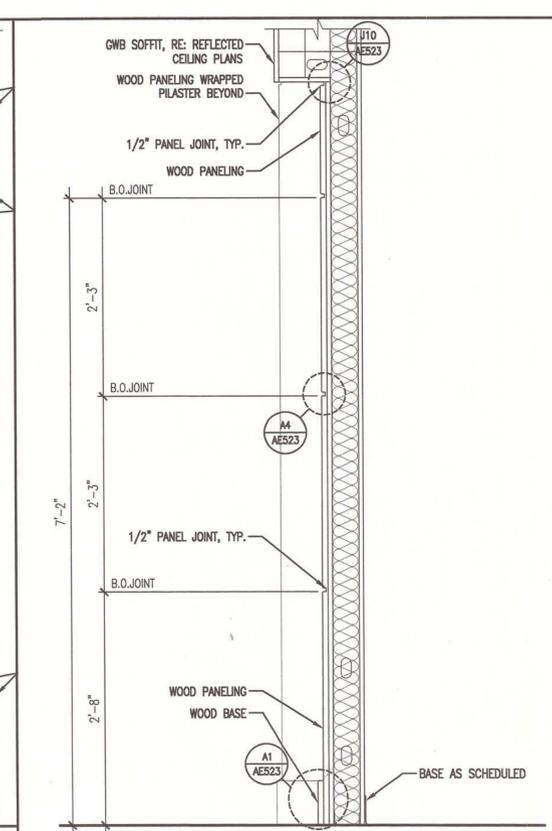


A10 SECTION @ TYP. PANELED WALL

**AS BUILT
 Owner Copy**

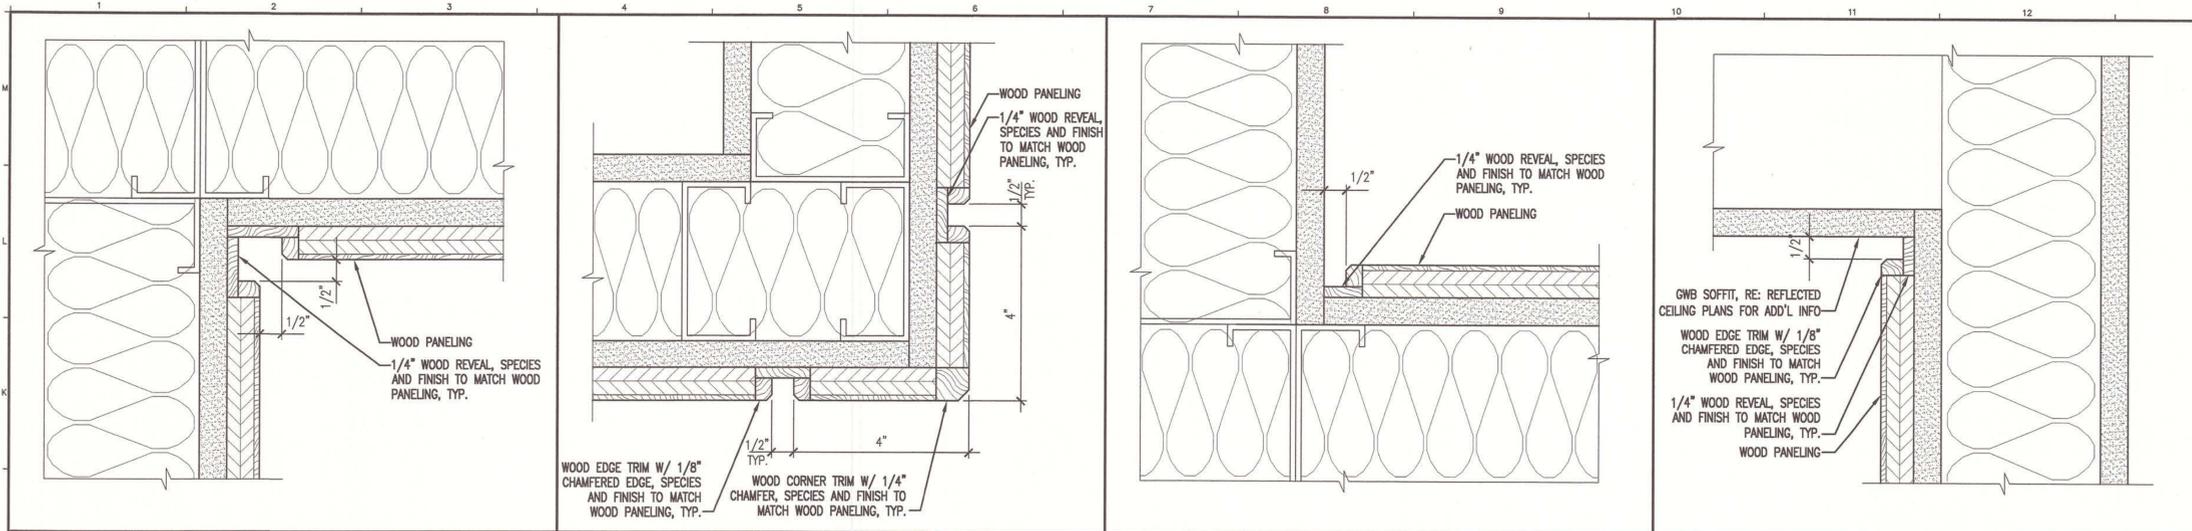


GENERAL NOTES:
 1. SEE G101 FOR PROJECT GENERAL NOTES.

SM RT
 ARCHITECTURE ENGINEERING PLANNING
 144 Fore Street P.O. Box 618
 Portland, Maine 04104
 Tel: (207) 772-3946
 Fax: (207) 772-1070

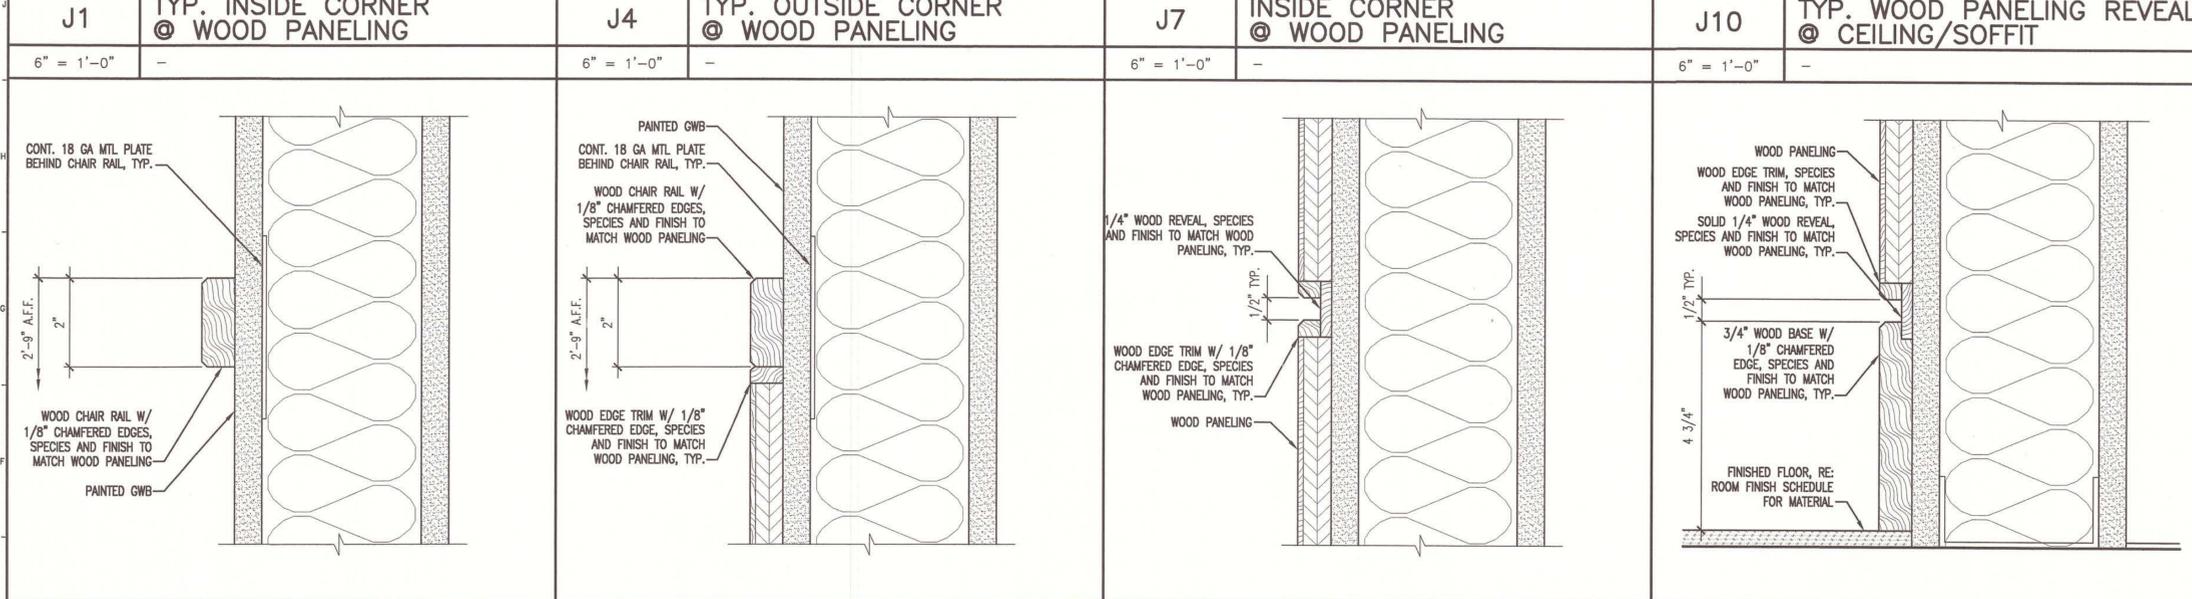

MAINE TURNPIKE AUTHORITY
 ADMINISTRATION BUILDING
 PORTLAND, MAINE
 PROJECT TITLE:
 CURRENT ISSUE STATUS:
 ISSUED FOR BIDDING/CONSTRUCTION
 7-9-07

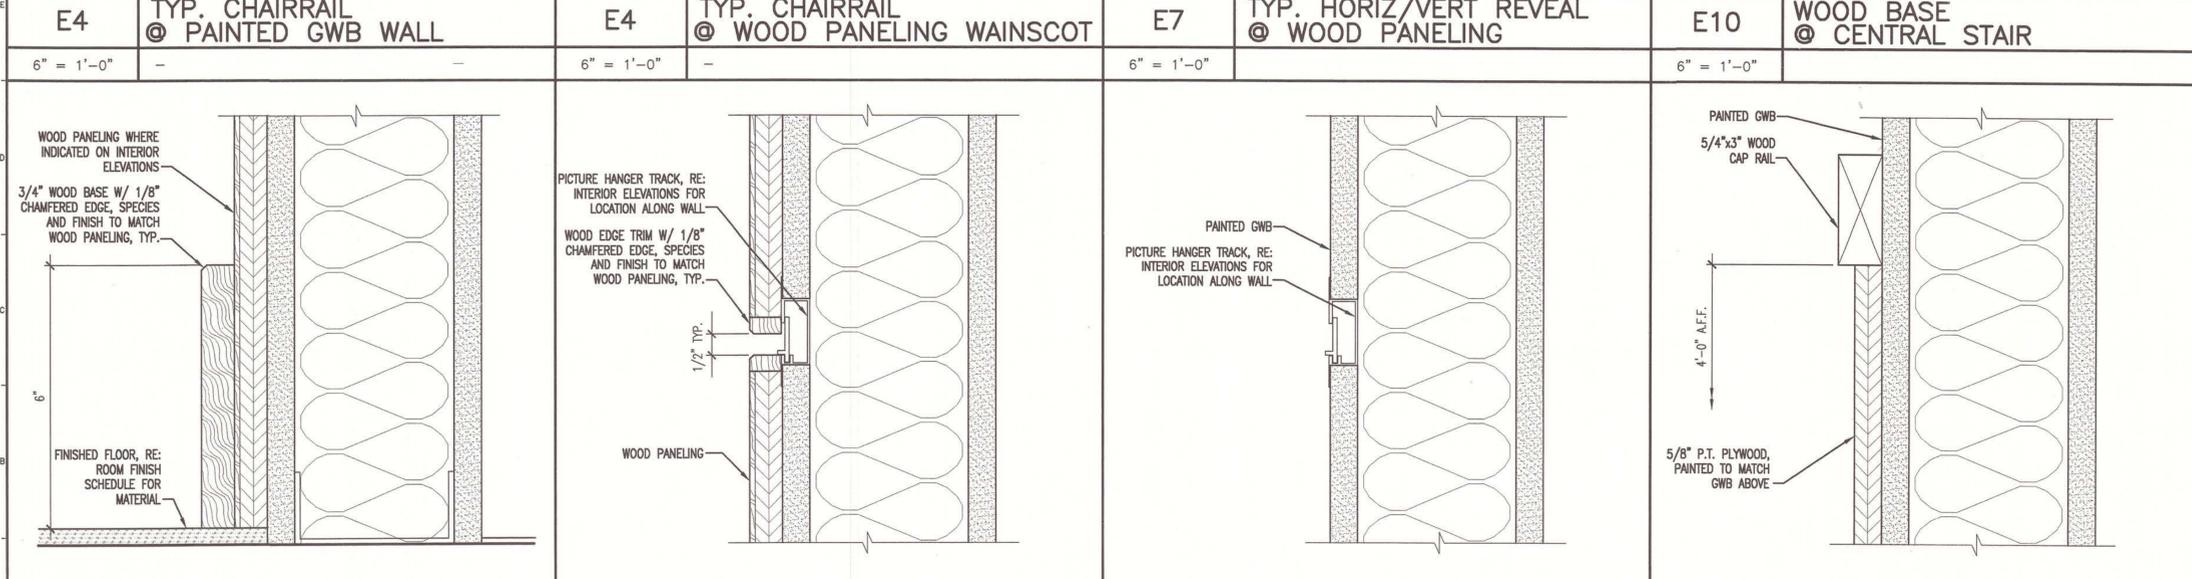

AS BUILT
 Owner Copy





REV	DESCRIPTION	DATE
0	BIDDING/CONSTRUCTION	7-9-07

GRAPHIC SCALE:
 0" 1"

SCALE: AS NOTED
 PROJECT MANAGER: SLB
 JC/DRAWN BY: TCM/DC
 A/E OF RECORD: SLB
 CAD FILE: AES23-06016
 PROJECT NO: 06016
 DATE: 7-9-07

SHEET TITLE:
 INTERIOR ELEVATION SECTIONS & DETAILS

SHEET No. **AES23**

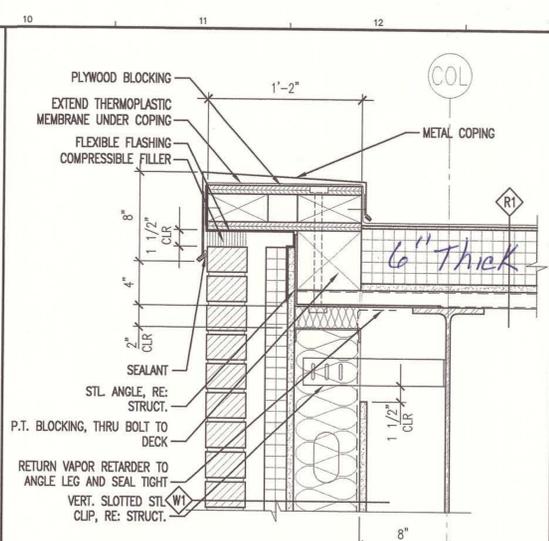
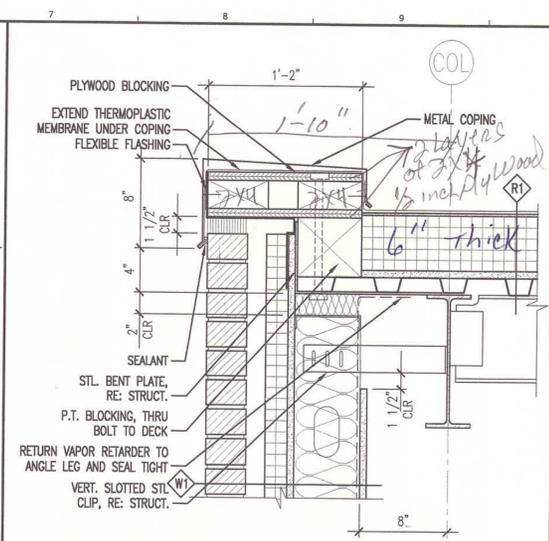
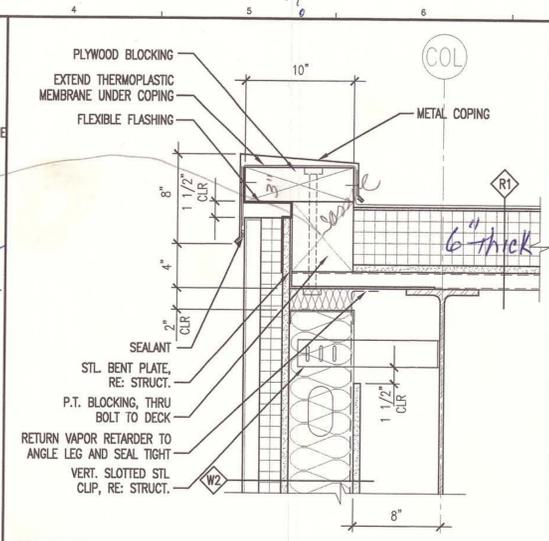
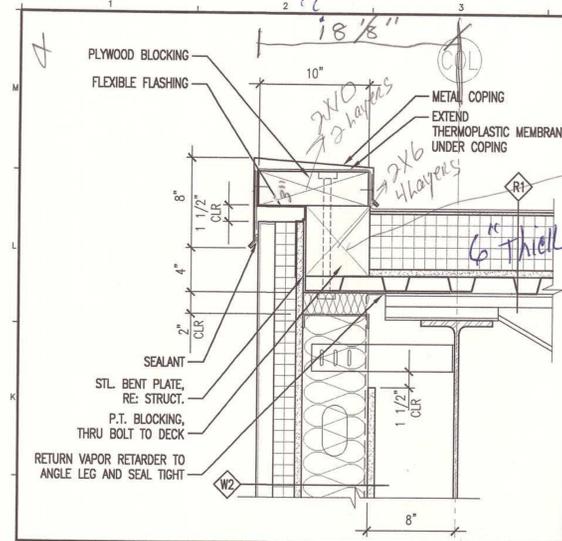


J1 ROOF EDGE DETAIL
1 1/2" = 1'-0"

J4 SECTION DETAIL @ ROOF EDGE
1 1/2" = 1'-0"

J7 ROOF EDGE DETAIL
1 1/2" = 1'-0"

J10 ROOF EDGE DETAIL
1 1/2" = 1'-0"

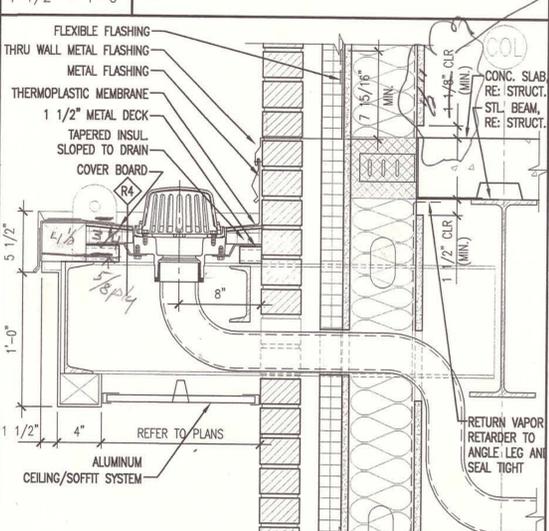
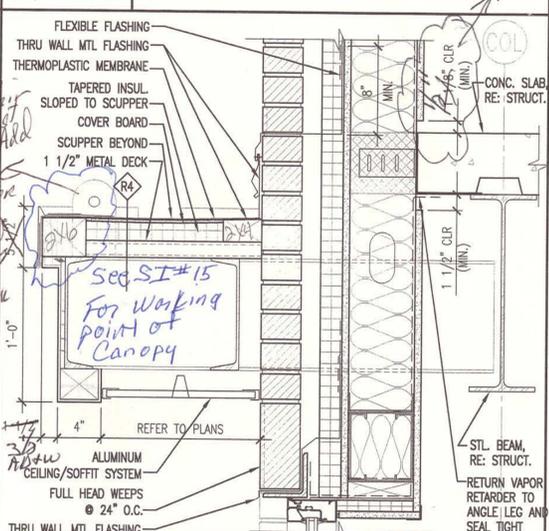
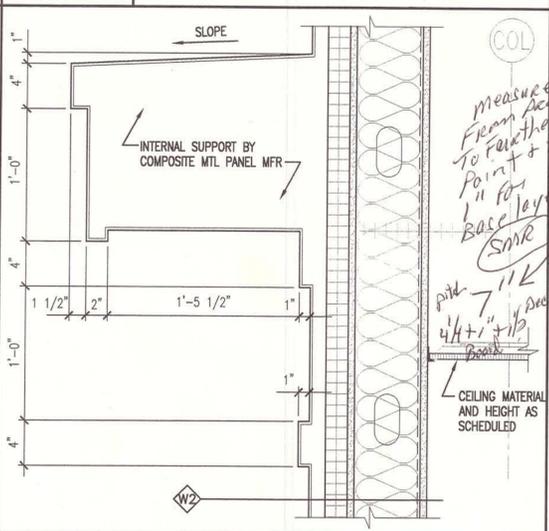
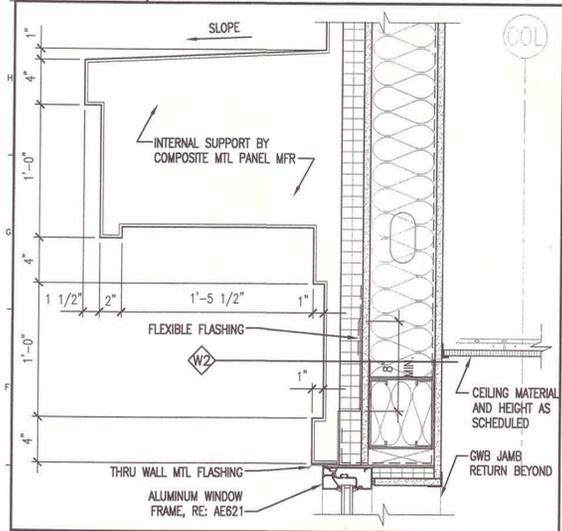


E1 SECTION DETAIL @ CORNICE
1 1/2" = 1'-0"

E4 SECTION DETAIL @ CORNICE
1 1/2" = 1'-0"

E7 SECTION DETAIL @ CANOPY
1 1/2" = 1'-0"

E10 SECTION DETAIL @ CANOPY
1 1/2" = 1'-0"

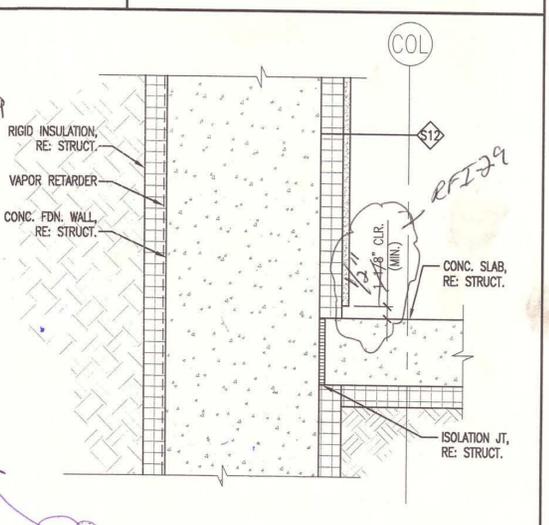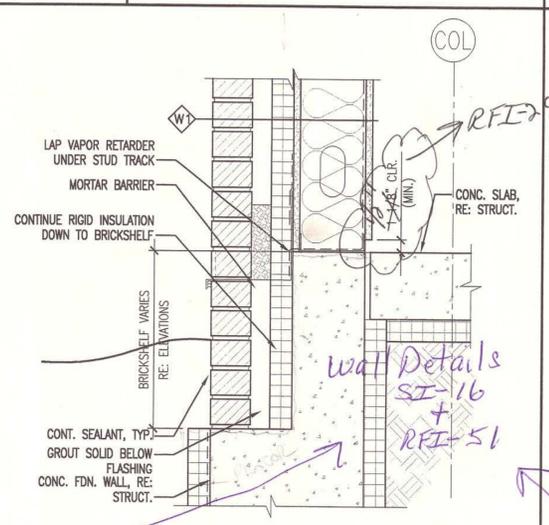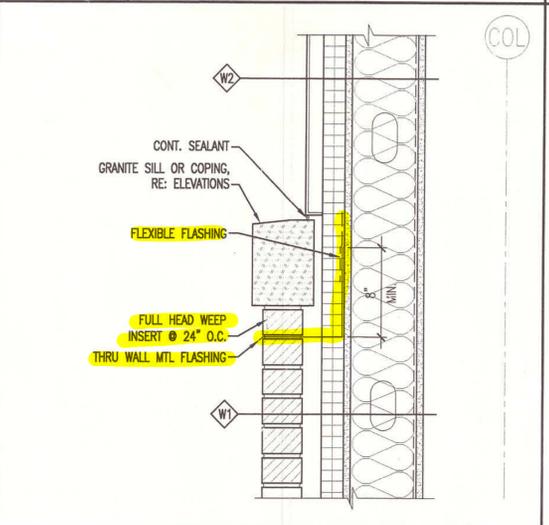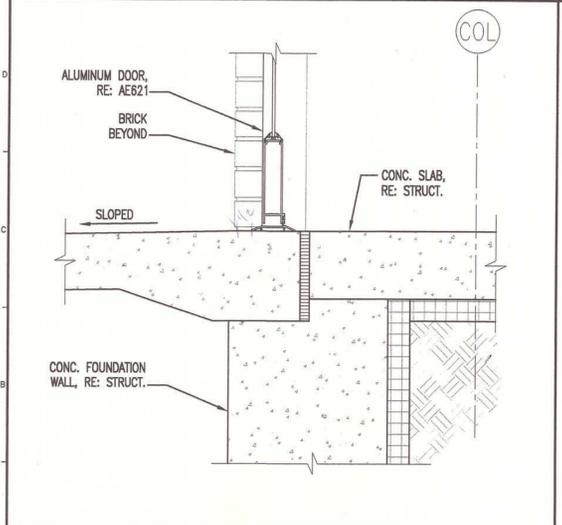

A1 SECTION DETAIL @ EXT. DOOR THRESHOLD
3" = 1'-0"

A4 SECTION DETAIL @ CORNICE
1 1/2" = 1'-0"

A7 SECTION DETAIL @ BOTTOM OF EXT. WALL
1 1/2" = 1'-0"


A10 SECTION DETAIL @
1 1/2" = 1'-0"

GENERAL NOTES:

1. SEE G101 FOR PROJECT GENERAL NOTES.



ARCHITECTURE ENGINEERING PLANNING
SWRT
144 Fore Street/P.O. Box 618
Portland, Maine 04104
tel. (207) 772-3846
fax. (207) 772-1070

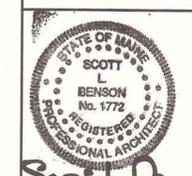


MAINE TURNPIKE AUTHORITY
ADMINISTRATION BUILDING
PORTLAND, MAINE
ISSUED FOR BIDDING/CONSTRUCTION
7-9-07

REV	DESCRIPTION	DATE
0	BIDDING/CONSTRUCTION	7-9-07

GRAPHIC SCALE: 0" = 1"

SCALE: AS NOTED
PROJECT MANAGER: SLB
JC/DRAWN BY: TCM/TCM
A/E OF RECORD: SLB
CAD FILE: AE531-06016
PROJECT NO: 06016
DATE: 7-9-07
SHEET TITLE: BUILDING AND WALL SECTION DETAILS
SHEET No: AE531

AS BUILT
Owner Copy

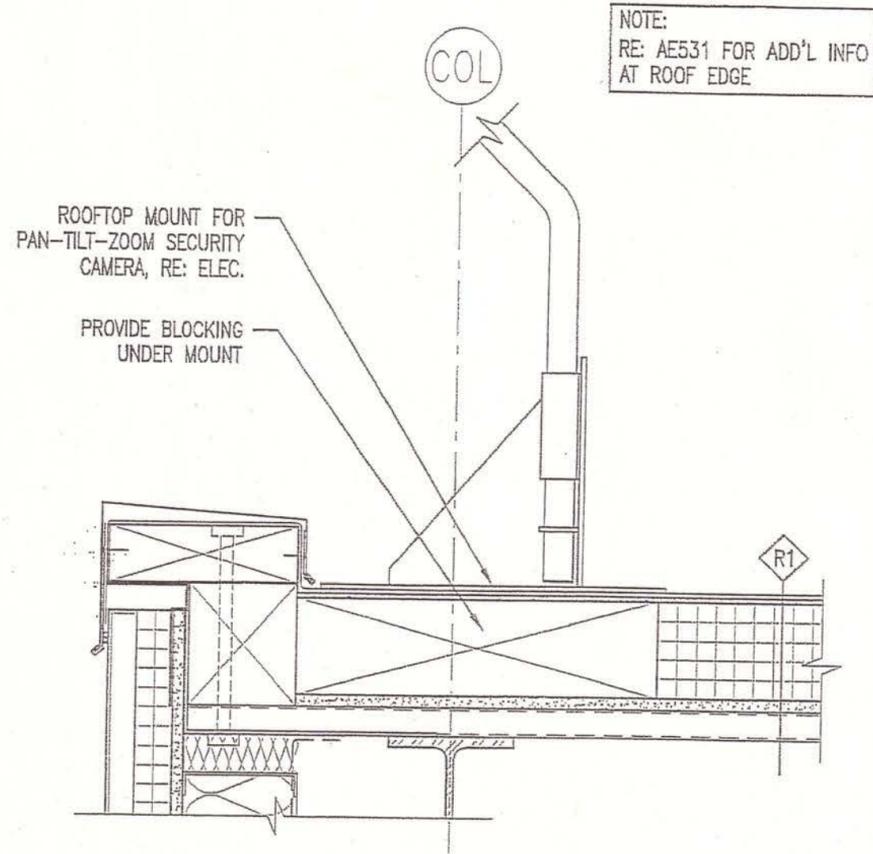

NOTE:
RE: AE531 FOR ADD'L INFO
AT ROOF EDGE

ROOFTOP MOUNT FOR
PAN-TILT-ZOOM SECURITY
CAMERA, RE: ELEC.

PROVIDE BLOCKING
UNDER MOUNT

R1




ARCHITECTURE ENGINEERING PLANNING
SMRT
144 Fore Street/P.O.Box 618 PORTLAND, MAINE 04104
tel. (207) 772-3846 / fax. (207) 772-1070

SCALE: 3/8"=1'-0"
CAD FILE: AE532-06016
PROJECT No. 06016
REF. SHEET: AE532
PM: SLB
A/E: SLB
DATE: 8-10-07

ADDITIONAL No. ADD-4
SKETCH No. A-10
© COPYRIGHT 2007 SMRT INC.

PROJECT: MAINE TURNPIKE AUTHORITY
ADMINISTRATION BUILDING
SUBJECT: ADDED J4/AE532

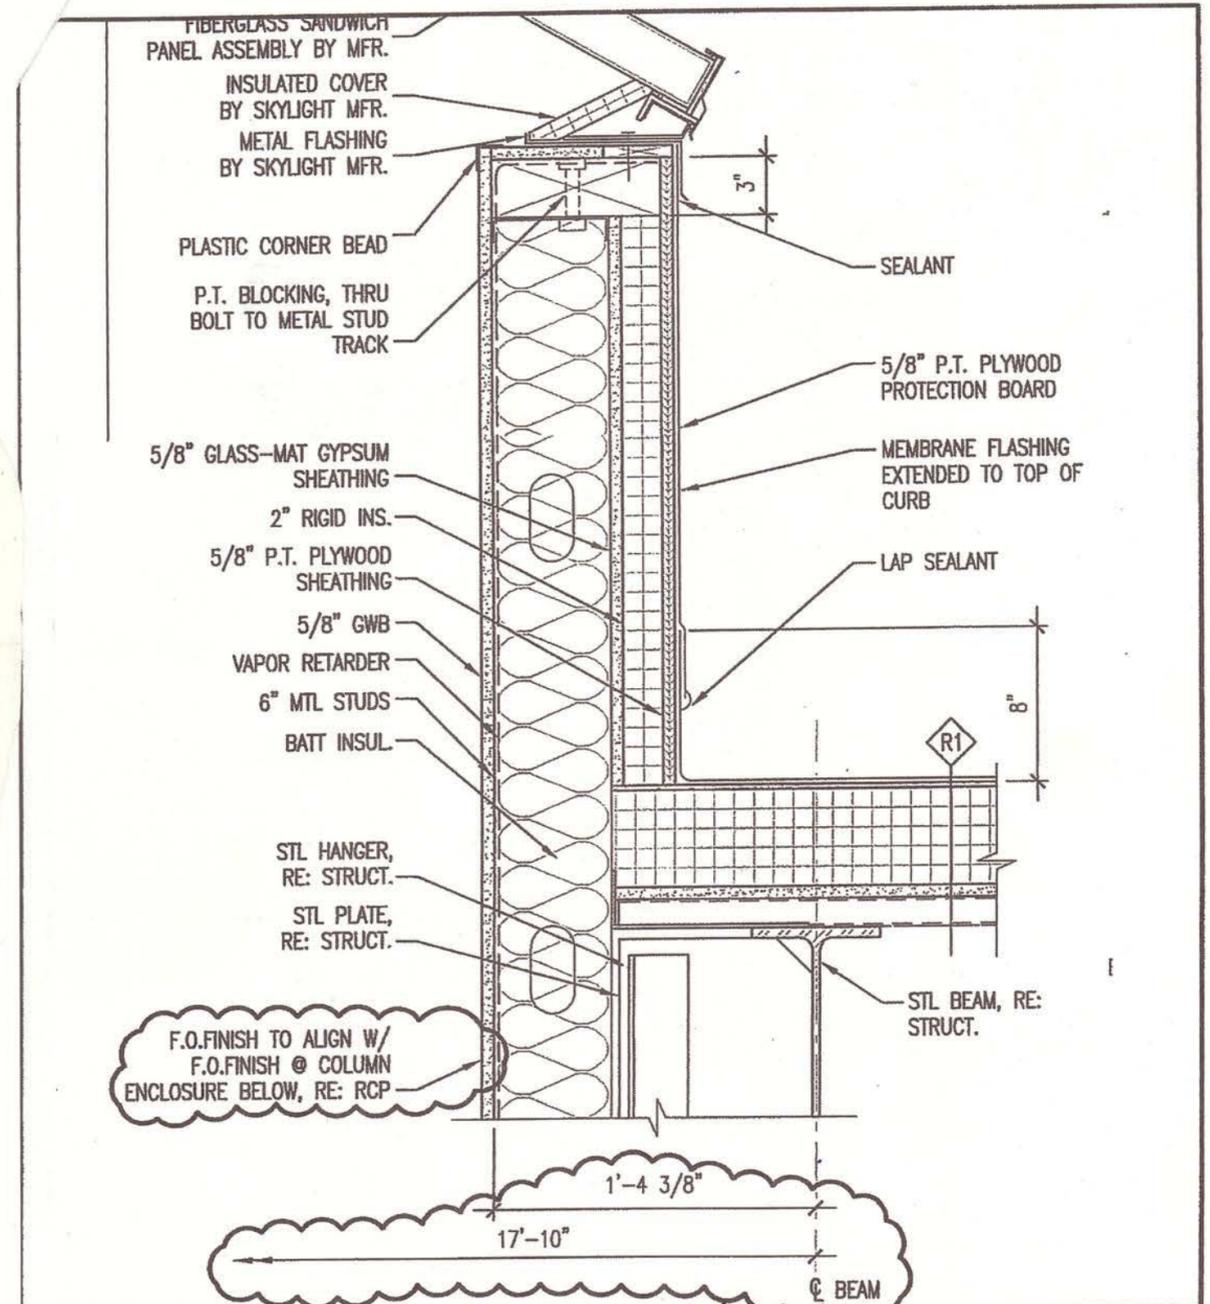

**SM
RT**



ARCHITECTURE ENGINEERING PLANNING
SMRT
144 Fore Street/P.O. Box 618 PORTLAND, MAINE 04104
tel. (207) 772-3846 / fax. (207) 772-1070

PROJECT: MAINE TURNPIKE AUTHORITY
ADMINISTRATION BUILDING
SUBJECT: REVISED A10/AE533
SECTION DETAIL @ SKYLIGHT

SCALE:	1 1/2" = 1'-0"
CAD FILE:	AE533-06016
PROJECT No.	06016
REF. SHEET:	AE533
PM:	SLB
A/E:	SLB
DATE:	
ADDITIONAL No.	SI-
SKETCH No.	A-2

RFI-51
+
SI-16
For Details

SEE SK-A10
OP. PAGE


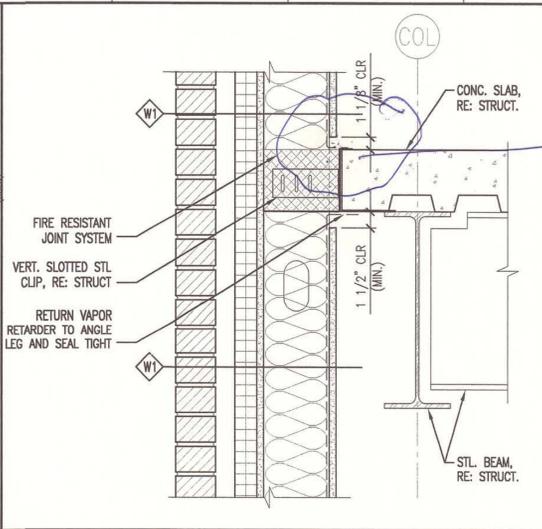
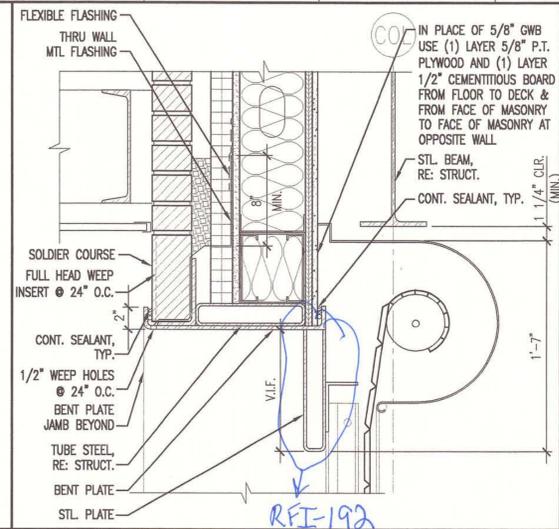


GENERAL NOTES:
1. SEE 0101 FOR PROJECT GENERAL NOTES.
RFI-233R
For Edge of Slab Fix

J1	-	J4	-
*	-	*	-

J7	DETAIL @ OVERHEAD DOOR	J10	SECTION DETAIL @ EDGE OF FLOOR SLAB
1 1/2" = 1'-0"	-	1 1/2" = 1'-0"	-

J10	SECTION DETAIL @ EDGE OF FLOOR SLAB
1 1/2" = 1'-0"	-

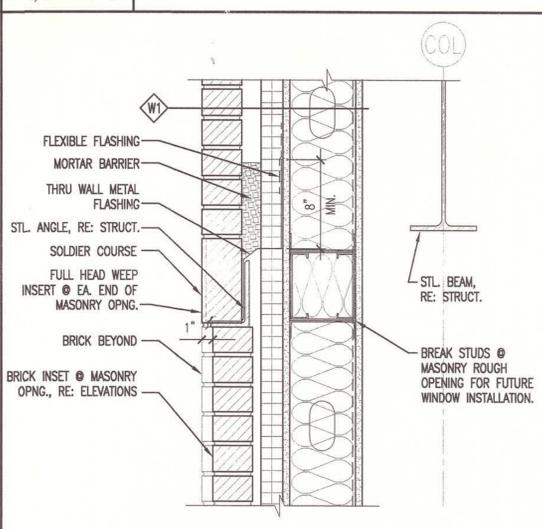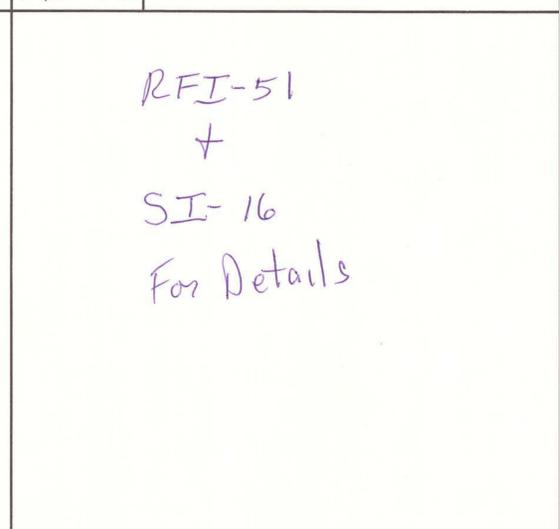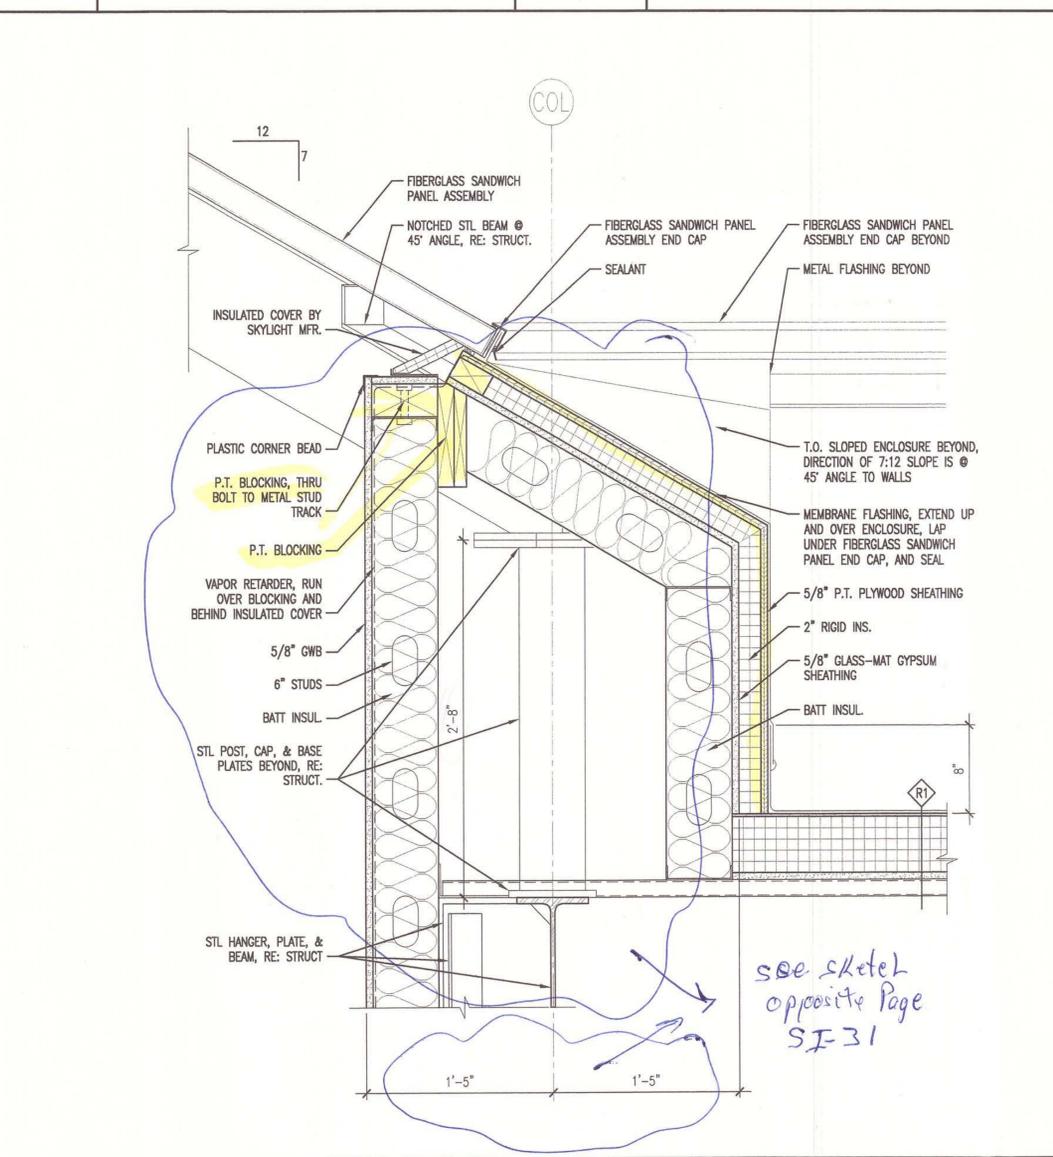

A1	SKYLIGHT VALLEY RAFTER & POST - ROOF ENCLOSURE	A7	EXTERIOR GRANITE PROFILES
1 1/2" = 1'-0"	-	1 1/2" = 1'-0"	-


A7	EXTERIOR GRANITE PROFILES	A10	SECTION DETAIL @ SILL OF INSET BRICK
1 1/2" = 1'-0"	-	1 1/2" = 1'-0"	-

A10	SECTION DETAIL @ SILL OF INSET BRICK
1 1/2" = 1'-0"	-

see sketch opposite page SI-31

AS BUILT
Owner Copy

SM RT
ARCHITECTURE ENGINEERING PLANNING
SMRT
144 Fore Street P.O. Box 618
Portland, Maine 04104
tel. (207) 772-3846
fax. (207) 772-1070

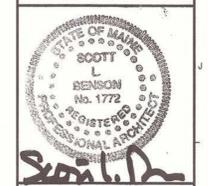


PROJECT TITLE:
**MAINE TURNPIKE AUTHORITY
ADMINISTRATION BUILDING
PORTLAND, MAINE**

CURRENT ISSUE STATUS:
**ISSUED FOR BIDDING/CONSTRUCTION
7-9-07**

REV	DESCRIPTION	DATE
0	BIDDING/CONSTRUCTION	7-9-07

GRAPHIC SCALE:
0" 1"

SCALE: AS NOTED
PROJECT MANAGER: SLB
JC/DRAWN BY: TCM/TCM
A/E OF RECORD: SLB
CAD FILE: AE532-06016
PROJECT NO: 06016
DATE: 7-9-07
SHEET TITLE:
**BUILDING AND WALL
DETAILS**
SHEET No. **AE532**

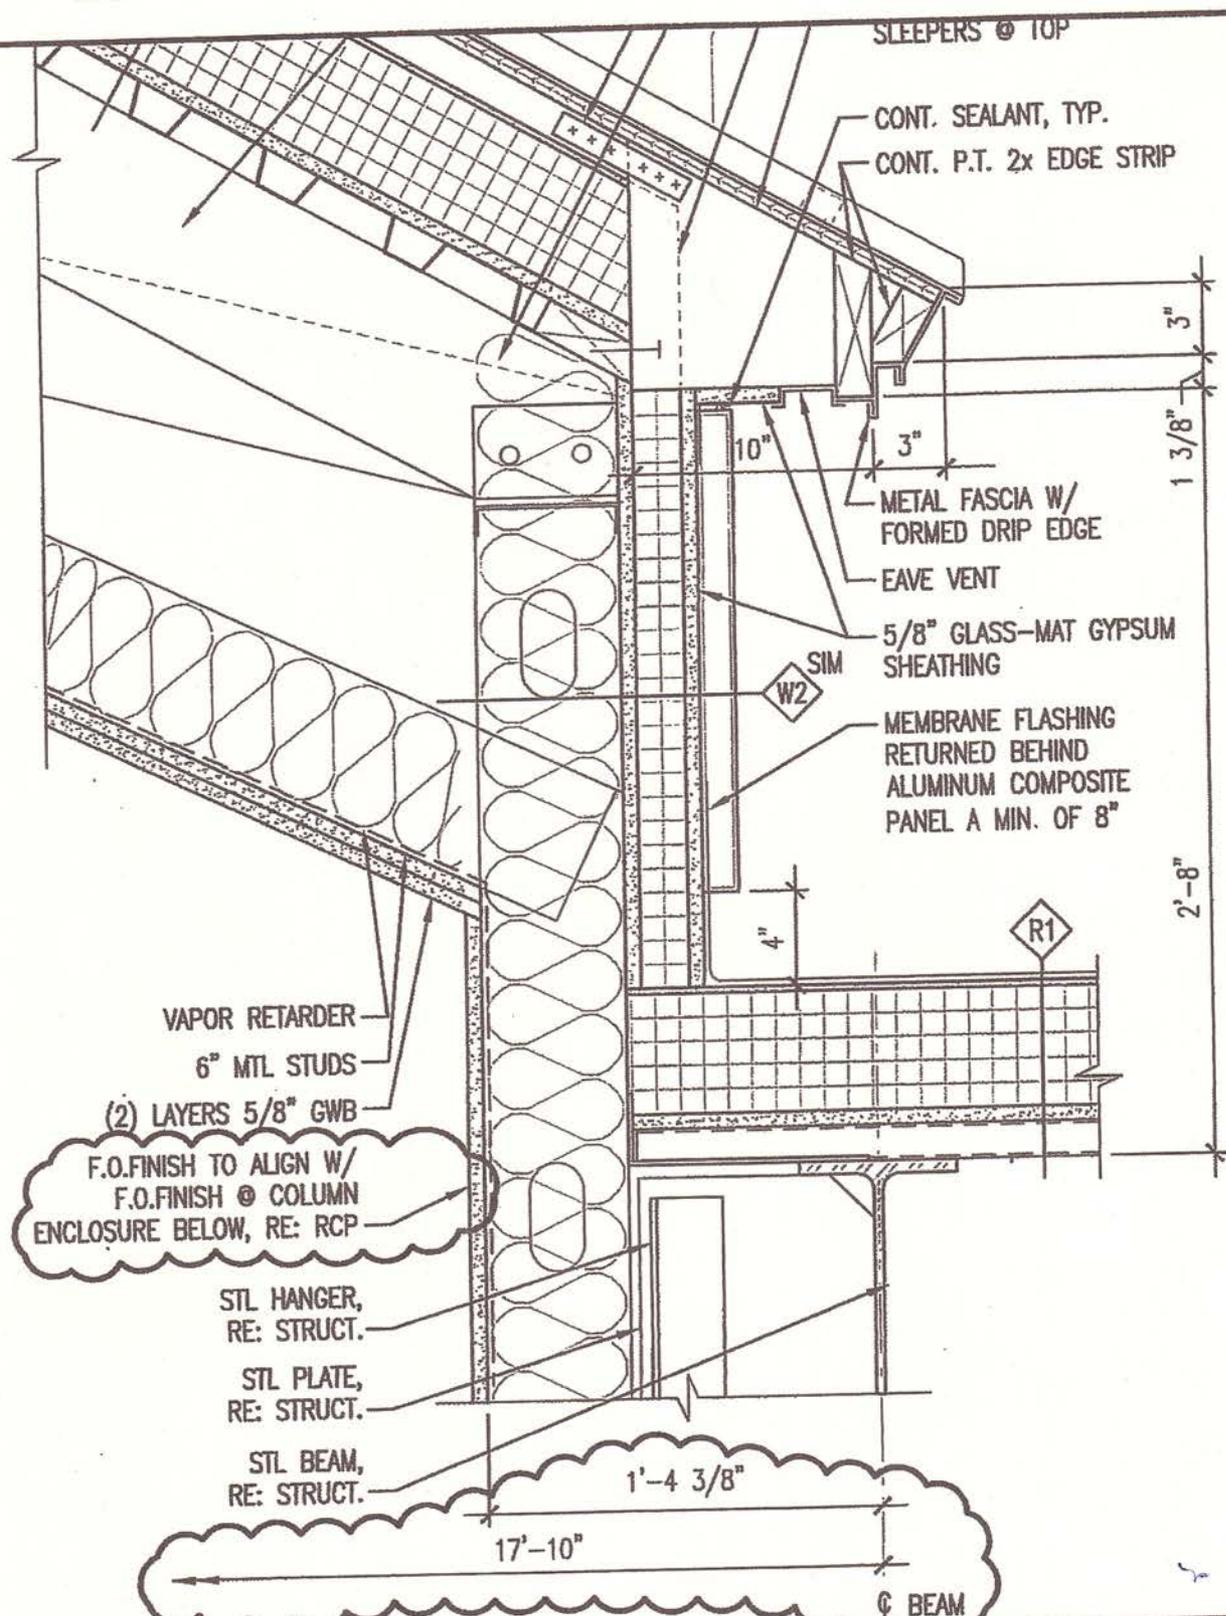

F.O.FINISH TO ALIGN W/
F.O.FINISH @ COLUMN
ENCLOSURE BELOW, RE: RCP

VAPOR RETARDER
6" MTL STUDS
(2) LAYERS 5/8" GWB

STL HANGER,
RE: STRUCT.
STL PLATE,
RE: STRUCT.
STL BEAM,
RE: STRUCT.

17'-10"
1'-4 3/8"
C BEAM





**SM
RT**

ARCHITECTURE ENGINEERING PLANNING
SMRT
144 Fore Street/P.O.Box 618 PORTLAND, MAINE 04104
tel. (207) 772-3846 / fax. (207) 772-1070

MAINE TURNPIKE AUTHORITY
ADMINISTRATION BUILDING
REVISED A10/AE533

PROJECT: MAINE TURNPIKE AUTHORITY ADMINISTRATION BUILDING
SUBJECT: SECTION DETAIL @ CLERESTORY ROOF EDGE

SCALE:	1 1/2" = 1'-0"
CAD FILE:	AE533-06016
PROJECT No.	06016
REF. SHEET:	AE533
PM:	SLB
A/E:	SLB
DATE:	
ADDITUM No.	SI-
SKETCH No.	A-1

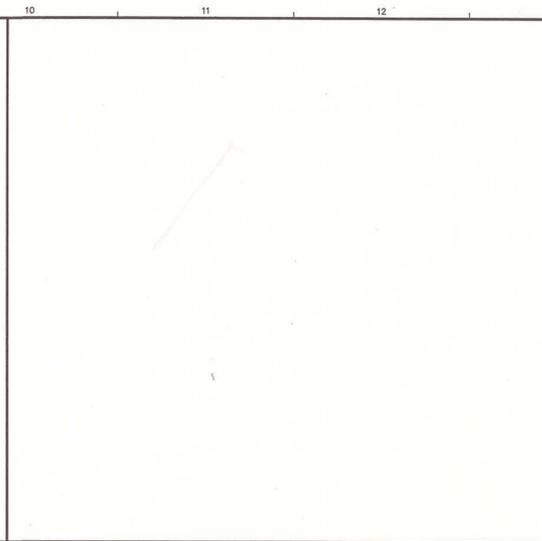
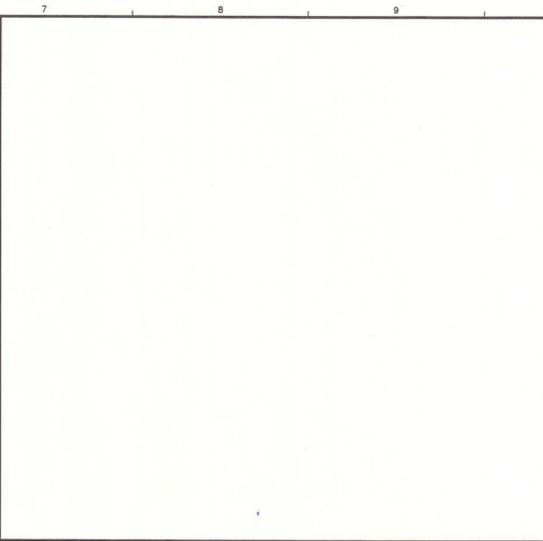
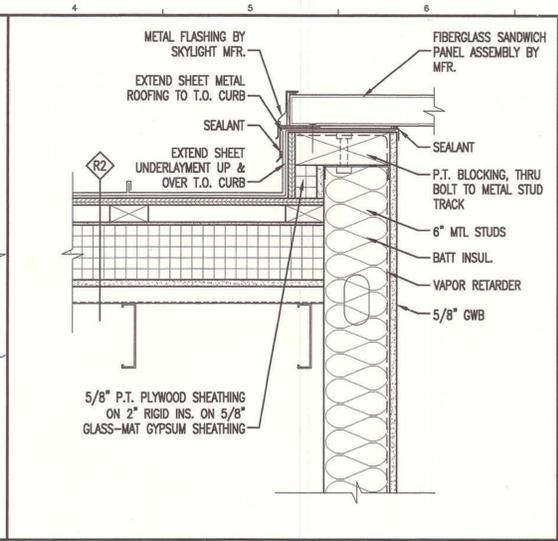
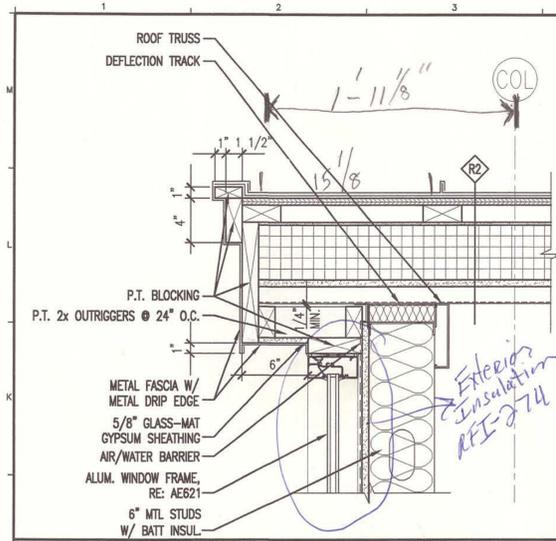


J1 SECTION DETAIL @ CLERESTORY ROOF RAKE
1 1/2" = 1'-0"

J4 SECTION DETAIL @ METAL ROOF & SKYLIGHT
1 1/2" = 1'-0"

J7
1 1/2" = 1'-0"

J10
1 1/2" = 1'-0"

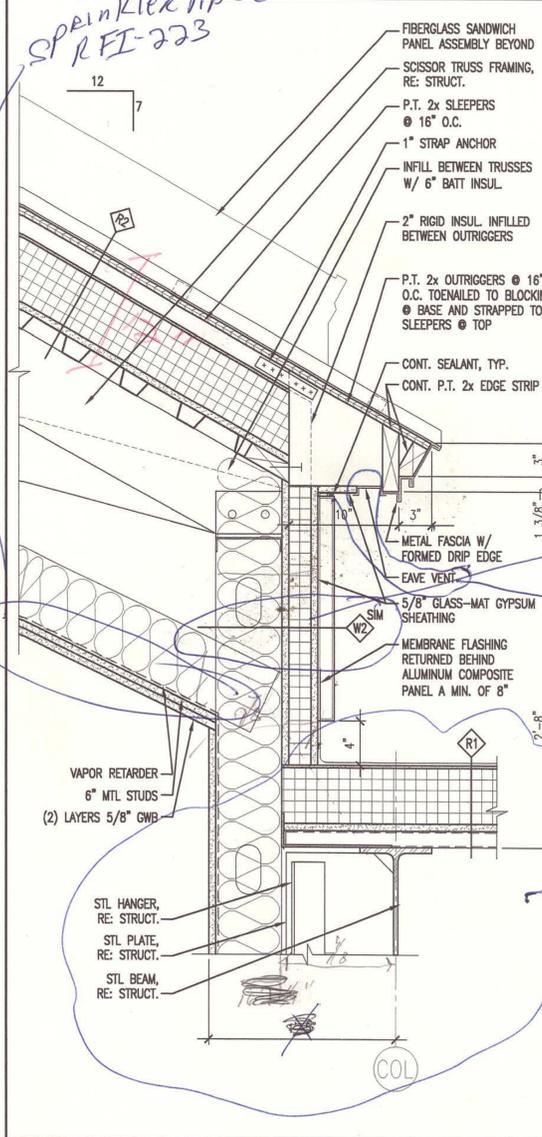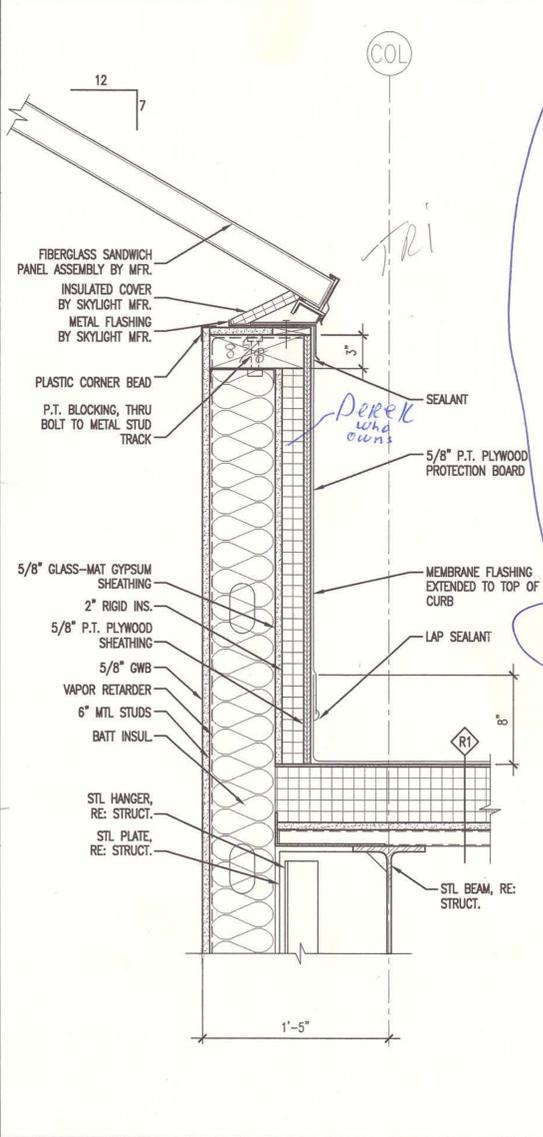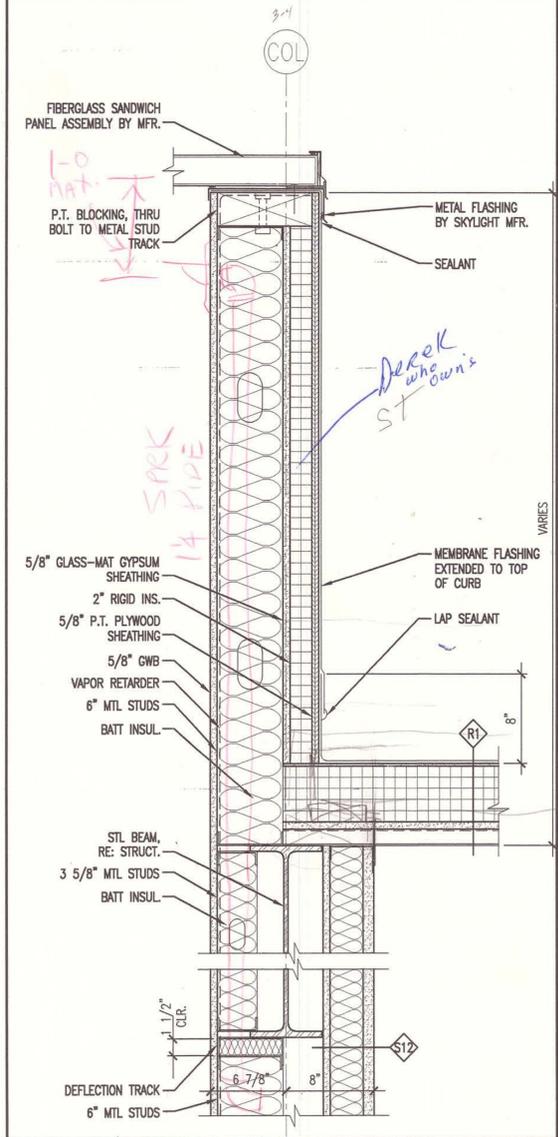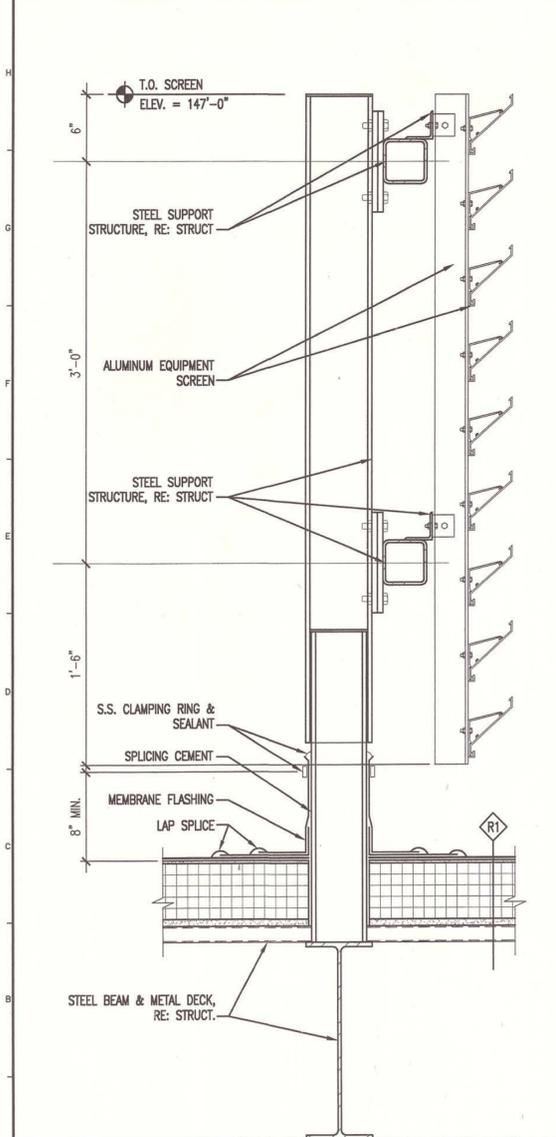

A1 SECTION DETAIL @ EQUIPMENT SCREEN
1 1/2" = 1'-0"

A4 SECTION DETAIL @ SKYLIGHT
1 1/2" = 1'-0"

A7 SECTION DETAIL @ SKYLIGHT
1 1/2" = 1'-0"

A10 SECTION DETAIL @ CLEAR STORY ROOF EDGE
1 1/2" = 1'-0"

GENERAL NOTES:
1. SEE 0101 FOR PROJECT GENERAL NOTES.



ARCHITECTURE ENGINEERING PLANNING
SMT
144 Fore Street/P.O. Box 618
Portland, Maine 04104
tel. (207) 772-3846
fax. (207) 772-1070



PROJECT TITLE: MAINE TURNPIKE AUTHORITY ADMINISTRATION BUILDING
CURRENT ISSUE STATUS: ISSUED FOR BIDDING/CONSTRUCTION 7-9-07

REV	DESCRIPTION	DATE
0	BIDDING/CONSTRUCTION	7-9-07

GRAPHIC SCALE: 0" = 1"
SCALE: AS NOTED
PROJECT MANAGER: SLB
JC/DRAWN BY: TCM/TCM
A/E OF RECORD: SLB
CAD FILE: AE533-06016
PROJECT NO: 06016
DATE: 7-8-07
SHEET TITLE: BUILDING AND WALL SECTION DETAILS
SHEET No. AE533

AS BUILT
Owner Copy

*RFE 224
Dense Glass Between
Ridge
Eave Vent RFE 251*


*see sketch
opposite page
SI-31*

*SPRINKLER PIPE CHANGE
RFE 223*

*Derek who owns
ST*

*14 PIPE
SACK*

*Exterior
Insulation
RFE 274*

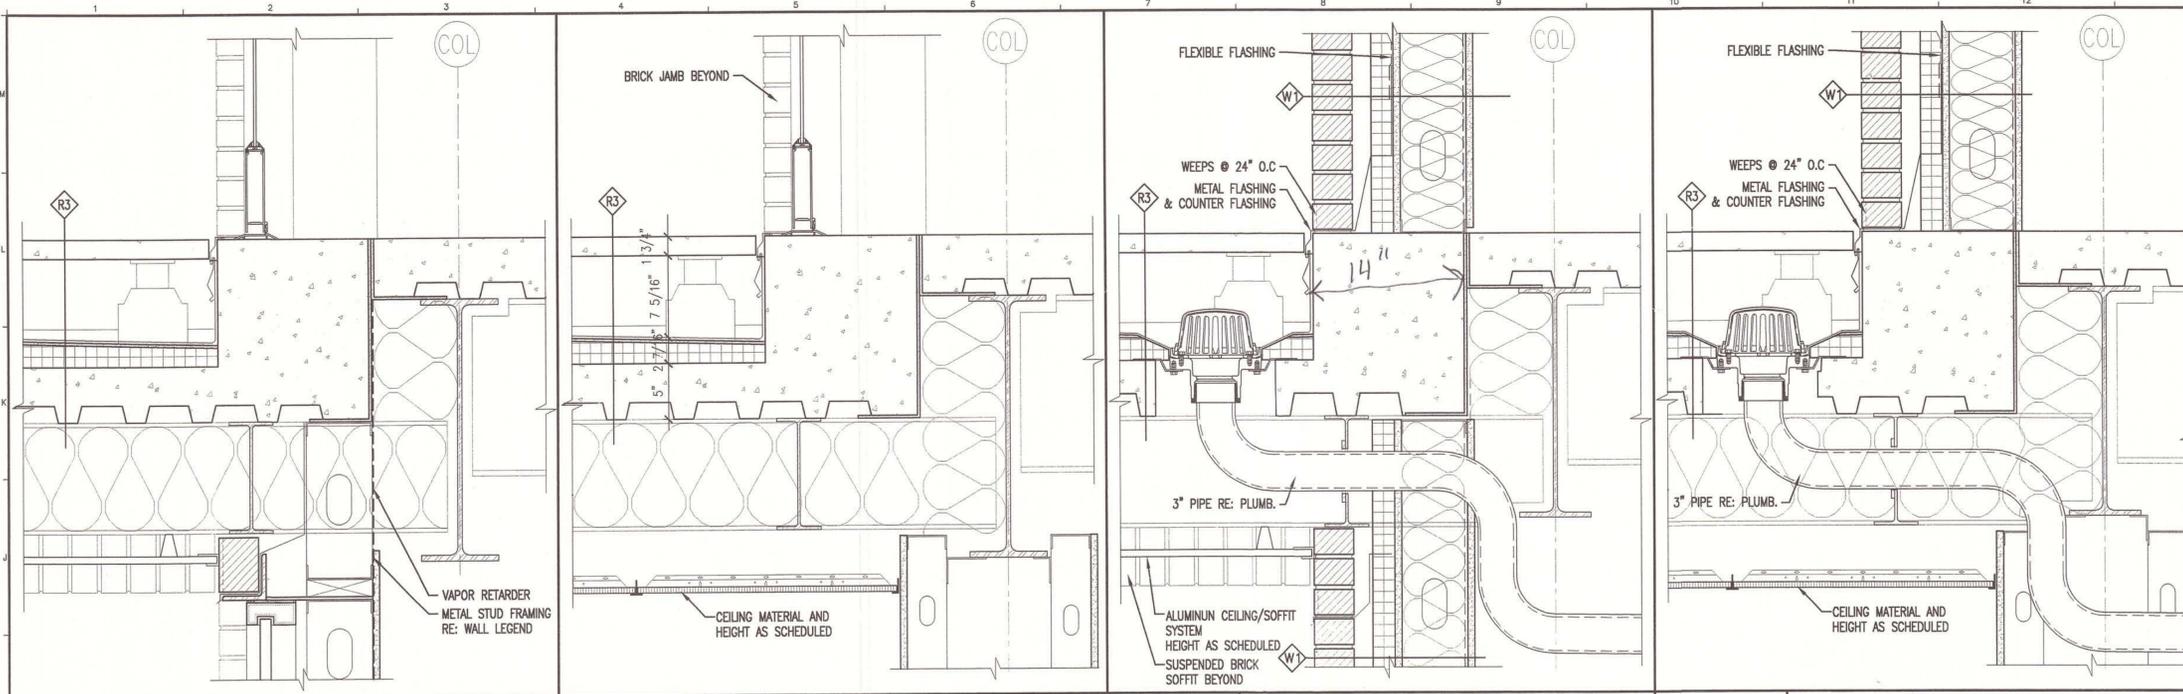


H1 SECTION DETAIL @ BALCONY
 1 1/2" = 1'-0"

H4 SECTION DETAIL @ BALCONY
 1 1/2" = 1'-0"

H7 SECTION DETAIL @ BALCONY
 1 1/2" = 1'-0"

H10 SECTION DETAIL @ BALCONY
 1 1/2" = 1'-0"

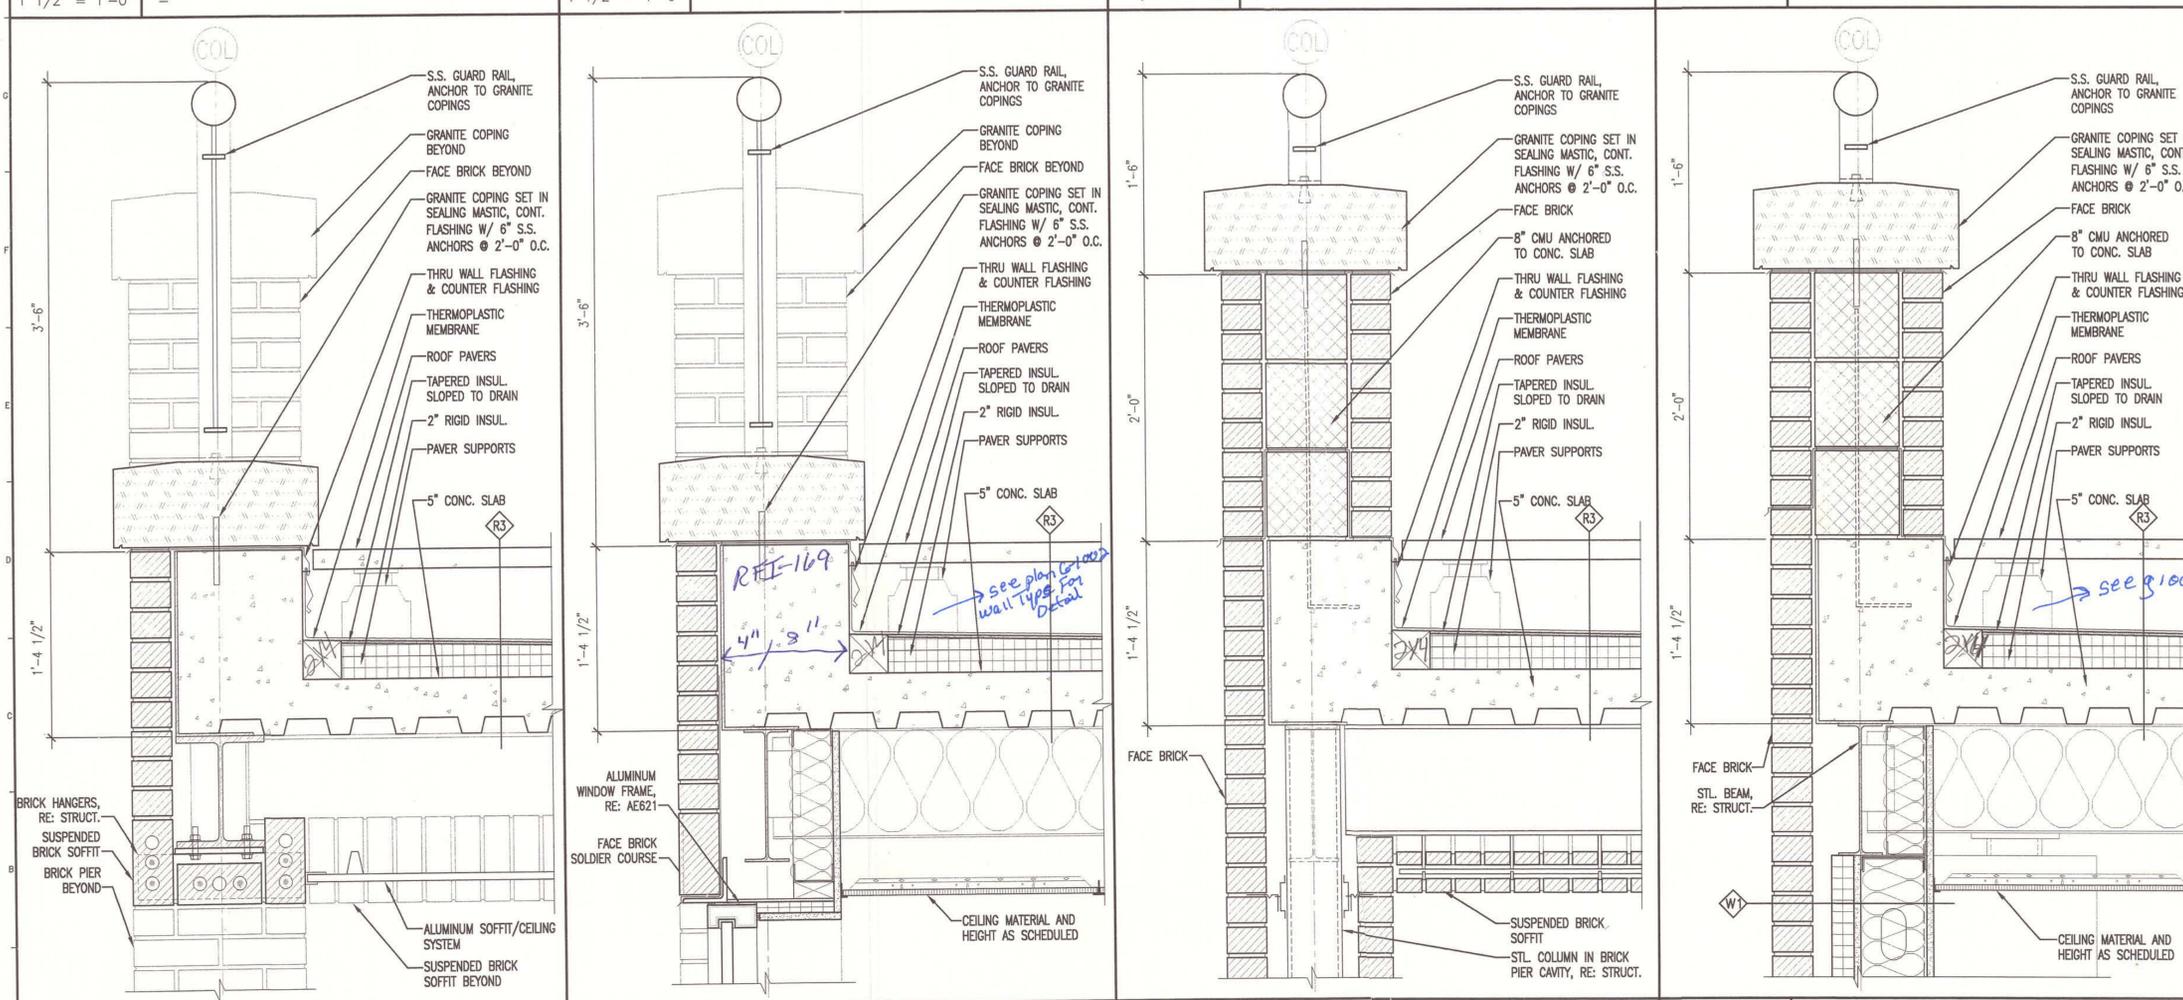

A1 SECTION DETAIL @ BALCONY
 1 1/2" = 1'-0"

A4 SECTION DETAIL @ BALCONY
 1 1/2" = 1'-0"


A7 SECTION DETAIL @ BALCONY
 1 1/2" = 1'-0"

A10 SECTION DETAIL @ BALCONY
 1 1/2" = 1'-0"

GENERAL NOTES:
 1. SEE 0101 FOR PROJECT GENERAL NOTES.



ARCHITECTURE ENGINEERING PLANNING
 SMART
 144 Fore Street/P.O. Box 618
 Portland, Maine 04104
 tel. (207) 772-3846
 fax. (207) 772-1070

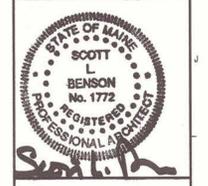

PROJECT TITLE:
**MAINE TURNPIKE AUTHORITY
 ADMINISTRATION BUILDING**
 PORTLAND, MAINE

CURRENT ISSUE STATUS:
**ISSUED FOR BIDDING/CONSTRUCTION
 7-9-07**

REV	DESCRIPTION	DATE
0	BIDDING/CONSTRUCTION	7-9-07

GRAPHIC SCALE:
 0" 1"

SCALE: AS NOTED
 PROJECT MANAGER: SLB
 JC/DRAWN BY: TCM/TCM
 A/E OF RECORD: SLB
 CAD FILE: AE534-06016
 PROJECT NO: 06016
 DATE: 7-9-07
 SHEET TITLE:
**BUILDING AND WALL
 SECTION DETAILS**
 SHEET No. **AE534**

AS BUILT
 Owner Copy

GENERAL NOTES:

1. SEE G101 FOR PROJECT GENERAL NOTES.

**SM
RT**

ARCHITECTURE ENGINEERING PLANNING
SMART

144 Fore Street, P.O. Box 618
Portland, Maine 04104
tel. (207) 772-3846
fax. (207) 772-1070



MAINE TURNPIKE AUTHORITY
ADMINISTRATION BUILDING
PORTLAND, MAINE

ISSUED FOR BIDDING/CONSTRUCTION
7-9-07

PROJECT TITLE:

CURRENT ISSUE STATUS:

REV	DESCRIPTION	DATE
0	BIDDING/CONSTRUCTION	7-9-07

GRAPHIC SCALE:



SCALE: AS NOTED
PROJECT MANAGER: SLB
JC/DRAWN BY: TCM/TCM
A/E OF RECORD: SLB
CAD FILE: AES35-06016
PROJECT NO: 06016
DATE: 7-9-07

SHEET TITLE:
BUILDING AND WALL
SECTION DETAILS

SHEET No. AE535

AS BUILT
Owner Copy

<p>J1 —</p>	<p>J4 MECHANICAL SHAFT DETAIL</p>	<p>J7 ELEVATOR DOOR HEAD DETAIL</p>	<p>J10 MECHANICAL SHAFT DETAIL</p>
<p>1 1/2" = 1'-0"</p>	<p>1 1/2" = 1'-0"</p>	<p>1 1/2" = 1'-0"</p>	<p>1 1/2" = 1'-0"</p>
<p>E1 MECHANICAL SHAFT DETAIL</p>	<p>E4 MECHANICAL SHAFT DETAIL</p>	<p>E7 ELEVATOR SHAFT DETAIL</p>	<p>E10 ELEVATOR SHAFT DETAIL</p>
<p>1 1/2" = 1'-0"</p>	<p>1 1/2" = 1'-0"</p>	<p>1 1/2" = 1'-0"</p>	<p>1 1/2" = 1'-0"</p>
<p>A1 MECHANICAL SHAFT DETAIL</p>	<p>A4 MECHANICAL SHAFT DETAIL</p>	<p>A7 ELEVATOR SHAFT DETAIL</p>	<p>A10 ELEVATOR SHAFT DETAIL</p>
<p>1 1/2" = 1'-0"</p>	<p>1 1/2" = 1'-0"</p>	<p>1 1/2" = 1'-0"</p>	<p>1 1/2" = 1'-0"</p>

GENERAL NOTES:
 1. SEE 6101 FOR PROJECT GENERAL NOTES.

**SM
SMT
RT**

ARCHITECTURE ENGINEERING PLANNING
 SMART
 144 Fore Street/P.O. Box 618
 Portland, Maine 04104
 tel. (207) 772-3846
 fax. (207) 772-1070



Scott L. Benson

PROJECT TITLE:
**MAINE TURNPIKE AUTHORITY
 ADMINISTRATION BUILDING**
 PORTLAND, MAINE


CURRENT ISSUE STATUS:
ISSUED FOR BIDDING/CONSTRUCTION
7-9-07

REV	DESCRIPTION	DATE
0	BIDDING/CONSTRUCTION	7-9-07

GRAPHIC SCALE:
 0" 1"
 SCALE: AS NOTED
 PROJECT MANAGER: SLB
 JC/DRAWN BY: TCM/TCM
 A/E OF RECORD: SLB
 CAD FILE: AE541-06016
 PROJECT NO: 06016
 DATE: 7-9-07


SHEET TITLE:
**STAIR
 SECTIONS & DETAILS**
 SHEET No.
AE541

**AS BUILT
 Owner Copy**

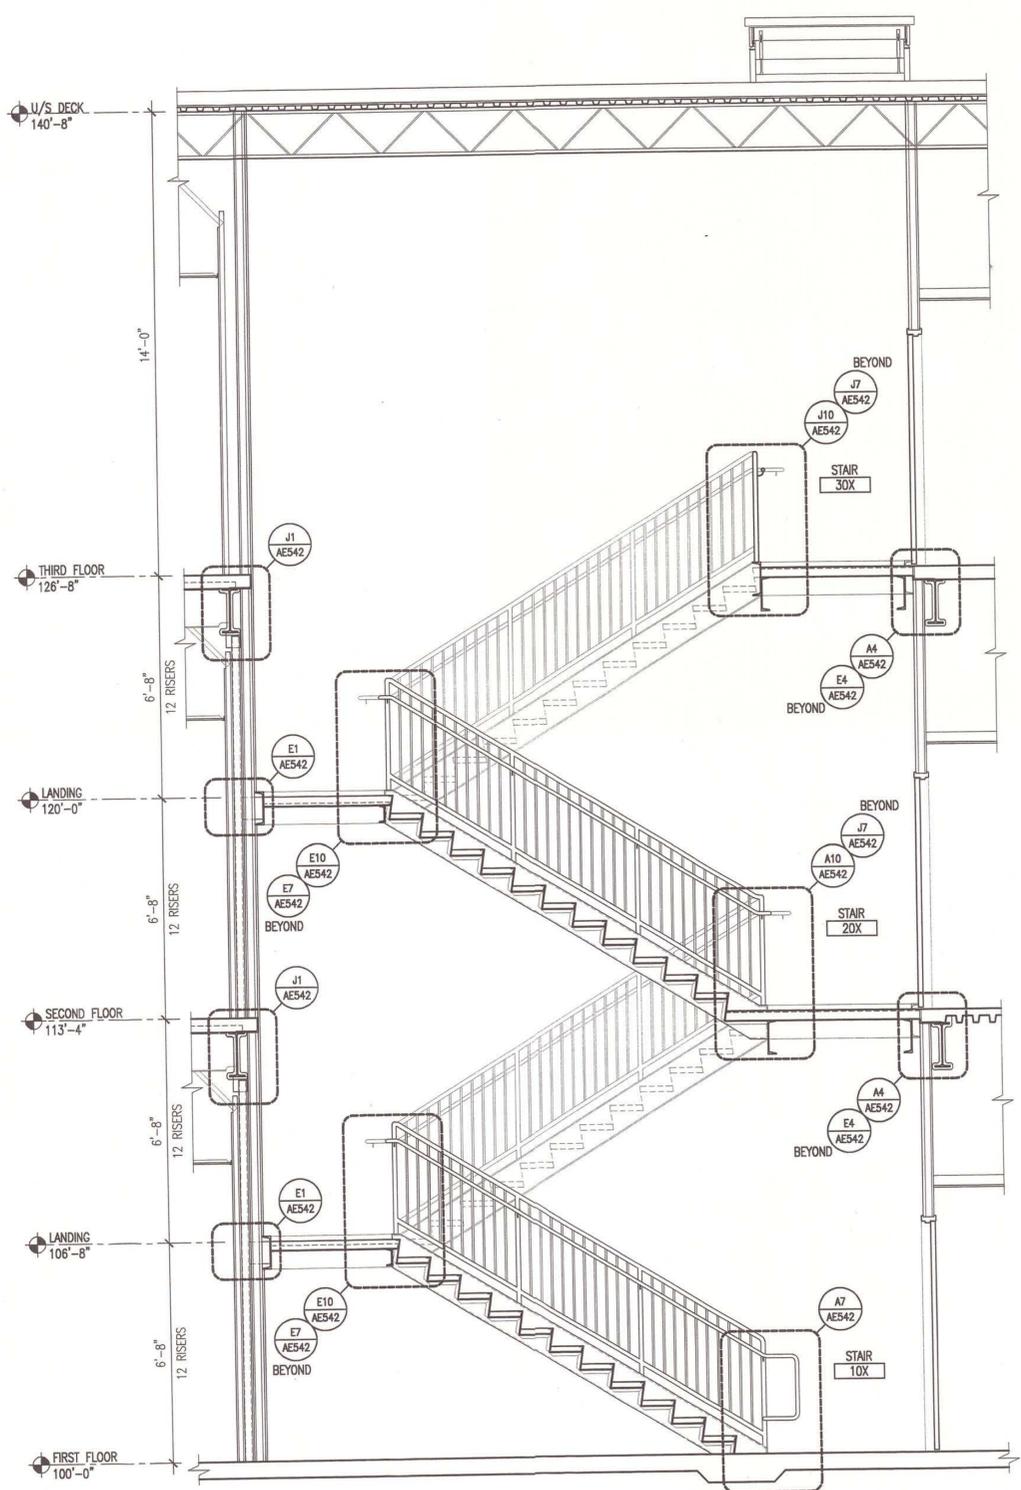


A7 STAIR SECTION

3/8" = 1'-0"

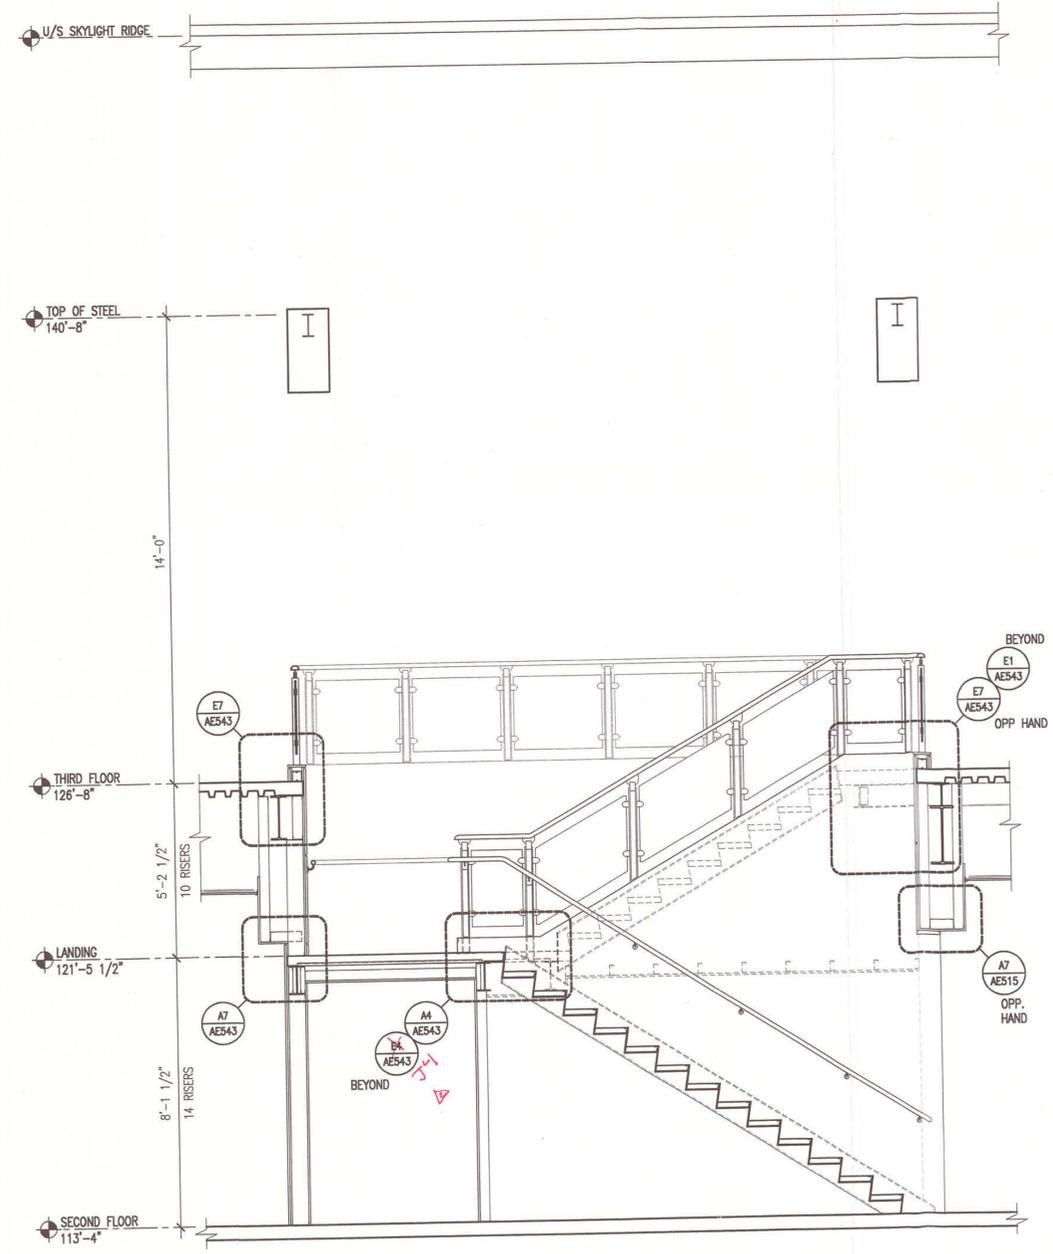


A1 STAIR SECTION


3/8" = 1'-0"

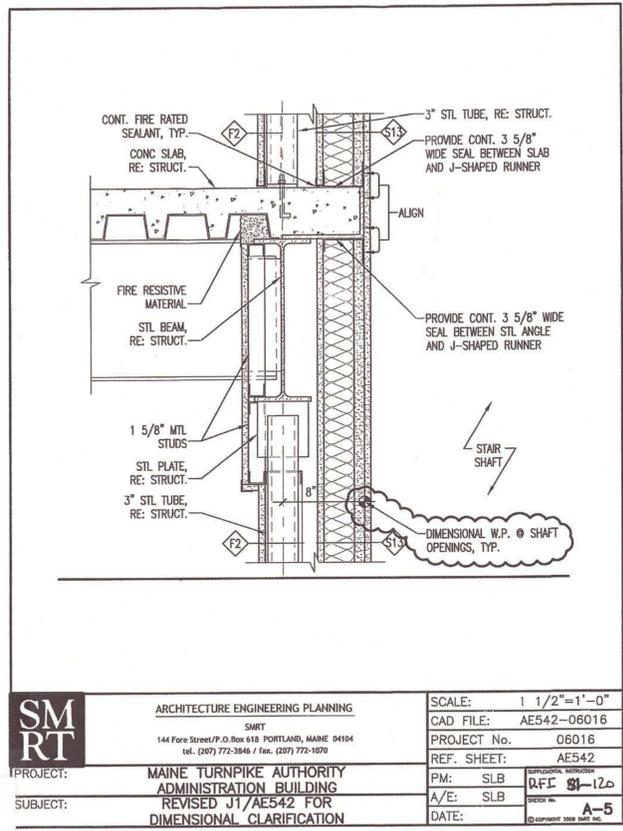


	ARCHITECTURE ENGINEERING PLANNING	SCALE: 1 1/2"=1'-0"
	SMRT 144 Fore Street/P.O. Box 618 PORTLAND, MAINE 04104 tel. (207) 772-3846 / fax. (207) 772-1070	CAD FILE: AE542-06016
PROJECT:	MAINE TURNPIKE AUTHORITY ADMINISTRATION BUILDING	PROJECT No. 06016
SUBJECT:	REVISED J1/AE542 FOR DIMENSIONAL CLARIFICATION	REF. SHEET: AE542
		PM: SLB
		A/E: SLB
		DATE: _____

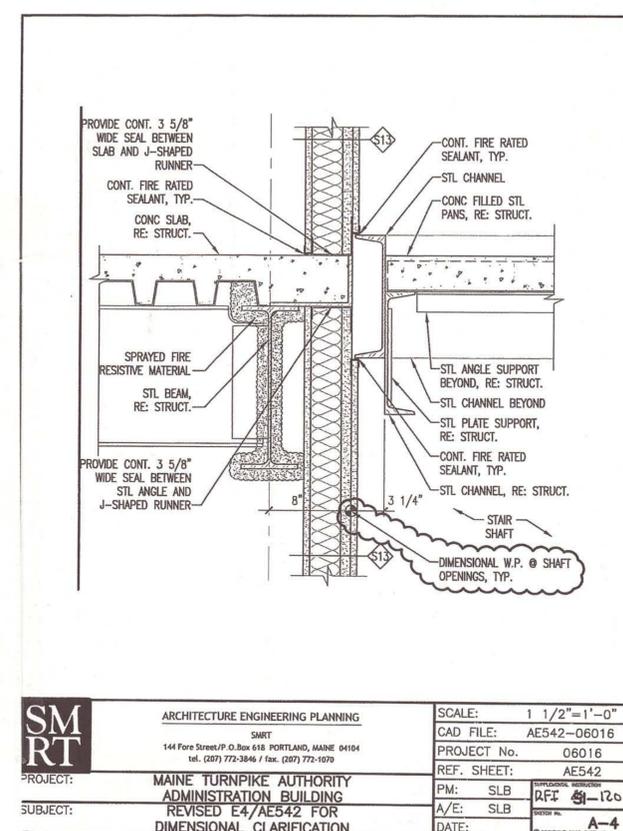


	ARCHITECTURE ENGINEERING PLANNING	SCALE: 1 1/2"=1'-0"
	SMRT 144 Fore Street/P.O. Box 618 PORTLAND, MAINE 04104 tel. (207) 772-3846 / fax. (207) 772-1070	CAD FILE: AE542-06016
PROJECT:	MAINE TURNPIKE AUTHORITY ADMINISTRATION BUILDING	PROJECT No. 06016
SUBJECT:	REVISED E4/AE542 FOR DIMENSIONAL CLARIFICATION	REF. SHEET: AE542
		PM: SLB
		A/E: SLB
		DATE: _____

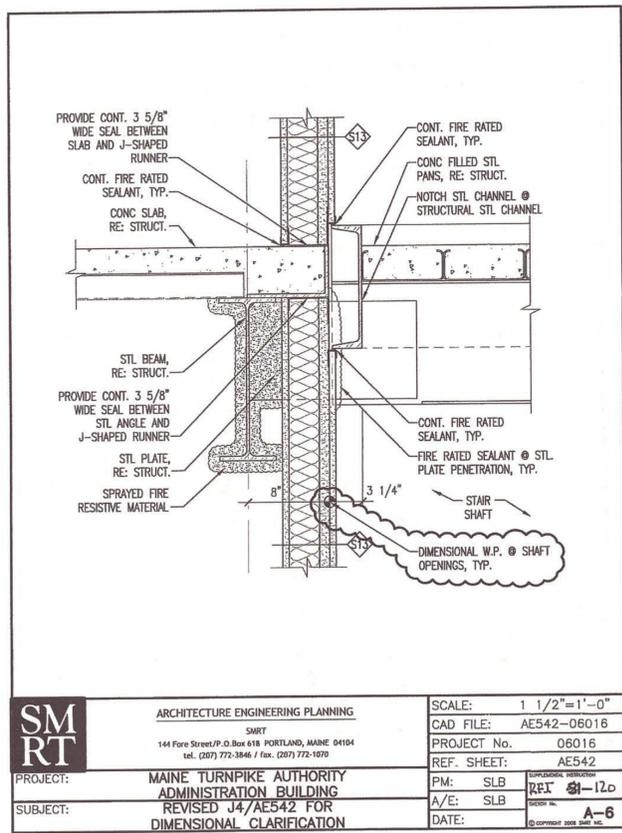


	ARCHITECTURE ENGINEERING PLANNING	SCALE: 1 1/2"=1'-0"
	SMRT 144 Fore Street/P.O. Box 618 PORTLAND, MAINE 04104 tel. (207) 772-3846 / fax. (207) 772-1070	CAD FILE: AE542-06016
PROJECT:	MAINE TURNPIKE AUTHORITY ADMINISTRATION BUILDING	PROJECT No. 06016
SUBJECT:	REVISED J4/AE542 FOR DIMENSIONAL CLARIFICATION	REF. SHEET: AE542
		PM: SLB
		A/E: SLB
		DATE: _____

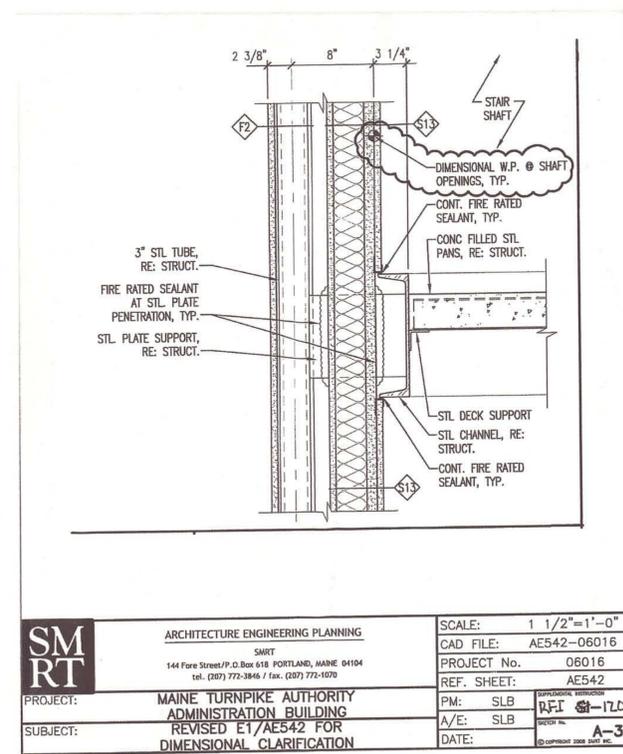

	ARCHITECTURE ENGINEERING PLANNING	SCALE: 1 1/2"=1'-0"
	SMRT 144 Fore Street/P.O. Box 618 PORTLAND, MAINE 04104 tel. (207) 772-3846 / fax. (207) 772-1070	CAD FILE: AE542-06016
PROJECT:	MAINE TURNPIKE AUTHORITY ADMINISTRATION BUILDING	PROJECT No. 06016
SUBJECT:	REVISED E1/AE542 FOR DIMENSIONAL CLARIFICATION	REF. SHEET: AE542
		PM: SLB
		A/E: SLB
		DATE: _____

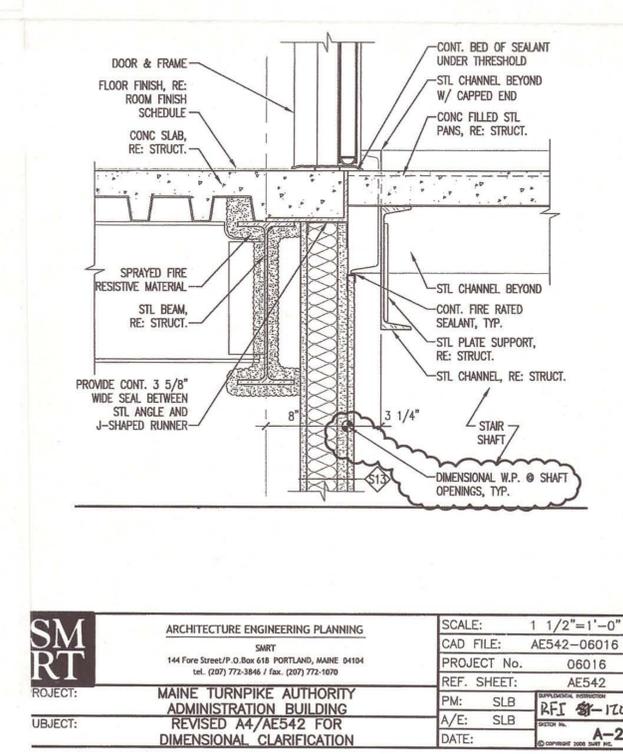


	ARCHITECTURE ENGINEERING PLANNING	SCALE: 1 1/2"=1'-0"
	SMRT 144 Fore Street/P.O. Box 618 PORTLAND, MAINE 04104 tel. (207) 772-3846 / fax. (207) 772-1070	CAD FILE: AE542-06016
PROJECT:	MAINE TURNPIKE AUTHORITY ADMINISTRATION BUILDING	PROJECT No. 06016
SUBJECT:	REVISED A4/AE542 FOR DIMENSIONAL CLARIFICATION	REF. SHEET: AE542
		PM: SLB
		A/E: SLB
		DATE: _____

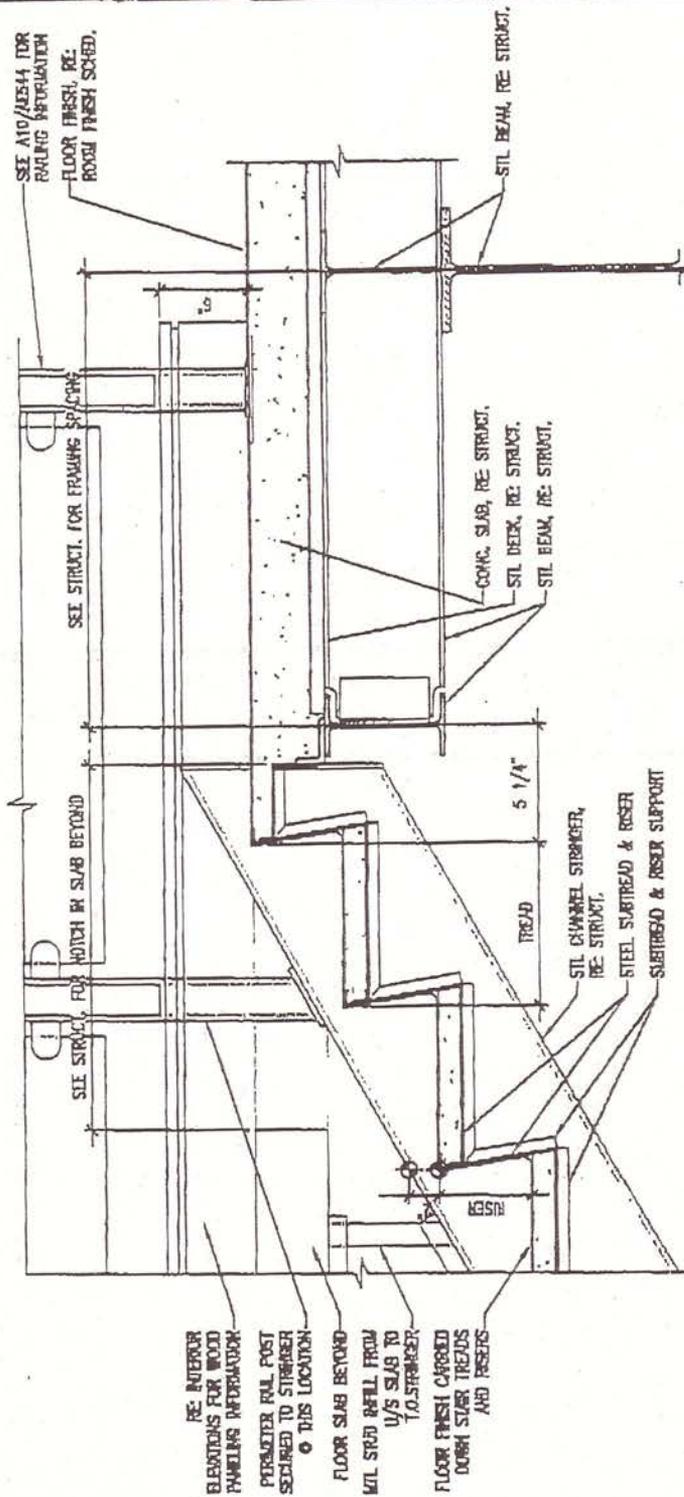


ARCHITECTURE ENGINEERING PLANNING
 SMRT
 144 Fore Street/P.O.Box 618 PORTLAND, MAINE 04104
 tel. (207) 772-3846 / fax. (207) 772-1070

SCALE:	1"=1'-0"
CAD FILE:	AE543-06018
PROJECT No.	06016
REF. SHEET:	AE543
PM:	SLB
A/E:	SLB
DATE:	8-3-07
ADD-2 A-2	


PROJECT: MAINE TURNPIKE AUTHORITY
 ADMINISTRATION BUILDING
 SUBJECT: ADDED E1/AE543
 SECTION DETAIL @ TOP OF STAIR

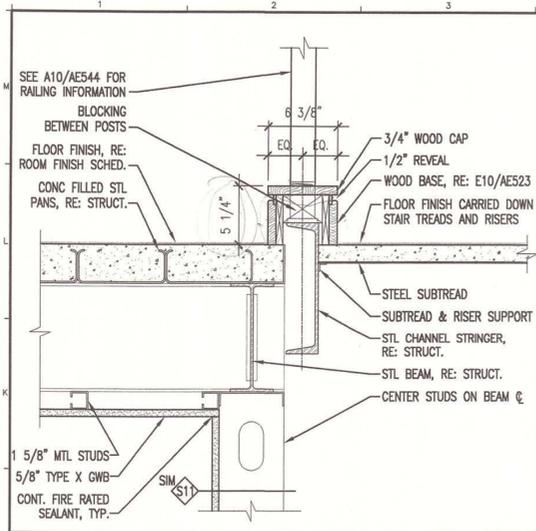


JE1 SECTION @ STAIR
1 1/2" = 1'-0"

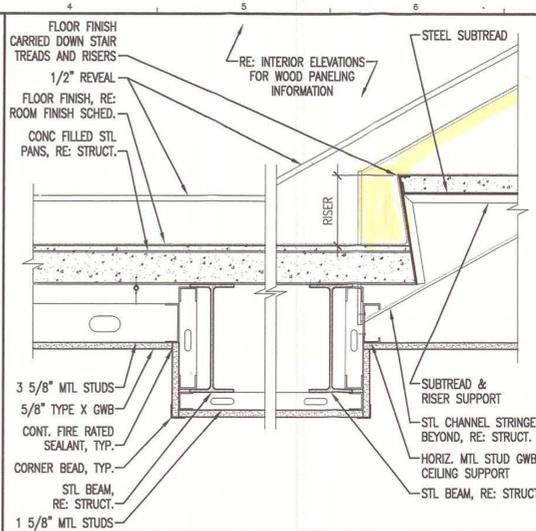

JE4 SECTION @ STAIR
1 1/2" = 1'-0"

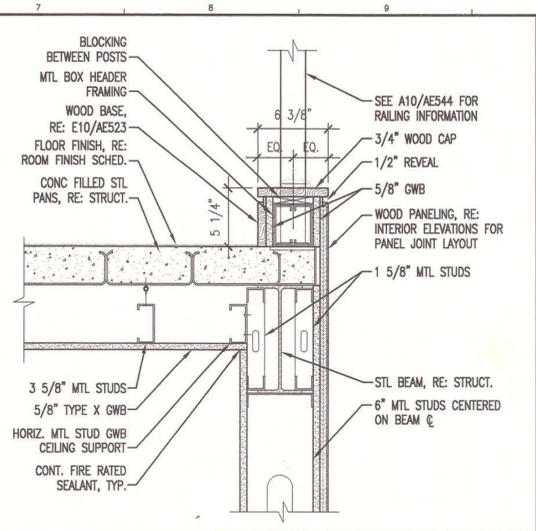


JE7 SECTION @ STAIR
1 1/2" = 1'-0"

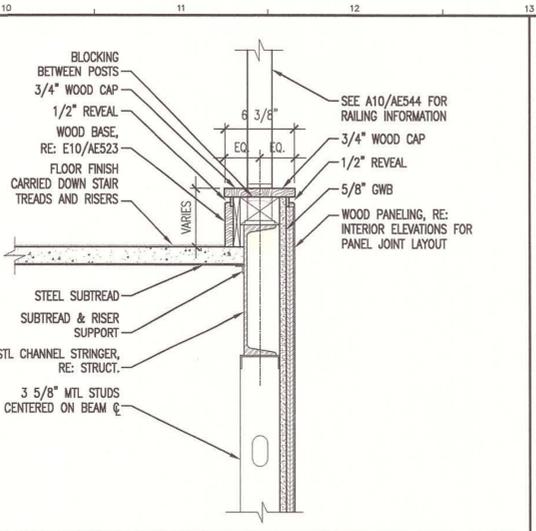


JE10 SECTION @ STAIR
1 1/2" = 1'-0"

Handwritten note: SEE SK A-2 OPPOSITE PAGE


E1 SECTION @ STAIR
1 1/2" = 1'-0"

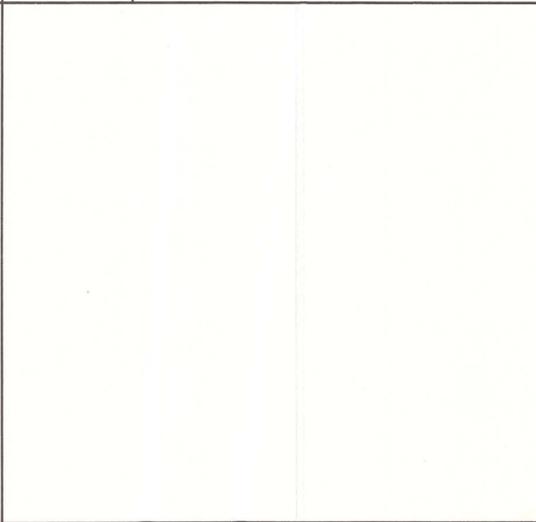

E4 SECTION @ STAIR
1 1/2" = 1'-0"

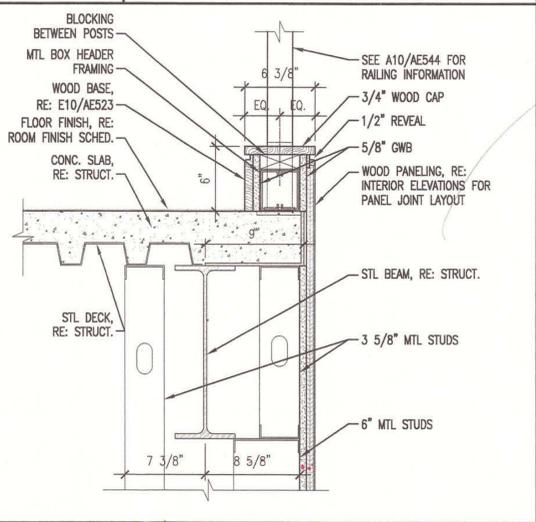


E7 SECTION @ STAIR
1 1/2" = 1'-0"

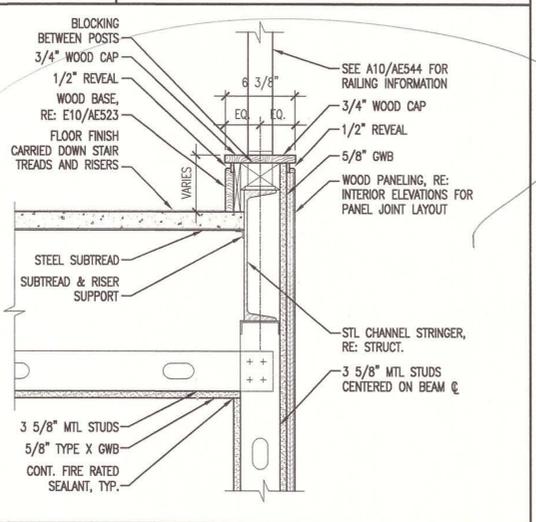


E10 SECTION @ STAIR
1 1/2" = 1'-0"

GENERAL NOTES:
1. SEE 0101 FOR PROJECT GENERAL NOTES.


Handwritten note: See ST-46

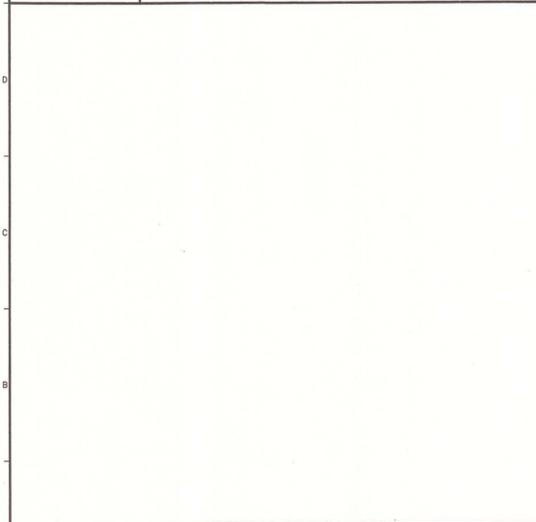


A1 SECTION @ BEAM
1 1/2" = 1'-0"

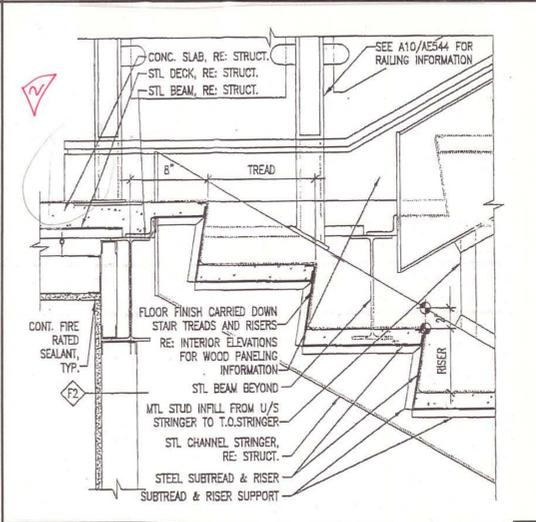

A4 SECTION @ BEAM
1 1/2" = 1'-0"

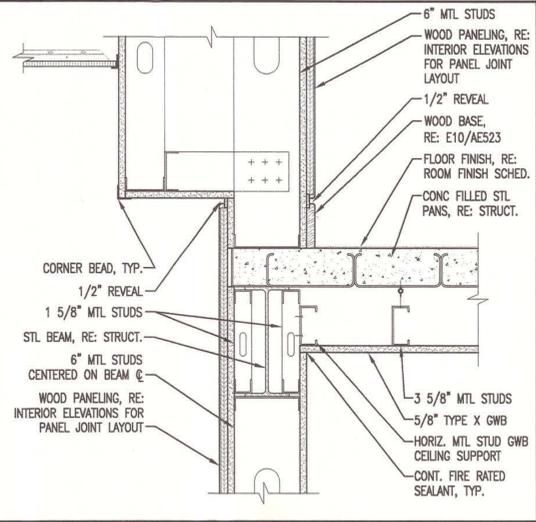

A7 SECTION @ STAIR
1 1/2" = 1'-0"

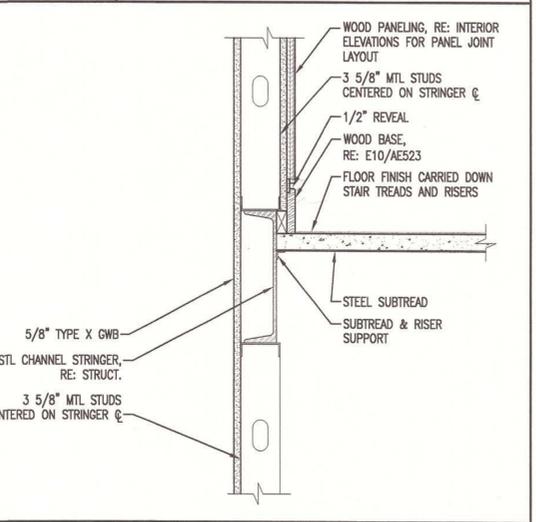

A10 SECTION @ STAIR
1 1/2" = 1'-0"

SM RT
ARCHITECTURE ENGINEERING PLANNING
144 Fore Street, P.O. Box 618
Portland, Maine 04104
tel. (207) 772-3846
fax. (207) 772-1070

STATE OF MAINE
SCOTT L. BENSON
No. 1772
REGISTERED PROFESSIONAL ARCHITECT


Handwritten signature: Scott L. Benson

PROJECT TITLE: MAINE TURNPIKE AUTHORITY ADMINISTRATION BUILDING PORTLAND, MAINE
CURRENT ISSUE STATUS: ISSUED FOR BIDDING/CONSTRUCTION 7-9-07


REV	DESCRIPTION	DATE
0	BIDDING/CONSTRUCTION	7-9-07

GRAPHIC SCALE: 0" = 1"
SCALE: AS NOTED
PROJECT MANAGER: SLB
JC/DRAWN BY: TCM/TCM
A/E OF RECORD: SLB
CAD FILE: AE543-06016
PROJECT NO: 06016
DATE: 7-9-07
SHEET TITLE: STAIR DETAILS
SHEET No. AE543


AS BUILT
Owner Copy

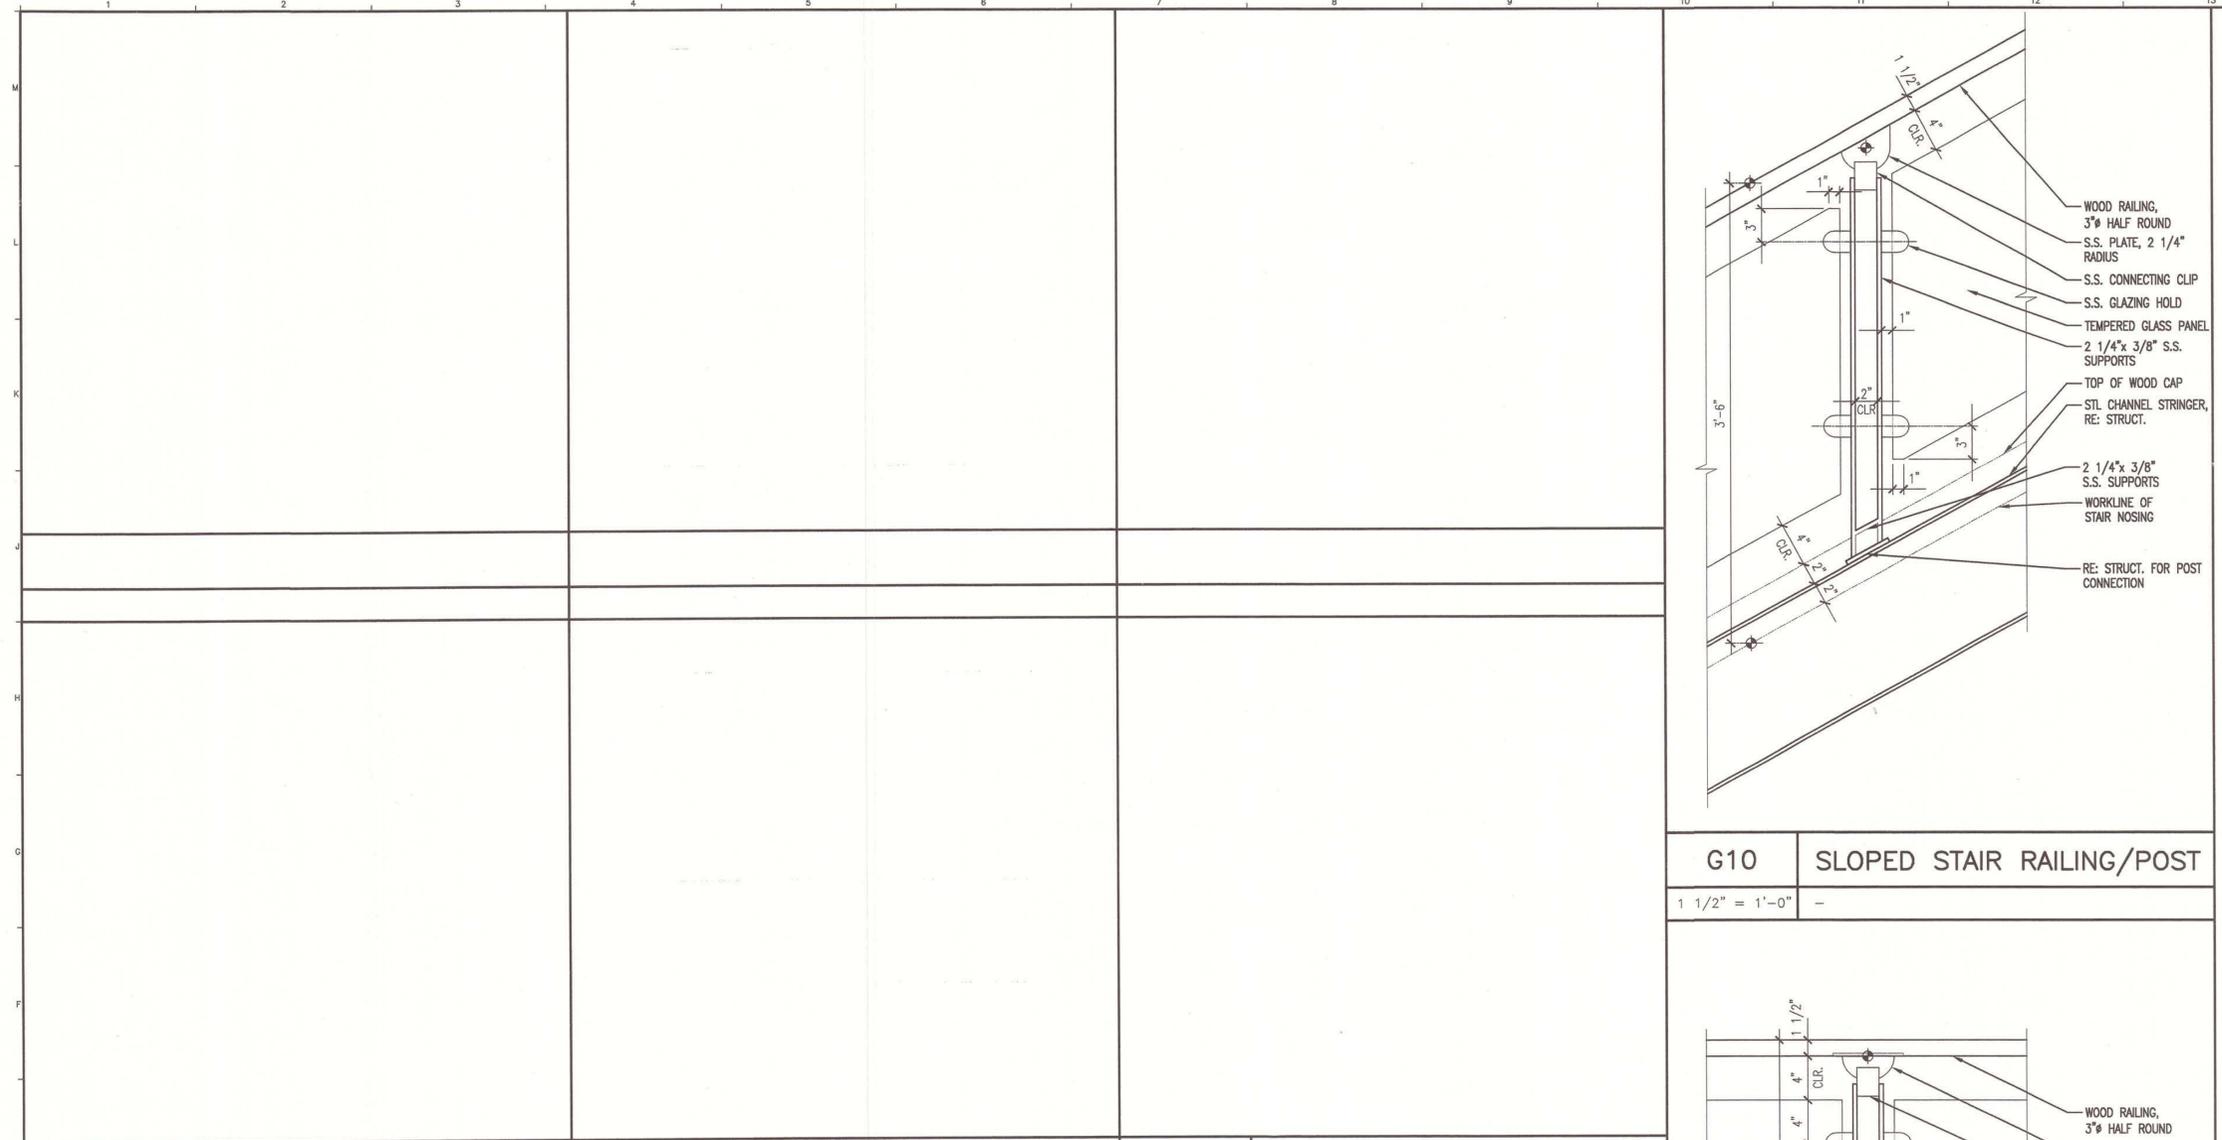

GENERAL NOTES:
 1. SEE G1001 FOR PROJECT GENERAL NOTES.

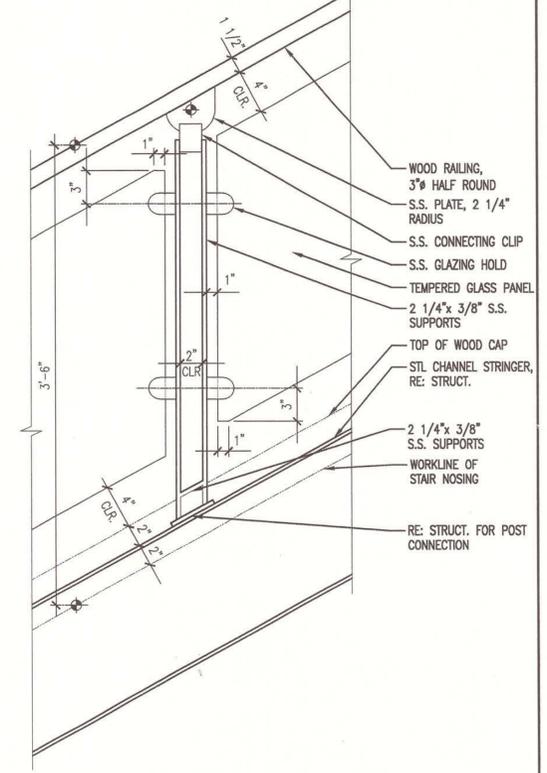

G10 SLOPED STAIR RAILING/POST
 1 1/2" = 1'-0"

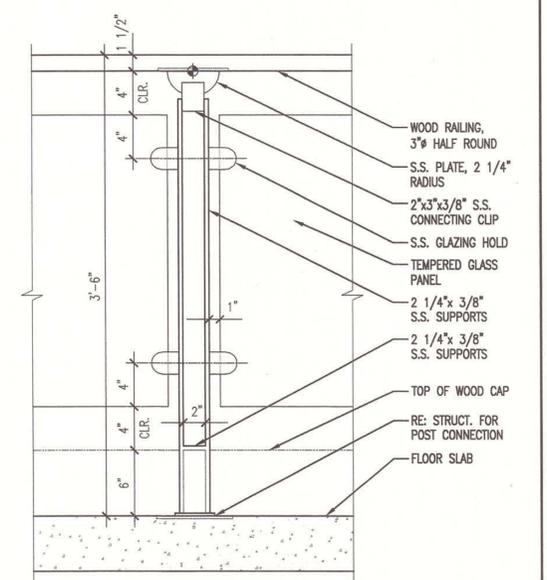

A10 TYPICAL STAIR RAILING/POST
 1 1/2" = 1'-0"




ARCHITECTURE ENGINEERING PLANNING
 SMART
 144 Fore Street/P.O. Box 618
 Portland, Maine 04104
 tel. (207) 772-3846
 fax. (207) 772-1070



PROJECT TITLE: MAINE TURNPIKE AUTHORITY ADMINISTRATION BUILDING PORTLAND, MAINE
 CURRENT ISSUE STATUS: ISSUED FOR BIDDING/CONSTRUCTION 7-9-07

REV	DESCRIPTION	DATE
0	BIDDING/CONSTRUCTION	7-9-07

GRAPHIC SCALE: 0" = 1"
 SCALE: AS NOTED
 PROJECT MANAGER: SLB
 JC/DRAWN BY: TCM/TCM
 A/E OF RECORD: SLB
 CAD FILE: AE544-06016
 PROJECT NO: 06016
 DATE: 7-9-07
 SHEET TITLE: RAILING DETAILS
 SHEET No. AE544

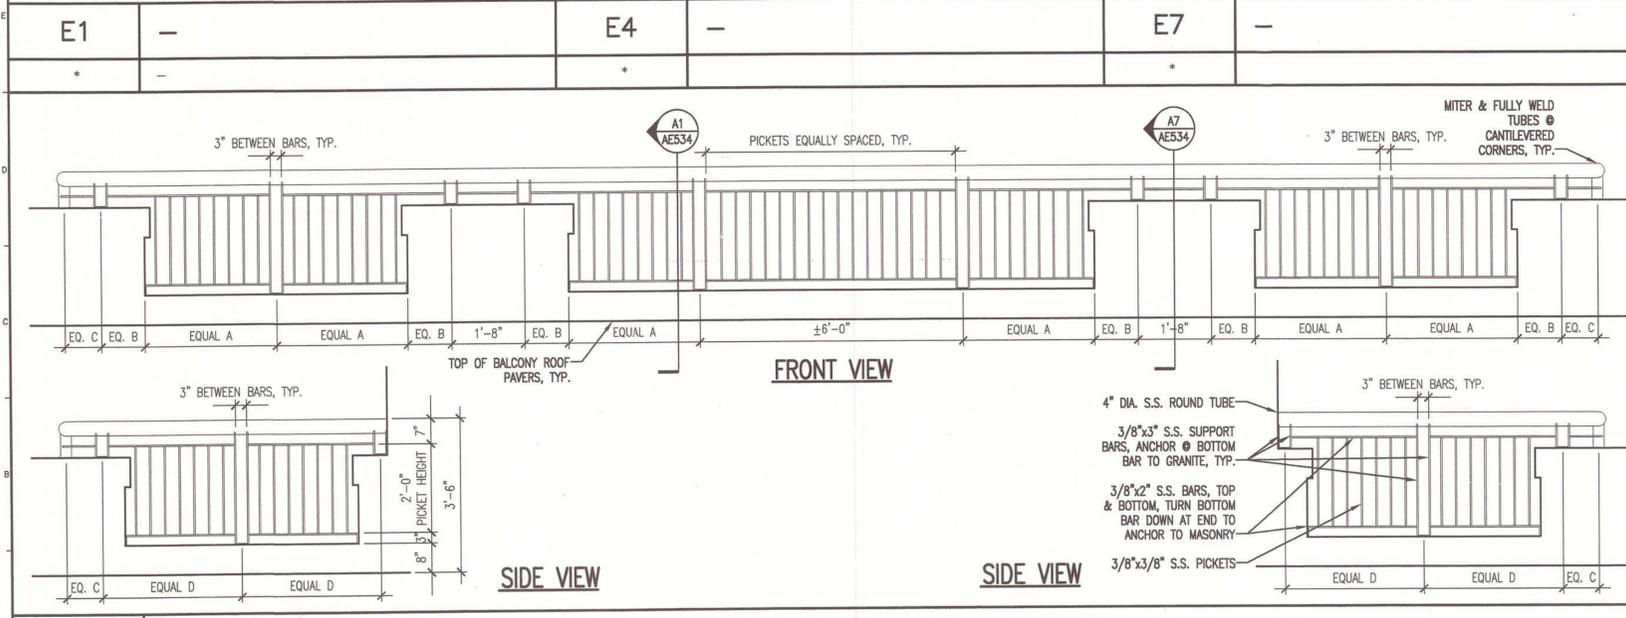

A1 EXTERIOR BALCONIES - RAIL ELEVATIONS
 1/2" = 1'-0"

AS BUILT
 Owner Copy

FIRST FLOOR ROOM FINISH SCHEDULE

ROOM NUMBER	ROOM NAME	FLOOR	BASE	WALLS				CEILING		ROOM NUMBER	REMARKS
				NORTH	SOUTH	EAST	WEST	MATERIAL	HEIGHT		
101	FULLFILLMENT	VCT	RES	GWB	GWB	GWB	GWB	ACT	9'-0"	101	8'-6" Ceiling RFT-386
102	MEN'S TOILET	CT	CT	CT/GWB	CT/GWB	CT/GWB	CT/GWB	ACT	9'-0"	102	8'-10" Ceiling RFT-386
102a	SHOWER	CT	CT	CT/GWB	CT/GWB	CT/GWB	CT/GWB	GWB	8'-0"	102a	8'-10" Ceiling H RFT-386
103	WOMEN'S TOILET	CT	CT	CT/GWB	CT/GWB	CT/GWB	CT/GWB	ACT	9'-0"	103	
103a	SHOWER	CT	CT	CT/GWB	CT/GWB	CT/GWB	CT/GWB	GWB	8'-0"	103a	
104	STAIR	RUBBER	RES	GWB	GWB	GWB	GWB	EXP	N/A	104	
105	STAIR	RUBBER	RES	GWB	GWB	GWB	GWB	EXP	N/A	105	
106	T/D	VCT	RES	GWB	GWB	GWB	GWB	EXP	N/A	106	
107	ELEC.	VCT	RES	GWB	GWB	GWB	GWB	EXP	N/A	107	Aceto
108	JAN.	VCT	RES	FRP	FRP	FRP	FRP	GWB	8'-0"	108	
109	SUPPLIES	VCT	RES	GWB	GWB	GWB	GWB	GWB	8'-0"	109	
110	TRANSP. STORAGE	VCT	RES	GWB	GWB	GWB	GWB	ACT	9'-0"	110	8'-6" Ceiling RFT-386
111	CORR.	VCT	RES	GWB/WP	GWB/WP	-	GWB/WP	ACT	9'-0"	111	
112	COMPUTER REPAIR LAB	SDVCT	RES	GWB	GWB	GWB	GWB	ACT	9'-0"	112	8'-10" Ceiling RFT-386
113	COMPUTER STORAGE	SDVCT	RES	GWB	GWB	GWB	GWB	ACT	9'-0"	113	
114	MID RANGE/SERVER ROOM	SDVCT	RES	GWB	GWB	GWB	GWB	PTD EXP	N/A	114	
115	BOTTLE	VCT	RES	GWB	GWB	GWB	GWB	EXP.	N/A	115	
116	FARE COLLECTION STORAGE	VCT	RES	GWB	GWB	GWB	GWB	EXP.	N/A	116	
117	SEC. EVID. STORAGE	VCT	RES	GWB	GWB	GWB	GWB	ACT	9'-0"	117	
118	INTERVIEW	CPT	RES	GWB	GWB	GWB	GWB	ACT	9'-0"	118	
119	OFFICE	CPT	RES	GWB	GWB	GWB	GWB	ACT	9'-0"	119	
120	OFFICE	CPT	RES	GWB	GWB	GWB	GWB	ACT	9'-0"	120	
121	OFFICE	CPT	RES	GWB	GWB	GWB	GWB	ACT	9'-0"	121	
122	CORR.	VCT	RES	GWB/WP	GWB/WP	GWB/WP	GWB/WP	ACT	9'-0"	122	
123	CONFERENCE TRAINING	CPT	RES	GWB/RAIL	GWB/RAIL	GWB/RAIL	GWB/RAIL	ACT	9'-0"	123	
124	STORAGE	CPT	RES	GWB	GWB	GWB	GWB	ACT	9'-0"	124	Aceto
125	JAN.	VCT	RES	FRP	FRP	FRP	FRP	GWB	8'-0"	125	
126	OFFICE	CPT	RES	GWB	GWB	GWB	GWB	ACT	9'-0"	126	
127	OFFICE	CPT	RES	GWB	GWB	GWB	GWB	ACT	9'-0"	127	
128	OFFICE	CPT	RES	GWB	GWB	GWB	GWB	ACT	9'-0"	128	
129	WAITING	VCT	RES	GWB	GWB	GWB	GWB	ACT	9'-0"	129	
130	CORR.	VCT	RES	GWB/WP	GWB/WP	GWB/WP	GWB/WP	ACT	9'-0"	130	
131	TOILET	CT	CT	CT/GWB	CT/GWB	CT/GWB	CT/GWB	ACT	8'-0"	131	
132	RECEPT.	CPT	RES	GWB	GWB	GWB	GWB	ACT	9'-0"	132	
133	TOILET	CT	CT	CT/GWB	CT/GWB	CT/GWB	CT/GWB	ACT	8'-0"	133	
134	WORK ROOM	VCT	RES	GWB	GWB	GWB	GWB	ACT	9'-0"	134	
135	WOMEN'S SHOWER	CT	CT	CT/GWB	CT/GWB	CT/GWB	CT/GWB	ACT	8'-0"	135	
136	MEN'S SHOWER	CT	CT	CT/GWB	CT/GWB	CT/GWB	CT/GWB	ACT	8'-0"	136	
137	CORR.	VCT	RES	GWB/WP	GWB/WP	GWB/WP	GWB/WP	ACT	9'-0"	137	
138	BREAKROOM	VCT	RES	GWB	GWB	GWB	GWB	ACT	9'-0"	138	
139	LOCKERS	VCT	RES	GWB	GWB	GWB	GWB	ACT	9'-0"	139	
140	CORR.	VCT	RES	GWB/WP	GWB/WP	GWB/WP	GWB/WP	ACT	9'-0"	140	John Cyr
141	COMP.	SDVCT	RES	GWB	GWB	GWB	GWB	EXP	N/A	141	
142	TROOPERS	VCT	RES	GWB	GWB	GWB	GWB	ACT	9'-0"	142	
143	CORR.	VCT	RES	GWB/WP	GWB/WP	GWB/WP	GWB/WP	ACT	9'-0"	143	
144	SUP.	VCT	RES	GWB	GWB	GWB	GWB	ACT	9'-0"	144	
145	SALLYPORT	S. CONC.	-	CMU	CMU	CMU	CMU	EXP	N/A	145	
146	ARMORY	S. CONC.	-	CMU	CMU	CMU	CMU	EXP	N/A	146	
147	INTERVIEW	VCT	RES	GWB	CMU	GWB	GWB	ACT*	9'-0"	147	*PROVIDE HOLD DOWN CLIPS Ceiling
148	INTOX.	VCT	RES	GWB	CMU	GWB	GWB	GWB	9'-0"	148	EPOXY WALL FINISH ON GWB
149	TOILET	CT	CT	CT/GWB	CT/GWB	CT/GWB	CT/GWB	ACT*	8'-0"	149	EPOXY WALL FINISH ON GWB, *PROVIDE HOLD DOWN CLIPS Ceilings
150	VEST.	VCT	RES	GWB	GWB	GWB	GWB	GWB	9'-0"	150	
151	CORR.	VCT	RES	GWB/WP	GWB/WP	GWB/WP	GWB/WP	ACT	9'-0"	151	
152	OFFICE	CPT	RES	GWB	GWB	GWB	GWB	ACT	9'-0"	152	8'-4" Ceiling H RFT-386
153	OPEN OFFICE	CPT	RES	GWB	GWB	GWB	GWB	ACT	9'-0"	153	8'-6" Ceiling H RFT-386
154	BREAKROOM	VCT	RES	GWB	GWB	GWB	GWB	ACT/GWB	VARIES	154	8'-10" Ceiling H RFT-386
155	VENDING	VCT	RES	GWB	GWB	GWB	GWB	ACT	9'-0"	155	7'-11" Ceiling H RFT-386
156	CORR.	VCT	RES	GWB/WP	GWB/WP	GWB/WP	GWB/WP	ACT	9'-0"	156	
157	CORR.	VCT	RES	GWB/WP	GWB/WP	GWB/WP	GWB/WP	ACT	9'-0"	157	
157a	ALCOVE	VCT	RES	GWB/WP	GWB/WP	GWB/WP	GWB/WP	ACT	9'-0"	157a	
158	CORR.	VCT	RES	GWB/WP	GWB/WP	GWB/WP	GWB/WP	ACT	9'-0"	158	
159	CONFERENCE	CPT	RES	GWB	GWB	GWB	GWB	ACT	9'-0"	159	8'-8" Ceiling H RFT-386
160	ELEV. MACH.	S. CONC.	RES	GWB	GWB	GWB	GWB	ACT	9'-0"	160	
161	OPEN OFFICE	CPT	RES	GWB	GWB	GWB	GWB	ACT	9'-0"	161	8'-6" Ceiling H RFT-386
162	OFFICE	CPT	RES	GWB	GWB	GWB	GWB	ACT	9'-0"	162	8'-2" Ceiling H RFT-386
163	CUSTODIAL STORAGE	VCT	RES	GWB	GWB	GWB	GWB	ACT	9'-0"	163	
164	CORR.	VCT	RES	GWB/WP	GWB/WP	GWB/WP	GWB/WP	ACT	9'-0"	164	
165	VEST.	VCT	RES	GWB	GWB	GWB	GWB	GWB	9'-0"	165	
166	OFFICE SUPPLIES	S. CONC.	RES	GWB	GWB	GWB	GWB	ACT	9'-0"	166	
167	BUILDING SERVICES	S. CONC.	RES	GWB	GWB	GWB	GWB	ACT	9'-0"	167	
168	SHIP/RECEIVE	S. CONC.	-	PLY/GWB	PLY/GWB	PLY/GWB	PLY/GWB	PT EXP.	N/A	168	4' HIGH PLYWOOD WAINSCOT ALL WALLS who own's Parag
169	MECH.	S. CONC.	RES	GWB	GWB	GWB	GWB	EXP.	N/A	169	
170	CORR.	VCT	RES	GWB/WP	GWB/WP	GWB/WP	GWB/WP	ACT	9'-0"	170	
171	TEL/DATA	S. CONC.	RES	GWB	GWB	GWB	GWB	EXP.	N/A	171	
172	ELEC.	S. CONC.	RES	GWB	GWB	GWB	GWB	EXP.	N/A	172	
173	FILE STORAGE	VCT	RES	GWB	GWB	GWB	GWB	EXP.	N/A	173	
174	PLAN STORAGE	VCT	RES	GWB	GWB	GWB	GWB	ACT	9'-0"	174	8'-10" Ceiling RFT-386

GENERAL NOTES:

- SEE G1001 FOR PROJECT GENERAL NOTES.

FINISH NOTES:


- SEE SPECIFICATIONS FOR ADDITIONAL INFORMATION REGARDING FINISH MATERIALS.
- REFER TO PARTITION LEGEND FOR TYPE OF GWB COMPOSITION REQUIRED. "ABUSE RESISTANT", "MOISTURE RESISTANT" OR OTHER (TYPICAL).
- REFER TO INTERIOR ELEVATIONS FOR MORE INFORMATION ON MATERIAL LOCATIONS

FINISH ABBREVIATIONS:

ACT	ACOUSTICAL CEILING TILE
CONC	CONCRETE, SEALED
CEM	CEMENT BOARD
CPT	CARPET
CT	CERAMIC TILE
EXP	EXPOSED STRUCTURE
FRP	FIBERGLASS REINFORCED PANEL
GWB	GYPSPUM WALLBOARD, PAINTED
INS	INSULATED
MAT	WALK-OFF MAT
FF	PRE-FINISHED BY MANUFACTURER
FLAM	PLASTIC LAMINATE
PTD	PAINTED
QT	QUARRY TILE
RB	RUBBER BASE
RCP	REFLECTED CEILING PLAN
RES	RESILIENT BASE
SF	STOREFRONT (ALUMINUM)
SV	SHEET VINYL
VCT	VINYL COMPOSITION TILE
WVC	VINYL WALL COVERING
WD	WOOD
WDP	WOOD PANELING
WP	WALL PROTECTION
WSC	WOOD WAINSCOT



ARCHITECTURE ENGINEERING PLANNING
 SMART
 144 Fore Street/P.O. Box 618
 Portland, Maine 04104
 tel. (207) 772-3846
 fax. (207) 772-1070

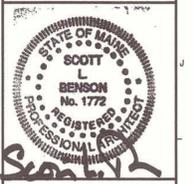

PROJECT TITLE:
 MAINE TURNPIKE AUTHORITY
 ADMINISTRATION BUILDING
 PORTLAND, MAINE
 CURRENT ISSUE STATUS:
 ISSUED FOR BIDDING/CONSTRUCTION
 7-9-07

REV	DESCRIPTION	DATE
0	BIDDING/CONSTRUCTION	7-9-07

GRAPHIC SCALE:	1"
SCALE:	AS NOTED
PROJECT MANAGER:	SLB
JC/DRAWN BY:	TCM/TCM
A/E OF RECORD:	SLB
CAD FILE:	AE601-06016
PROJECT NO:	06016
DATE:	7-9-07

SHEET TITLE:
FIRST FLOOR ROOM FINISH SCHEDULE
 SHEET No. **AE601**
© copyright 2007 S.M. S.M. R.T.

AS BUILT
 Owner Copy

A1	FIRST FLOOR ROOM FINISH SCHEDULE
NONE	-

SECOND FLOOR ROOM FINISH SCHEDULE

ROOM NUMBER	ROOM NAME	FLOOR	BASE	WALLS				CEILING		ROOM NUMBER	REMARKS
				NORTH	SOUTH	EAST	WEST	MATERIAL	HEIGHT		
201a	HALL	STONE/CPT	WD	WDP	WDP	WDP	WDP	GWB/ACT	9'-6"/8'-6"	201a	
201b	HALL	STONE	WD	WDP	WDP	WDP	WDP	GWB/ACT	9'-6"/8'-6"	201b	
201c	STORAGE	CONC	RES	GWB	GWB	GWB	GWB	GWB	7'-6"	201c	→ Lux
201d	ALCOVE	STONE	WD	VWC	VWC	WDP	VWC	ACT	9'-0"	201d	
202	MEN'S TOILET	CT	CT	CT/GWB	CT/GWB	CT/GWB	CT/GWB	ACT	9'-0"	202	
203	WOMEN'S TOILET	CT	CT	CT/GWB	CT/GWB	CT/GWB	CT/GWB	ACT	9'-0"	203	
204	STAIR	RUBBER	RES	GWB	GWB	GWB	GWB	EXP	N/A	204	
205	STAIR	RUBBER	RES	GWB	GWB	GWB	GWB	EXP	N/A	205	
206	T/D	VCT	RES	GWB	GWB	GWB	GWB	EXP.	N/A	206	→ Accto
207	ELEC.	VCT	RES	GWB	GWB	GWB	GWB	EXP.	N/A	207	
208	JAN.	VCT	RES	FRP	FRP	FRP	FRP	GWB	8'-0"	208	
209	SUPP.	VCT	RES	GWB	GWB	GWB	GWB	GWB	8'-0"	209	
210	LOBBY	STONE	WD	WDP*	WDP*	WDP*	WDP*	GWB/ACT	9'-6"/8'-6"	210	*SEE FINISH NOTE 3
211	VESTIBULE	STONE	WD	SF*	SF*	SF*	SF*	GWB	10'-8"	211	*SEE FINISH NOTE 3
212	RECEPT.	CPT	RES	GWB*	GWB*	GWB*	GWB*	ACT	9'-0"	212	*SEE FINISH NOTE 3
213	CONFERENCE ROOM	CPT	WD	GWB/RAIL*	GWB/RAIL*	GWB/RAIL*	GWB/RAIL*	ACT	9'-0"	213	*SEE FINISH NOTE 3
214	WAITING	CPT	WD	WDP*	WDP*	WDP*	WDP*	GWB/ACT	9'-6"/8'-6"	214	
215	WAITING	CPT	WD	WDP*	WDP*	WDP*	WDP*	GWB/ACT	9'-6"/8'-6"	215	
216	C.S. LOBBY	STONE	WD	GWB/WSC	GWB/WSC	GWB/WSC	GWB/WSC	ACT	9'-0"	216	
217	HEARING	CPT	WD	GWB/RAIL	GWB/RAIL	GWB/RAIL	GWB/RAIL	ACT	9'-0"	217	
218	HEARING	CPT	WD	GWB/RAIL	GWB/RAIL	GWB/RAIL	GWB/RAIL	ACT	9'-0"	218	
219	CUSTOMER SERVICE	CPT	RES	GWB	GWB	GWB	GWB	ACT	9'-0"	219	
220	NOTICE MAILING	VCT	RES	GWB	GWB	GWB	GWB	ACT	9'-0"	220	
221	VAULT	CPT	RES	GWB	GWB	GWB	GWB	ACT	9'-0"	221	
222	CORR.	CPT	RES	GWB	GWB	GWB	GWB	ACT	9'-0"	222	
223	OPEN OFFICE	CPT	RES	GWB	GWB	GWB	GWB	ACT	9'-0"	223	→ 8'-4" RFI-279
224	OPEN OFFICE	CPT	RES	-	-	GWB	GWB	ACT	8'-0"	224	8'-4" RFI-279
225	OPEN OFFICE	CPT	RES	GWB	GWB	GWB	GWB	ACT	9'-0"	225	8'-4" RFI-279
226	CORR.	CPT	RES	GWB	GWB	GWB	GWB	ACT	9'-0"	226	
227	VIOLATION REVIEW	CPT	RES	GWB	GWB	GWB	GWB	ACT	9'-0"	227	
228	OFFICE	CPT	RES	GWB	GWB	GWB	GWB	ACT	9'-0"	228	
229	CONFERENCE	CPT	WD	GWB/RAIL	GWB/RAIL	GWB/RAIL	GWB/RAIL	ACT/GWB	8'-0"	229	
230	CONFERENCE	CPT	WD	GWB/RAIL	GWB/RAIL	GWB/RAIL	GWB/RAIL	ACT/GWB	8'-0"	230	
231	STOR.	CPT	RES	GWB	GWB	GWB	GWB	ACT	8'-0"	231	
232	STOR.	CPT	RES	GWB	GWB	GWB	GWB	ACT	8'-0"	232	
233	FILE STORAGE	VCT	RES	GWB	GWB	GWB	GWB	ACT	9'-0"	233	
234	CORR.	CPT	RES	GWB	GWB	GWB	GWB	ACT	9'-0"	234	
235	KITCHEN	VCT	RES	GWB	GWB	GWB	GWB	ACT	9'-0"	235	
236	EQUIPMENT	SDVCT	RES	GWB	GWB	GWB	GWB	ACT	9'-0"	236	
237	COMMUNICATIONS	CPT	RES	GWB	GWB	GWB	GWB	ACT	9'-0"	237	
238	TOILET	CT	CT	CT/GWB	CT/GWB	CT/GWB	CT/GWB	ACT	8'-0"	238	
239	OFFICE	CPT	RES	GWB	GWB	GWB	GWB	ACT	9'-0"	239	
240	ANTE-ROOM	CPT	RES	GWB	GWB	GWB	GWB	ACT	9'-0"	240	
241	OPEN OFFICE	CPT	RES	GWB	GWB	GWB	GWB	ACT	9'-0"	241	
242	FILE STORAGE	VCT	RES	GWB	GWB	GWB	GWB	ACT	9'-0"	242	
243	HALL	CPT	RES	-	GWB	-	GWB	ACT	9'-0"	243	
244	OFFICE	CPT	RES	GWB	GWB	GWB	GWB	ACT	9'-0"	244	
245	OFFICE	CPT	RES	GWB	GWB	GWB	GWB	ACT	9'-0"	245	
246	NOT USED	-	-	-	-	-	-	-	-	246	
247	WAITING	CPT	RES	GWB	GWB	GWB	GWB	ACT	9'-0"	247	
248	OPEN OFFICE	CPT	RES	-	GWB	GWB	GWB	ACT	9'-0"	248	
249	OFFICE	CPT	RES	GWB	GWB	GWB	GWB	ACT	9'-0"	249	
250	OFFICE	CPT	RES	GWB	GWB	GWB	GWB	ACT	9'-0"	250	
251	CORR.	CPT	RES	GWB	GWB	GWB	GWB	ACT	9'-0"	251	
252	OFFICE	CPT	RES	GWB	GWB	GWB	GWB	ACT	9'-0"	252	
253	FILE STORAGE	VCT	RES	GWB	GWB	GWB	GWB	ACT	9'-0"	253	
254	OFFICE	CPT	RES	GWB	GWB	GWB	GWB	ACT	9'-0"	254	
255	CORRIDOR	CPT	RES	GWB	GWB	-	GWB	ACT	9'-0"	255	
256	CLOSET	STONE	WD	GWB	GWB	GWB	GWB	GWB	8'-0"	256	
257	COPY/MAIL	VCT	RES	GWB	GWB	GWB	GWB	ACT	9'-0"	257	

GENERAL NOTES:

- SEE G1001 FOR PROJECT GENERAL NOTES.

FINISH NOTES:


- SEE SPECIFICATIONS FOR ADDITIONAL INFORMATION REGARDING FINISH MATERIALS.
- REFER TO PARTITION LEGEND FOR TYPE OF GWB COMPOSITION REQUIRED. "ABUSE RESISTANT", "MOISTURE RESISTANT" OR OTHER (TYPICAL).
- REFER TO INTERIOR ELEVATIONS FOR MORE INFORMATION ON MATERIAL LOCATIONS

FINISH ABBREVIATIONS:

ACT	ACOUSTICAL CEILING TILE
CONC	CONCRETE, SEALED
CEM	CEMENT BOARD
CPT	CARPET
CT	CERAMIC TILE
EXP	EXPOSED STRUCTURE
FRP	FIBERGLASS REINFORCED PANEL
GWB	GYPSUM WALLBOARD, PAINTED
INS	INSULATED
MAT	WALK-OFF MAT
PF	PRE-FINISHED BY MANUFACTURER
PLM	PLASTIC LAMINATE
PTD	PAINTED
QT	QUARRY TILE
RB	RUBBER BASE
RCP	REFLECTED CEILING PLAN
RES	RESILIENT BASE
SF	STOREFRONT (ALUMINUM)
SV	SHEET VINYL
VCT	VINYL COMPOSITION TILE
VWC	VINYL WALL COVERING
WD	WOOD
WDP	WOOD PANELING
WP	WALL PROTECTION
WSC	WOOD WAINSCOT



ARCHITECTURE ENGINEERING PLANNING
SMRT
144 Fore Street, P.O. Box 618
Portland, Maine 04104
tel. (207) 772-3846
fax. (207) 772-1070

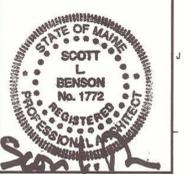

PROJECT TITLE:
MAINE TURNPIKE AUTHORITY
ADMINISTRATION BUILDING
PORTLAND, MAINE
CURRENT ISSUE STATUS:
ISSUED FOR BIDDING/CONSTRUCTION
7-9-07

REV	DESCRIPTION	DATE
0	BIDDING/CONSTRUCTION	7-9-07

GRAPHIC SCALE:
0" 1"
SCALE: AS NOTED
PROJECT MANAGER: SLB
JC/DRAWN BY: TCM/TCM
A/E OF RECORD: SLB
CAD FILE: AE602-06016
PROJECT NO: 06016
DATE: 7-9-07
SHEET TITLE:

SECOND FLOOR ROOM FINISH SCHEDULE
SHEET No. AE602

A1 SECOND FLOOR ROOM FINISH SCHEDULE

AS BUILT
Owner Copy

THIRD FLOOR ROOM FINISH SCHEDULE

ROOM NUMBER	ROOM NAME	FLOOR	BASE	WALLS				CEILING		ROOM NUMBER	REMARKS
				NORTH	SOUTH	EAST	WEST	MATERIAL	HEIGHT		
301	GALLERY	CPT	WD	GWB/WSC	GWB/WSC	GWB/WSC	GWB/WSC	GWB/ACT	9'-6"/8'-6"	301	Wall Board Softies @ 8'-6" Acoustical @ 9'-6" RFI-273
301a	ALCOVE	CPT	WD	VWC	VWC	VWC/WSC	VWC	ACT	9'-0"	301a	
302	MEN'S TOILET	CT	CT	CT/GWB	CT/GWB	CT/GWB	CT/GWB	ACT	9'-0"	302	
303	WOMEN'S TOILET	CT	CT	CT/GWB	CT/GWB	CT/GWB	CT/GWB	ACT	9'-0"	303	lux
304	STAIR	RUBBER	RES	GWB	GWB	GWB	GWB	EXP	N/A	304	
305	STAIR	RUBBER	RES	GWB	GWB	GWB	GWB	EXP	N/A	305	
306	TEL./DATA	VCT	RES	GWB	GWB	GWB	GWB	EXP	N/A	306	Accto
307	ELEC.	VCT	RES	GWB	GWB	GWB	GWB	EXP	N/A	307	
308	JAN.	VCT	RES	FRP	FRP	FRP	FRP	GWB	8'-0"	308	
309	SUPPLIES	VCT	RES	GWB	GWB	GWB	GWB	GWB	8'-0"	309	
310	AUTHORITY ROOM	CPT	WD	GWB/WSC	GWB/WSC	GWB/WSC	GWB/WSC	GWB/ACT*	9'-6"/8'-6"	310	*SEE WALL SECTIONS
311	CLOSET	CPT	RES	GWB	GWB	GWB	GWB	GWB	8'-0"	311	
312	CLOSET	CPT	RES	GWB	GWB	GWB	GWB	GWB	8'-0"	312	
313	CORRIDOR	CPT	RES	GWB	GWB	GWB	GWB	ACT	9'-0"	313	
314	KITCHEN	VCT	RES	GWB	GWB	GWB	GWB	ACT	9'-0"	314	
315	STORAGE	CPT	RES	GWB	GWB	GWB	GWB	ACT	9'-0"	315	
316	OFFICE	CPT	RES	GWB	GWB	GWB	GWB	ACT	9'-0"	316	
317	OPEN OFFICE	CPT	RES	GWB	GWB	GWB	GWB	ACT	9'-0"	317	
318	OFFICE	CPT	RES	GWB	GWB	GWB	GWB	ACT	9'-0"	318	
319	WAIT	CPT	RES	-	GWB	GWB	GWB	ACT	9'-0"	319	
320	OFFICE	CPT	RES	GWB	GWB	GWB	GWB	ACT	9'-0"	320	
321	OFFICE	CPT	RES	GWB	GWB	GWB	GWB	ACT	9'-0"	321	
322	OPEN OFFICE	CPT	RES	GWB	GWB	GWB	GWB	ACT	9'-0"	322	
323	VAULT	VCT	RES	GWB	GWB	GWB	GWB	ACT	9'-0"	323	
324	OPEN OFFICE	CPT	RES	-	GWB	GWB	GWB	ACT	9'-0"	324	
325	COPY	VCT	RES	GWB	GWB	GWB	GWB	ACT	9'-0"	325	
326	OPEN OFFICE	CPT	RES	GWB	GWB	GWB	GWB	ACT	9'-0"	326	
327	CORRIDOR	CPT	RES	GWB	GWB	GWB	GWB	ACT	9'-0"	327	
328	TEST	CPT	RES	GWB	GWB	GWB	GWB	ACT	9'-0"	328	
329	AUDIT	CPT	RES	GWB	GWB	GWB	GWB	ACT	9'-0"	329	
330	WAITING	CPT	RES	GWB	GWB	GWB	GWB	ACT	9'-0"	330	
331	OPEN OFFICE	CPT	RES	GWB	GWB	GWB	GWB	ACT	9'-0"	331	
332	FILES	VCT	RES	GWB	GWB	GWB	GWB	ACT	9'-0"	332	
333	OFFICE	CPT	RES	GWB	GWB	GWB	GWB	ACT	9'-0"	333	
334	OFFICE	CPT	RES	GWB	GWB	GWB	GWB	ACT	9'-0"	334	
335	OPEN OFFICE	CPT	RES	GWB	GWB	GWB	GWB	ACT	9'-0"	335	7'-8 1/2" RFI-280
336	CORRIDOR	CPT	RES	GWB	GWB	GWB	GWB	ACT	9'-0"	336	
337	FILE STORAGE	VCT	RES	GWB	GWB	GWB	GWB	ACT	9'-0"	337	
338	CONFERENCE	CPT	WD	GWB/RAIL	GWB/RAIL	GWB/RAIL	GWB/RAIL	ACT	9'-0"	338	
339	OPEN OFFICE	CPT	RES	GWB	GWB	GWB	GWB	ACT	9'-0"	339	7'-8 1/2" RFI-280
340	OFFICE	CPT	RES	GWB	GWB	GWB	GWB	ACT	9'-0"	340	
341	OFFICE	CPT	RES	GWB	GWB	GWB	GWB	ACT	9'-0"	341	
342	OFFICE	CPT	RES	GWB	GWB	GWB	GWB	ACT	9'-0"	342	
343	LAYOUT	CPT	RES	GWB	GWB	-	GWB	ACT	9'-0"	343	7'-8 1/2" RFI-280
344	OPEN OFFICE	CPT	RES	GWB	GWB	GWB	-	ACT	9'-0"	344	
345	CONFERENCE	CPT	WD	GWB/RAIL	GWB/RAIL	GWB/RAIL	GWB/RAIL	ACT	9'-0"	345	8'-6" RFI-280 + RFI 348
346	OFFICE	CPT	WD	GWB/RAIL	GWB/RAIL	GWB/RAIL	GWB/RAIL	GWB/ACT	9'-0"	346	7'-8 1/2" RFI-280
347	TOILET	CT	CT	GWB/CT	GWB/CT	GWB/CT	GWB/CT	ACT	8'-0"	347	7'-8 1/2" RFI-280
348	STOR.	CPT	RES	GWB	GWB	GWB	GWB	ACT	9'-0"	348	7'-8 1/2" RFI-280
349	OPEN OFFICE	CPT	WD	GWB/RAIL	GWB/RAIL	GWB/RAIL	GWB/RAIL	ACT	9'-0"	349	8'-6" RFI-280
350	CLOSET	CPT	RES	GWB	GWB	GWB	GWB	GWB	9'-0"	350	
351	OFFICE	CPT	RES	GWB	GWB	-	GWB	ACT	9'-0"	351	
352	CORRIDOR	CPT	RES	GWB	GWB	GWB	GWB	ACT	9'-0"	352	
353	OFFICE	CPT	RES	GWB	GWB	GWB	GWB	ACT	9'-0"	353	
354	CORRIDOR	CPT	RES	GWB	GWB	GWB	GWB	ACT	9'-0"	354	

GENERAL NOTES:

- SEE 61001 FOR PROJECT GENERAL NOTES.

FINISH NOTES:

- SEE SPECIFICATIONS FOR ADDITIONAL INFORMATION REGARDING FINISH MATERIALS.
- REFER TO PARTITION LEGEND FOR TYPE OF GWB COMPOSITION REQUIRED. "ABUSE RESISTANT", "MOISTURE RESISTANT" OR OTHER (TYPICAL).
- REFER TO INTERIOR ELEVATIONS FOR MORE INFORMATION ON MATERIAL LOCATIONS


FINISH ABBREVIATIONS:

ACT	ACOUSTICAL CEILING TILE
CONC	CONCRETE, SEALED
CEM	CEMENT BOARD
CPT	CARPET
CT	CERAMIC TILE
EXP	EXPOSED STRUCTURE
FRP	FIBERGLASS REINFORCED PANEL
GWB	GYPSONUM WALLBOARD, PAINTED
INS	INSULATED
MAT	WALK-OFF MAT
PF	PRE-FINISHED BY MANUFACTURER
PLM	PLASTIC LAMINATE
PTD	PAINTED
QT	QUARRY TILE
RB	RUBBER BASE
RCP	REFLECTED CEILING PLAN
RES	RESILIENT BASE
SF	STOREFRONT (ALUMINUM)
SV	SHEET VINYL
VCT	VINYL COMPOSITION TILE
VWC	VINYL WALL COVERING
WD	WOOD
WDP	WOOD PANELING
WP	WALL PROTECTION
WSC	WOOD WAINSCOT

SM RT

ARCHITECTURE ENGINEERING PLANNING

144 Fore Street/P.O. Box 618
Portland, Maine 04104
tel. (207) 772-3946
fax. (207) 772-1070

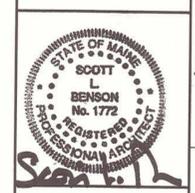

PROJECT TITLE:
**MAINE TURNPIKE AUTHORITY
ADMINISTRATION BUILDING**
PORTLAND, MAINE

CURRENT ISSUE STATUS:
ISSUED FOR BIDDING/CONSTRUCTION
7-9-07

REV	DESCRIPTION	DATE
0	BIDDING/CONSTRUCTION	7-9-07

GRAPHIC SCALE:
0" 1"

SCALE: AS NOTED

PROJECT MANAGER: SLB
JC/DRAWN BY: TCM/TCM
A/E OF RECORD: SLB
CAD FILE: AE603-06016
PROJECT NO: 06016
DATE: 7-9-07
SHEET TITLE:
**THIRD FLOOR
ROOM FINISH
SCHEDULE**
SHEET No. **AE603**

**AS BUILT
Owner Copy**

A1 THIRD FLOOR ROOM FINISH SCHEDULE

NONE - * -

SECOND FLOOR DOOR SCHEDULE

DOOR NUMBER	DOOR				GLAZING	FRAME				HWS	FIRE RATING (MIN.)	DOOR NUMBER	REMARKS
	SIZE	MATERIAL	ELEVATION			MATERIAL	ELEVATION	HEAD	JAMB				
201a	(2) 3'-0" x 7'-0"	ALUM	FG2	TEMP	ALUM	AB	J4/AE626	E4/AE626	A4/AE626	17	-	201a	Access Control RFI-343
201c	3'-0" x 7'-0"	WD2	F	N/A	HM	H1	J10/AE623	E10/AE623	-	14	45	201c	DELETE KICK PLATE
202	3'-0" x 7'-0"	WD2	F	N/A	HM	H1	J1/AE623 SIM	E1/AE623 SIM	-	2	-	202	
203	3'-0" x 7'-0"	WD2	F	N/A	HM	H1	J1/AE623 SIM	E1/AE623 SIM	-	2	-	203	
204	3'-0" x 7'-0"	WD1	NL	WIRE	HM	H1	J1/AE623	E1/AE623	-	3	60	204	
205	3'-0" x 7'-0"	WD1	NL	WIRE	HM	H1	J1/AE623	E1/AE623	-	3	60	205	
206	3'-0" x 7'-0"	WD1	F	N/A	HM	H1	J1/AE623	E1/AE623	-	13	-	206	
207	3'-0" x 7'-0"	WD1	F	N/A	HM	H1	J1/AE623	E1/AE623	-	13	-	207	
208	2'-8" x 7'-0"	WD1	F	N/A	HM	H1	J1/AE623	E1/AE623	-	13	-	208	
209	2'-8" x 7'-0"	WD1	F	N/A	HM	H1	J1/AE623	E1/AE623	-	5	-	209	Revise Locksets SI 84
210	(2) 3'-0" x 7'-0"	ALUM	FG2	INS/TEMP	ALUM	AB	J4/AE626	E4/AE626	A4/AE626	18	-	210	
211	(2) 3'-0" x 7'-0"	ALUM	FG2	INS/TEMP	ALUM	A2	J4/AE627	A4/AE628	-	19	-	211	
212	3'-0" x 7'-0"	WD2	HG	TEMP	HM	H1	J1/AE623	E1/AE623	-	8	-	212	
213	3'-0" x 7'-0"	WD2	FG	TEMP	HM	H1	J10/AE623	E10/AE623	-	8	-	213	
216	3'-0" x 7'-0"	WD2	FG	TEMP	HM	H1	J10/AE623	E10/AE623 HI	-	27	-	216	Install Core Reader RFI-341
217a	3'-0" x 7'-0"	WD1	F	N/A	HM	H1	J1/AE623	E1/AE623 HI	-	27	-	217a	
217b	3'-0" x 7'-0"	WD1	HG	TEMP	HM	H1	J1/AE623	E1/AE623 HI	-	21	-	217b	
218a	3'-0" x 7'-0"	WD1	F	N/A	HM	H1	J1/AE623	E1/AE623 HI	-	27	-	218a	
218b	3'-0" x 7'-0"	WD1	HG	TEMP	HM	H1	J1/AE623	E1/AE623 HI	-	21	-	218b	
219	3'-0" x 7'-0"	WD1	HG	TEMP	HM	H1	J1/AE623	E1/AE623	-	21	-	219	
220	3'-0" x 7'-0"	WD1	HG	TEMP	HM	H1	J7/AE623	E7/AE623	-	8	-	220	
221	3'-0" x 7'-0"	WD1	F	N/A	HM	H1	J1/AE623	E1/AE623	-	21	45	221	
222	3'-0" x 7'-0"	WD2	NL	TEMP	HM	H3	J10/AE623	E10/AE623	-	22	-	222	
226	3'-0" x 7'-0"	W1	NL	TEMP	HM	H3	J10/AE623	E10/AE623	-	23	-	226	
227	3'-0" x 7'-0"	WD1	F	N/A	HM	H1	J1/AE623	E1/AE623	-	8	-	227	
228	3'-0" x 7'-0"	WD1	F	N/A	HM	H1	J1/AE623	E1/AE623	-	8	-	228	
229a	3'-0" x 7'-0"	WD2	FG	TEMP	HM	H3	J10/AE623	E10/AE623	-	14	-	229a	
229b	3'-0" x 7'-0"	ALUM	FG	INS/TEMP	ALUM	A1	J1&E4/AE627	E7/AE628 HI	-	27	-	229b	Hardware Scope RFI-342
229c	(2) 2'-6"x9'-6"	HM	F	N/A	HM	H1	J10/AE623	E10/AE623	-	9	-	229c	230b Change Hardware RFI-342
230a	3'-0" x 7'-0"	WD2	FG	TEMP	HM	H3	J1/AE623	E1/AE623	-	14	-	230a	
230	3'-0" x 7'-0"	ALUM	FG	INS/TEMP	ALUM	A1	J1&E4/AE627	E7/AE628 HI	-	27	-	230	
231	3'-0" x 7'-0"	WD1	F	N/A	HM	H1	J1/AE623	E1/AE623	-	8	-	231	
232	3'-0" x 7'-0"	WD1	F	N/A	HM	H1	J1/AE623	E1/AE623	-	8	-	232	
233	3'-0" x 7'-0"	WD1	F	N/A	HM	H1	J1/AE623	E1/AE623	-	14	-	233	
234	3'-0" x 7'-0"	WD2	NL	TEMP	HM	H3	J10/AE623	E10/AE623	-	23	-	234	
235a	3'-0" x 7'-0"	WD1	HG	WIRE	HM	H1	J1/AE623	E1/AE623	-	25	45	235a	
235b	3'-0" x 7'-0"	WD1	F	N/A	HM	H1	J1/AE623	E1/AE623	-	21	45	235b	
236	3'-0" x 7'-0"	WD1	F	N/A	HM	H1	J1/AE623	E1/AE623	-	4	-	236	
237	3'-0" x 7'-0"	WD1	HG	TEMP	HM	H1	J1/AE623	E1/AE623	-	25	-	237	
238	3'-0" x 7'-0"	WD1	F	N/A	HM	H1	J1/AE623	E1/AE623	-	11	-	238	
239	3'-0" x 7'-0"	WD1	F	N/A	HM	H1	J1/AE623	E1/AE623	-	8	-	239	
240	3'-0" x 7'-0"	WD1	FG	TEMP	HM	H1	J1/AE623	E1/AE623	-	21	45	240	
242	3'-0" x 7'-0"	WD1	HG	TEMP	HM	H1	J1/AE623	E1/AE623	-	14	-	242	
244	3'-0" x 7'-0"	WD1	F	N/A	HM	H1	J1/AE623	E1/AE623	-	8	-	244	
245	3'-0" x 7'-0"	WD1	F	N/A	HM	H1	J1/AE623	E1/AE623	-	8	-	245	
249	3'-0" x 7'-0"	WD1	F	N/A	HM	H1	J1/AE623	E1/AE623	-	8	-	249	
250	3'-0" x 7'-0"	WD1	F	N/A	HM	H1	J1/AE623	E1/AE623	-	8	-	250	
251	3'-0" x 7'-0"	WD2	NL	TEMP	HM	H1	J10/AE623	E10/AE623	-	22	-	251	
252	3'-0" x 7'-0"	WD1	F	N/A	HM	H1	J1/AE623	E1/AE623	-	8	-	252	
253	3'-0" x 7'-0"	WD1	NL	TEMP	HM	H1	J1/AE623	E1/AE623	-	14	-	253	
254	3'-0" x 7'-0"	WD1	F	N/A	HM	H1	J1/AE623	E1/AE623	-	8	-	254	
255	3'-0" x 7'-0"	WD2	F	N/A	HM	H1	J10/AE623	E10/AE623	-	21	-	255	
256	2'-6" x 7'-0"	WD2	F	N/A	HM	H1	J10/AE623	E10/AE623	-	24	-	256	
257	3'-0" x 7'-0"	WD1	HG	TEMP	HM	H1	J4/AE624	E4/AE624	-	6	-	257	
258													SEE RFI-308 For info

SI-129
Change to
Wire Glass

GENERAL NOTES:

- SEE G101 FOR PROJECT GENERAL NOTES.
- DOOR NOTES
- ALL SWINGING DOORS TO BE 1-3/4" THICK (U.N.O.).
 - ALL DOORS SHALL BE 3/4" UNDERCUT (TYPICAL) EXCEPT WHEN THERE IS A BOTTOM FRAME, SILL THRESHOLD, WHERE RATED (1/2" UNDERCUT @ RATED LOCATIONS), OR SPECIFICALLY NOTED OTHERWISE.
 - ALL DOORS WITH BOTTOM FRAMES OR SILL THRESHOLDS SHALL HAVE MANUFACTURERS RECOMMENDED STANDARD UNDERCUT.
 - GLAZING NOTED ON DOOR SCHEDULE IS FOR THE DOOR AND SIDELIGHTS IN THE FRAME (TYPICAL).
 - SEE SPECIFICATIONS FOR HARDWARE SET DESCRIPTIONS.

DOOR ABBREVIATIONS

AL/ALUM	ALUMINUM
F	FLUSH
FG	FULL GLAZING
NL	NARROW LIGHT
HG	HALF GLAZING
HM	HOLLOW METAL
INS	INSULATED
STL	STEEL
SS	STAINLESS STEEL
TEMP	TEMPERED GLASS
WIRE	WIRE GLASS
WD1	PLAIN SLICED OAK
WD2	RIFF CUT OAK
LAM	LAMINATED GLASS

RFI-33 Doors + ADA Clearances



ARCHITECTURE ENGINEERING PLANNING
SMRT
144 Fore Street P.O. Box 618
Portland, Maine 04104
Tel: (207) 772-3846
Fax: (207) 772-1070



MAINE TURNPIKE AUTHORITY
ADMINISTRATION BUILDING
PORTLAND, MAINE
ISSUED FOR BIDDING/CONSTRUCTION
7-9-07

PROJECT TITLE:	
CURRENT ISSUE STATUS:	
DATE:	7-9-07
DESCRIPTION:	
REV:	0
GRAPHIC SCALE:	0" = 1"
SCALE:	AS NOTED
PROJECT MANAGER:	SLB
JC/DRAWN BY:	TCM/TCM
A/E OF RECORD:	SLB
CAD FILE:	AE612-06016
PROJECT NO.:	06016
DATE:	7-9-07
SHEET TITLE:	SECOND FLOOR DOOR SCHEDULE
SHEET No.:	AE612

AS BUILT
Owner Copy

A1 SECOND FLOOR DOOR SCHEDULE

NONE - *

THIRD FLOOR DOOR SCHEDULE

DOOR NUMBER	DOOR			FRAME					HWS	FIRE RATING (MIN.)	DOOR NUMBER	REMARKS	
	SIZE	MATERIAL	ELEVATION	GLAZING	MATERIAL	ELEVATION	HEAD	JAMB					SILL
302	3'-0" x 7'-0"	WD2	F	N/A	HM	H1	J1/AE623 SIM	E1/AE623 SIM	-	2	302		
303	3'-0" x 7'-0"	WD2	F	N/A	HM	H1	J1/AE623 SIM	E1/AE623 SIM	-	2	303		
304	3'-0" x 7'-0"	WD1	NL	WIRE	HM	H1	J1/AE623	E1/AE623	-	60	304		
305	3'-0" x 7'-0"	WD1	NL	WIRE	HM	H1	J1/AE623	E1/AE623	-	3	60	305	
306	3'-0" x 7'-0"	WD1	F	N/A	HM	H1	J1/AE623	E1/AE623	-	13	-	306	
307	3'-0" x 7'-0"	WD1	F	N/A	HM	H1	J1/AE623	E1/AE623	-	13	-	307	
308	2'-8" x 7'-0"	WD1	F	N/A	HM	H1	J1/AE623	E1/AE623	-	13	-	308	
309	2'-8" x 7'-0"	WD1	F	N/A	HM	H1	J1/AE623	E1/AE623	-	5	-	309	Revise Locksets SI 84
310a	3'-0" x 7'-0"	WD2	FG	TEMP	HM	H3	J1/AE623	E1/AE623	-	20	-	310a	
310b	3'-0" x 7'-0"	WD2	FG	TEMP	HM	H3	J1/AE623	E1/AE623	-	20	-	310b	Change Hardware. 3/16 RFI=342
310c	3'-0" x 7'-0"	ALUM	FG	INS/TEMP	HM	A1	J1&E4/AE627	E1/AE628	-	16	-	310c	
311	3'-0" x 7'-0"	WD2	F	N/A	HM	H1	J1/AE623	E1/AE623 LO	-	24	-	311	
312	3'-0" x 7'-0"	WD2	LV	N/A	HM	H1	J1/AE623	E1/AE623 HI	-	24	-	312	
313	3'-0" x 7'-0"	WD1	NL	TEMP	HM	H3	J1/AE623	E1/AE623 LO	-	22	-	313	
314a	3'-0" x 7'-0"	WD2	NL	TEMP	HM	H1	J1/AE623	E1/AE623 HI	-	25	-	314a	
314b	3'-0" x 7'-0"	WD2	F	N/A	HM	H1	J7/AE623	E7/AE623 HI	-	25	-	314b	
315	3'-0" x 7'-0"	WD2	F	N/A	HM	H1	J7/AE623	E7/AE623 HI	-	8	-	315	
316	3'-0" x 7'-0"	WD1	F	N/A	HM	H1	J1/AE623	E1/AE623	-	8	-	316	
318	3'-0" x 7'-0"	WD1	F	N/A	HM	H1	J1/AE623	E1/AE623	-	8	-	318	
320	3'-0" x 7'-0"	WD1	F	N/A	HM	H1	J7/AE623	E7/AE623	-	8	-	320	
321	3'-0" x 7'-0"	WD1	F	N/A	HM	H1	J1/AE623	E1/AE623	-	8	-	321	
322	3'-0" x 7'-0"	WD1	FG	TEMP	HM	H1	J1/AE623	E1/AE623	-	8	-	322	
323	3'-0" x 7'-0"	WD1	F	N/A	HM	H1	J1/AE623	E1/AE623	-	21	45	323	
325	3'-0" x 7'-0"	WD1	HG	TEMP	HM	H1	J1/AE623	E1/AE623	-	12	-	325	
327	3'-0" x 7'-0"	WD1	NL	TEMP	M	H3	J1/AE623	E7/AE623 HI	-	23	-	327	
328	3'-0" x 7'-0"	WD1	HG	TEMP	M	H1	J1/AE623	E1/AE623	-	12	-	328	
329	3'-0" x 7'-0"	WD1	HG	TEMP	M	H1	J1/AE623	E1/AE623	-	8	-	329	Cond. Member RFI 345
330	3'-0" x 7'-0"	HM	FG	TEMP	H	H3	J1/AE623	E1/AE623 HI	-	14	-	330	
331	3'-0" x 7'-0"	WD1	HG	TEMP	H	H1	J1/AE623	E1/AE623	-	21	-	331	
332	3'-0" x 7'-0"	WD1	NL	TEMP	H	H1	J1/AE623	E1/AE623	-	14	-	332	
333	3'-0" x 7'-0"	WD1	F	N/A	HM	H1	J1/AE623	E1/AE623	-	8	-	333	
334	3'-0" x 7'-0"	WD1	F	N/A	HM	H1	J1/AE623	E1/AE623	-	8	-	334	
335	3'-0" x 7'-0"	WD1	NL	TEMP	HM	H1	J1/AE623	E1/AE623	-	14	-	335	
336	3'-0" x 7'-0"	WD1	NL	TEMP	HM	H3	J1/AE623	E1/AE623 HI	-	23	-	336	
337	3'-0" x 7'-0"	WD1	F	N/A	HM	H1	J1/AE623	E1/AE623	-	14	-	337	
338	3'-0" x 7'-0"	WD1	HG	TEMP	HM	H1	J1/AE623	E1/AE623	-	8	-	338	
339	3'-0" x 7'-0"	WD1	FG	TEMP	HM	H1	J1/AE623	E1/AE623	-	14	-	339	
340	3'-0" x 7'-0"	WD1	F	N/A	HM	H1	J1/AE623	E1/AE623	-	8	-	340	
341	3'-0" x 7'-0"	WD1	F	N/A	HM	H1	J1/AE623	E1/AE623	-	8	-	341	
342	3'-0" x 7'-0"	WD1	F	N/A	HM	H1	J1/AE623	E1/AE623	-	8	-	342	
345a	3'-0" x 7'-0"	WD1	HG	TEMP	HM	H1	J7/AE623	E7/AE623	-	8	-	345a	
345b	3'-0" x 7'-0"	WD1	F	N/A	HM	H1	J7/AE623	E7/AE623	-	8	-	345b	
346	3'-0" x 7'-0"	WD1	F	N/A	HM	H1	J7/AE623	E7/AE623	-	8	-	346	
347	3'-0" x 7'-0"	WD1	F	N/A	HM	H1	J1/AE623	E1/AE623	-	11	-	347	DELETE KICK PLATE
348	3'-0" x 7'-0"	WD1	F	N/A	HM	H1	J1/AE623	E1/AE623	-	8	-	348	
349	3'-0" x 7'-0"	WD1	FG	TEMP	HM	H1	J4/AE623	E4/AE623	-	14	-	349	
350	3'-0" x 7'-0"	WD1	F	N/A	HM	H1	J1/AE623	E1/AE623	-	24	-	350	
351	3'-0" x 7'-0"	WD1	F	N/A	HM	H1	J1/AE623	E1/AE623	-	8	-	351	
352	3'-0" x 7'-0"	WD2	F	N/A	HM	H1	J7/AE623	E7/AE623 HI	-	8	-	352	DELETE KICK PLATE
353	3'-0" x 7'-0"	WD1	HG	TEMP	HM	H1	J1/AE623	E1/AE623	-	8	-	353	
354	3'-0" x 7'-0"	WD2	NL	TEMP	HM	H3	J1/AE623	E1/AE623 HI	-	23	-	354	

347A
Auxiliary Lockset
SI-85

GENERAL NOTES:

- SEE G101 FOR PROJECT GENERAL NOTES.

DOOR NOTES

- ALL SWINGING DOORS TO BE 1-3/4" THICK (U.N.O.).
- ALL DOORS SHALL BE 3/4" UNDERCUT (TYPICAL) EXCEPT WHEN THERE IS A BOTTOM FRAME, SILL THRESHOLD, WHERE RATED (1/2" UNDERCUT @ RATED LOCATIONS), OR SPECIFICALLY NOTED OTHERWISE.
- ALL DOORS WITH BOTTOM FRAMES OR SILL THRESHOLDS SHALL HAVE MANUFACTURERS RECOMMENDED STANDARD UNDERCUT.
- GLAZING NOTED ON DOOR SCHEDULE IS FOR THE DOOR AND SIDELIGHTS IN THE FRAME (TYPICAL).
- SEE SPECIFICATIONS FOR HARDWARE SET DESCRIPTIONS.

DOOR ABBREVIATIONS

AL/ALUM	ALUMINUM
F	FLUSH
FG	FULL GLAZING
NL	NARROW LIGHT
HG	HALF GLAZING
HM	HOLLOW METAL
INS	INSULATED
STL	STEEL
SS	STAINLESS STEEL
TEMP	TEMPERED GLASS
WIRE	WIRE GLASS
WD1	PLAIN SLICED OAK
WD2	RIFF CUT OAK
LAM	LAMINATED GLASS

RFI-33 Doors & ADA Clearances



ARCHITECTURE ENGINEERING PLANNING
SKIRT
144 Fore Street/P.O. Box 618
Portland, Maine 04104
Tel. (207) 772-3846
Fax. (207) 772-1070



PROJECT TITLE: MAINE TURNPIKE AUTHORITY ADMINISTRATION BUILDING PORTLAND, MAINE
CURRENT ISSUE STATUS: ISSUED FOR BIDDING/CONSTRUCTION 7-9-07

REV	DESCRIPTION	DATE
0	BIDDING/CONSTRUCTION	7-9-07

GRAPHIC SCALE: 0" = 1"
SCALE: AS NOTED
PROJECT MANAGER: SLB
JC/DRAWN BY: TCM/TCM
A/E OF RECORD: SLB
CAD FILE: AE613-06016
PROJECT NO: 06016
DATE: 7-9-07

SHEET TITLE: THIRD FLOOR DOOR SCHEDULE
SHEET No. AE613

AS BUILT
Owner Copy

A1 THIRD FLOOR DOOR SCHEDULE

NONE

GENERAL NOTES:


1. SEE G101 FOR PROJECT GENERAL NOTES.

GLAZING TYPES:

- VISION GLAZING PANEL
- SPANDREL GLAZING PANEL

**SMT
RT**

ARCHITECTURE ENGINEERING PLANNING
SMART
144 Fore Street/P.O. Box 618
Portland, Maine 04104
tel. (207) 772-3846
fax. (207) 772-1070

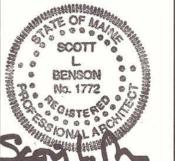

PROJECT TITLE: MAINE TURNPIKE AUTHORITY
ADMINISTRATION BUILDING
PORTLAND, MAINE
CURRENT ISSUE STATUS: ISSUED FOR BIDDING/CONSTRUCTION
7-9-07

REV	DESCRIPTION	DATE
0	BIDDING/CONSTRUCTION	7-9-07

GRAPHIC SCALE:



SCALE: AS NOTED

PROJECT MANAGER: SLB

JC/DRAWN BY: TCM/TCM

A/E OF RECORD: SLB

CAD FILE: AE621-08016


PROJECT NO: 06016

DATE: 7-9-07

SHEET TITLE:

DOOR & WINDOW ELEVATIONS


SHEET No. AE621

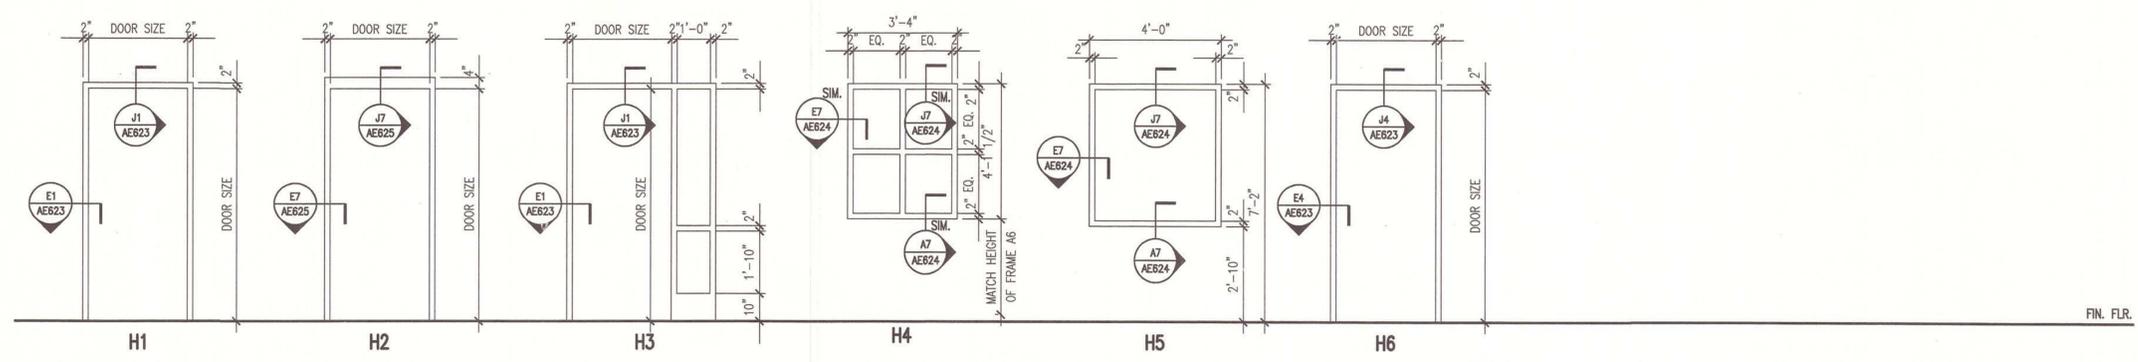

FIN. FLR.

J1 HOLLOW METAL FRAME ELEVATIONS


3/8" = 1'-0"

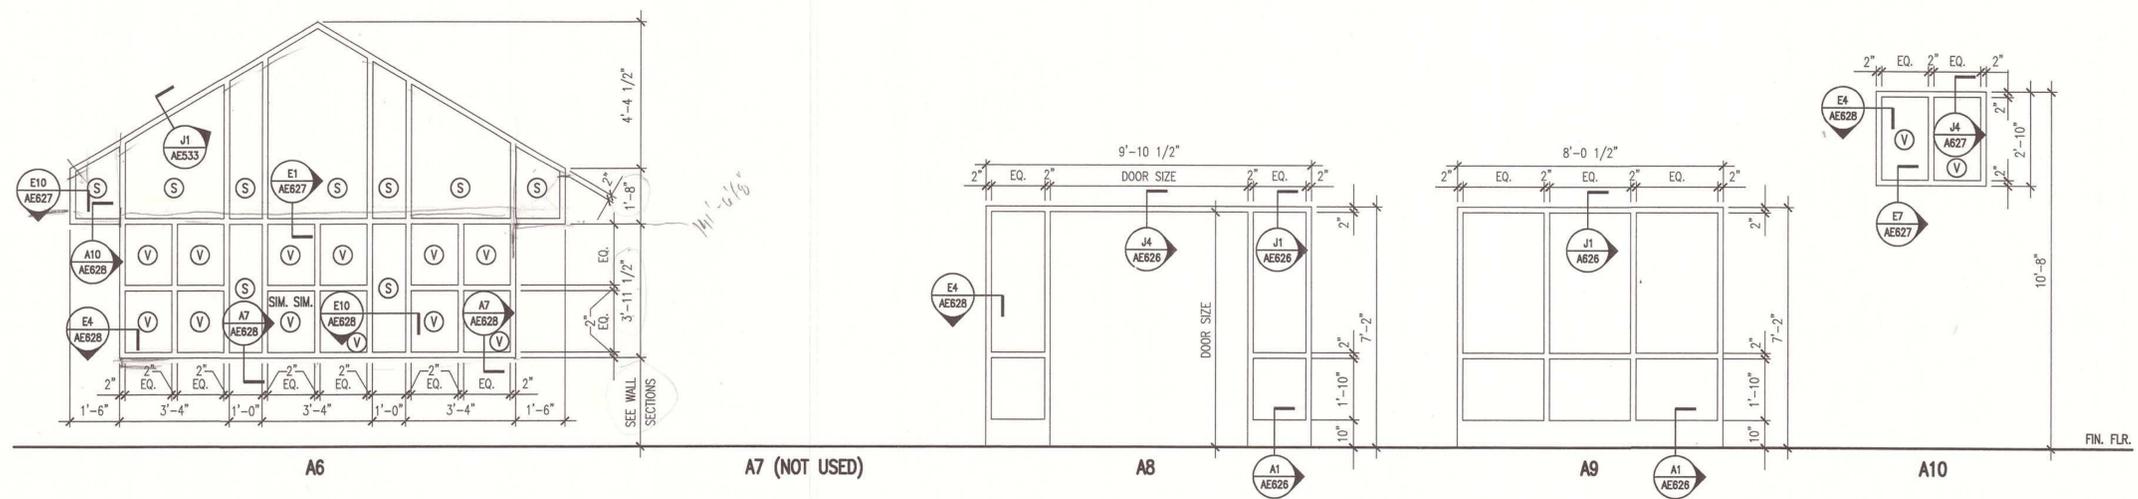

FIN. FLR.

E1 ALUMINUM FRAME ELEVATIONS

3/8" = 1'-0"

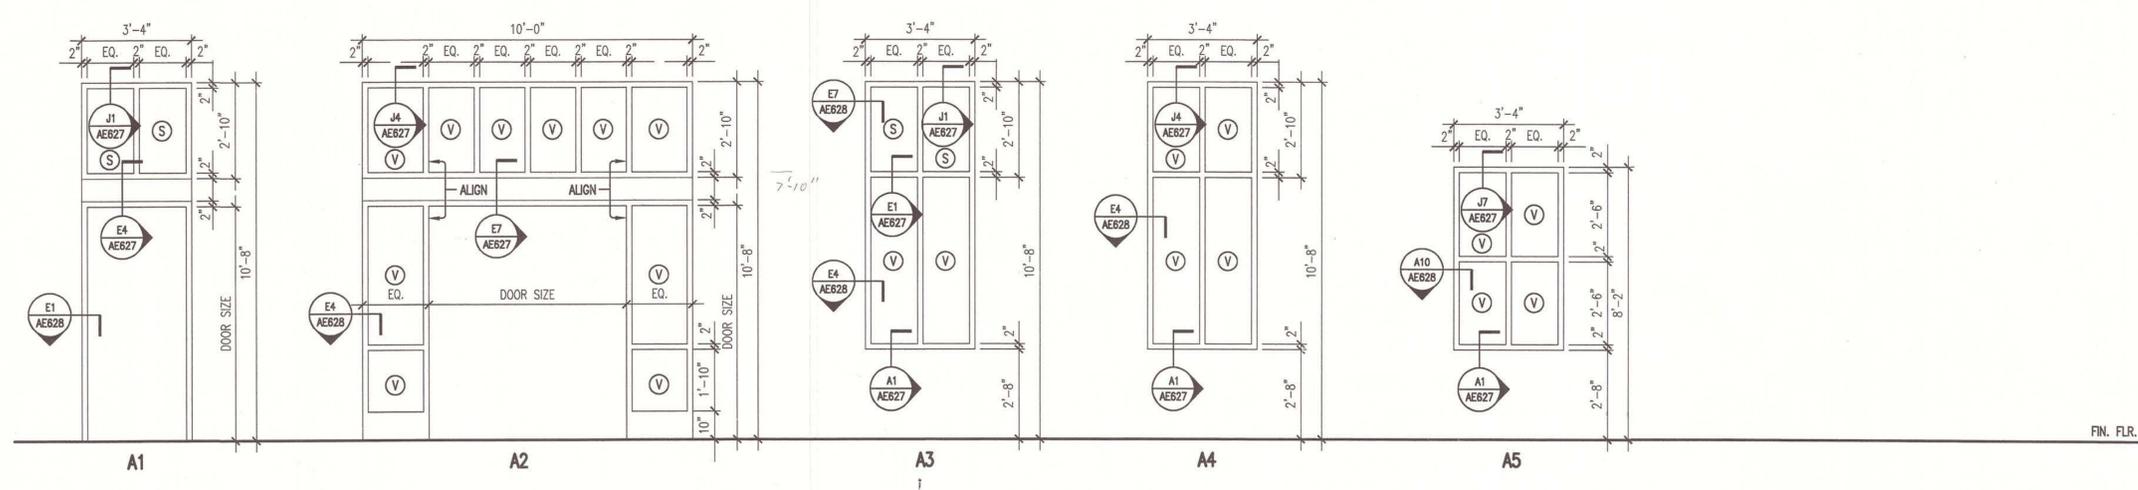

FIN. FLR.

A1 ALUMINUM FRAME ELEVATIONS

3/8" = 1'-0"

AS BUILT
Owner Copy

GENERAL NOTES:

1. SEE G1001 FOR PROJECT GENERAL NOTES.

**SM
SRT**

ARCHITECTURE ENGINEERING PLANNING
SMRT

144 Fore Street/P.O. Box 618
Portland, Maine 04104
tel. (207) 772-3866
fax. (207) 772-1070



PROJECT TITLE:
**MAINE TURNPIKE AUTHORITY
ADMINISTRATION BUILDING**
PORTLAND, MAINE

CURRENT ISSUE STATUS:
**ISSUED FOR BIDDING/CONSTRUCTION
7-9-07**

REV	DESCRIPTION	DATE
0	BIDDING/CONSTRUCTION	7-9-07

GRAPHIC SCALE:
0" = 1"

SCALE: AS NOTED

PROJECT MANAGER: SLB

JC/DRAWN BY: TCM/TCM

A/E OF RECORD: SLB

CAD FILE: AE622-06016


PROJECT NO: 06016

DATE: 7-9-07

SHEET TITLE:
**DOOR & WINDOW
ELEVATIONS**


SHEET No. **AE622**

**AS BUILT
Owner Copy**

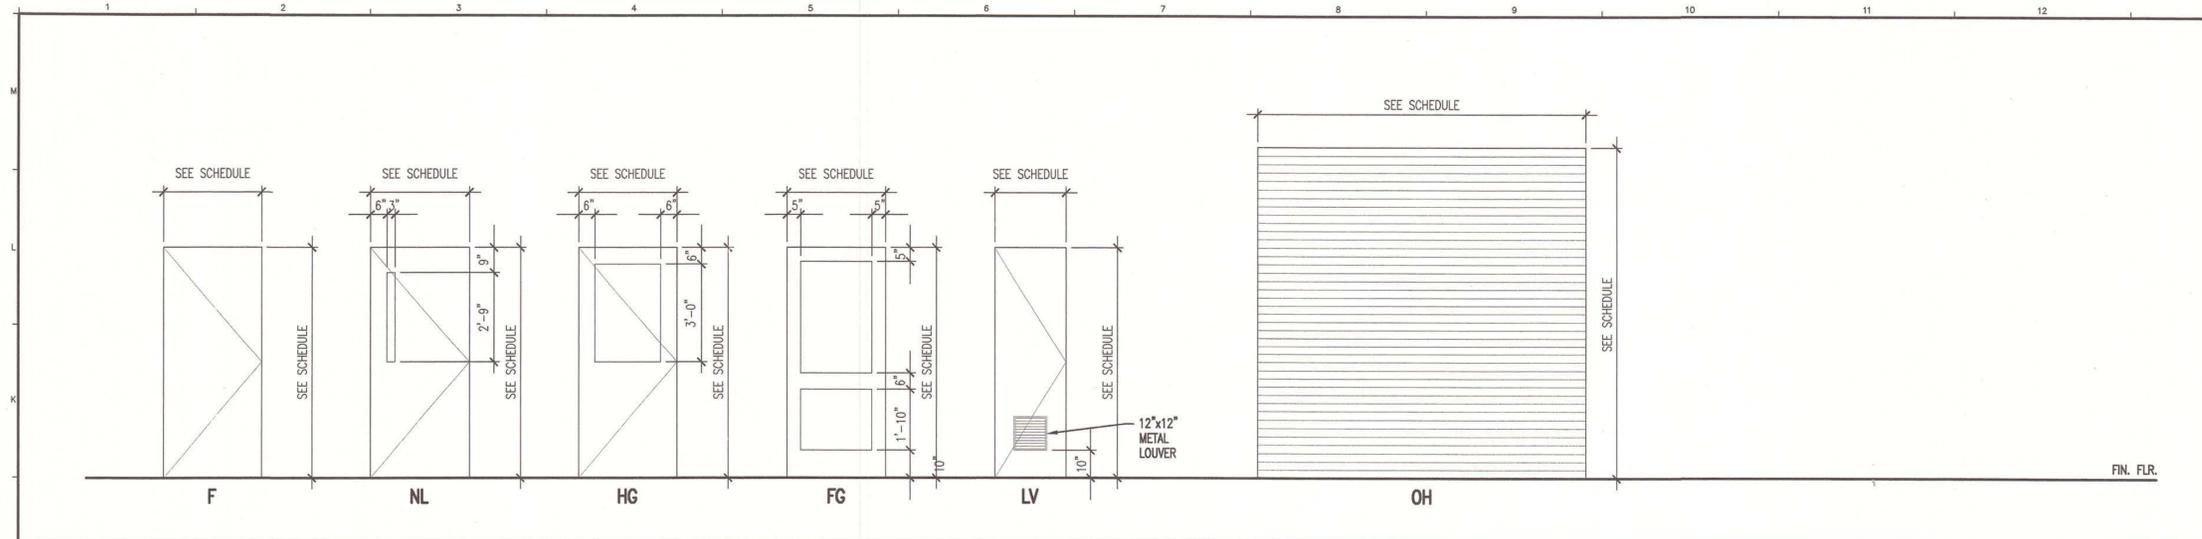


J1 DOOR TYPE ELEVATIONS

3/8" = 1'-0"

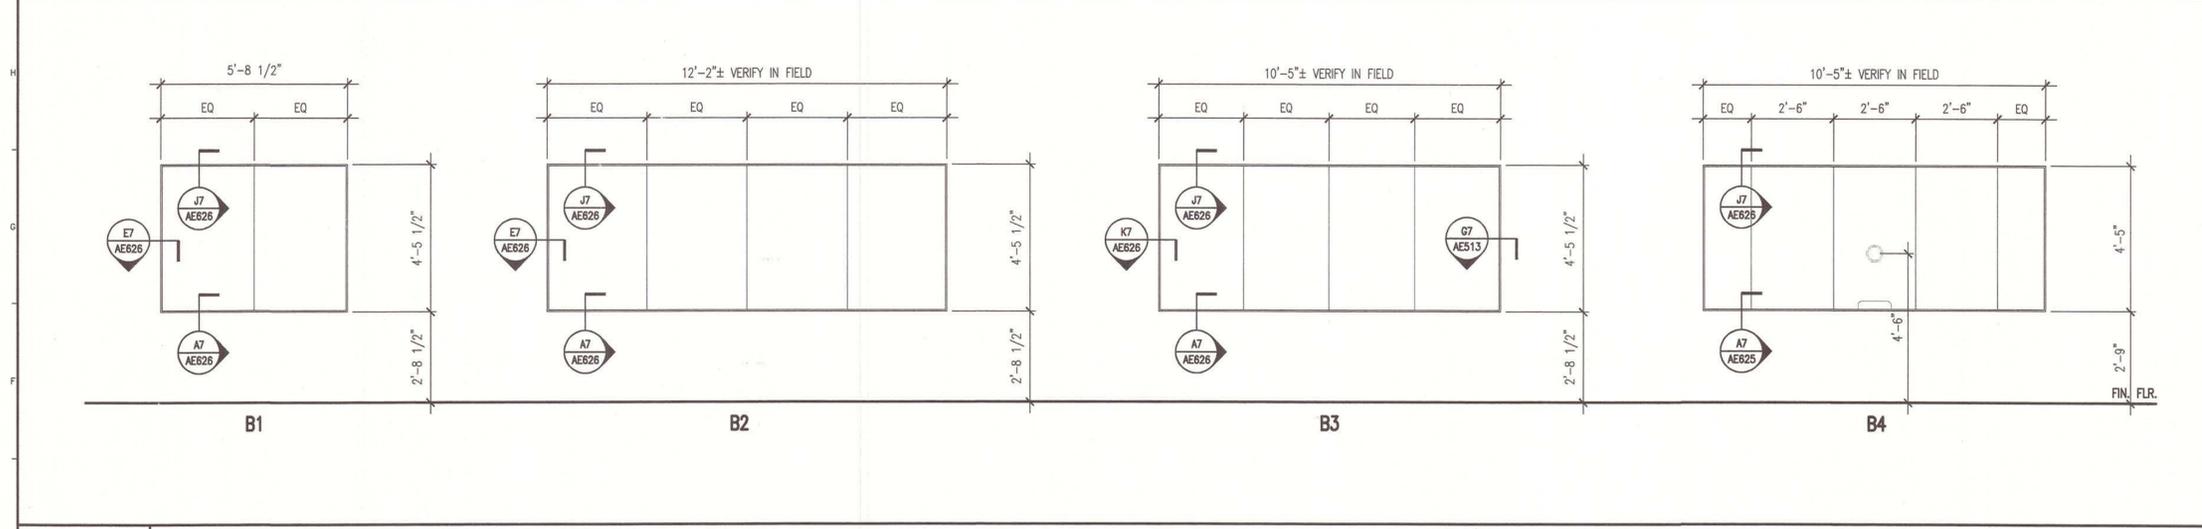

E1 BUTT-GLAZED FRAME ELEVATIONS

3/8" = 1'-0" AE102

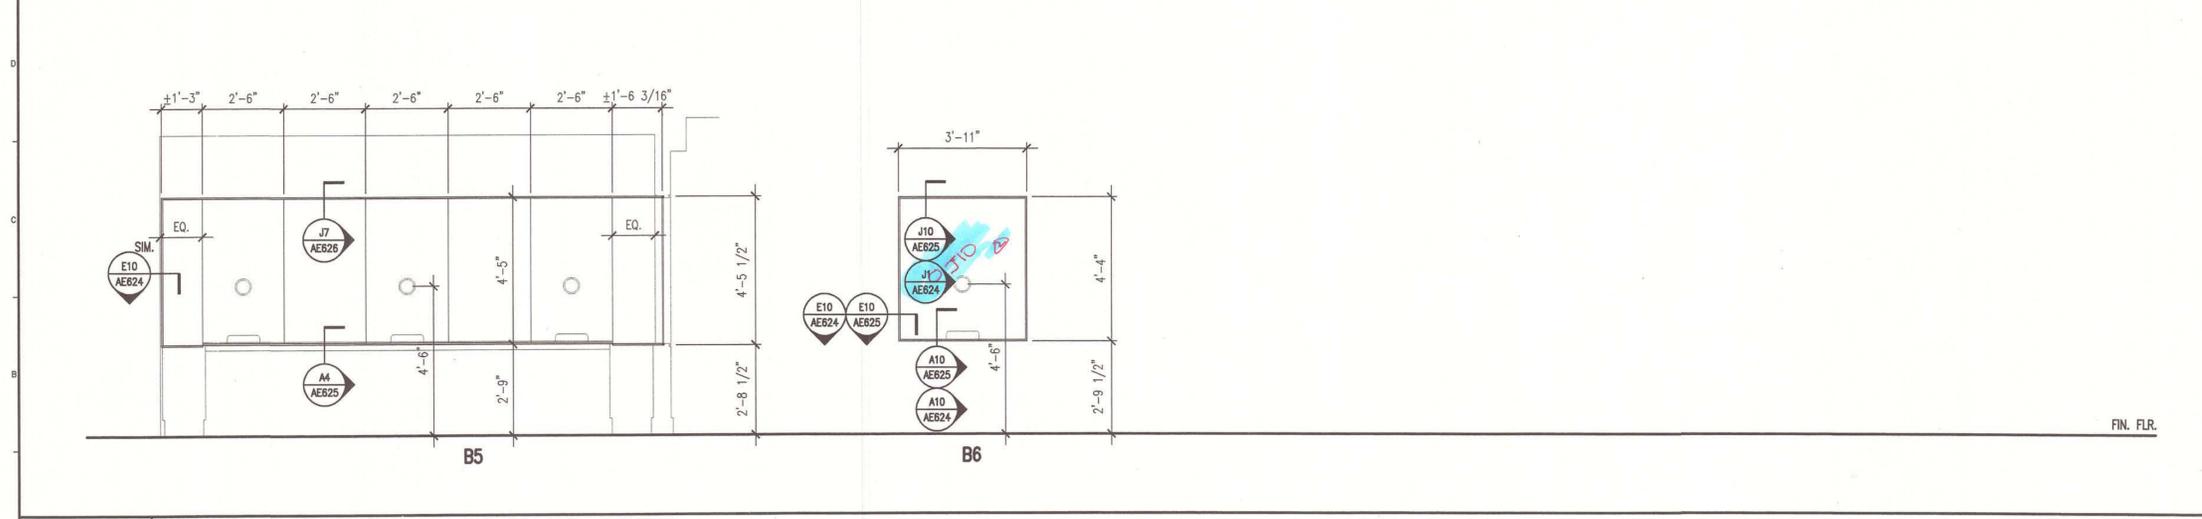

A1 BUTT-GLAZED FRAME ELEVATIONS


3/8" = 1'-0" AE101, AE102 & AE103

GENERAL NOTES:

1. SEE 61001 FOR PROJECT GENERAL NOTES.

**SM
RT**

ARCHITECTURE ENGINEERING PLANNING
SMRT
144 Fore Street, P.O. Box 618
Portland, Maine 04104
tel. (207) 772-3846
fax. (207) 772-1070

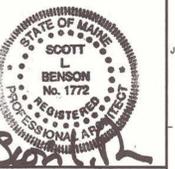

PROJECT TITLE:
**MAINE TURNPIKE AUTHORITY
ADMINISTRATION BUILDING**
PORTLAND, MAINE

CURRENT ISSUE STATUS:
**ISSUED FOR BIDDING/CONSTRUCTION
7-9-07**

REV	DESCRIPTION	DATE
0	BIDDING/CONSTRUCTION	7-9-07





GRAPHIC SCALE:
0" = 1"

SCALE: AS NOTED
PROJECT MANAGER: SLB
J/C/DRAWN BY: TCM/TCM
A/E OF RECORD: SLB
CAD FILE: AE623-06016
PROJECT NO.: 06016
DATE: 7-9-07

SHEET TITLE:
**DOOR & WINDOW
DETAILS**

SHEET No.
AE623

**AS BUILT
Owner Copy**

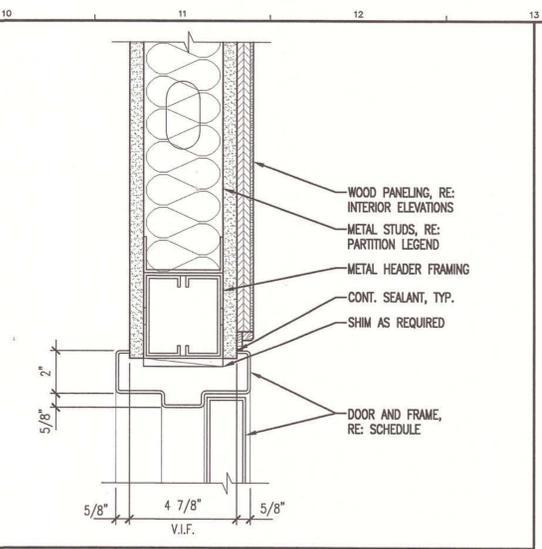
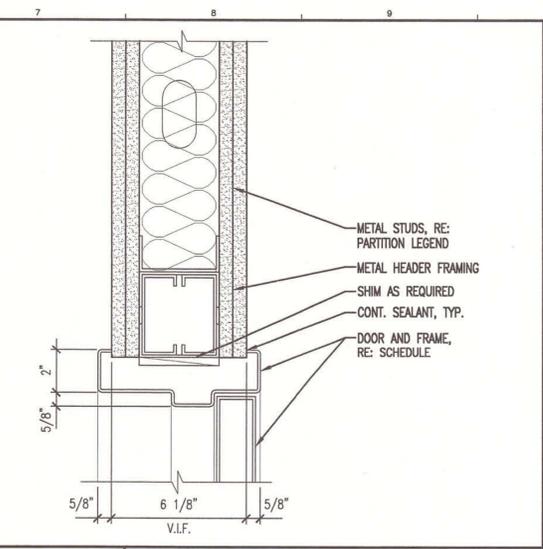
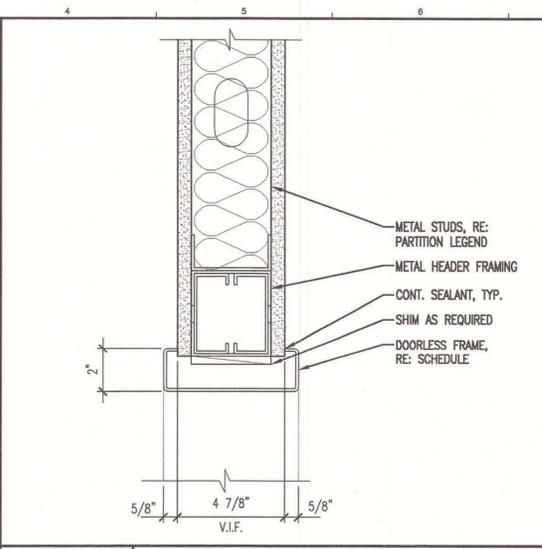
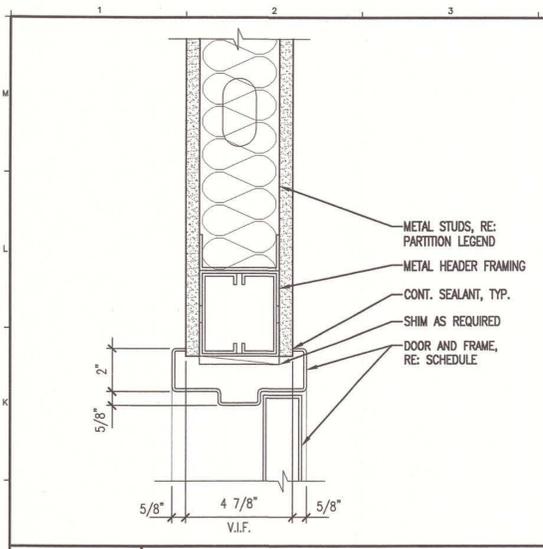


J1 HEAD DETAIL
3" = 1'-0"

J4 HEAD DETAIL
3" = 1'-0"

J7 HEAD DETAIL
3" = 1'-0"

J10 HEAD DETAIL
3" = 1'-0"

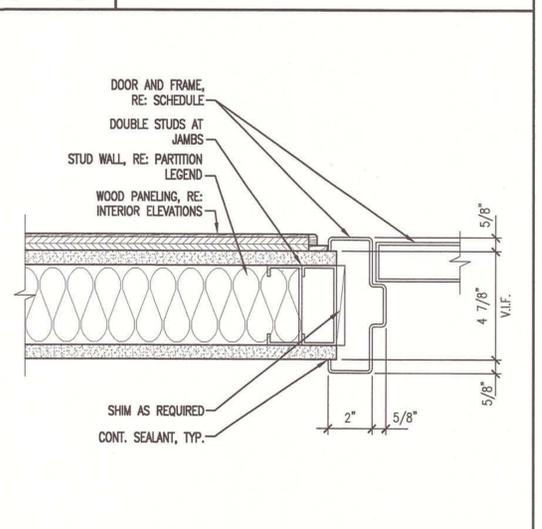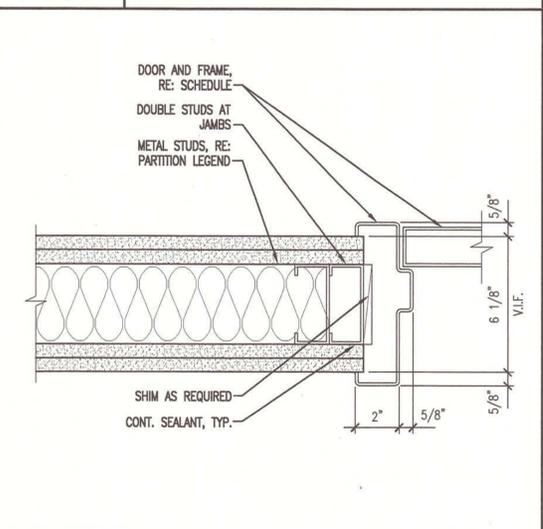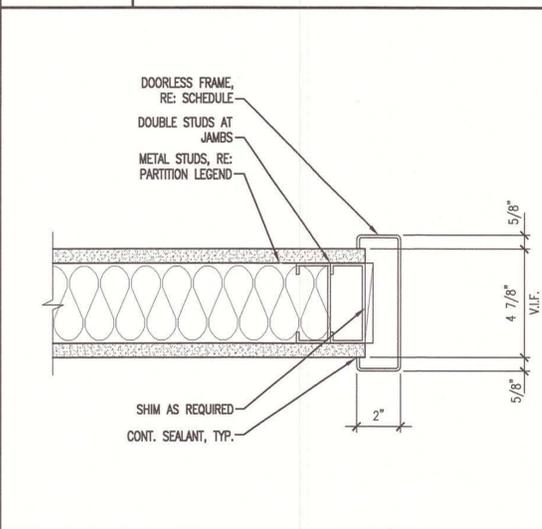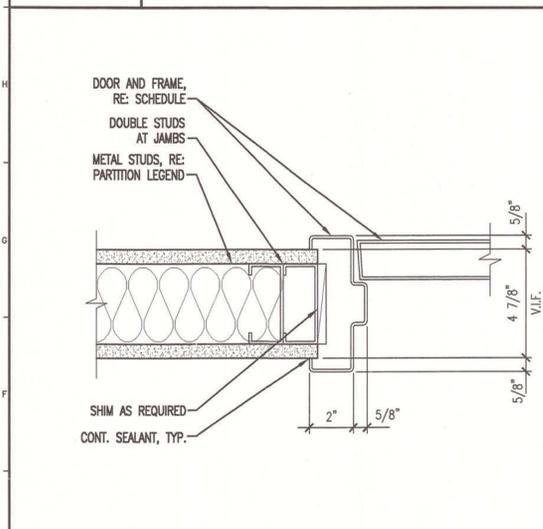


E1 JAMB DETAIL
3" = 1'-0"

E4 JAMB DETAIL
3" = 1'-0"


E7 JAMB DETAIL
3" = 1'-0"

E10 JAMB DETAIL
3" = 1'-0"

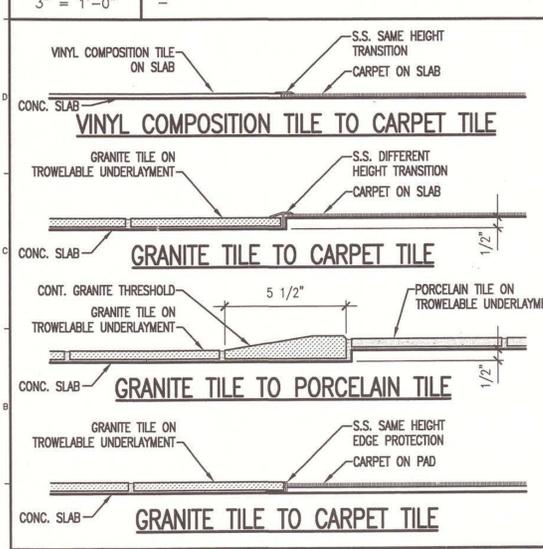

A4
-

A7
-

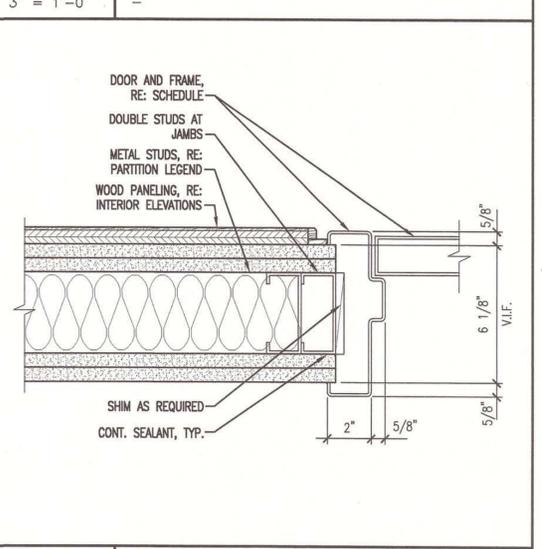

A1 FLOOR MATERIAL TRANSITIONS
3" = 1'-0"

A4
-

A7
-

A10 JAMB DETAIL
3" = 1'-0"

GENERAL NOTES:
 1. SEE G101 FOR PROJECT GENERAL NOTES.



ARCHITECTURE ENGINEERING PLANNING
 SMRT
 144 Fore Street, P.O. Box 618
 Portland, Maine 04104
 tel. (207) 772-3946
 fax. (207) 772-1070



PROJECT TITLE:
**MAINE TURNPIKE AUTHORITY
 ADMINISTRATION BUILDING**
 PORTLAND, MAINE

CURRENT ISSUE STATUS:
**ISSUED FOR BIDDING/CONSTRUCTION
 7-9-07**

REV	DESCRIPTION	DATE
0	BIDDING/CONSTRUCTION	7-9-07

GRAPHIC SCALE:
 0" 1"




SCALE: AS NOTED

PROJECT MANAGER: SLB
 JC/DRAWN BY: TCM/TCM
 A/E OF RECORD: SLB
 CAD FILE: AE624-06016
 PROJECT NO: 06016
 DATE: 7-9-07

SHEET TITLE:
**DOOR & WINDOW
 DETAILS**

SHEET NO.
AE624

**AS BUILT
 Owner Copy**


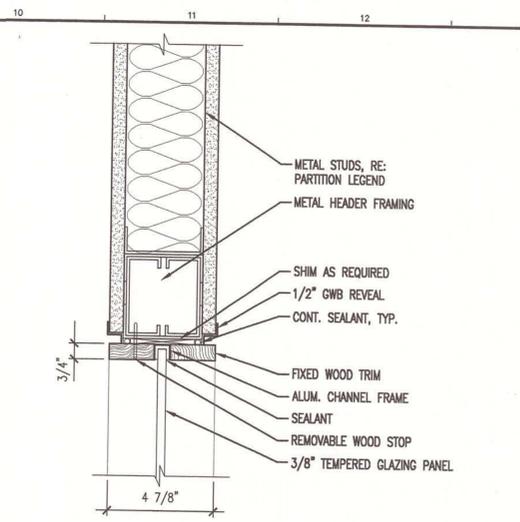
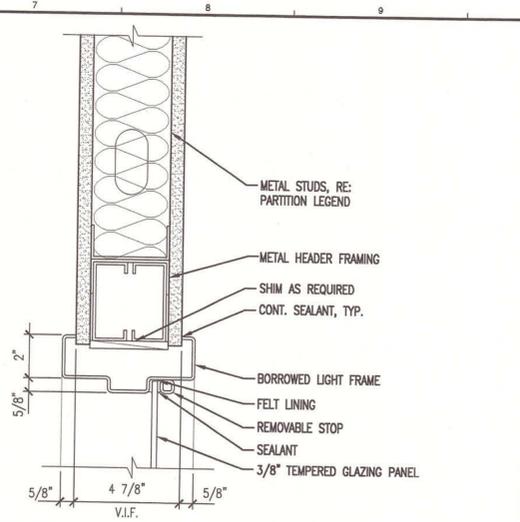
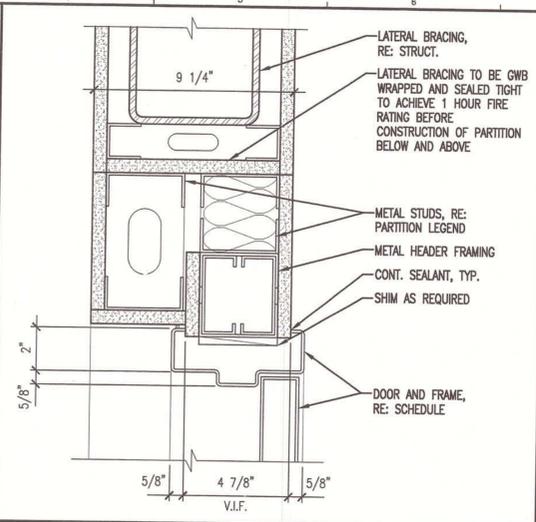


J1 —
 * —

J4 HEAD DETAIL
 3" = 1'-0" —

J7 HEAD DETAIL
 3" = 1'-0" —

J10 HEAD DETAIL
 3" = 1'-0" —

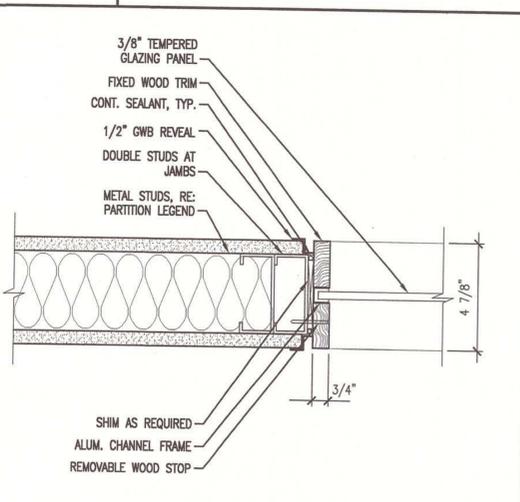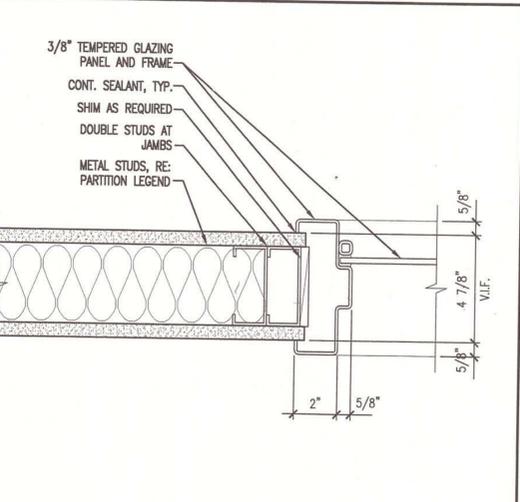
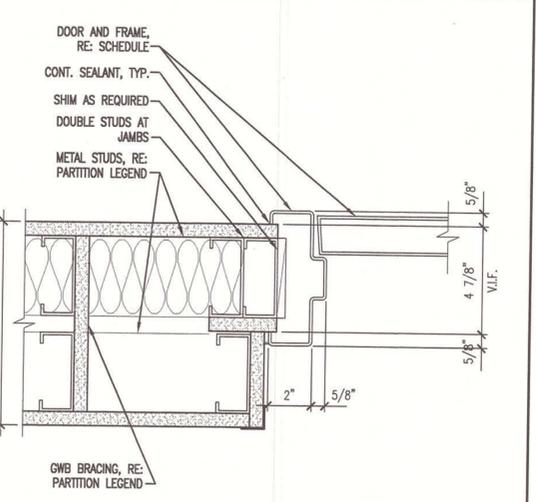
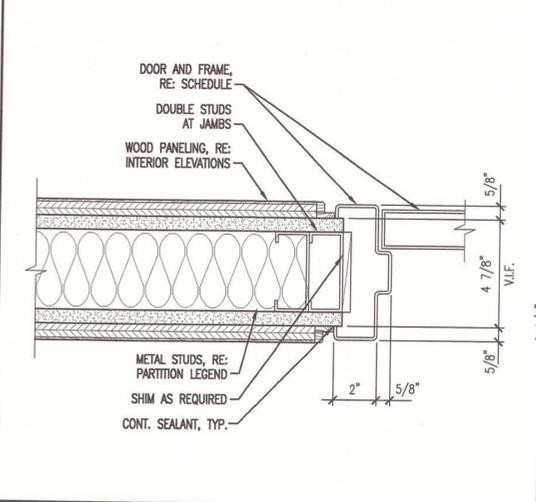


E1 JAMB DETAIL
 3" = 1'-0" —

E4 JAMB DETAIL
 3" = 1'-0" —

E7 JAMB DETAIL
 3" = 1'-0" —

E10 JAMB DETAIL
 3" = 1'-0" —

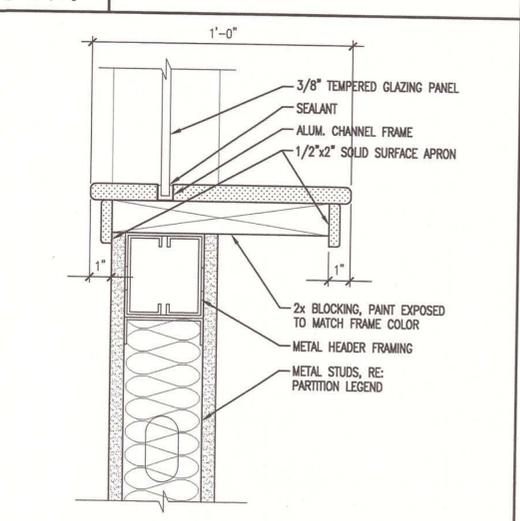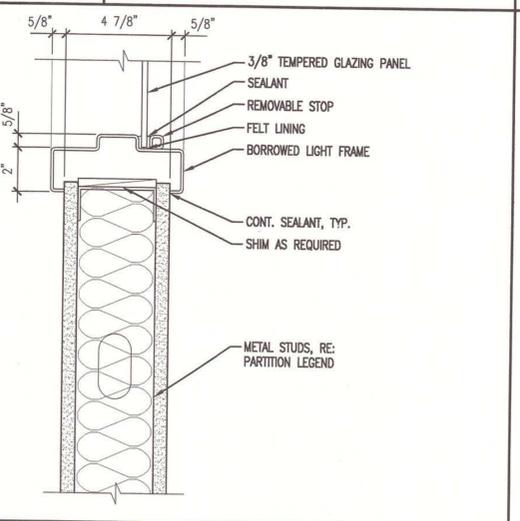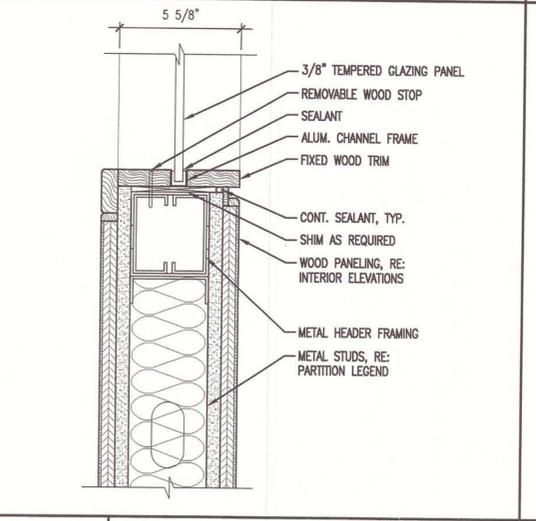


A1 —
 * —


A4 SILL DETAIL
 3" = 1'-0" —

A7 SILL DETAIL
 3" = 1'-0" —


A10 SILL DETAIL
 3" = 1'-0" —

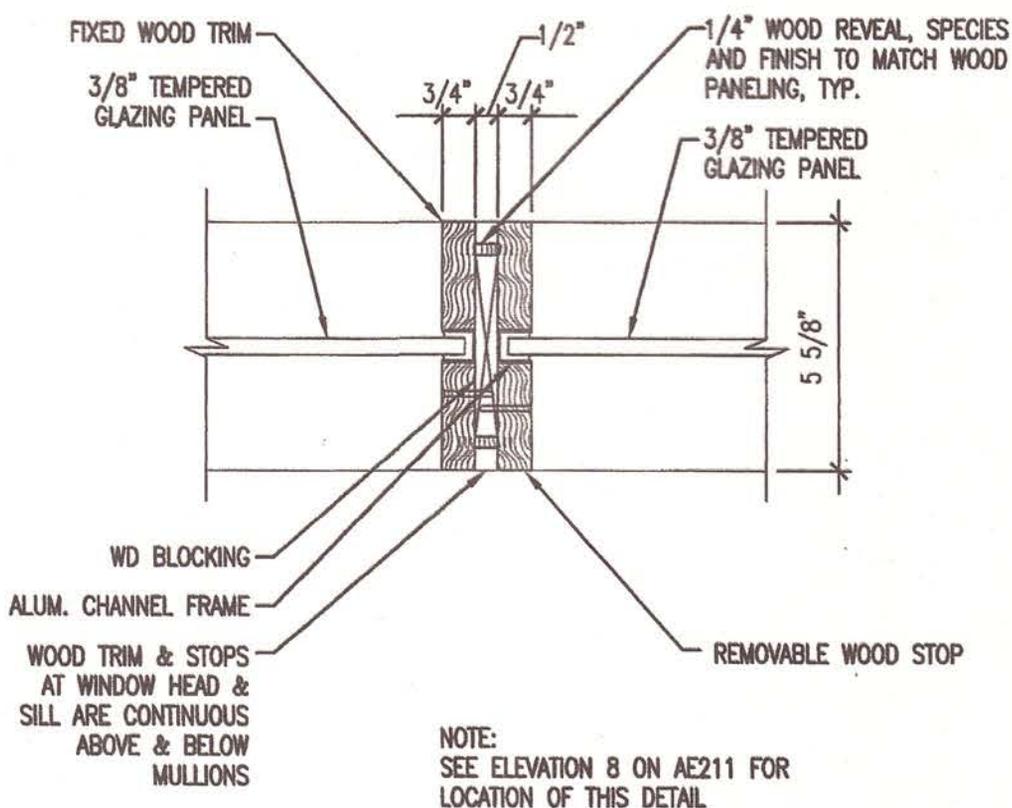

E4	JAMB DETAIL	
3" = 1'-0"	-	
SM RT	ARCHITECTURE ENGINEERING PLANNING SMRT 144 Fore Street/P.O.Box 618 PORTLAND, MAINE 04104 tel. (207) 772-3846 / fax. (207) 772-1070	SCALE: 3"=1'-0"
	PROJECT: MAINE TURNPIKE AUTHORITY ADMINISTRATION BUILDING	CAD FILE: AE626-06016
SUBJECT: ADD DETAIL E4/AE626 AS DESCRIBED	REF. SHEET: AE626	PROJECT No. 06016
		PM: SLB
		A/E: SLB
		DATE:
		SUPPLEMENTAL INSTRUCTION SI-64 SKETCH No. A-3 © COPYRIGHT 2008 SMRT INC.

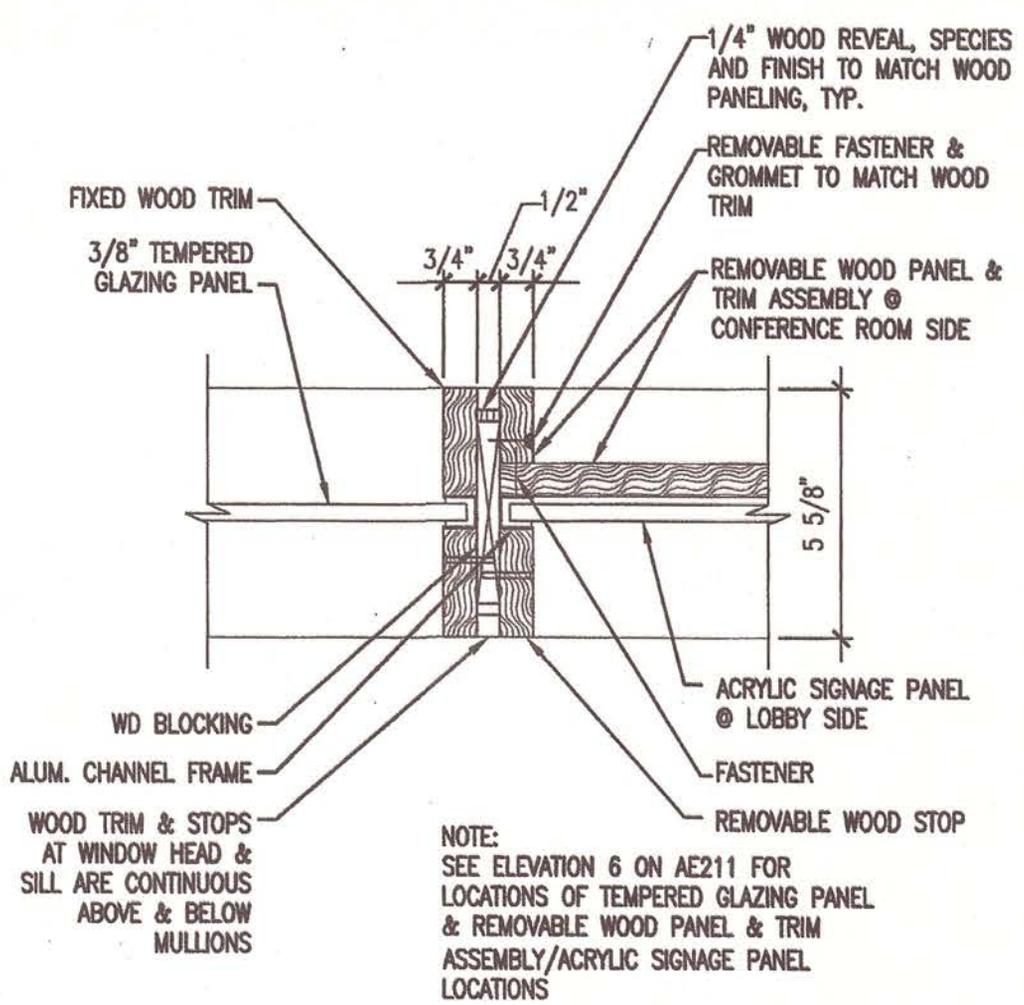


E1	JAMB DETAIL	
3" = 1'-0"	-	
SM RT	ARCHITECTURE ENGINEERING PLANNING SMRT 144 Fore Street/P.O.Box 618 PORTLAND, MAINE 04104 tel. (207) 772-3846 / fax. (207) 772-1070	SCALE: 3"=1'-0"
	PROJECT: MAINE TURNPIKE AUTHORITY ADMINISTRATION BUILDING	CAD FILE: AE626-06016
SUBJECT: ADD DETAIL E1/AE626 AS DESCRIBED	REF. SHEET: AE626	PROJECT No. 06016
		PM: SLB
		A/E: SLB
		DATE:
		SUPPLEMENTAL INSTRUCTION SI-64R SKETCH No. A-2 © COPYRIGHT 2008 SMRT INC.

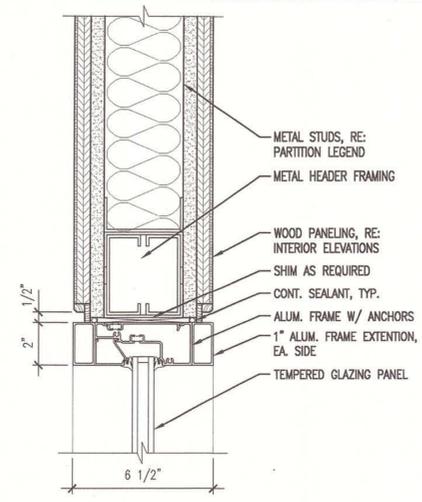


J1 HEAD DETAIL

3" = 1'-0"

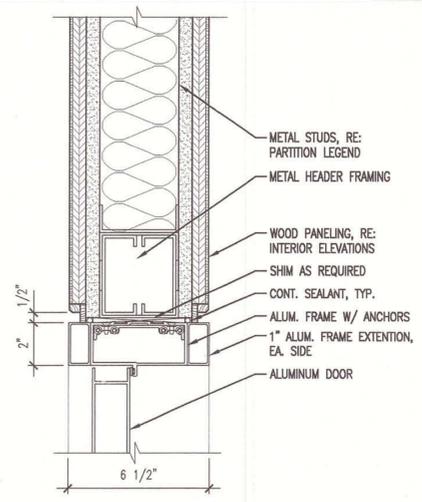


J4 HEAD DETAIL

3" = 1'-0"

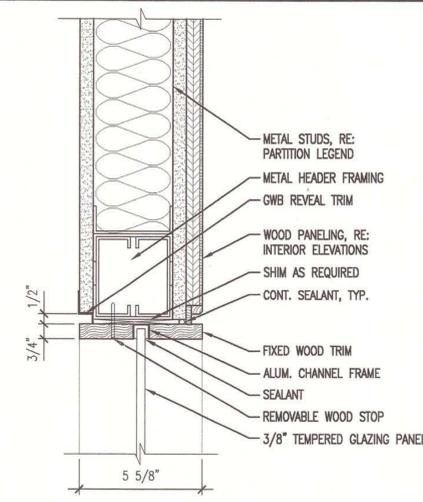

J7 HEAD DETAIL

3" = 1'-0"

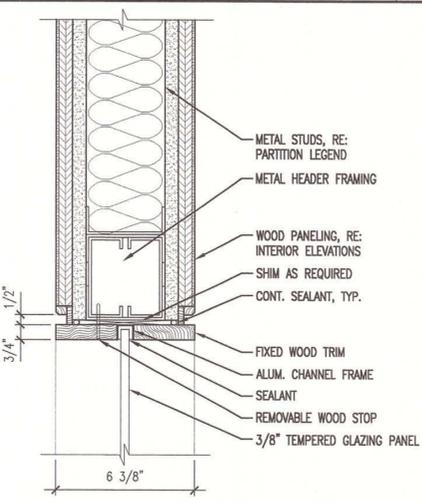


J10 HEAD DETAIL

3" = 1'-0"


See opposite page
SI-64R

See opposite page
SI-64R

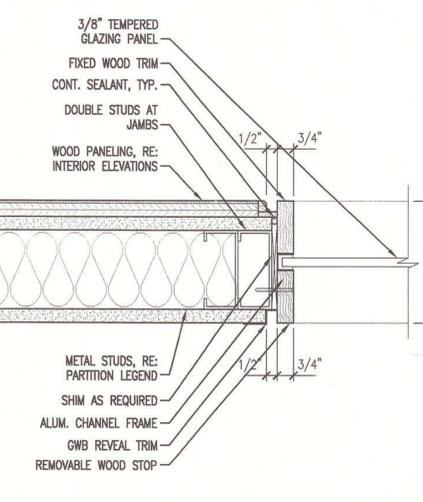

E7 JAMB DETAIL

3" = 1'-0"

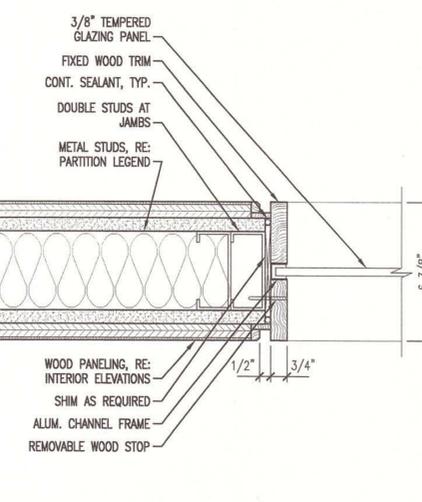

E10 JAMB DETAIL


3" = 1'-0"

E1 - Jamb Detail

*


E4 - Jamb Detail

*

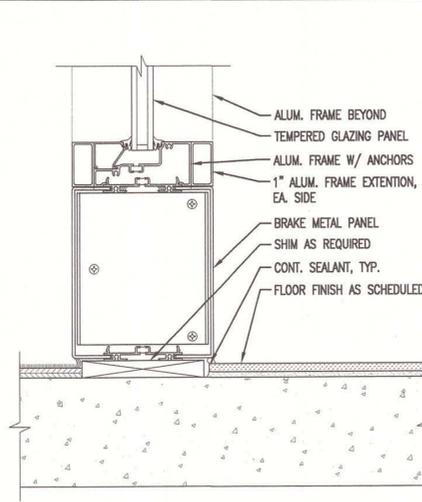


A1 SILL DETAIL

3" = 1'-0"

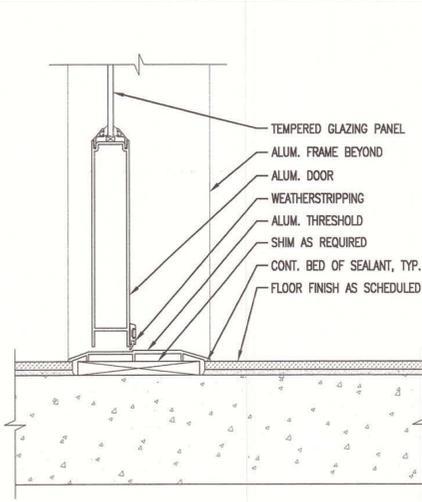


A4 THRESHOLD DETAIL

3" = 1'-0"

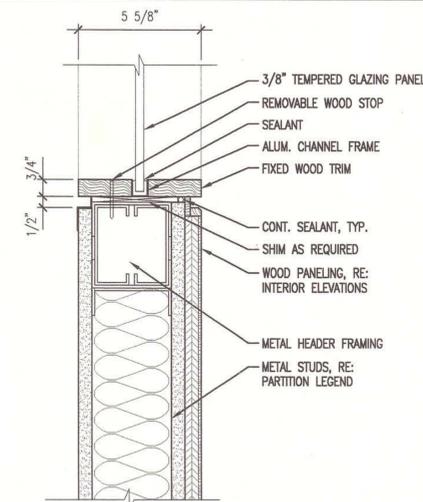

A7 SILL DETAIL

3" = 1'-0"

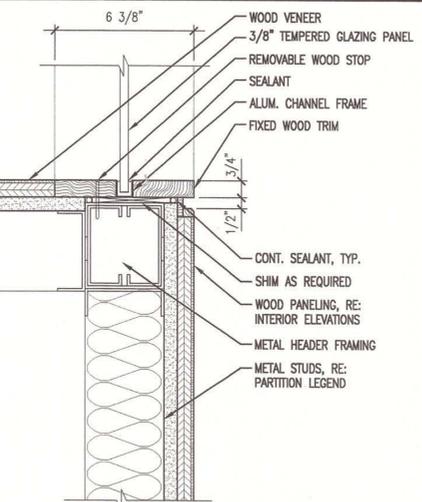

A10 SILL DETAIL

3" = 1'-0"

GENERAL NOTES:

1. SEE G001 FOR PROJECT GENERAL NOTES.



ARCHITECTURE ENGINEERING PLANNING
SMRT
144 Fore Street/P.O. Box 618
Portland, Maine 04104
tel. (207) 772-3846
fax. (207) 772-1070



PROJECT TITLE:
**MAINE TURNPIKE AUTHORITY
ADMINISTRATION BUILDING**
PORTLAND, MAINE

CURRENT ISSUE STATUS:
ISSUED FOR BIDDING/CONSTRUCTION
7-9-07

REV	DESCRIPTION	DATE
0	BIDDING/CONSTRUCTION	7-9-07

GRAPHIC SCALE:
0" = 1"

SCALE: AS NOTED

PROJECT MANAGER: SLB

JC/DRAWN BY: TCM/TCM

A/E OF RECORD: SLB

CAD FILE: AE626-06016


PROJECT NO: 06016

DATE: 7-9-07

SHEET TITLE:
**DOOR & WINDOW
DETAILS**

SHEET No. **AE626**

AS BUILT
Owner Copy

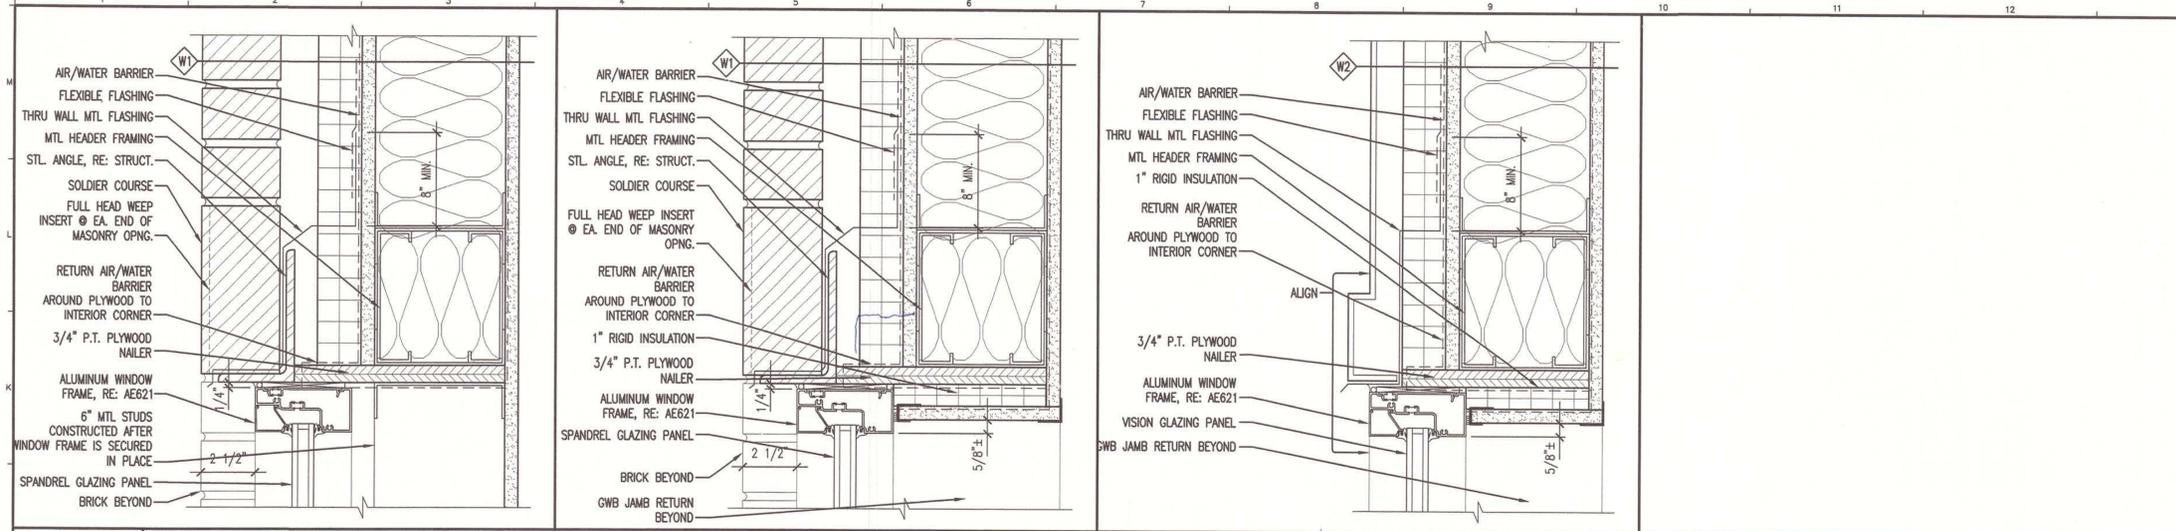


J1 HEAD DETAIL
3" = 1'-0"

J4 HEAD DETAIL
3" = 1'-0"

J7 HEAD DETAIL
3" = 1'-0"

J10 -

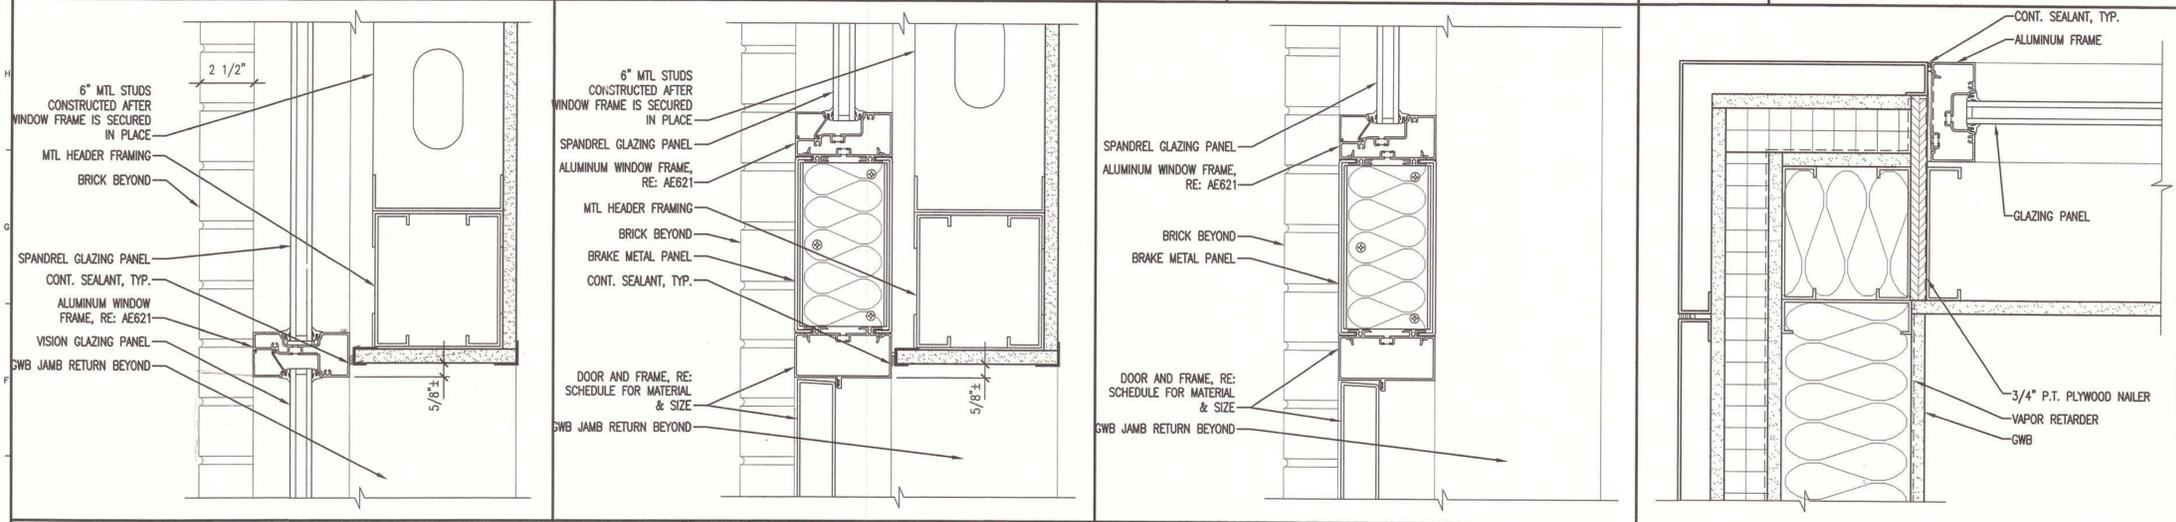


E1 MULLION DETAIL
3" = 1'-0"

E4 MULLION DETAIL
3" = 1'-0"

E7 MULLION DETAIL
3" = 1'-0"

E10 JAMB DETAIL
3" = 1'-0"

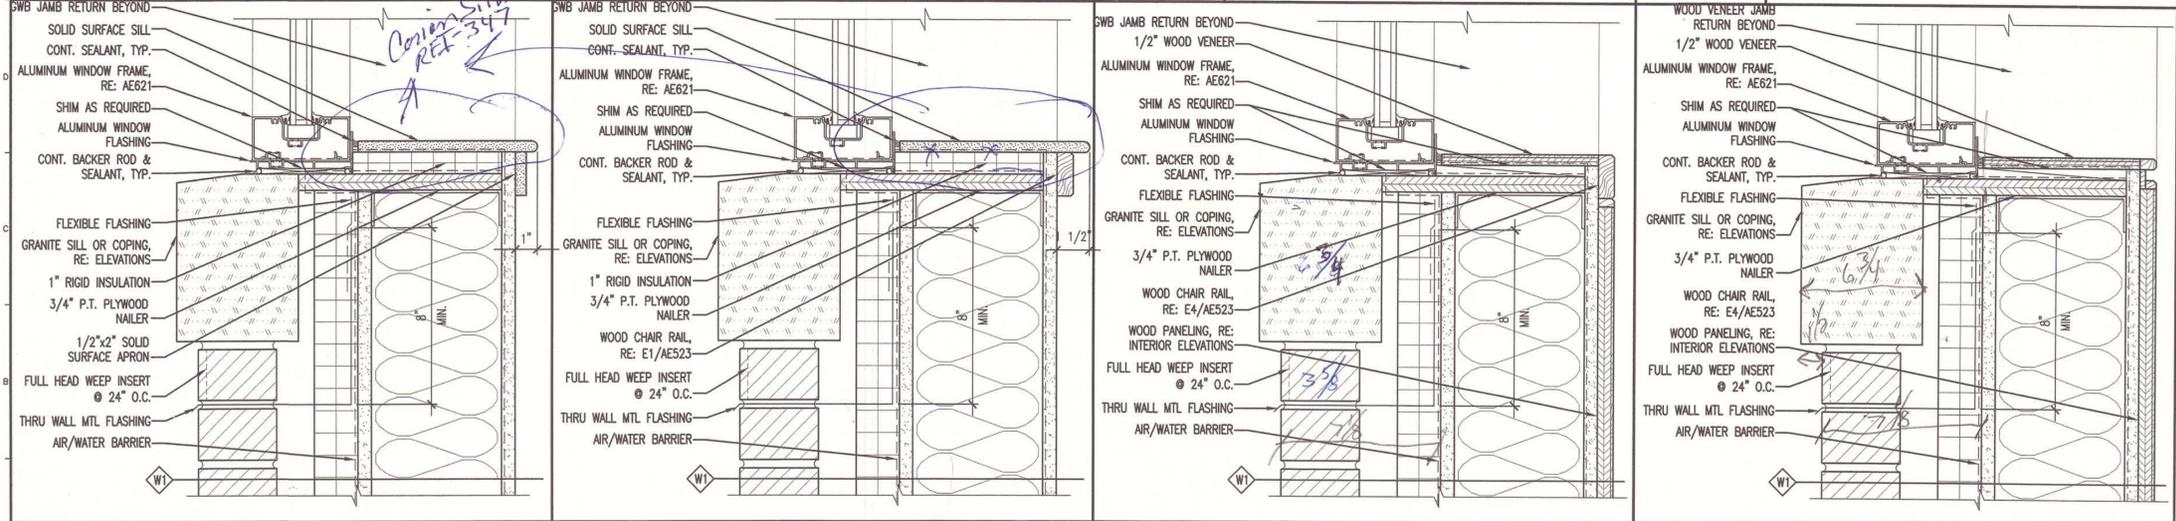

A1 SILL DETAIL
3" = 1'-0"

A4 SILL DETAIL
3" = 1'-0"


A7 SILL DETAIL
3" = 1'-0"

A10 SILL DETAIL
3" = 1'-0"

GENERAL NOTES:
1. SEE G001 FOR PROJECT GENERAL NOTES.



ARCHITECTURE ENGINEERING PLANNING
SMART
144 Fore Street/P.O. Box 618
Portland, Maine 04104
tel. (207) 772-3846
fax. (207) 772-1070

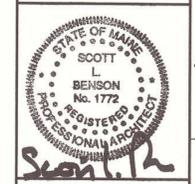

MAINE TURNPIKE AUTHORITY
ADMINISTRATION BUILDING
PORTLAND, MAINE

ISSUED FOR BIDDING/CONSTRUCTION
7-9-07

PROJECT TITLE: _____

CURRENT ISSUE STATUS: _____

REV	DESCRIPTION	DATE
0	BIDDING/CONSTRUCTION	7-9-07

GRAPHIC SCALE: 0" = 1"

SCALE: AS NOTED

PROJECT MANAGER: SLB

JC/DRAWN BY: TCM/TCM

A/E OF RECORD: SLB

CAD FILE: AE627-06016


PROJECT NO: 06016

DATE: 7-9-07


SHEET TITLE: DOOR & WINDOW DETAILS

SHEET No. **AE627**

AS BUILT
Owner Copy

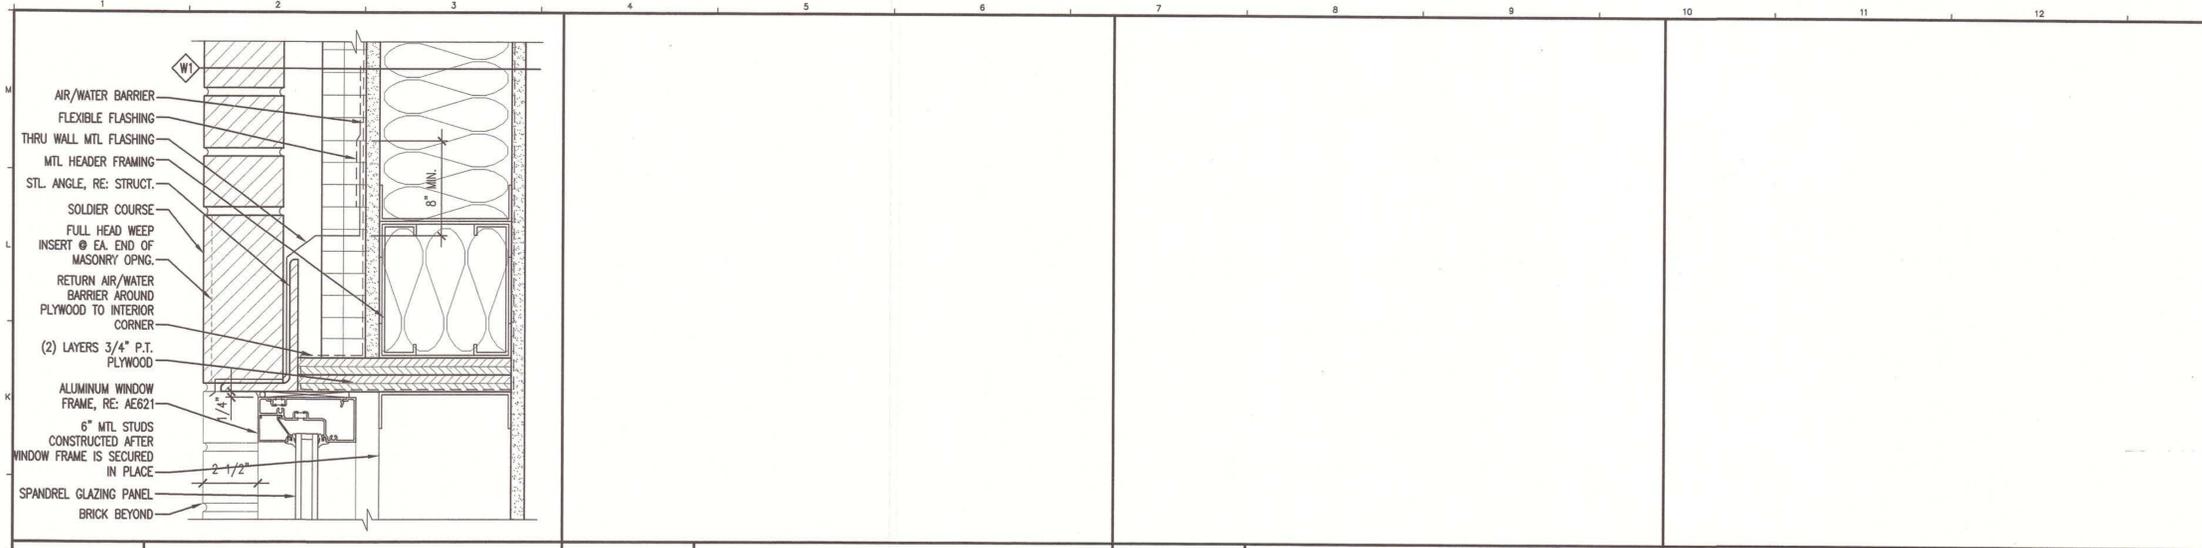


J1 HEAD DETAIL @ DOOR FRAME
3" = 1'-0"

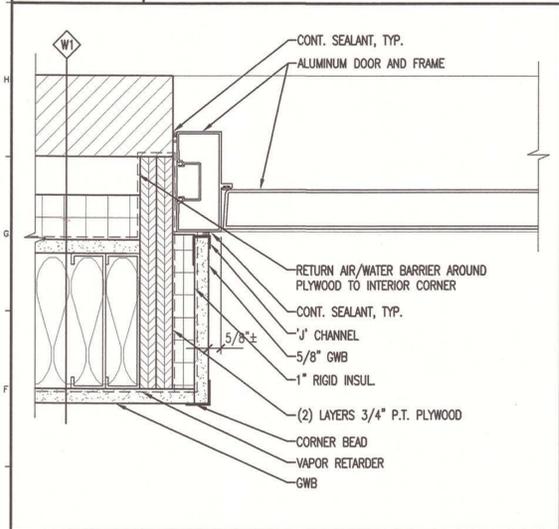


E1 JAMB DETAIL @ DOOR FRAME
3" = 1'-0"

J4 -
3" = 1'-0"

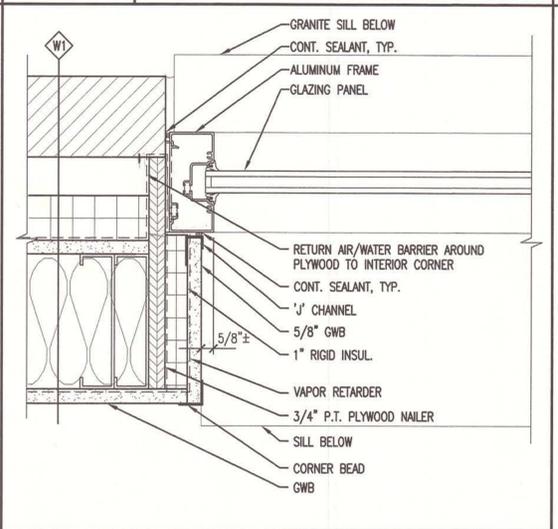


E4 JAMB DETAIL @ WINDOW
3" = 1'-0"

J7 -
3" = 1'-0"

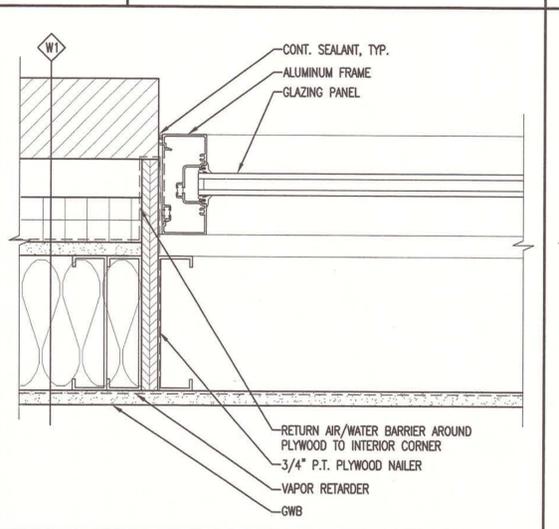


E7 JAMB DETAIL @ WINDOW
3" = 1'-0"


J10 -
3" = 1'-0"

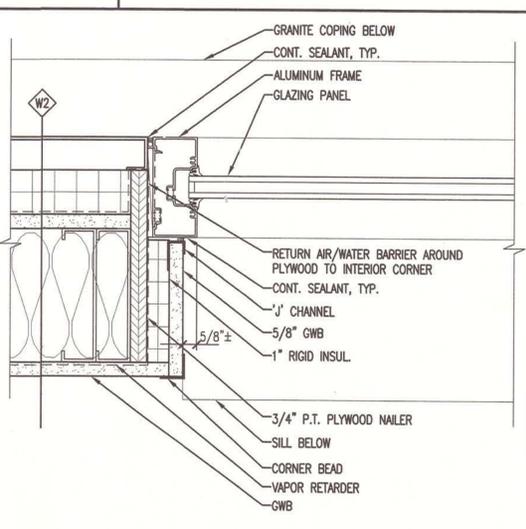


E10 JAMB DETAIL @ WINDOW
3" = 1'-0"

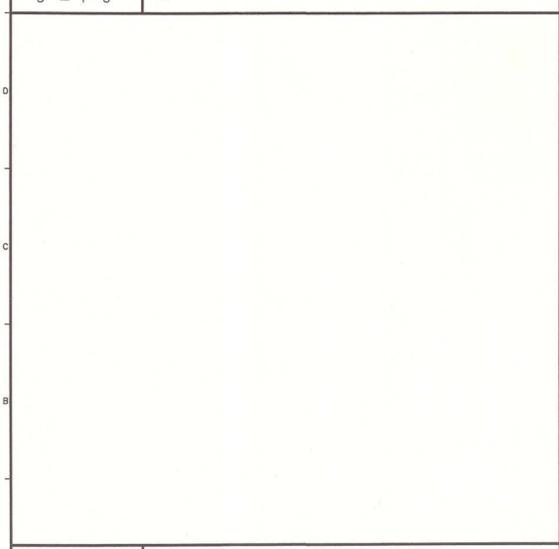

A4 JAMB DETAIL @ WINDOW
3" = 1'-0"

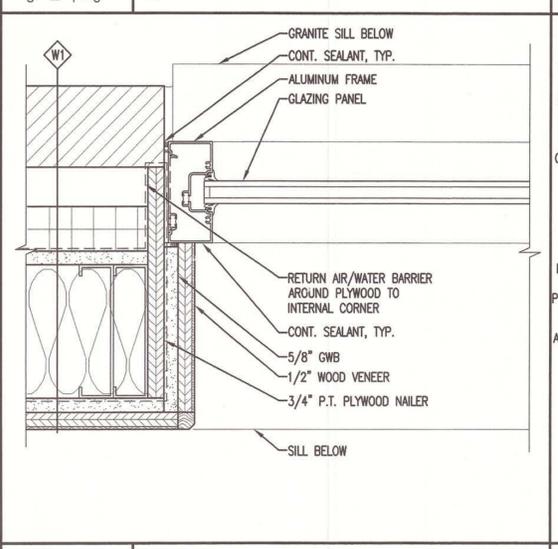

A7 SILL DETAIL
3" = 1'-0"

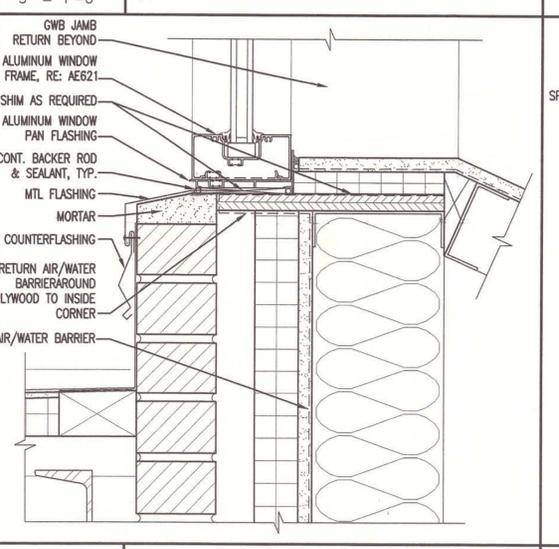


A10 SILL DETAIL
3" = 1'-0"

GENERAL NOTES:
1. SEE G1001 FOR PROJECT GENERAL NOTES.



ARCHITECTURE ENGINEERING PLANNING
SMRT
144 Fore Street, P.O. Box 618
Portland, Maine 04104
tel. (207) 773-3846
fax. (207) 773-1070

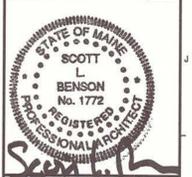

MAINE TURNPIKE AUTHORITY
ADMINISTRATION BUILDING
PORTLAND, MAINE
ISSUED FOR BIDDING/CONSTRUCTION
7-9-07

REV	DESCRIPTION	DATE
0	BIDDING/CONSTRUCTION	7-9-07

GRAPHIC SCALE:
0" 1"
SCALE: AS NOTED
PROJECT MANAGER: SLB
JC/DRAWN BY: TCM/TCM
A/E OF RECORD: SLB
CAD FILE: AE628-06016
PROJECT NO: 06016
DATE: 7-9-07
SHEET TITLE:
DOOR & WINDOW DETAILS

SHEET No. **AE628**

AS BUILT
Owner Copy

Poston Flooring Plan

Rick Paulison

From: Derek Converse [dconverse@wright-ryan.com]
Sent: Friday, July 18, 2008 9:04 AM
To: 'Scott Benson'
Cc: 'Rick Paulison'; 'Laurie Warhol'; 'Charles Myers'; 'Warchol, Scott A.'
Subject: RE: MTA RFI #133 Response

Scott:

We will proceed as noted below with no cost impacts to the owner. Thanks.

Derek

From: Scott Benson [mailto:SBenson@SMRTInc.com]
Sent: Monday, June 23, 2008 5:21 PM
To: Derek Converse
Cc: Rick Paulison; Laurie Warhol; Charles Myers; Warchol, Scott A.
Subject: RE: MTA RFI #133 Response

hi derek: with the understanding that no cost to the owner is proposed, smrt accepts wrc's recommendations as described below with one exception, that exception being the use of a stone transition along the line separating the stone tile on the lobby floor from the carpeted waiting areas located on both sides of the vestibule. the transition pieces will be made from the same dark stone as the accent tile, will run from column to column the entire width of the waiting areas, and will be 4" wide and a min. of 2'-0" long with a 3/16" high 45 degree bevel on that edge of the transition facing the carpeted waiting area. thank you for your concern for these details. please verify how wrc would like to proceed. regards, scott

-----Original Message-----

From: Derek Converse [mailto:dconverse@wright-ryan.com]
Sent: Monday, June 23, 2008 2:46 PM
To: Scott Benson
Cc: Rick Paulison
Subject: MTA RFI #133 Response

Scott:

In your response to RFI #133, you noted that you would like for the slab to be depressed 1/4" at the locations to receive stone tile.

We feel this approach is not the best approach to address the flooring thickness difference. We believe this construction joint could result in potential slab problems and maintenance problems down the road.

In lieu of placing two separate placements on the 2nd floor, we would like to place the 2nd floor in one placement all at the same elevation. At areas where the stone tile abuts a different flooring material, we would propose to use Ardex Feather Finish (or other such system as approved by SMRT and Paul White Tile) out for a distance of 6-8 feet to create a smooth transition between the two systems. Please also note that the difference will actually be closer to 3/16" and not 1/4".

Thanks for your consideration. Call me if you have any questions.

Sincerely,

7/21/2008

From: Scott Benson [SBenson@SMRTInc.com]
Sent: Monday, June 23, 2008 5:21 PM
To: Derek Converse
Cc: Rick Paulison; Laurie Warhol; Charles Myers; Warchol, Scott A.
Subject: RE: MTA RFI #133 Response

hi derek: with the understanding that no cost to the owner is proposed, smrt accepts wrc's recommendations as described below with one exception, that exception being the use of a stone transition along the line separating the stone tile on the lobby floor from the carpeted waiting areas located on both sides of the vestibule. the transition pieces will be made from the same dark stone as the accent tile, will run from column to column the entire width of the waiting areas, and will be 4" wide and a min. of 2'-0" long with a 3/16" high 45 degree bevel on that edge of the transition facing the carpeted waiting area. thank you for your concern for these details. please verify how wrc would like to proceed. regards, scott

-----Original Message-----

From: Derek Converse [mailto:dconverse@wright-ryan.com]
Sent: Monday, June 23, 2008 2:46 PM
To: Scott Benson
Cc: Rick Paulison
Subject: MTA RFI #133 Response

Scott:

In your response to RFI #133, you noted that you would like for the slab to be depressed 1/4" at the locations to receive stone tile.

We feel this approach is not the best approach to address the flooring thickness difference. We believe this construction joint could result in potential slab problems and maintenance problems down the road.

In lieu of placing two separate placements on the 2nd floor, we would like to place the 2nd floor in one placement all at the same elevation. At areas where the stone tile abuts a different flooring material, we would propose to use Ardex Feather Finish (or other such system as approved by SMRT and Paul White Tile) out for a distance of 6-8 feet to create a smooth transition between the two systems. Please also note that the difference will actually be closer to 3/16" and not 1/4".

Thanks for your consideration. Call me if you have any questions.

Sincerely,

Derek Converse, LEED® AP
 Project Manager
 P 207.773.3625x15
 F 207.773.5173

No virus found in this incoming message.

Checked by AVG.

Version: 7.5.524 / Virus Database: 270.4.1/1516 - Release Date: 6/24/2008 7:53 AM

6/24/2008

GENERAL NOTES:

1. SEE G1001 FOR PROJECT GENERAL NOTES.

Paint schedule - SI-60

*TYP Carpet Tile Pattern 3SI
Metal Rails*

See Page opposite for info on these floors

Comp # 258 REL-190


LEGEND:

-  VINYL COMPOSITION TILE (VCT-1)
-  STONE TILE 1 (ST-1)
-  STONE TILE 2 (ST-2)
-  CERAMIC TILE (CT)
-  CARPET (CPT-1 U.N.O.)
-  RUBBER FLOORING
-  SEALED CONCRETE (CONC)
-  2x2 STATIC DISSIPATIVE VINYL COMPOSITION TILE (SDVCT)

*AS BUILT
Owner Copy*



ARCHITECTURE ENGINEERING PLANNING
SMRT
144 Fore Street/P.O. Box 618
Portland, Maine 04104
tel. (207) 772-3846
fax. (207) 772-1070

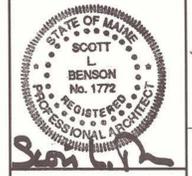


PROJECT TITLE:
**MAINE TURNPIKE AUTHORITY
ADMINISTRATION BUILDING**
PORTLAND, MAINE

CURRENT ISSUE STATUS:
ISSUED FOR BIDDING/CONSTRUCTION
7-9-07

REV	DESCRIPTION	DATE
0 <td>BIDDING/CONSTRUCTION</td> <td>7-9-07</td>	BIDDING/CONSTRUCTION	7-9-07

GRAPHIC SCALE:
0" 1"
SCALE: AS NOTED
PROJECT MANAGER: SLB
JC/DRAWN BY: TOM/PJP
A/E OF RECORD: SLB
CAD FILE: AF102-06016
PROJECT NO: 06016
DATE: 7-9-07

SHEET TITLE:
**SECOND FLOOR
FINISH PLAN**
SHEET No. **AF102**

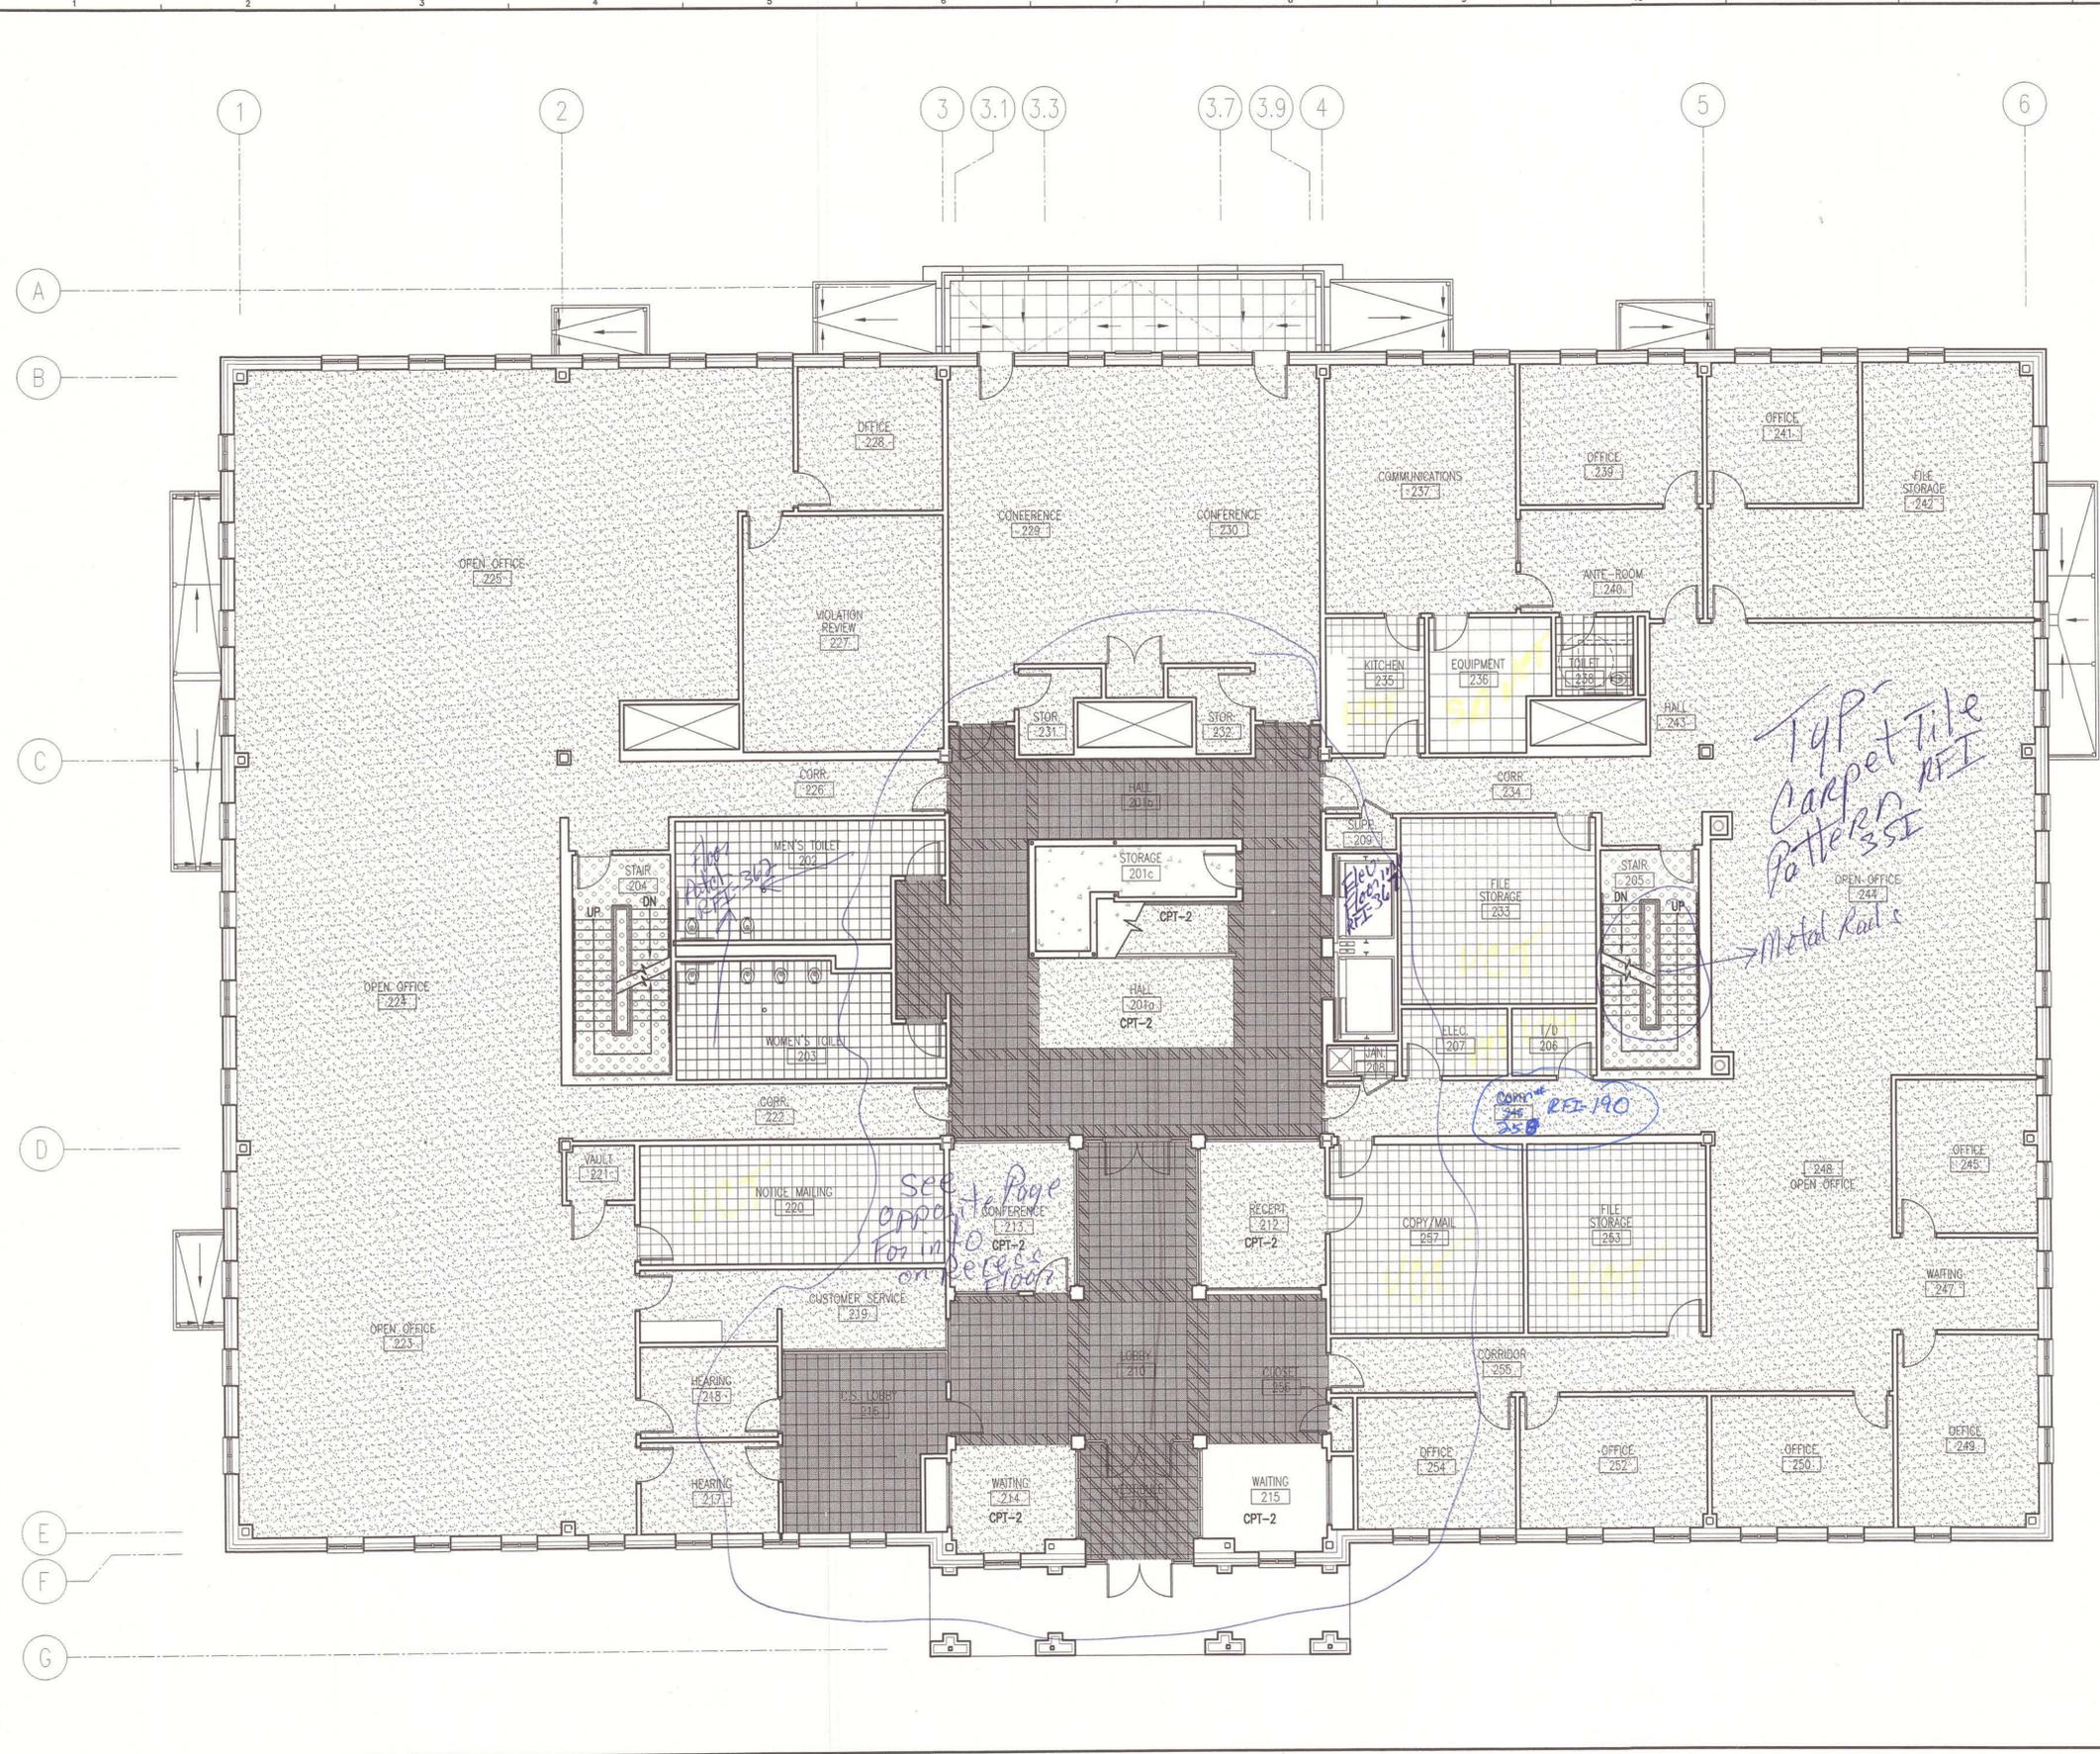


A1 SECOND FLOOR FINISH PLAN

1/8" = 1'-0"

GENERAL NOTES:

1. SEE G1001 FOR PROJECT GENERAL NOTES.

Paint Schedule - see SI-60

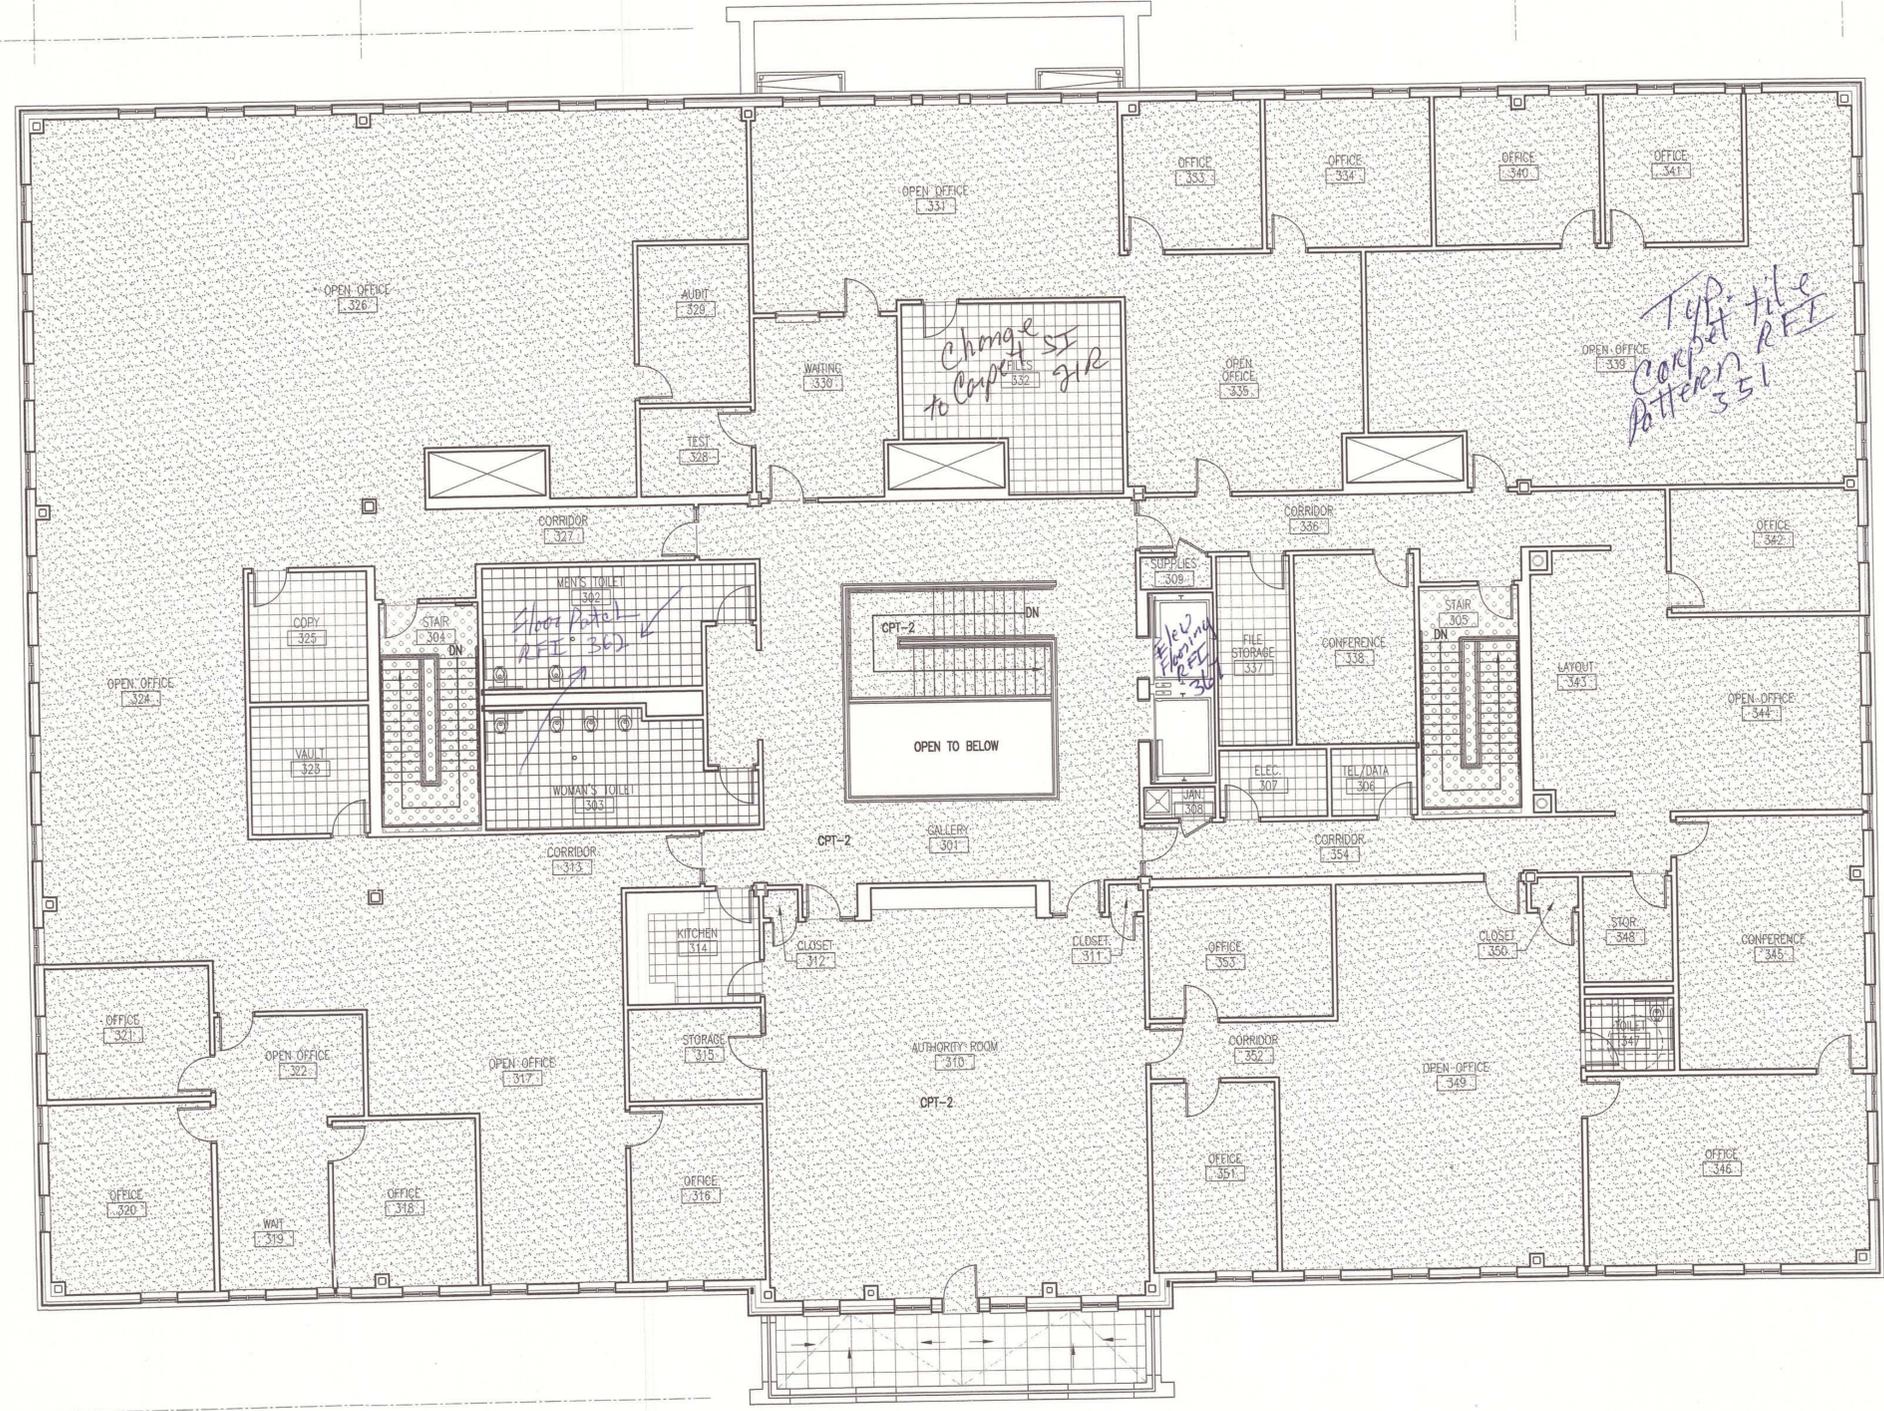


LEGEND:

- VINYL COMPOSITION TILE (VCT-1)
- STONE TILE 1 (ST-1)
- STONE TILE 2 (ST-2)
- CERAMIC TILE (CT)
- CARPET (CPT-1 U.N.O.)
- RUBBER FLOORING
- SEALED CONCRETE (CONC)
- 2x2 STATIC DISSIPATIVE VINYL COMPOSITION TILE (SDVCT)



ARCHITECTURE ENGINEERING PLANNING
 S.M. S.M. R.T.
 144 Fore Street/P.O. Box 618
 Portland, Maine 04104
 tel. (207) 772-3846
 fax. (207) 772-1070

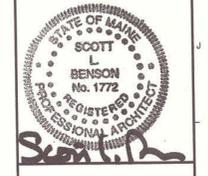

PROJECT TITLE:
**MAINE TURNPIKE AUTHORITY
 ADMINISTRATION BUILDING**
 PORTLAND, MAINE

CURRENT ISSUE STATUS:
**ISSUED FOR BIDDING/CONSTRUCTION
 7-9-07**

REV	DESCRIPTION	DATE
0	BIDDING/CONSTRUCTION	7-9-07

GRAPHIC SCALE:
 0" 1"
 SCALE: AS NOTED
 PROJECT MANAGER: SLB
 JC/DRAWN BY: TCM/PJP
 A/E OF RECORD: SLB
 CAD FILE: AF103-08016
 PROJECT NO: 08016
 DATE: 7-9-07

SHEET TITLE:
**THIRD FLOOR
 FINISH PLAN**
 SHEET No. **AF103**

AS BUILT
 Owner Copy

A1 THIRD FLOOR FINISH PLAN

1/8" = 1'-0"